

INDEX TO DRAWINGS	
SHEET NO.	DESCRIPTION
1	Title Sheet
2	Typical Sections
3-9	Plan & Profile
10-11	Standard Details
12-13	Culvert Details
14-25	Cross Sections

CONVENTIONAL SIGNS

Boundary Line (not fenced)	
Boundary Line (fenced)	
Centerline Medial Strip	
Existing Roads	
Railroad Track	
Banyan Tree (noted)	
Monkey Pod Tree (noted)	
Underground Telephone Line	
Water Pipe Line	
Telephone Pole	
Electric Power Pole	
Circular Concrete Culvert	
Concrete Box Culvert	

TERRITORY OF HAWAII
TERRITORIAL HIGHWAY DEPARTMENT
HONOLULU - T. H.



PLANS OF
KAMEHAMEHA HIGHWAY
PEARL HARBOR JUNCTION TO PUULOA ROAD
FEDERAL AID PROJECT NO. SN-FAP 9-A(6)

HONOLULU DISTRICT
ISLAND OF OAHU....

SCALES

P L A N 1 INCH=50 FEET
PLAN & PROFILE HORIZ.: 1 INCH=50 FEET
VERT.: 1 INCH=5 FEET
CROSS SECTIONS HORIZ.: 1 INCH=10 FEET
VERT.: 1 INCH=10 FEET

REVISED INDEX TO DRAWINGS		
SHEET NO.	DESCRIPTION	REVISION DATE
1	Title Sheet	Apr. 1944
2	Typical Sections	"
2-A	Intersection Details	"
2-B	Intersection Old Road to Rodgers	Obsolete
2-C	Intersection Opposite DA-NR 10 B (1)	Apr. 1944
3	Plan and Profile	"
3-A	" " "	"
3-A-1	" " "	"
3-A-2	" " "	"
3-A-3	Revisions to Plan and Profile, this sheet also part of Project DA-NR 10 A (1)	"
3-B	Plan and Profile	Mar. 1944
3-B-1	" " "	"
4, 5, 6	" " "	Apr. 1944
7	" " "	Mar. 1944
8	" " "	Apr. 1944
9	" " "	Obsolete
10, 11	Standard Details	
12, 13	Culvert Details	
14, 25	Cross Sections	

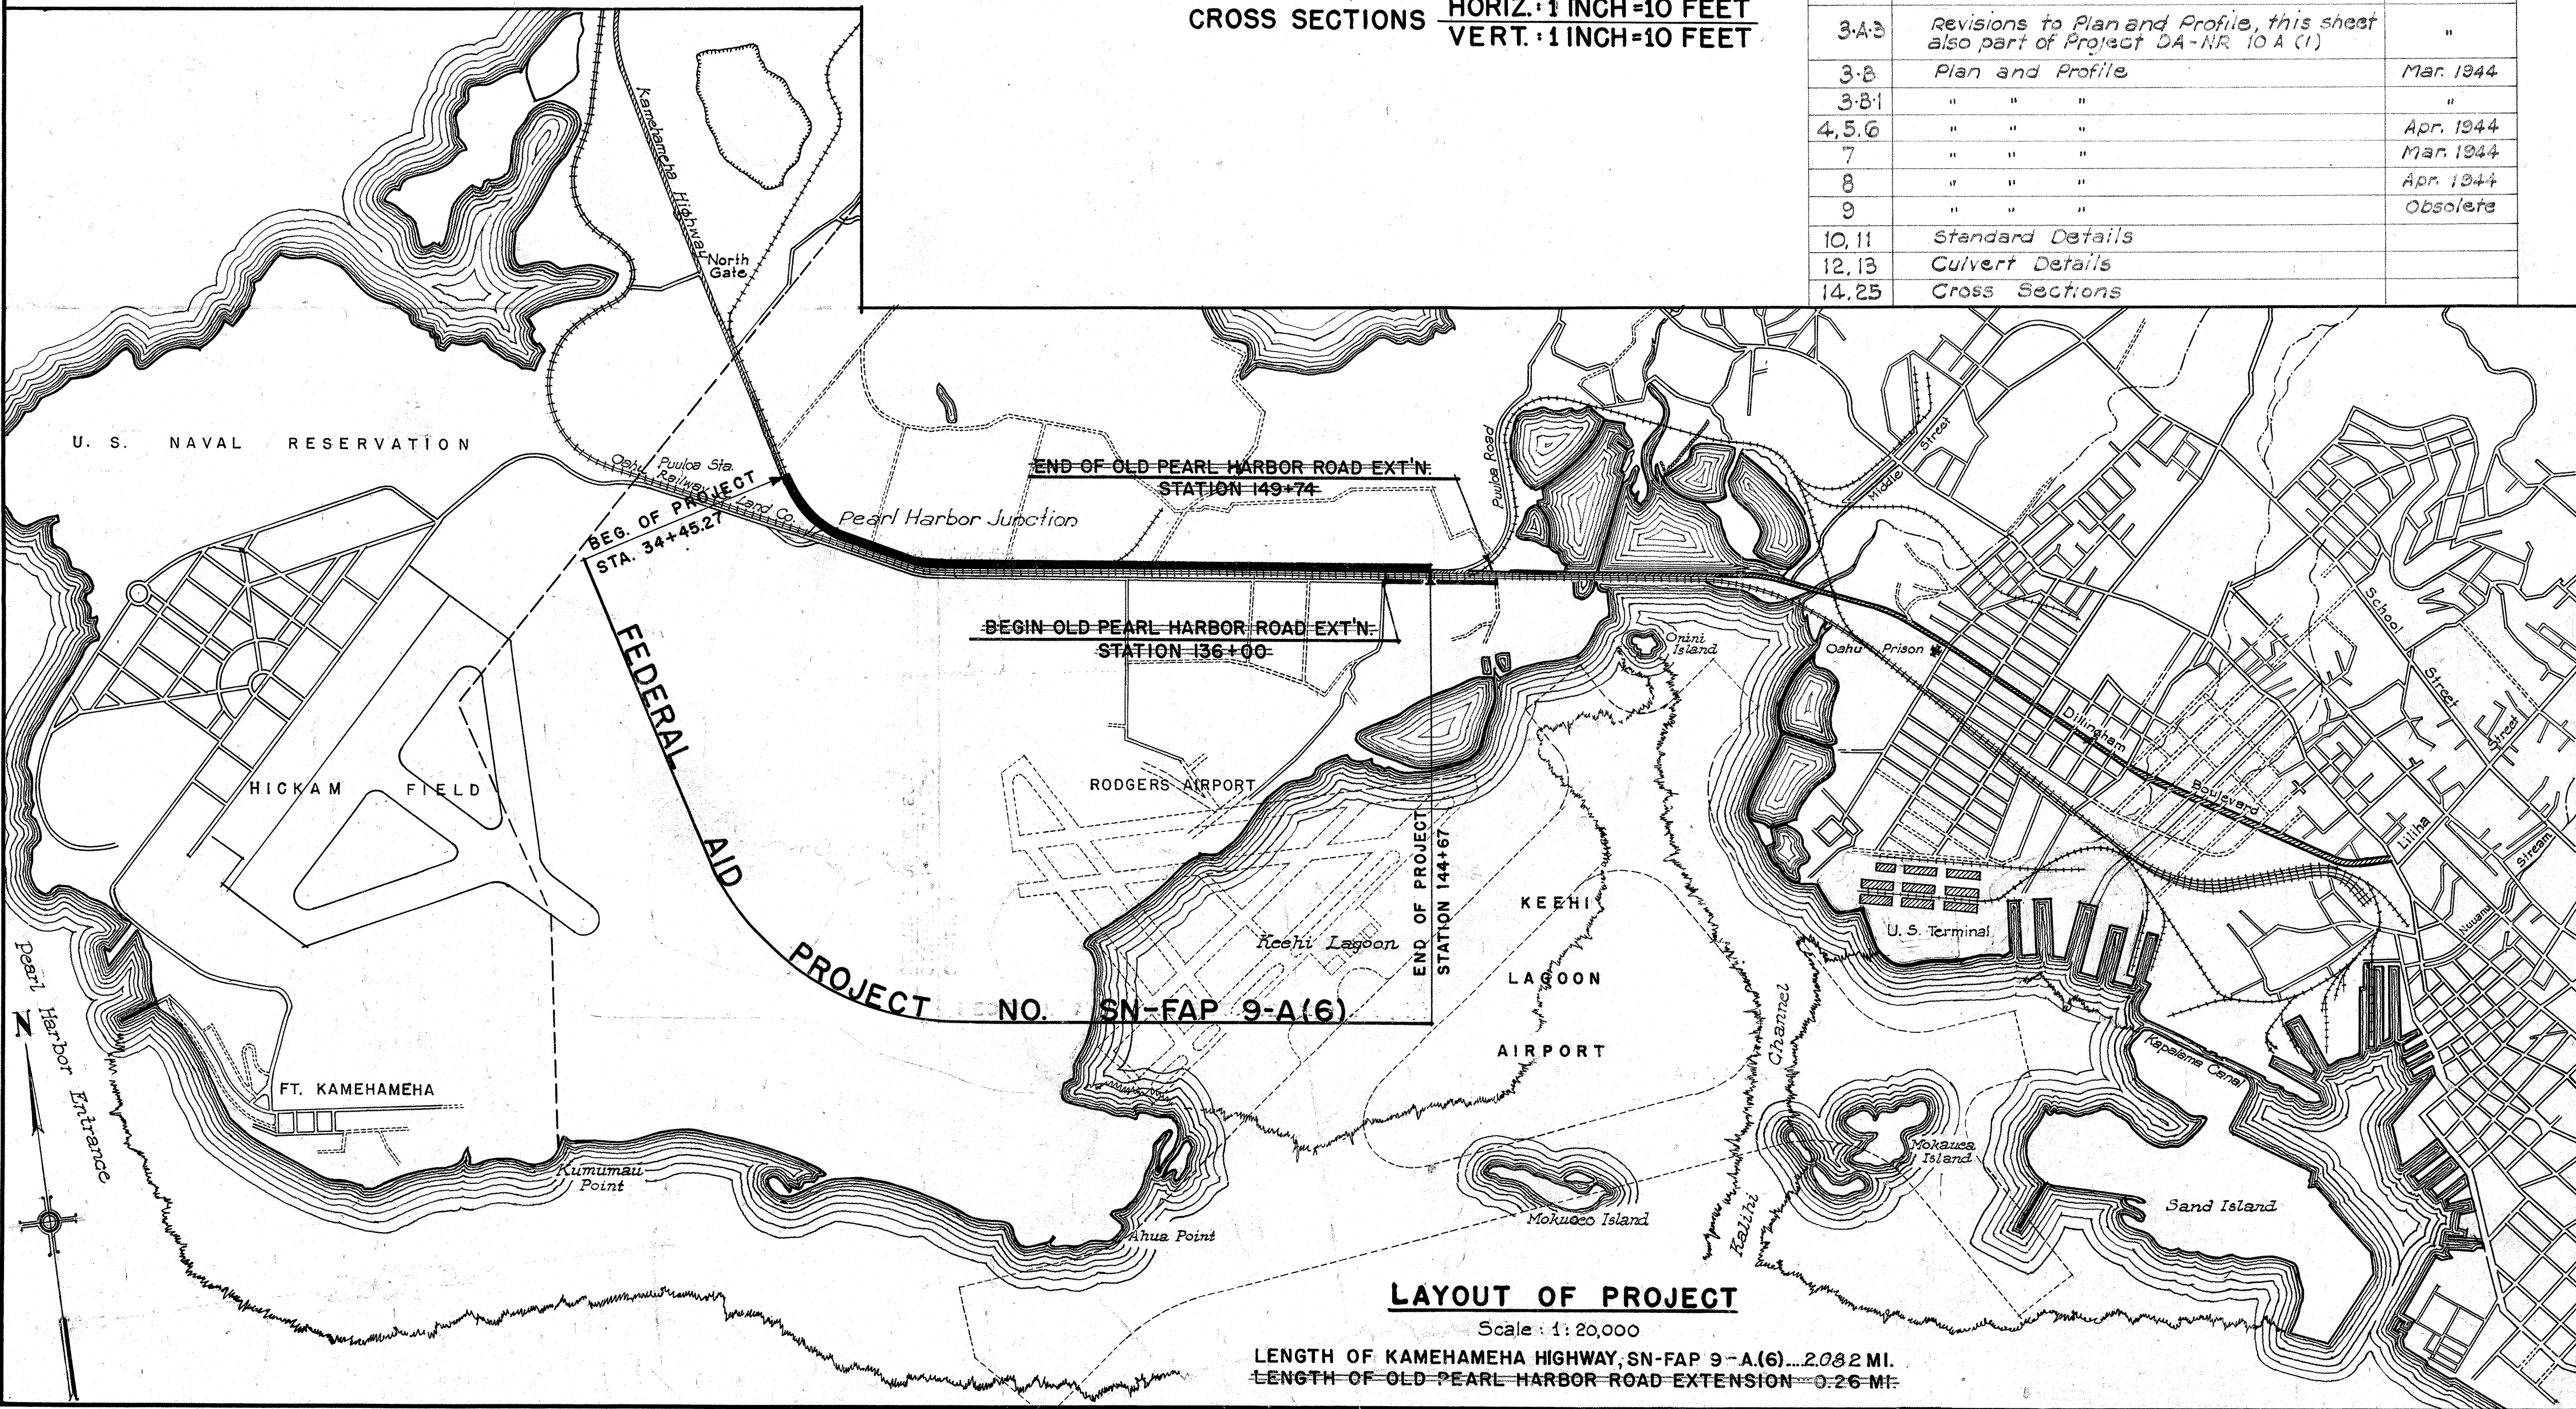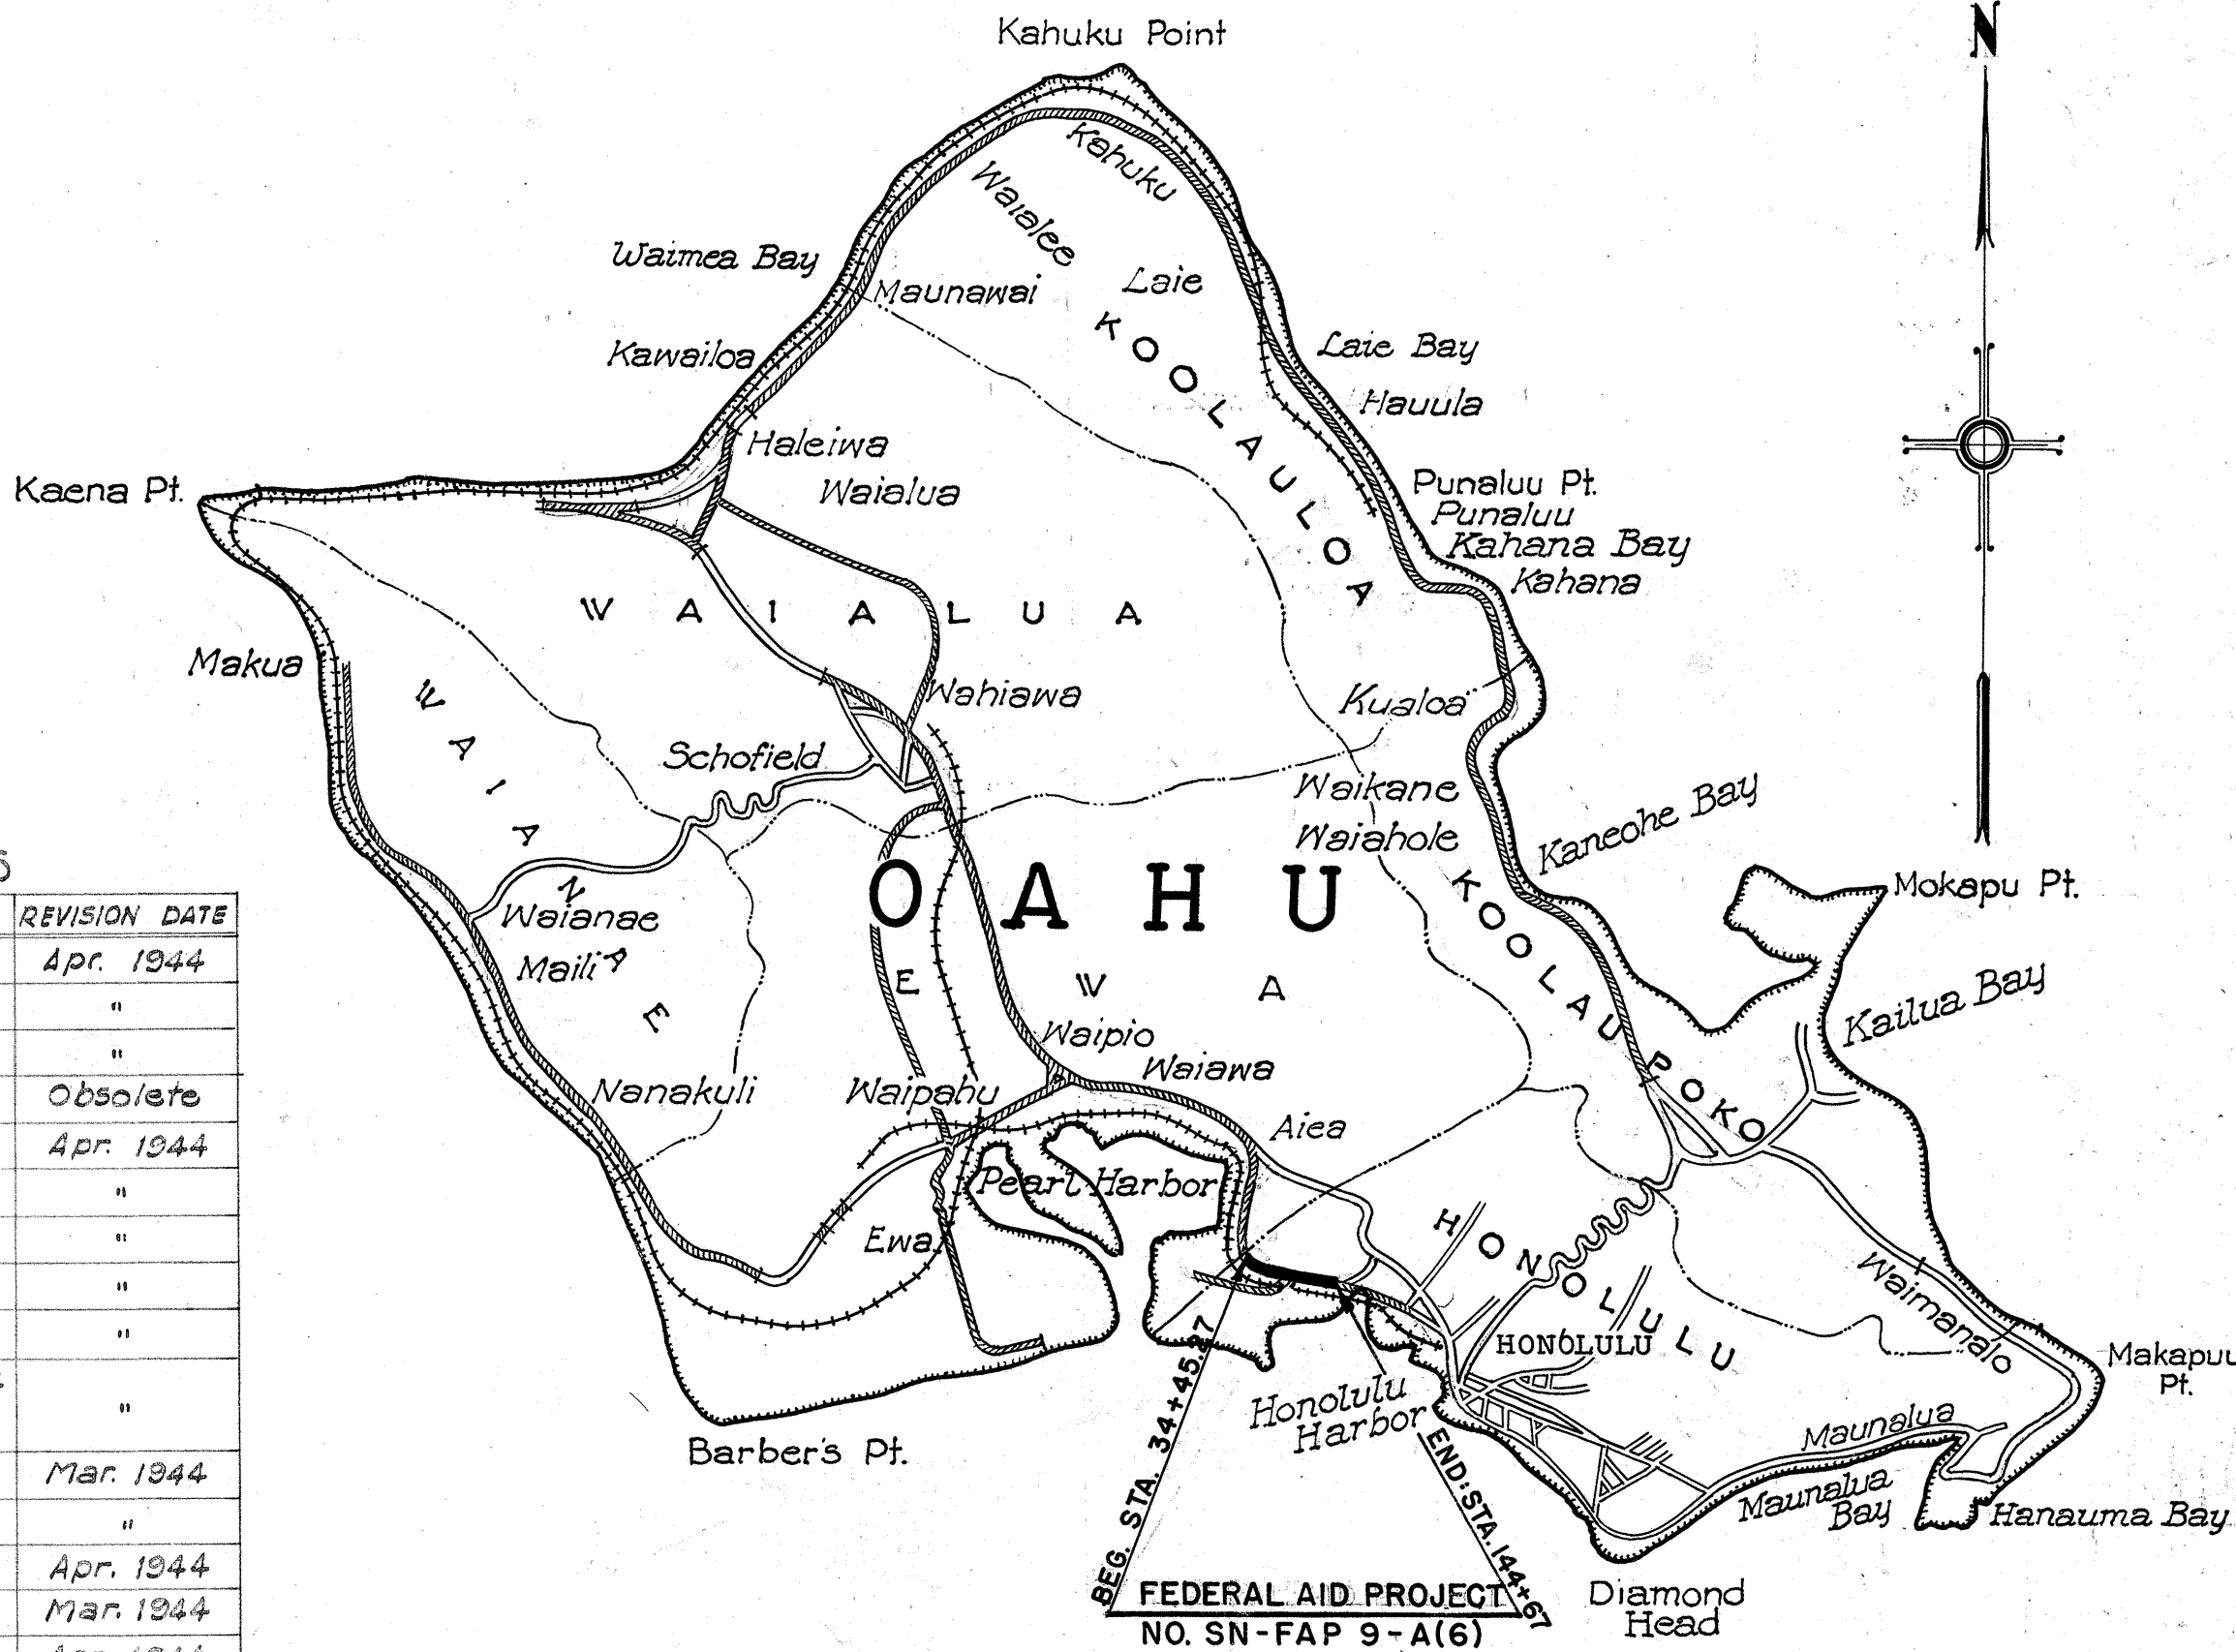

Federal Aid Projects previously constructed or under construction

RECOMMENDED FOR APPROVAL

Prin. Hwy. Engr., Public Roads
Administration, Federal Wks. Agency

RECOMMENDED FOR APPROVAL

Chief Western Region: Public Roads
Administration, Federal Wks. Agency

APPROVED

Commissioner: Public Roads
Administration, Federal Wks. Agency

APPROVED

APPROVED

Territorial Highway Engineer

LAYOUT OF PROJECT
Scale: 1:20,000
LENGTH OF KAMEHAMEHA HIGHWAY, SN-FAP 9-A(6) ... 2.032 MI.
LENGTH OF OLD PEARL HARBOR ROAD EXTENSION ... 0.26 MI.