
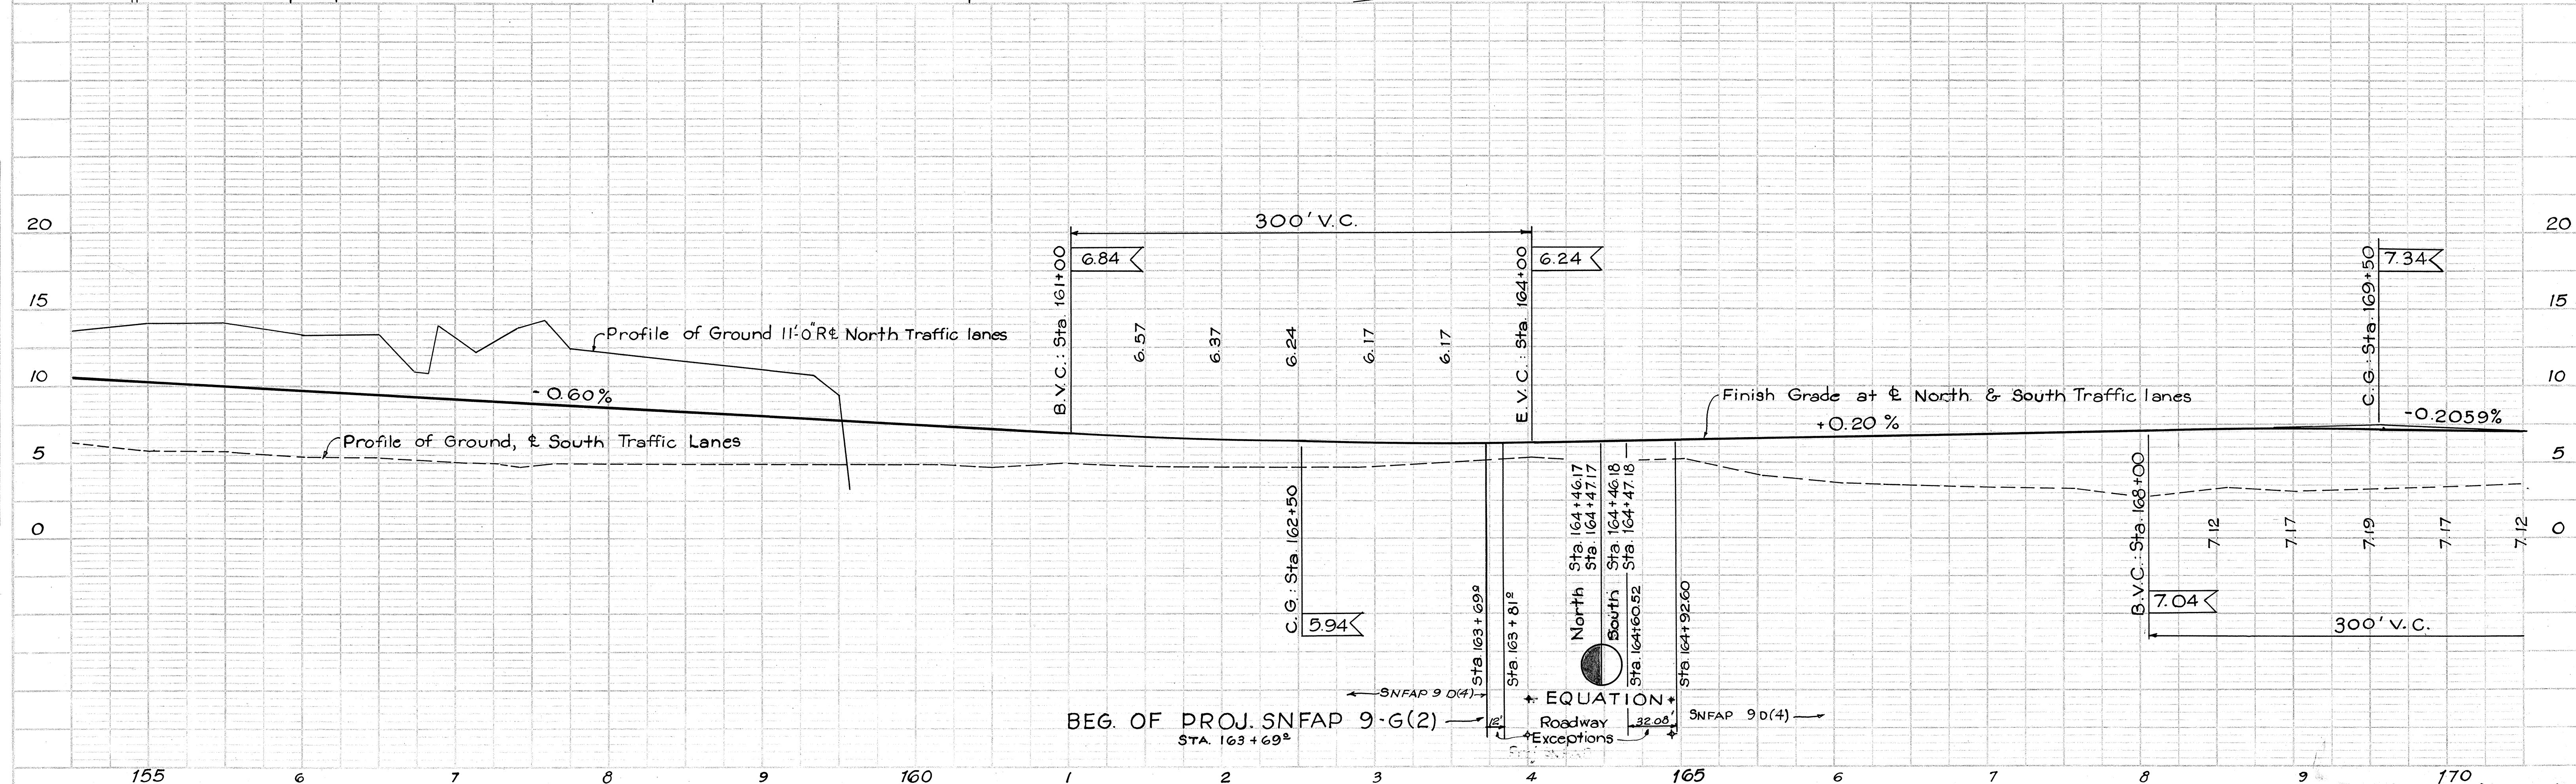


DATE	BY	REVISION
PLAN	SUBMITTER	DATE
	PLANNED	
	DESIGNED	
	CHECKED	
	APPROVED	
	NO. 1	

DATE	BY	REVISION
PROFILE	SUBMITTER	DATE
	PLANNED	
	DESIGNED	
	CHECKED	
	APPROVED	
	NO. 1	

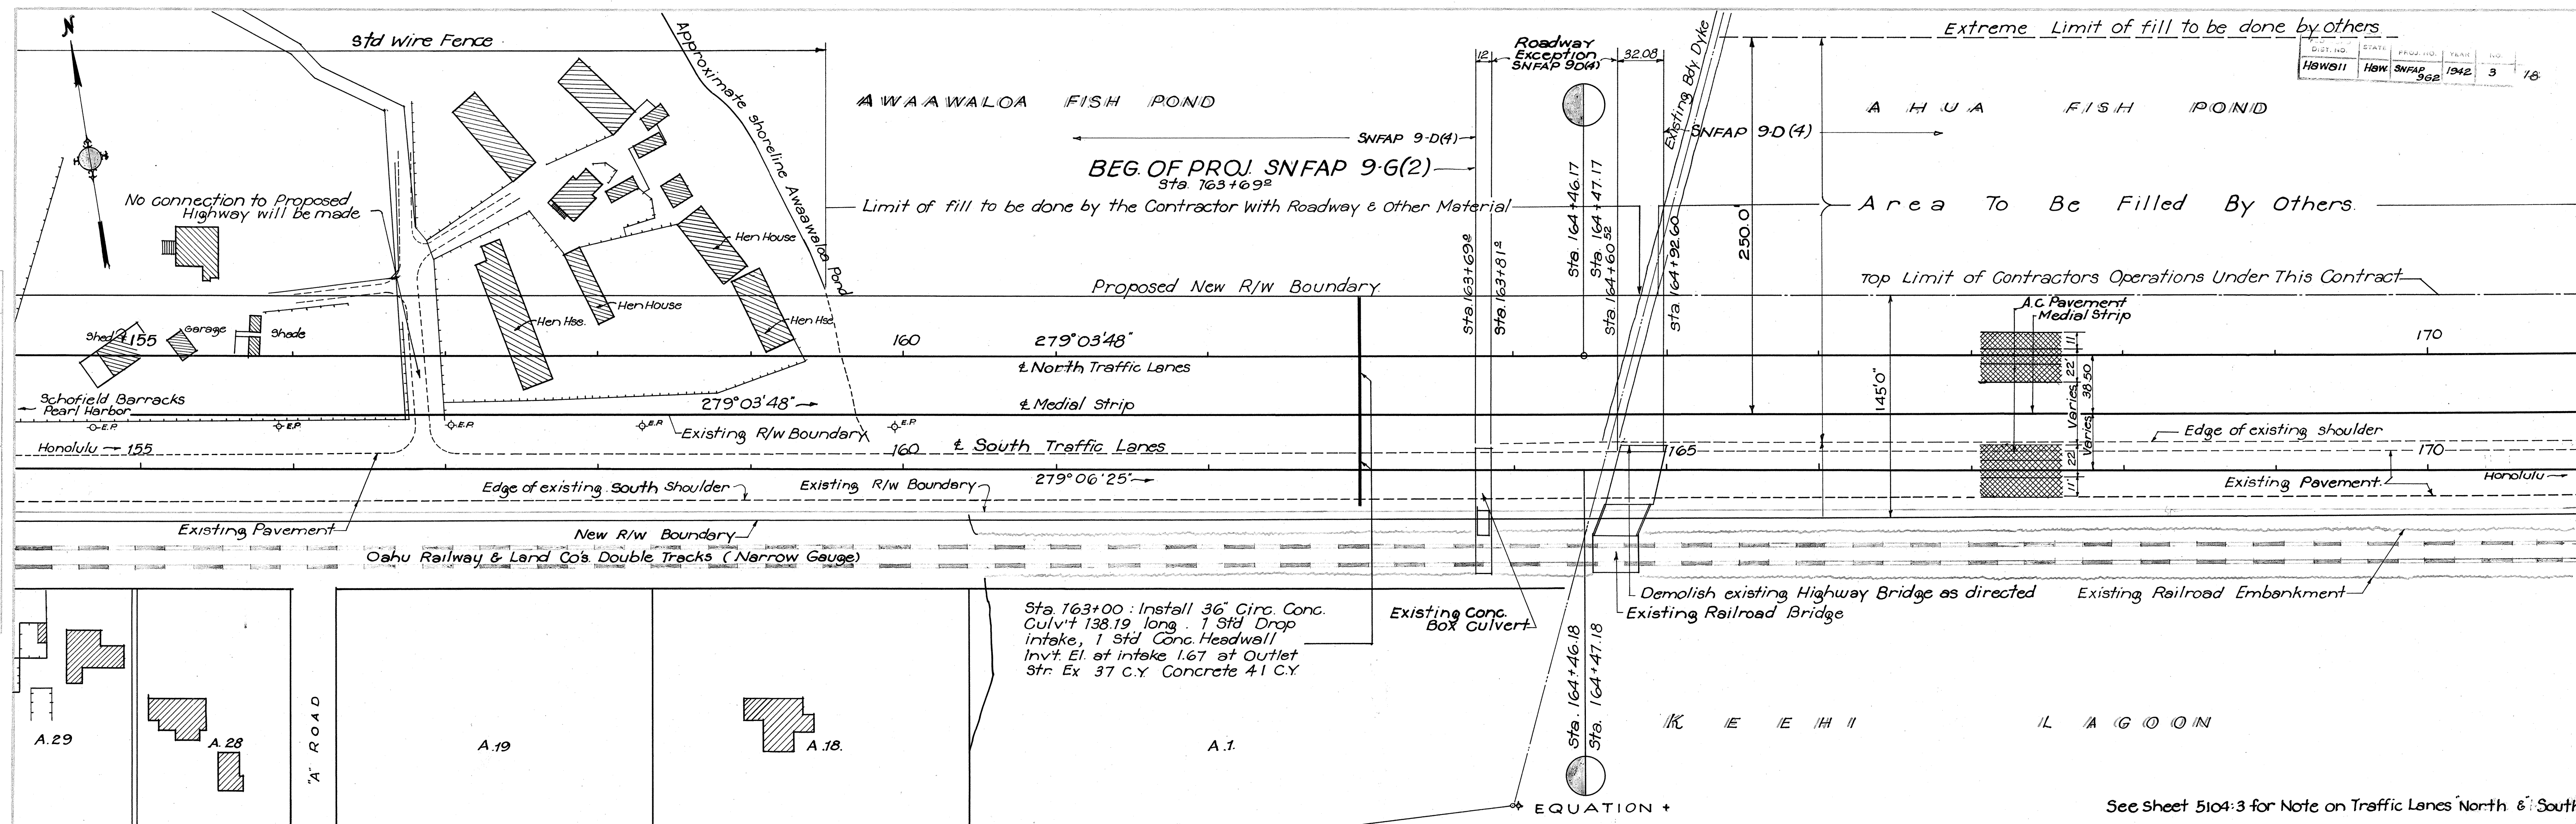

5111.3