



CURVE DATA
 $\Delta = 53^{\circ}08'15''$
 $D = 7^{\circ}00'$
 $R = 818.58'$
 $T = 409.36'$
 $L = 759.17'$

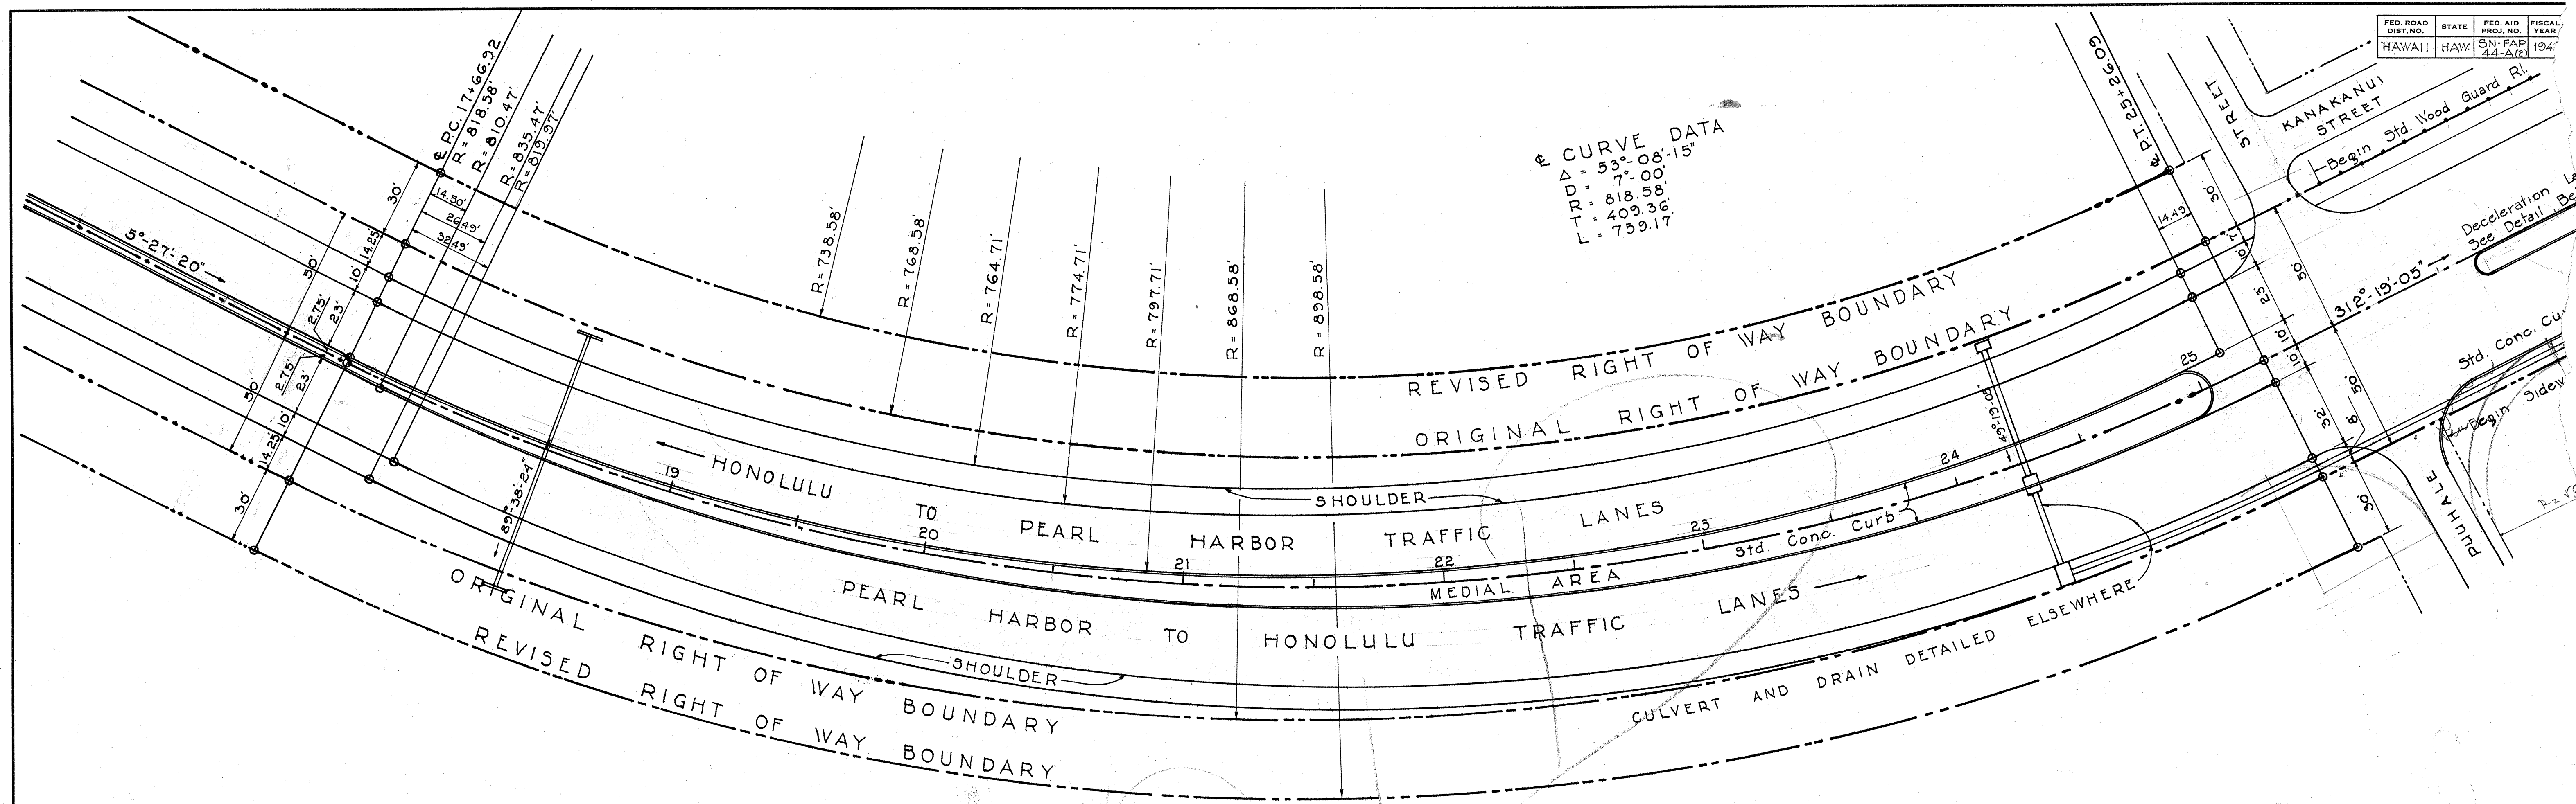

CURVE AT P.I. NO.2
 scale 1 inch=30 feet

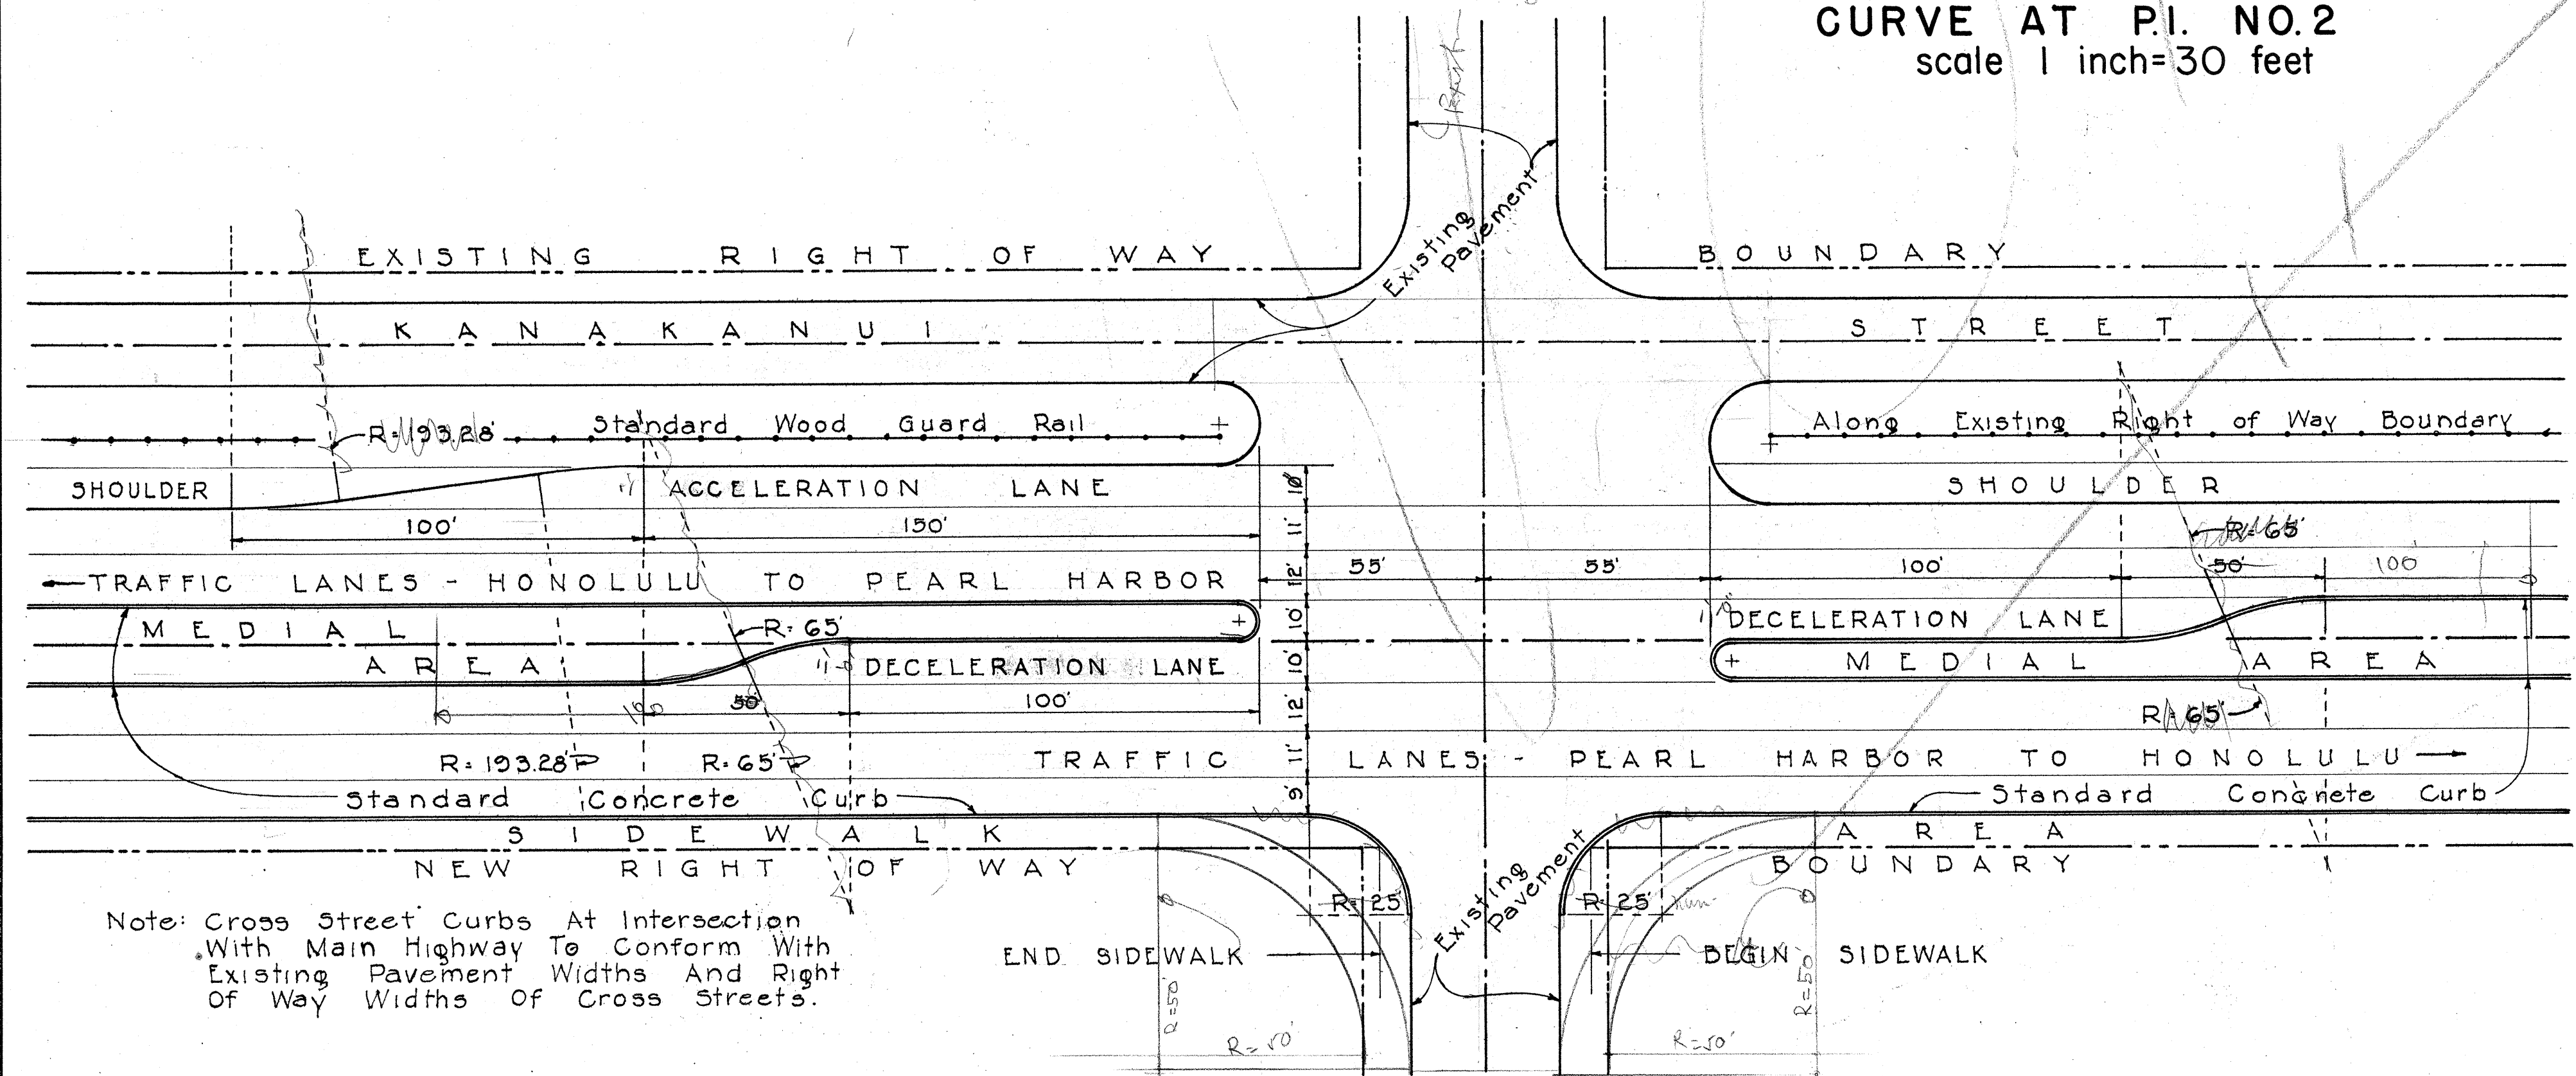

Note: Cross Street Curbs At Intersection
 With Main Highway To Conform With
 Existing Pavement Widths And Right
 Of Way Widths Of Cross Streets.

DETAIL AT INTERSECTION OF MOKAUEA, KALIHI, & LIBBY STREETS
 scale 1 inch = 30 feet

Superseded by revised plan 4/1/47

MISC. DETAILS
 Proj. No. SN-FAP 44-A(2)
 See also note.

TERRITORIAL HIGHWAY DEPARTMENT
 TERRITORY OF HAWAII
 MISC. DETAILS
 PROJECT NO SN-FAP 44-A (2)
 Scales as Noted

SURVEY PLOTTED BY: _____ DATE: _____
 DESIGNED BY: _____
 TRACED BY: _____
 QUANTITIES BY: _____
 CHECKED BY: _____
 ORIGINAL PLAN NOTE BOOK No. _____