
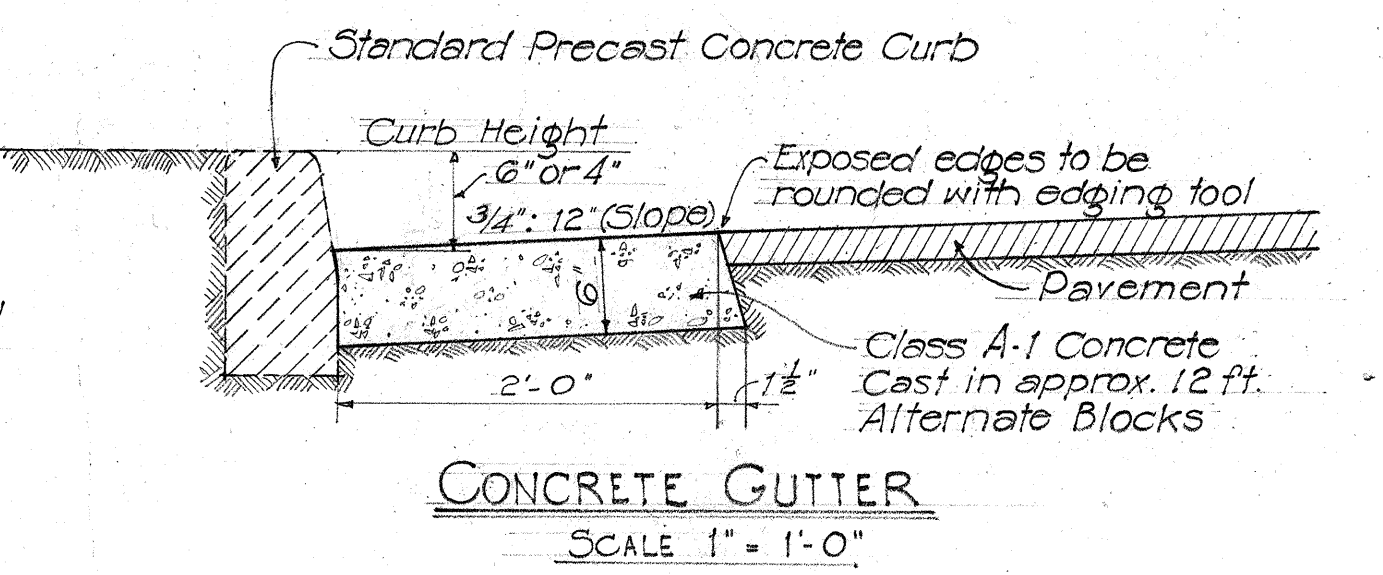
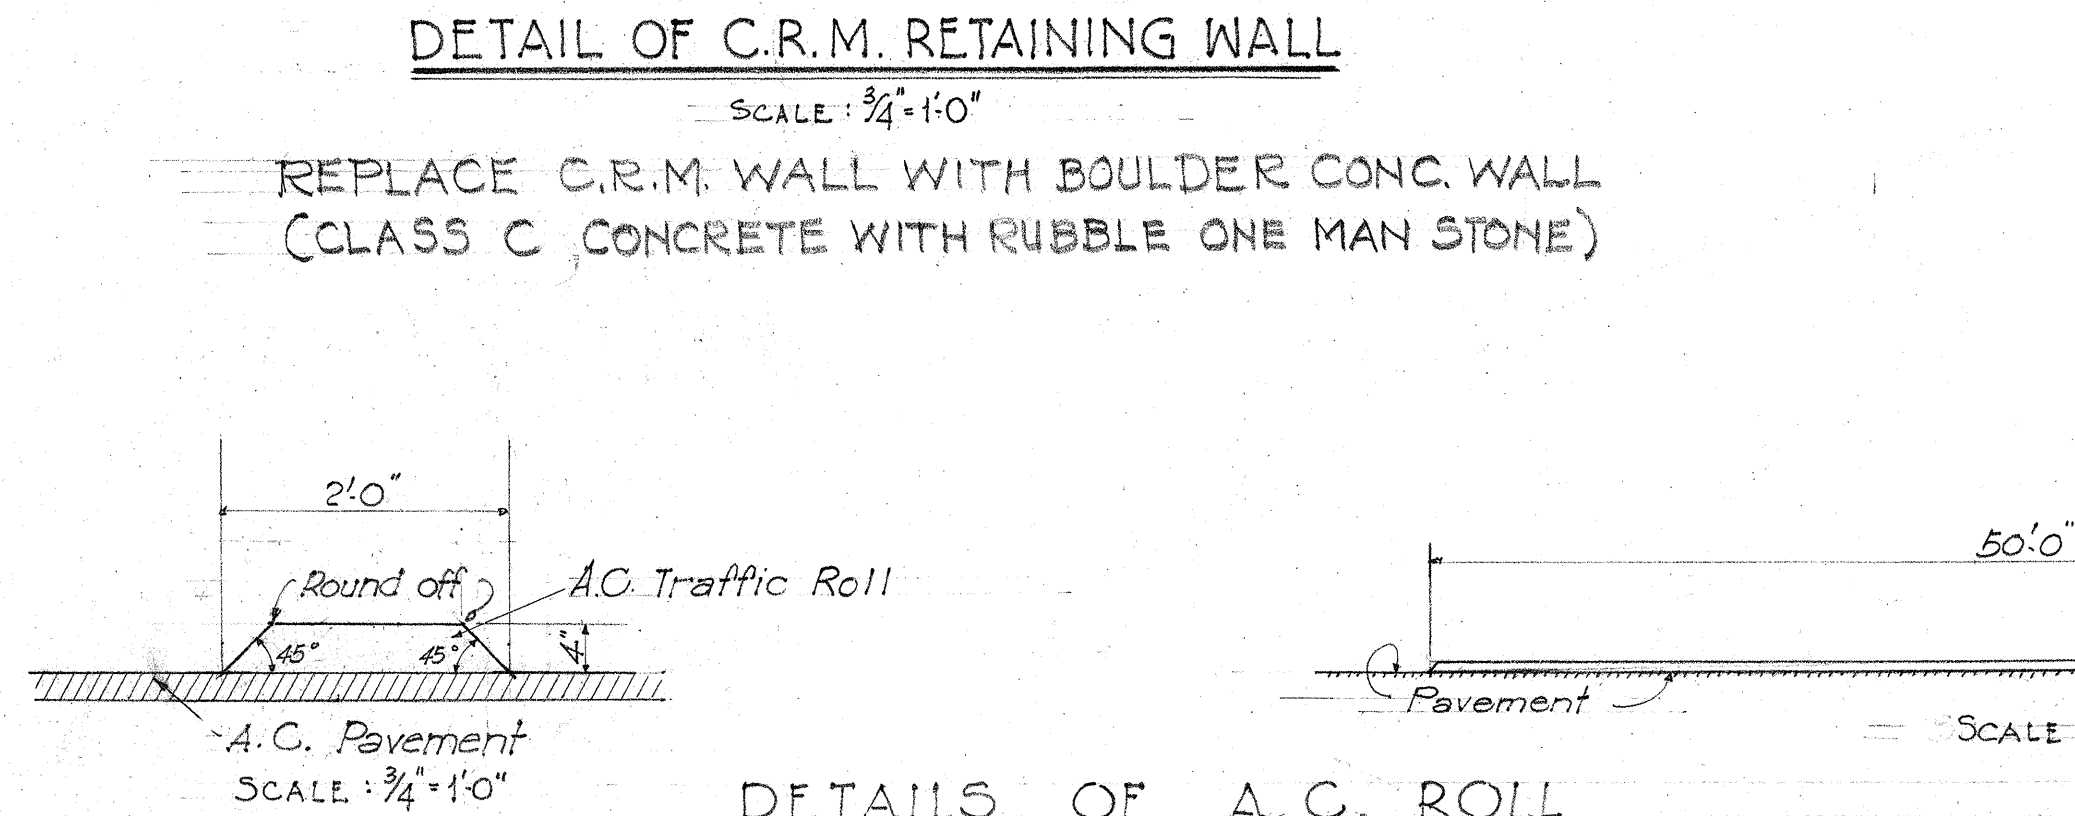
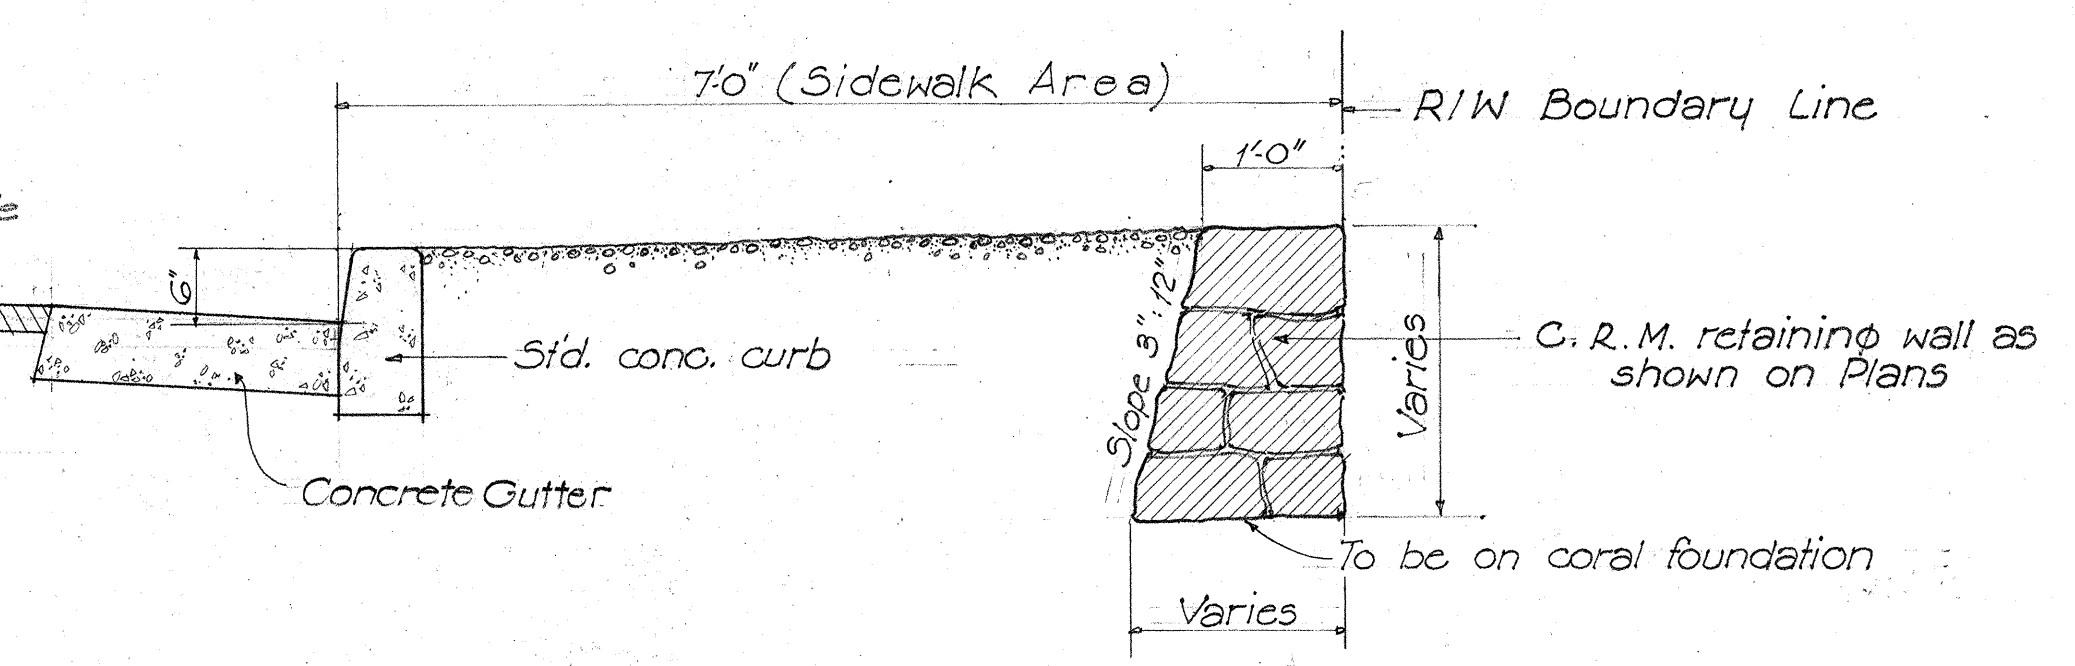
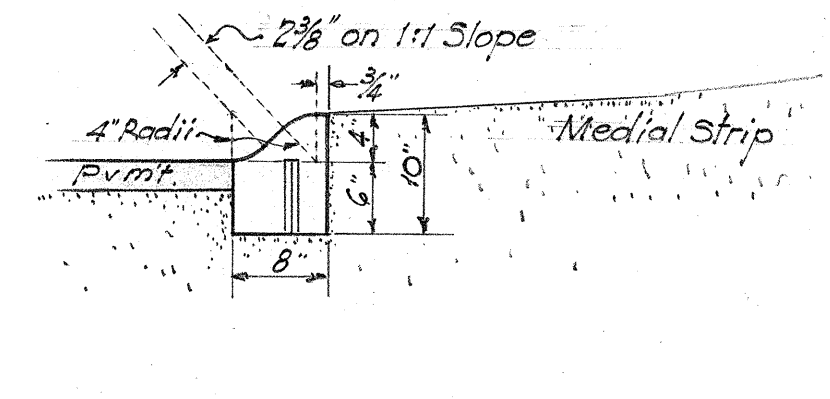
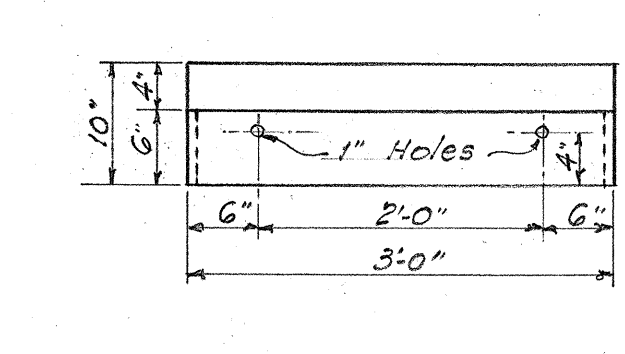
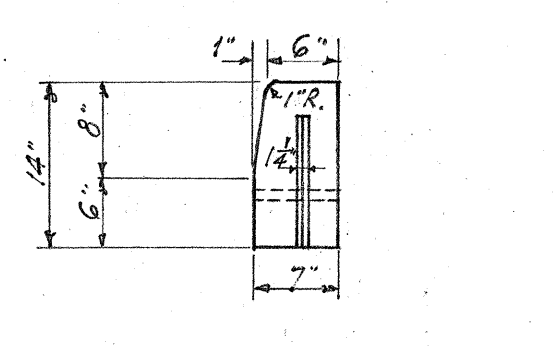
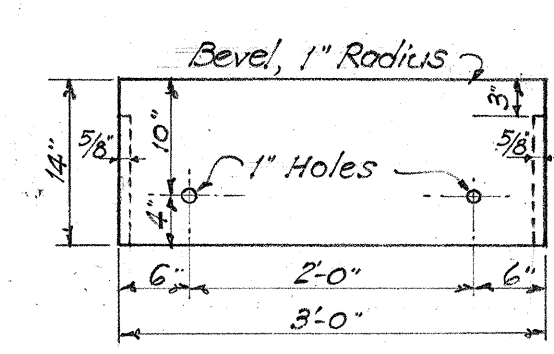
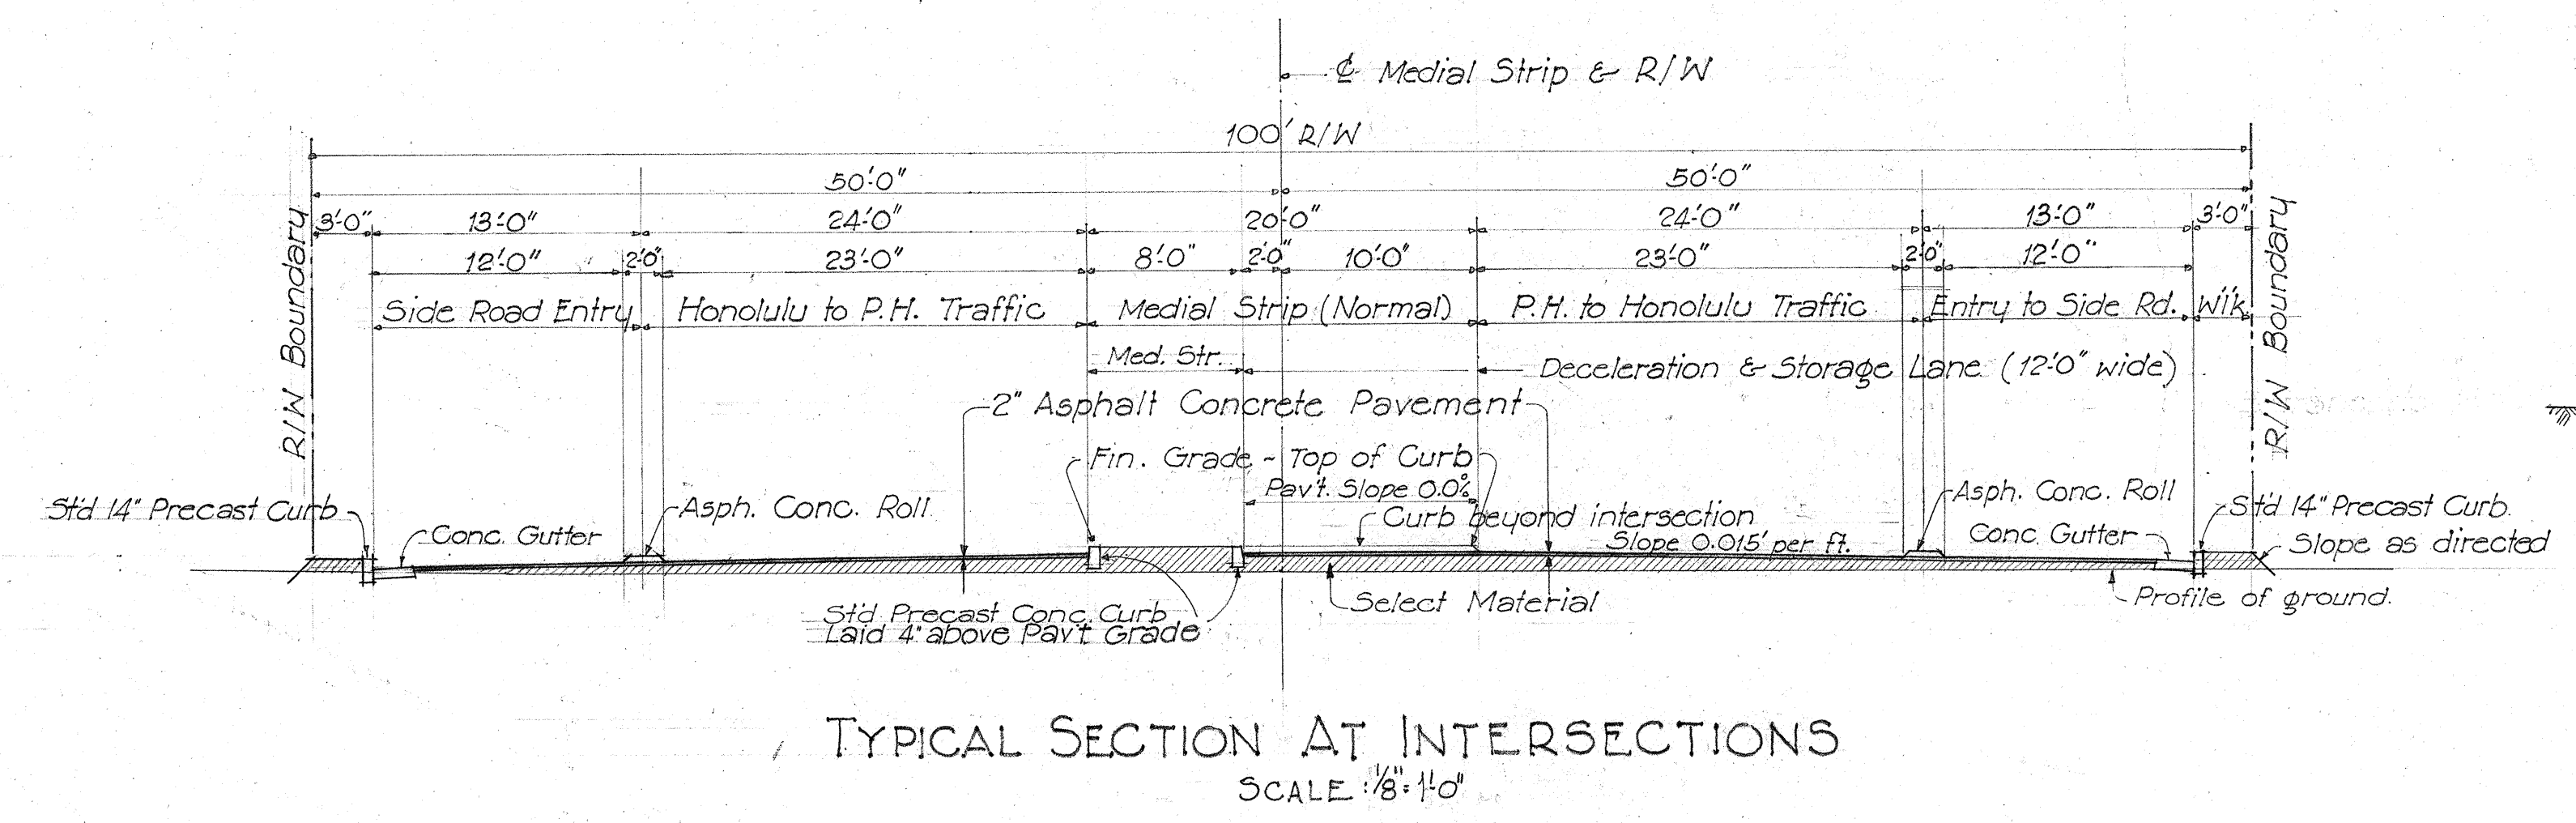
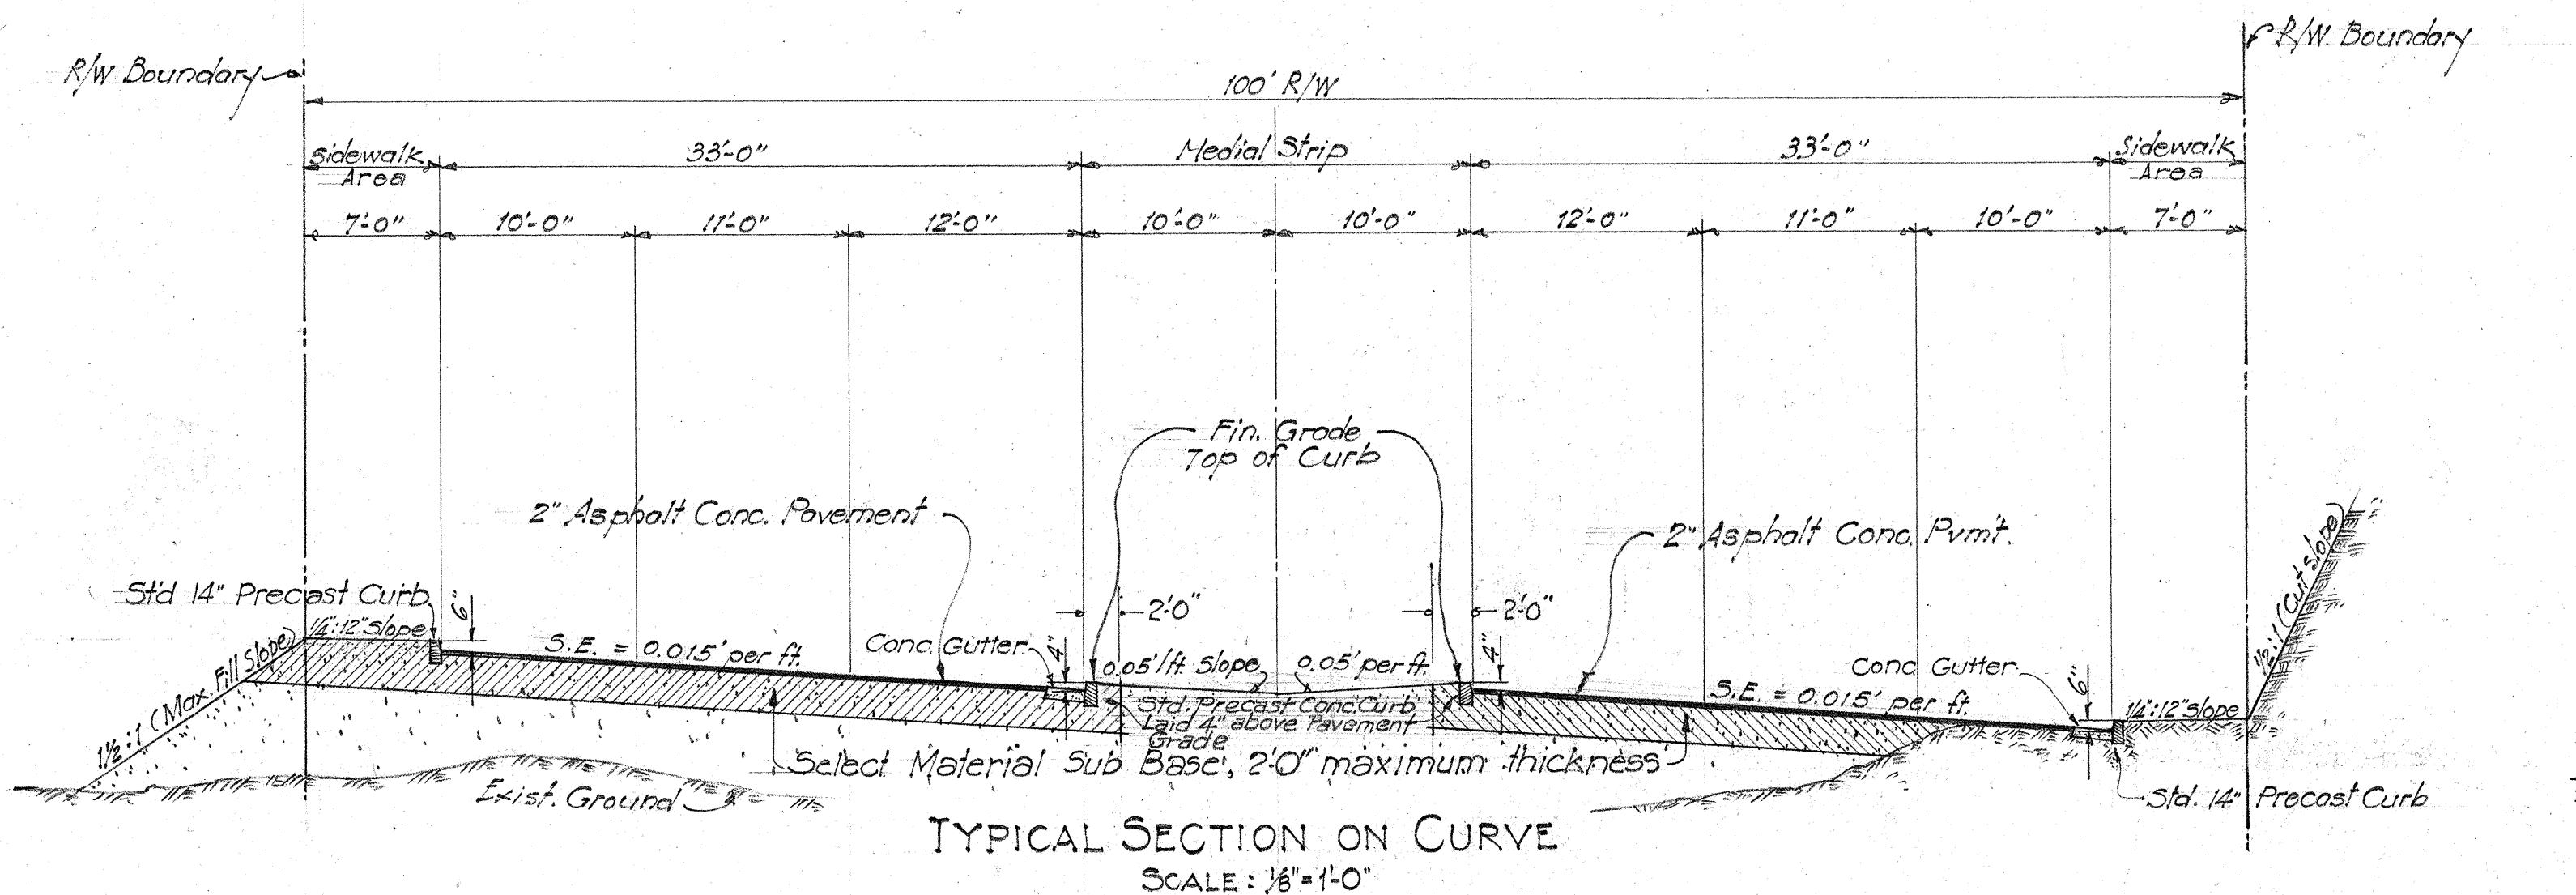


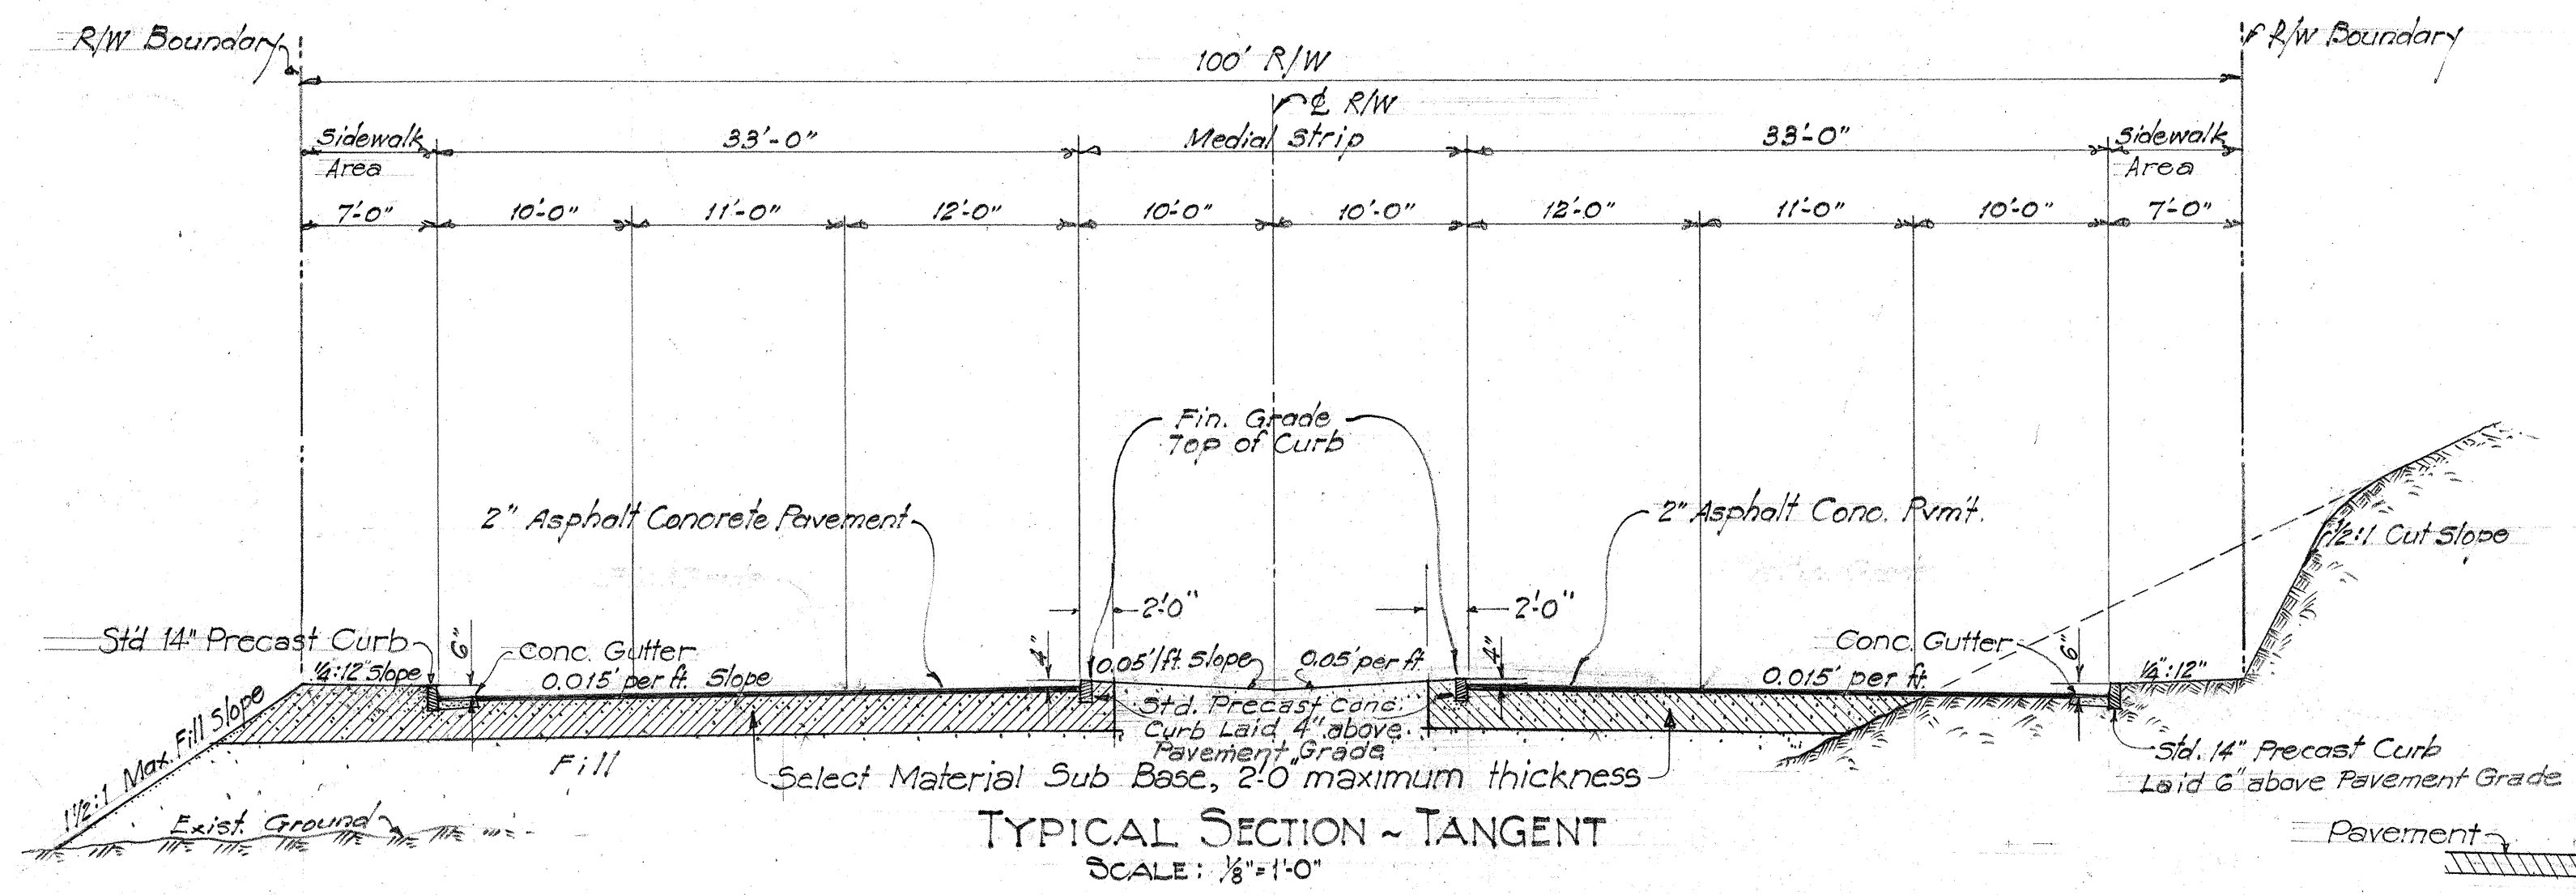

TERRITORIAL HIGHWAY DEPARTMENT
TERRITORY OF HAWAII

TYPICAL SECTIONS
PROJECT NO SN -FAP 44-A(2)

Scales: As Noted

Revised Date: April 1, 1944

SURVEY PLOTTED BY	DATE
TRACED BY	
NOTED BY	
CHECKED BY	
ORIGINAL PLAN	
NOTE BOOK	
NO.	