


ORIGINAL PLAN	DATE
SURVEY PLOTTED BY	
DESIGNED BY	
DRAWN BY	
CHECKED BY	
NOTED BY	
QUANTITIES CHECKED BY	
NO.	

Checked by: J.O.R.
 Revision: May 10, 1944
 Revision: Mar 4, 1944
 Revised Layout 2/28/44
 Curb Legend Revised 3-30-44

FED. ROAD DIST. NO.	STATE	FED. AID PROJ. NO.	FISCAL YEAR	SHEET NO.	TOTAL SHEETS
Hawaii	Haw.	DANR100	1944	5-A	12

FED. ROAD DIST. NO.	STATE	FED. AID PROJ. NO.	FISCAL YEAR	SHEET NO.	TOTAL SHEETS
Hawaii	Haw.	DANR100	1943	3D	12

FED. ROAD DIST. NO.	STATE	FED. AID PROJ. NO.	FISCAL YEAR	SHEET NO.	TOTAL SHEETS
Hawaii	Haw.	SNFAP 9-D(4)	1944	8	12

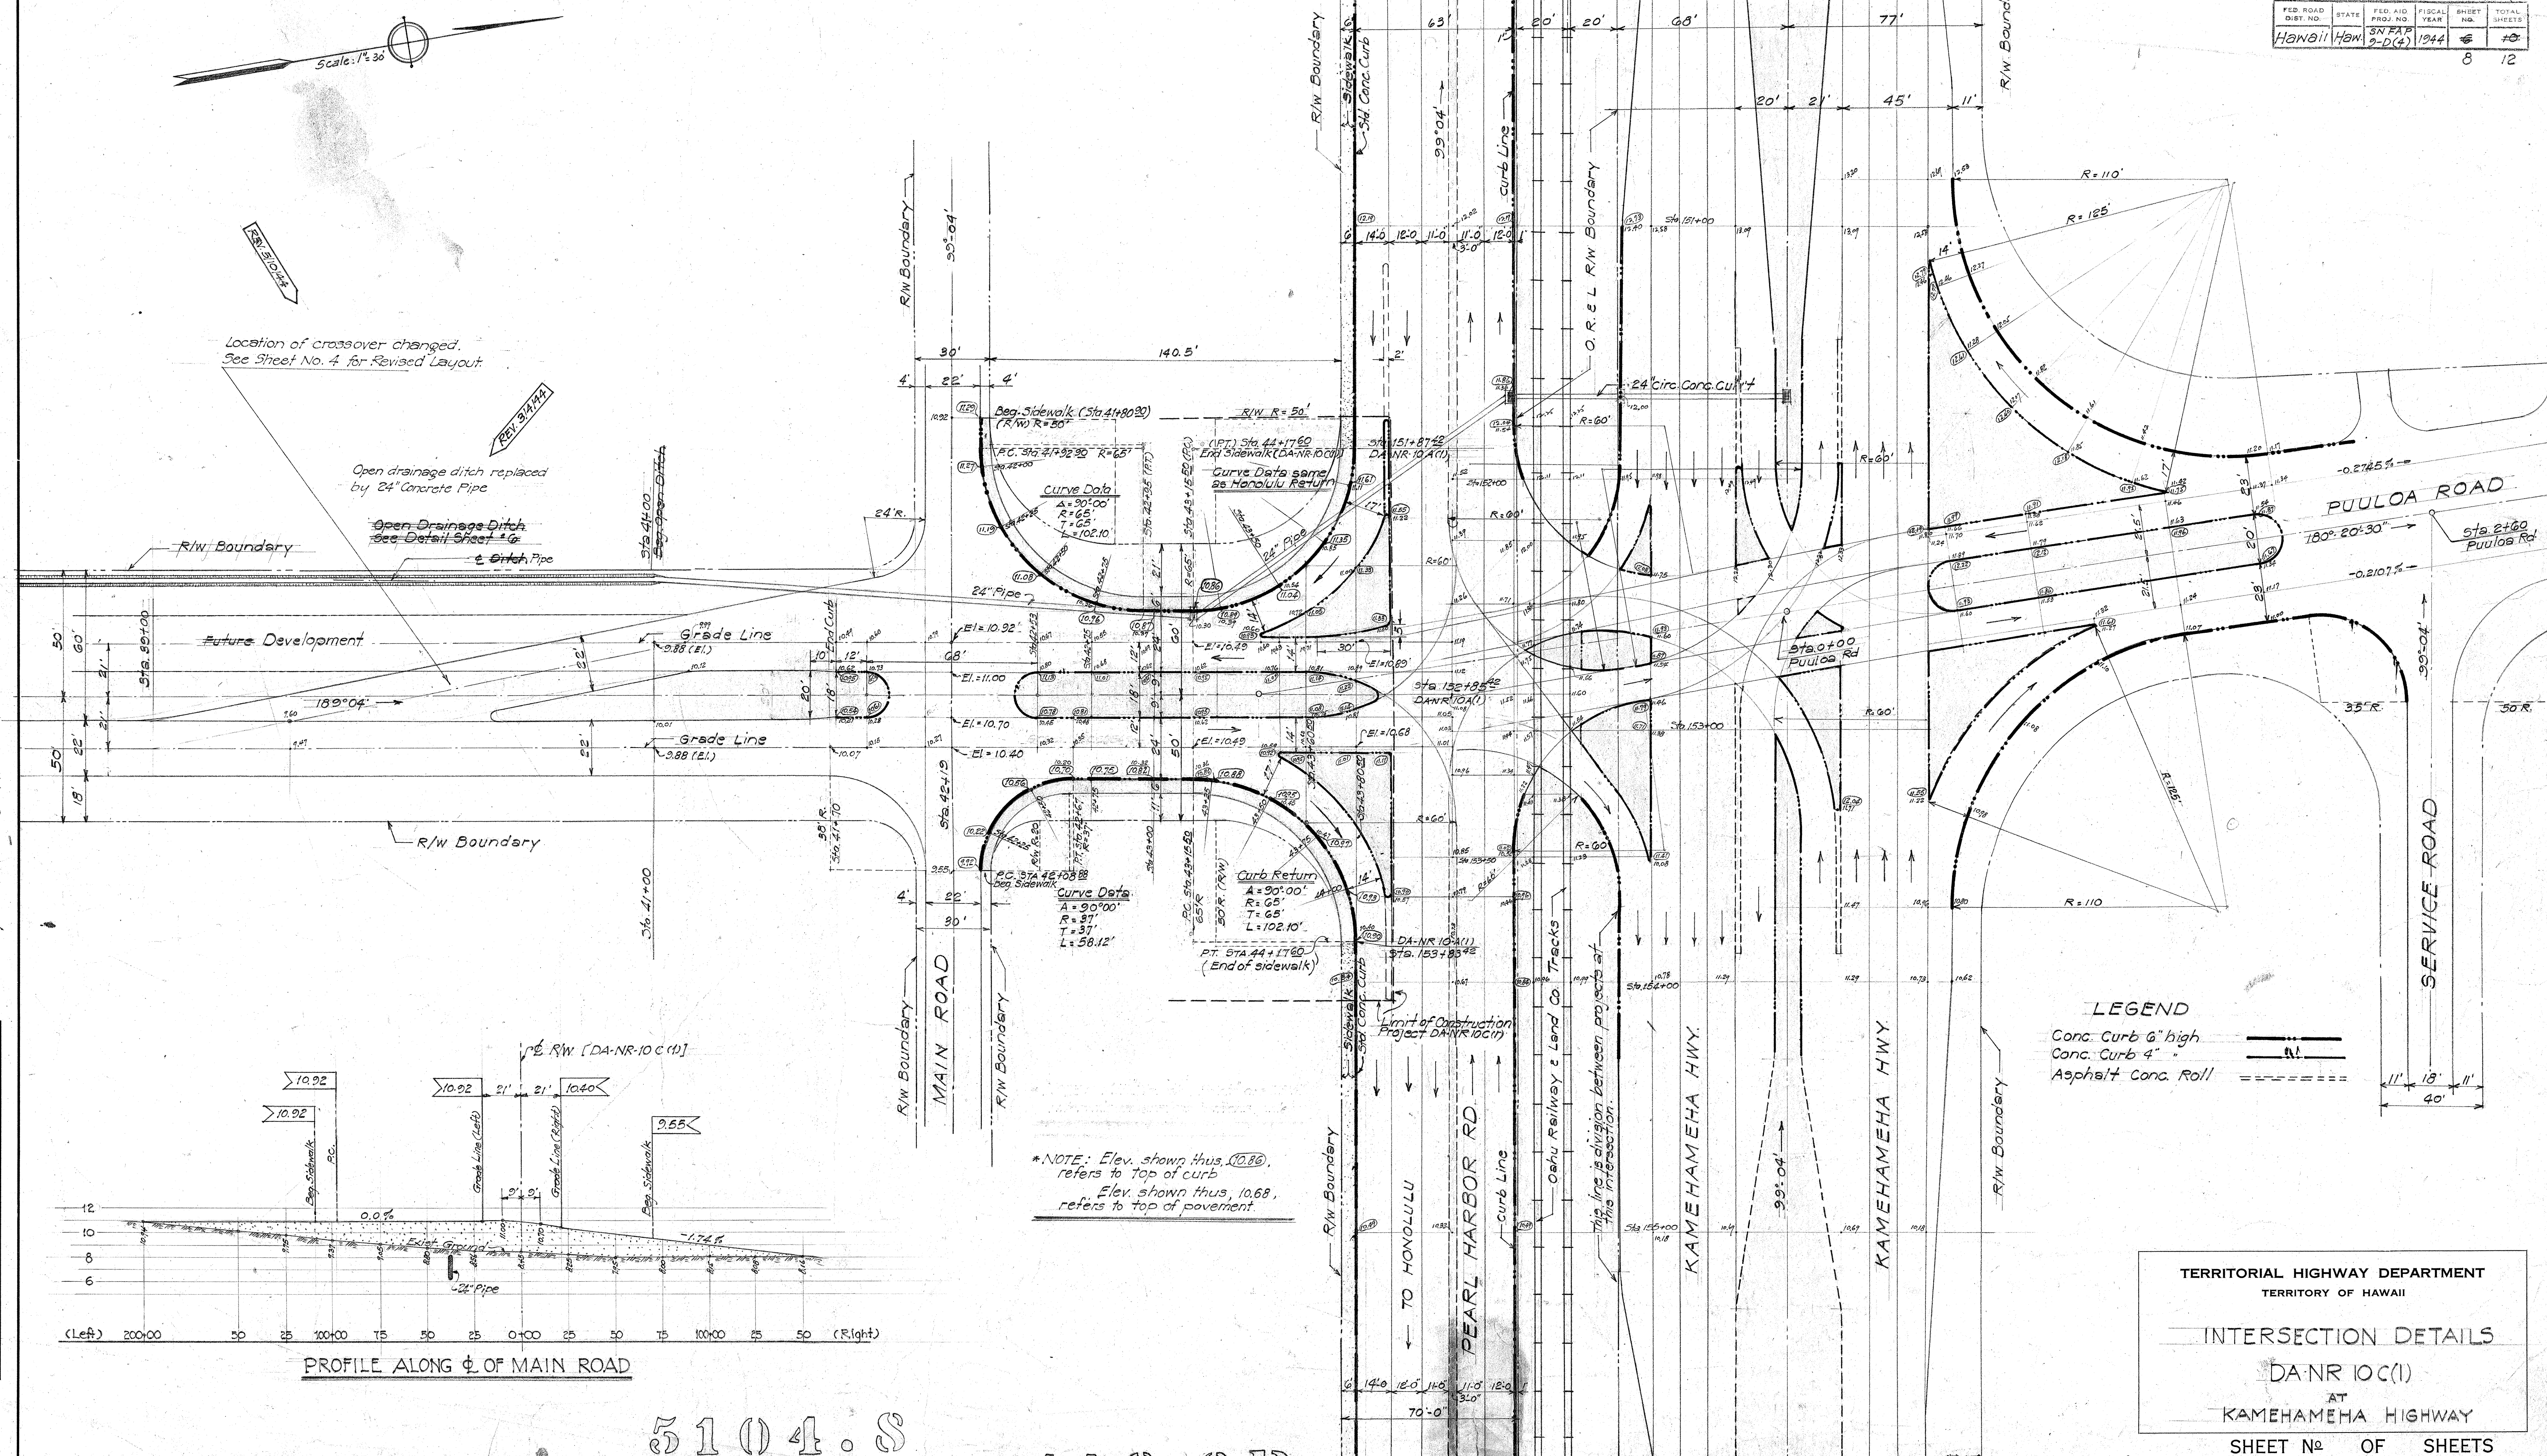

5104.S 5118.3D PART OF 5118 5132 514