


INDEX TO DRAWINGS	
SHEET NO.	DESCRIPTION
1	Title Sheet
2-3	Typical Sections
4-11A	Plan & Profile, Curve Data
12-13	Standard Details
14	Miscellaneous
15	Catch Basin Detail
16-26	Cross Sections

Centerline	175
Boundary (Not Fenced)	
Boundary (Fenced)	
Existing Road	
Railroad Track	
Circular Conc. Culvt.	
Concrete Box Culvt.	
Bridge	
Telephone Pole	
Electric Pole	
Coconut Palm	

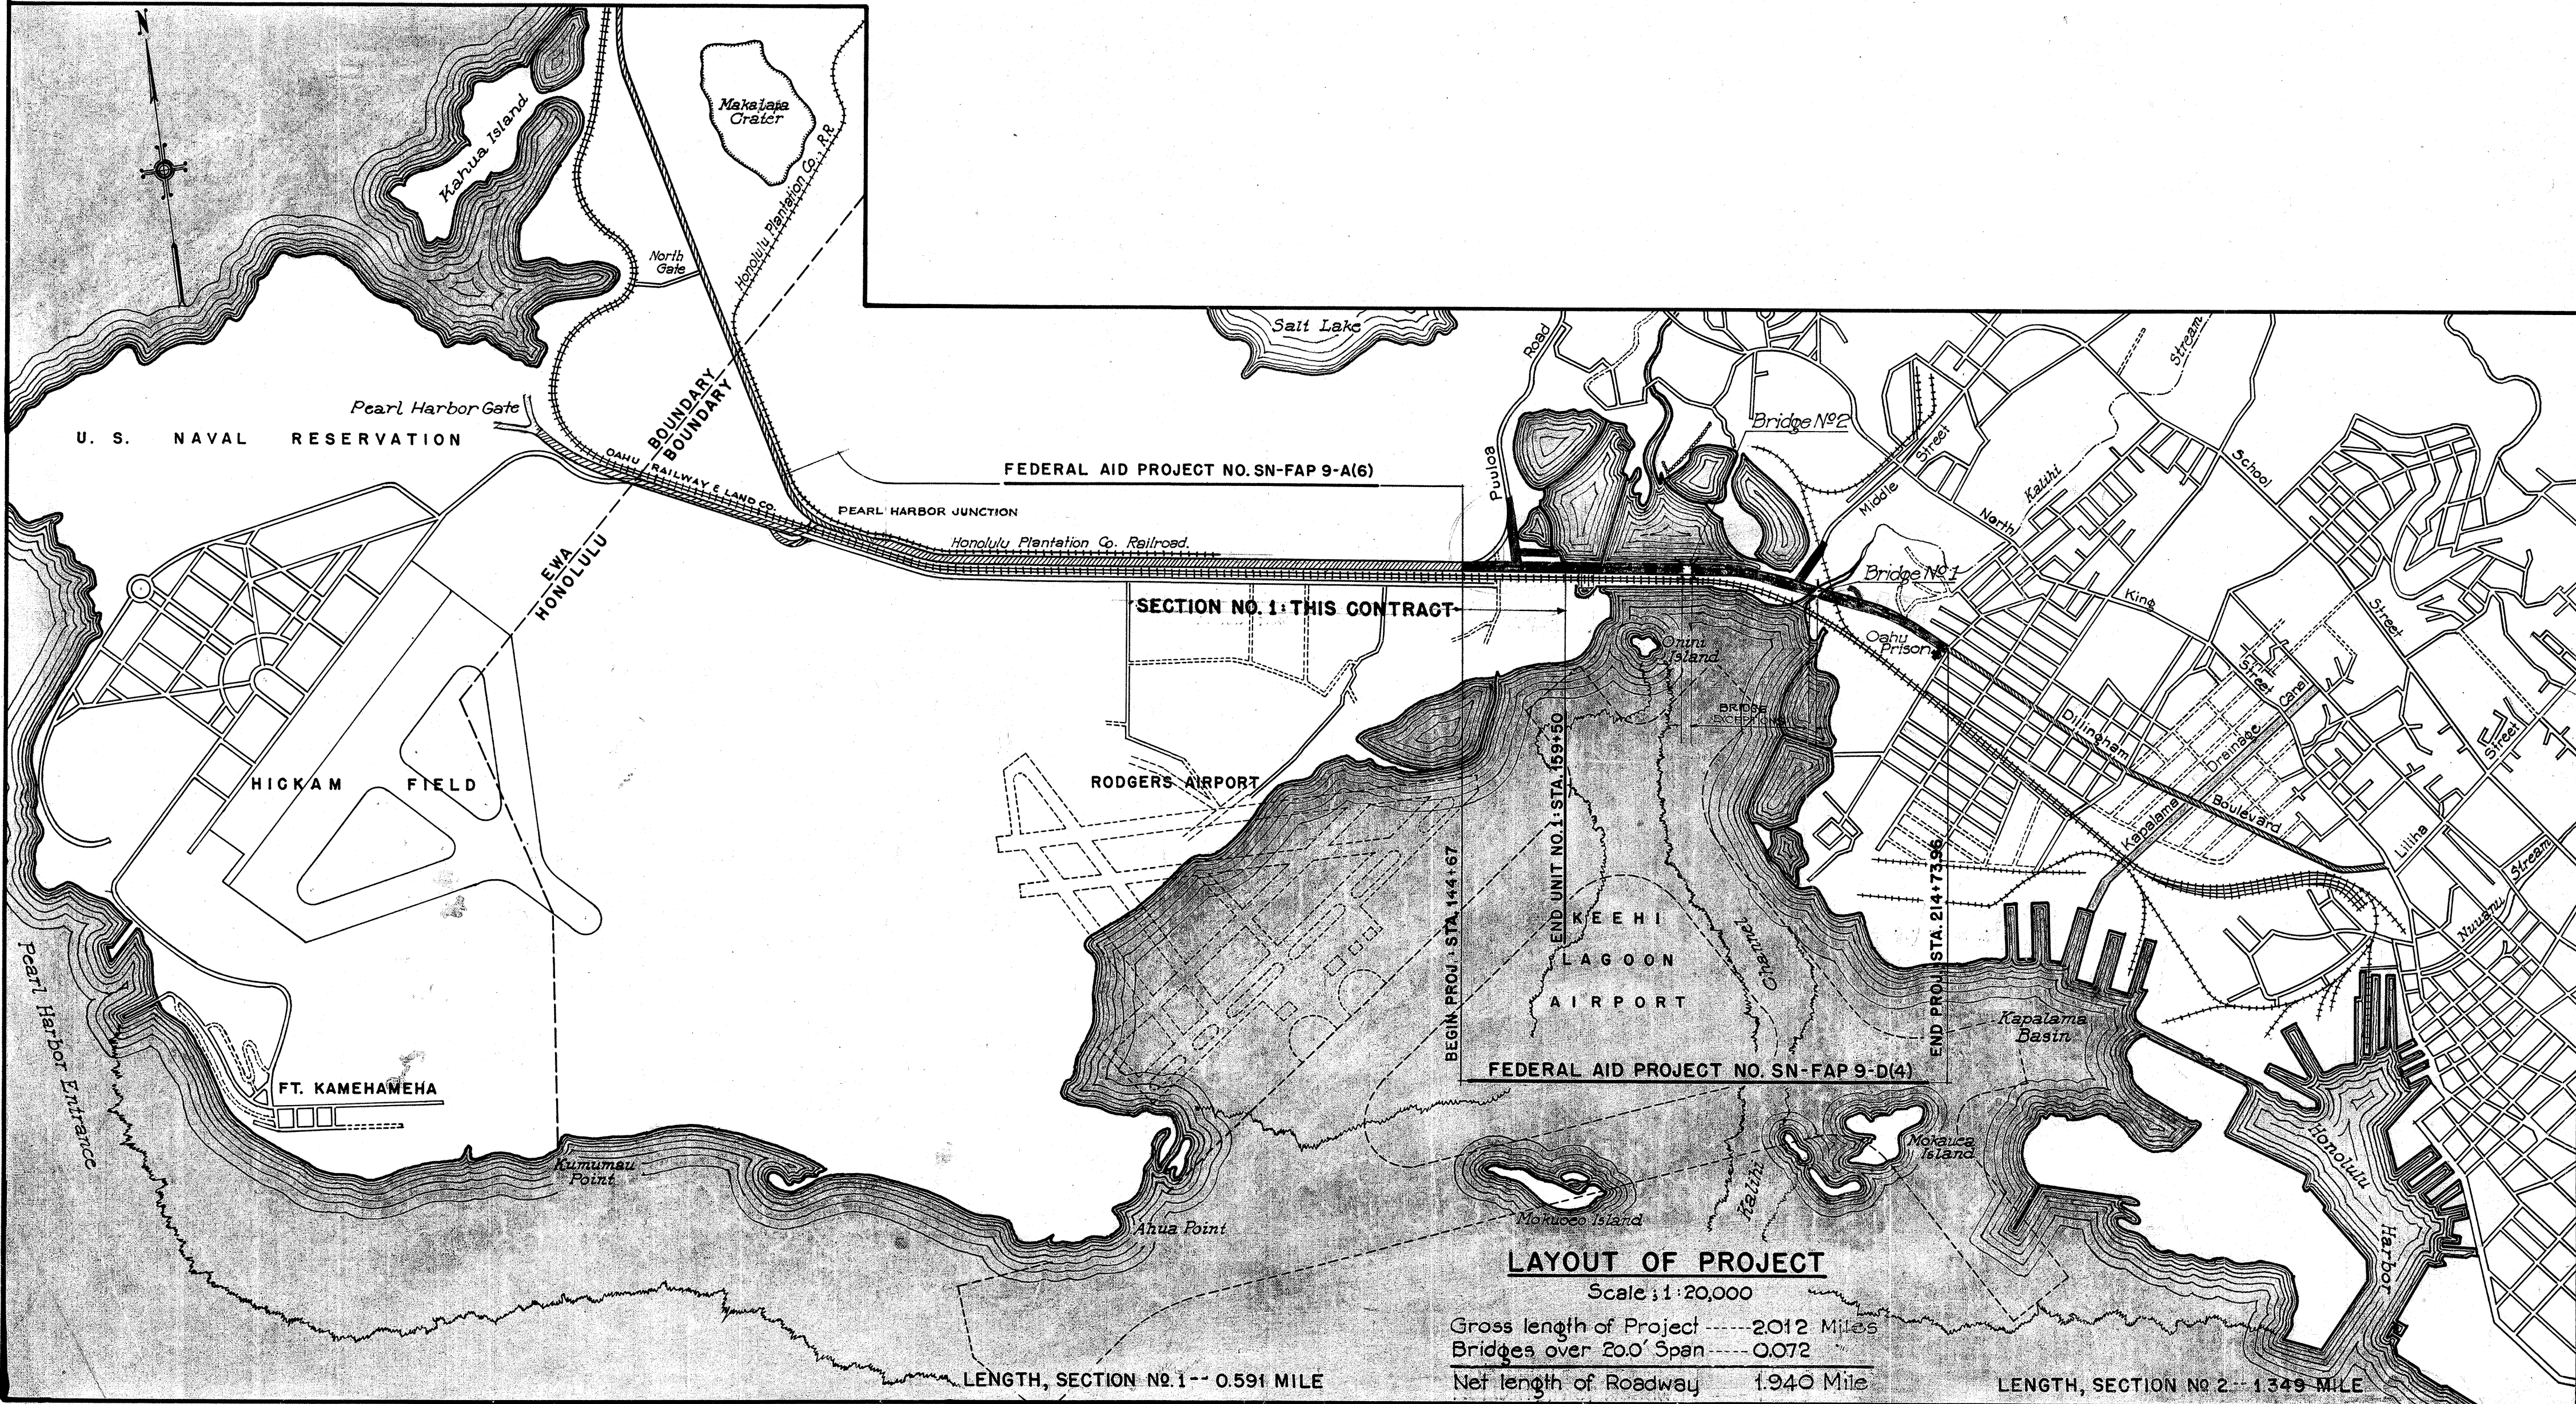


TERRITORY OF HAWAII
TERRITORIAL HIGHWAY DEPARTMENT
HONOLULU T.H.

PLANS OF
KAMEHAMEHA HIGHWAY
PUULOA ROAD TO OAHU PRISON
FEDERAL AID PROJECT NO. SN-FAP 9-D(4) *500.1*

HONOLULU DISTRICT
ISLAND OF OAHU

SCALE

PLAN	1 INCH = 50 FEET
PROFILE	HOR., 1 INCH = 50 FEET VER., 1 INCH = 5 FEET
CROSS SECTIONS	HOR., 1 INCH = 10 FEET VER., 1 INCH = 10 FEET

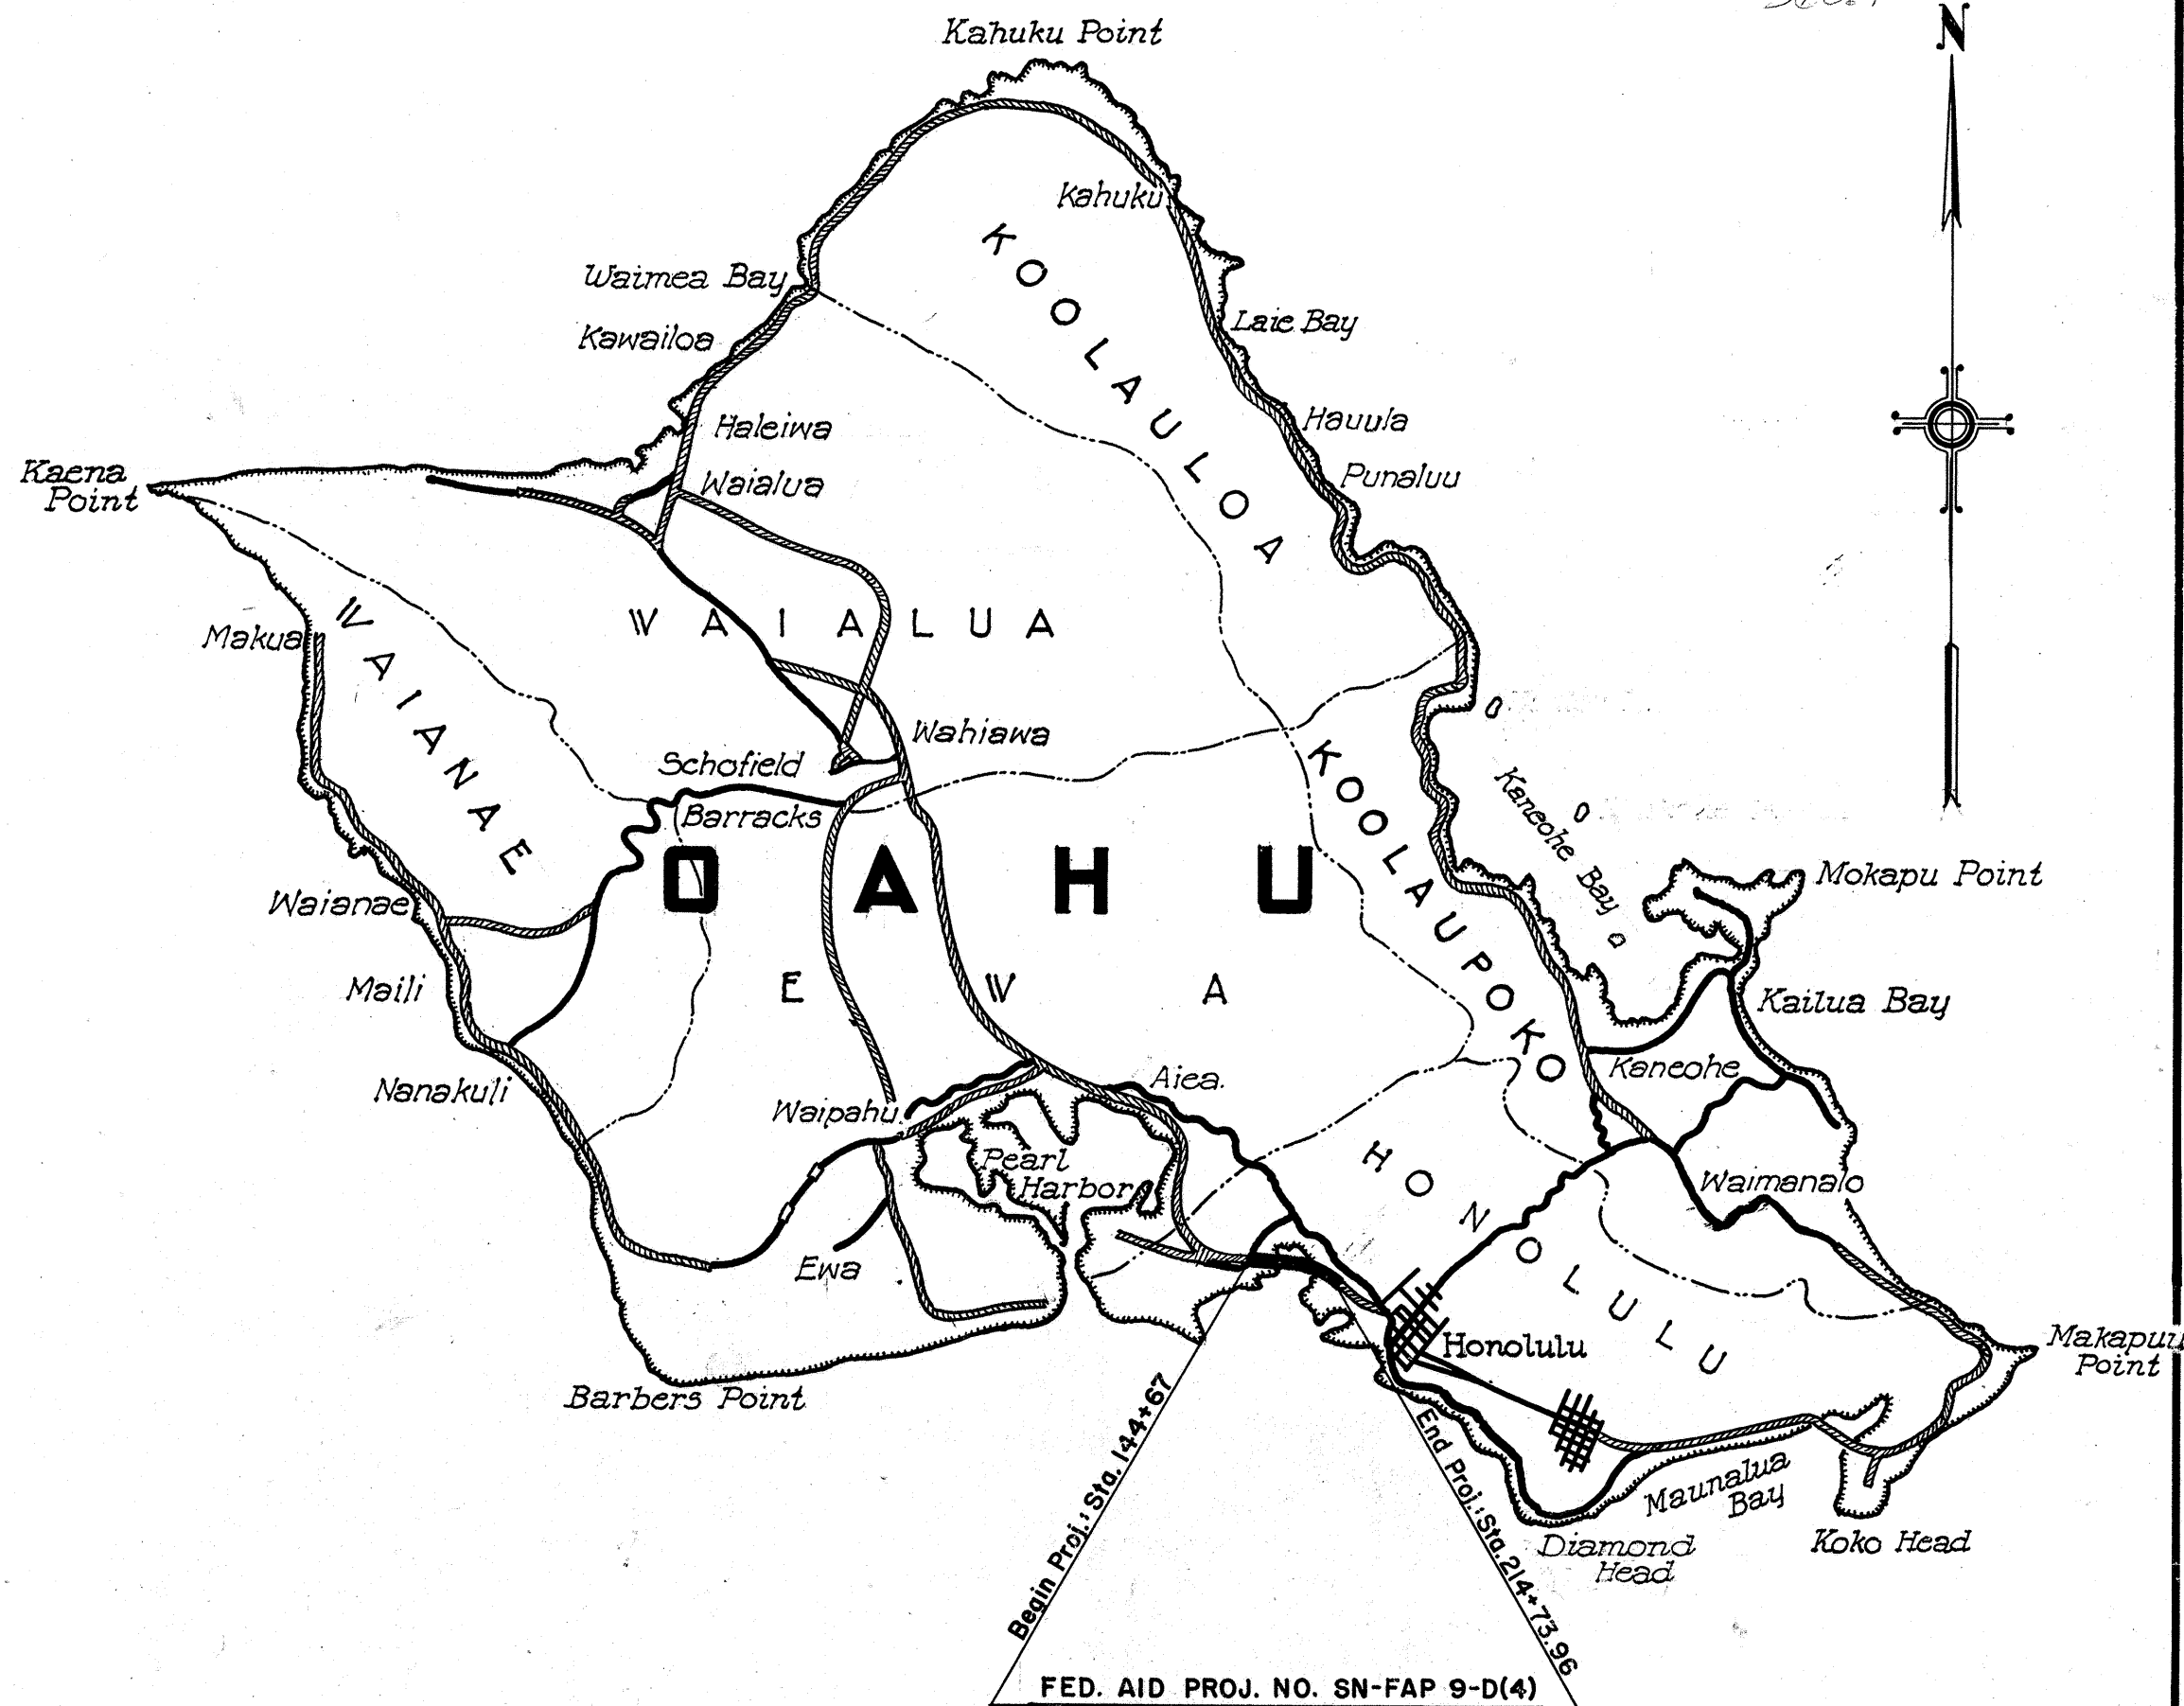

Federal Aid Projects previously constructed or under construction

INDEX TO DRAWINGS			
REFERENCE NO.	DESCRIPTION	SHEET NO.	REVISED DATE
1	Title Sheet	5104. 1	May 1944
2	Typical Sections	5104. 2	" "
3	Plan & Profile	5104. 3	" "
4	" " "	5104. 4	" "
5	" " "	5104. 5	" "
6	Standard Details	5104. 6	" "
7	" " "	5104. 7	" "
8	Intersection Details	5104. 8	" "
9	Cross Sections	5104. 9	" "
10	" " "	5104. 10	" "
11	" " "	5104. 11	" "
12	" " "	5104. 12	" "

APPROVED
B. F. Rush
Territorial Highway Engineer
Date: 5-20-44

APPROVED

APPROVED
R. B. Ball
Territorial Highway Engineer
Date:

RECOMMENDED FOR APPROVAL
PRINCIPAL HIGHWAY ENGINEER
Public Roads Administration
Federal Works Agency

RECOMMENDED FOR APPROVAL
CHIEF, WESTERN REGION
Public Roads Administration
Federal Works Agency

APPROVED
COMMISSIONER
Public Roads Administration
Federal Works Agency