



FED. ROAD DIST. NO.	STATE	FED. AID PROJ. NO.	FISCAL YEAR	SHEET NO.	TOTAL SHEETS
HAWAII	HAW	DAWR5(1)	1944	4	13

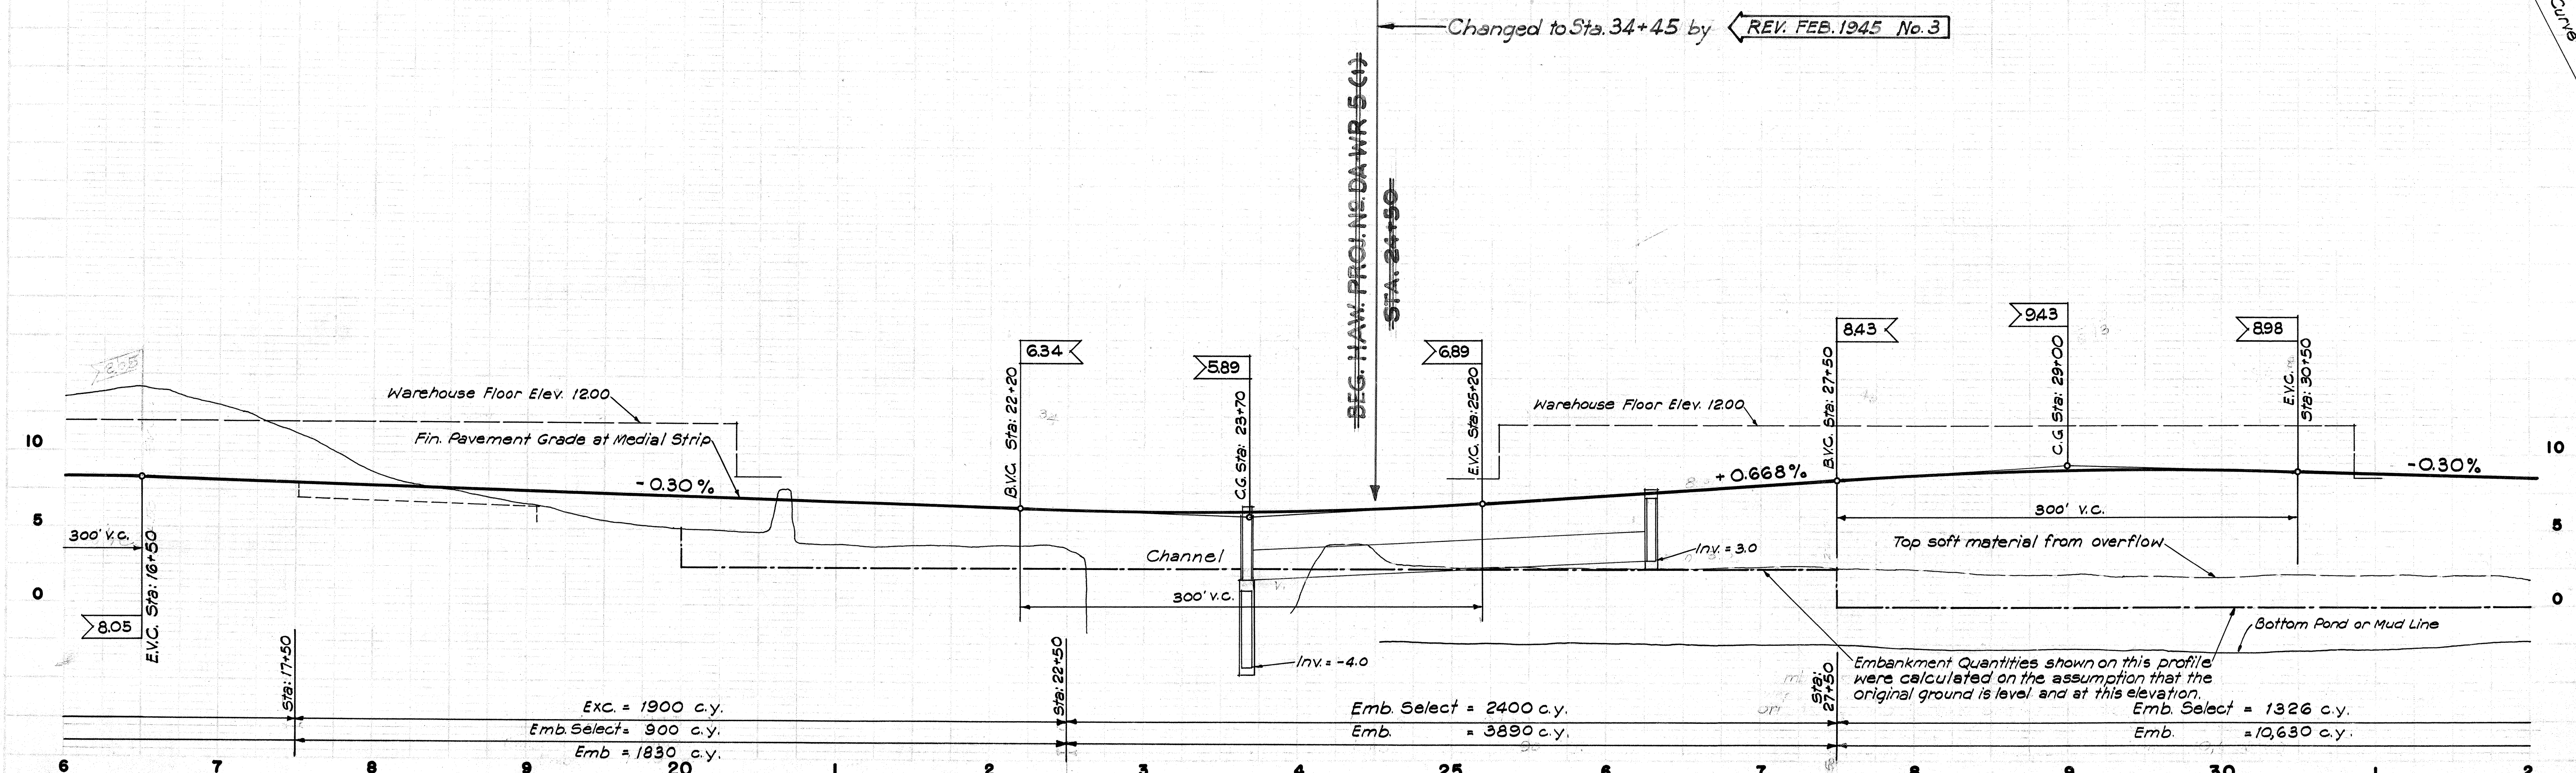



5136.4

REV. DEC. 1944
REV. SEPT. 1944
REV. FEB. 1945

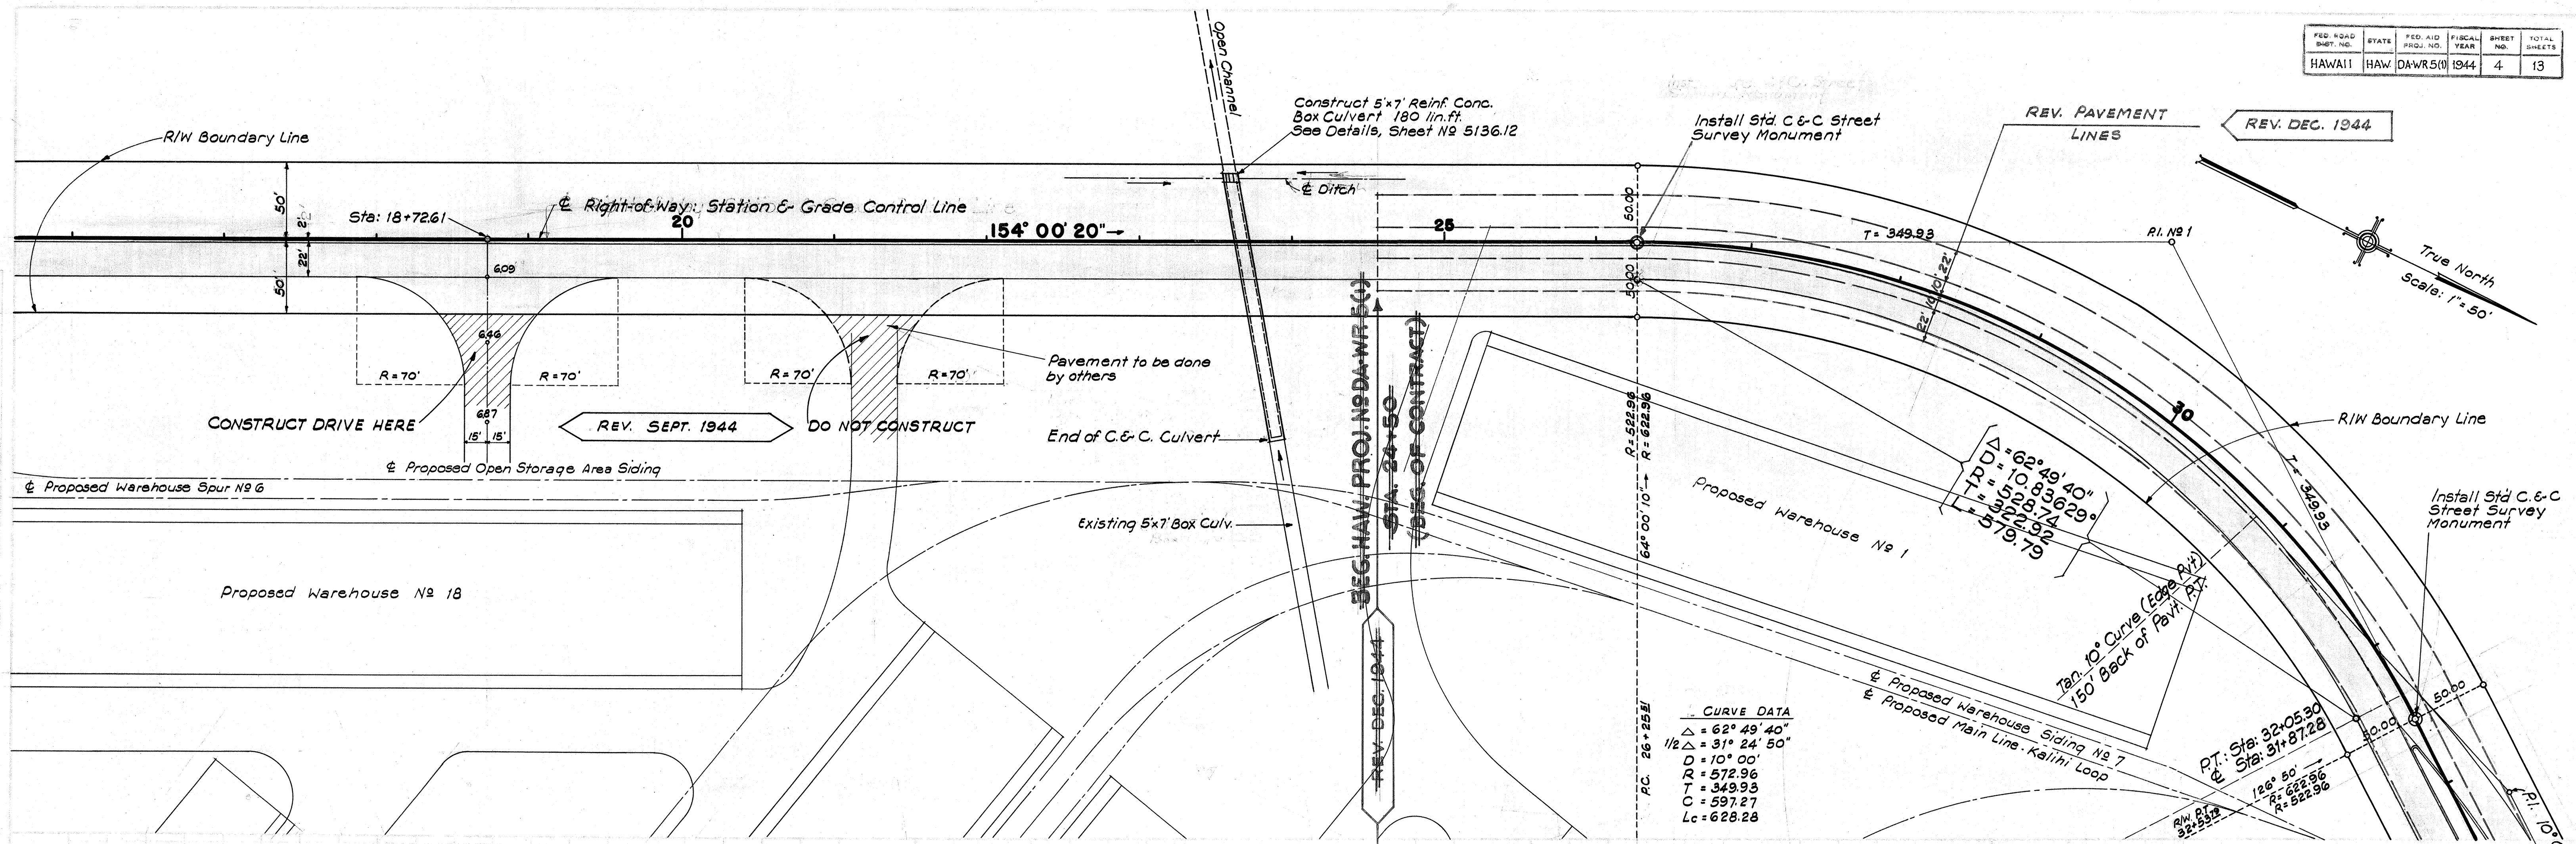

513²6.6³

REV. FEB. 1945
REV. DEC. 1944
REV. OCT. 1944

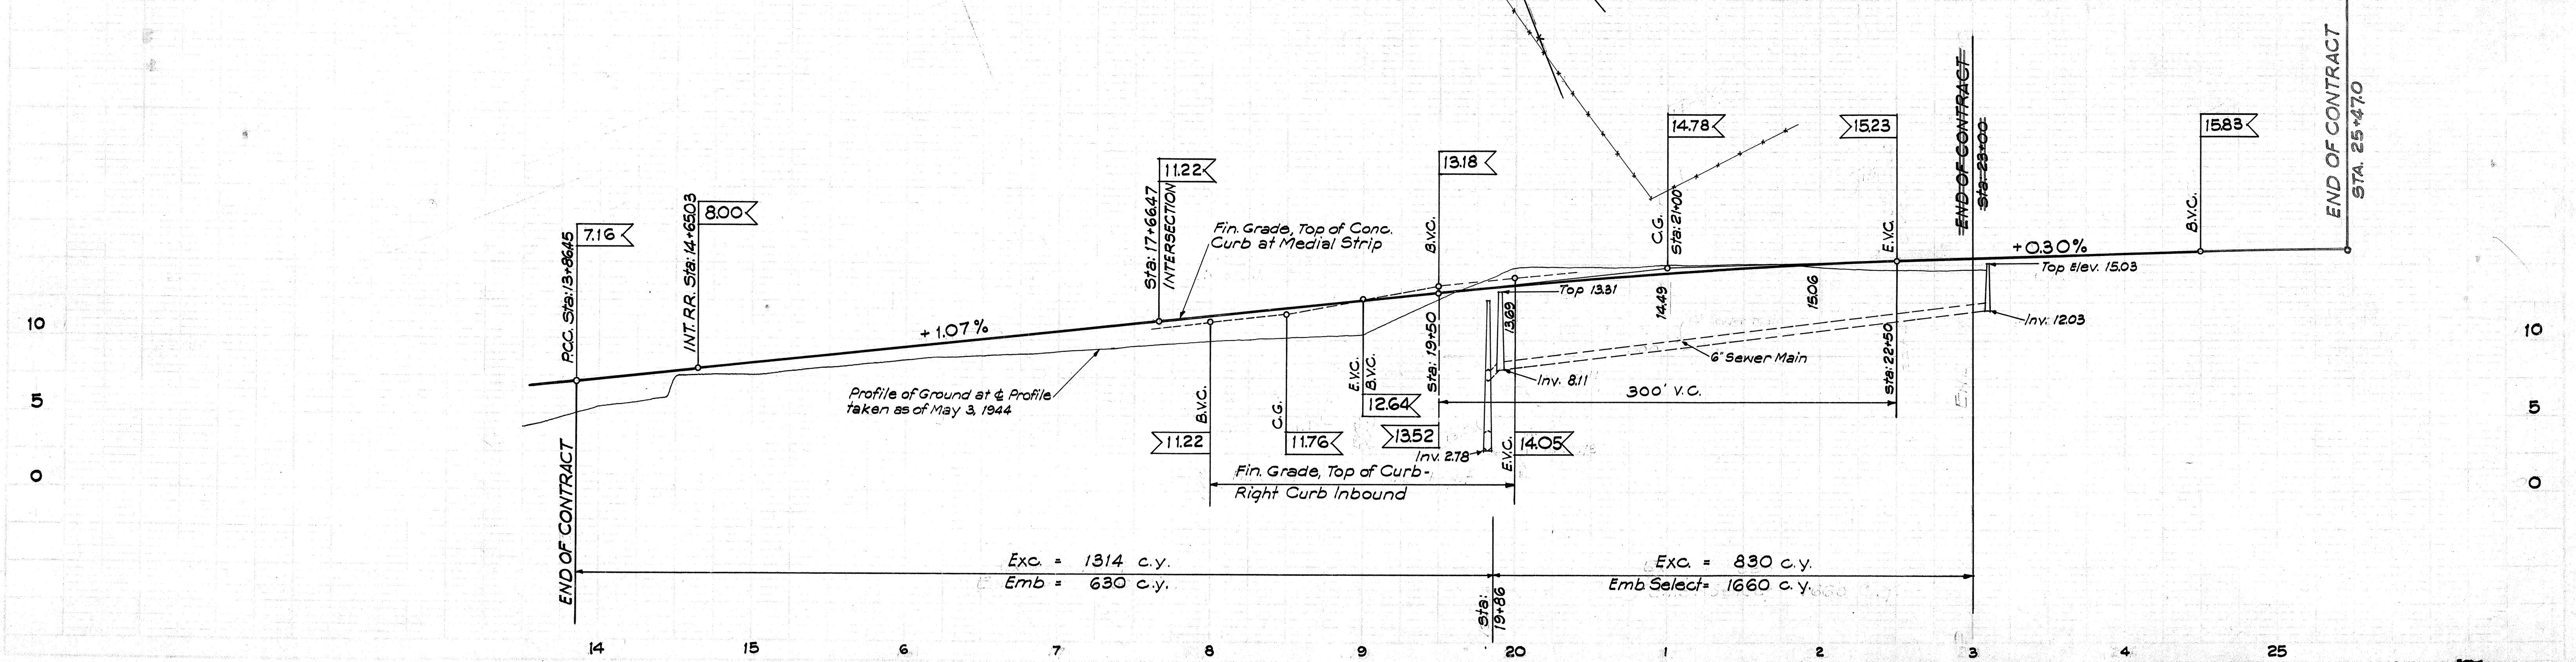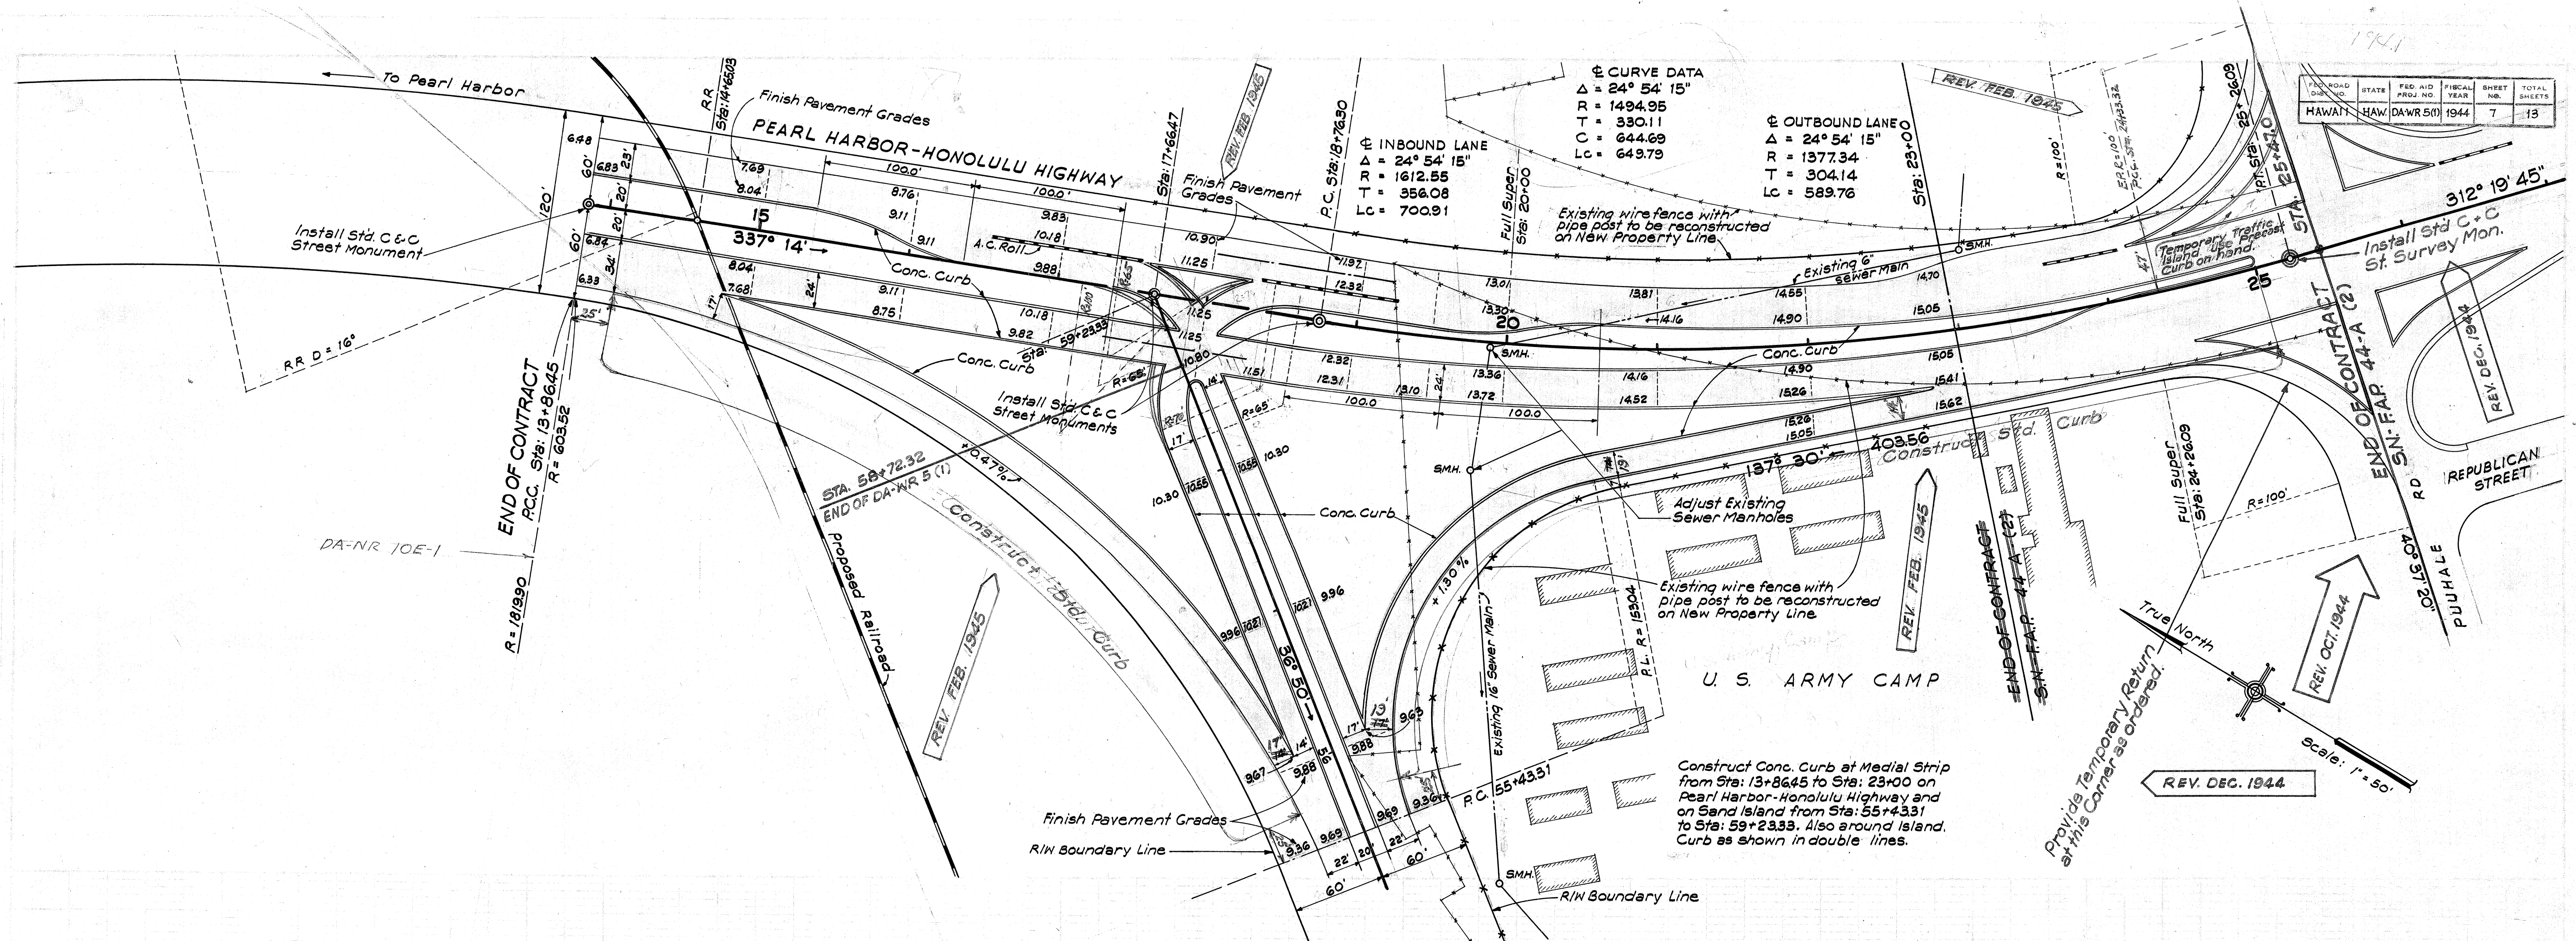

5136.7