

INDEX TO DRAWINGS	
SHEET NO.	DESCRIPTION
1	Title Sheet
2	Typical Sections
3-7	Plan & Profile
8	Standard Details
9	"
10	"
11	"
12	Culvert Details
13	Adjusting Sewer Manhole Detail
Note: No Cross Sections	

All changes made during construction have been shown in red on these tracings and checked by
Alfred B. Roberts
 Resident Engineer.
 Date July 11, 1945

TERRITORY OF HAWAII
 TERRITORIAL HIGHWAY DEPARTMENT
 HONOLULU - T. H.

PLANS OF
SAND ISLAND ACCESS ROAD


HAWAII PROJECT NO. DA-WR 5 (I)

HONOLULU DISTRICT
 ISLAND OF OAHU


SCALES

PLAN 1 INCH = 50 FEET
 PROFILE HORIZ: 1 INCH = 50 FEET
 VERT: 1 INCH = 5 FEET
 CROSS SECTIONS HORIZ: 1 INCH = 10 FEET
 VERT: 1 INCH = 10 FEET

Centerline 55
 Boundary Lines or
 Fences (Noted) or
 Existing Roadway
 Circular Concrete Culvert
 Railroad
 Telephone Pole
 Electric Power Line Pole
 Sewer Manhole
 Telephone Manhole
 Fire Hydrant
 or

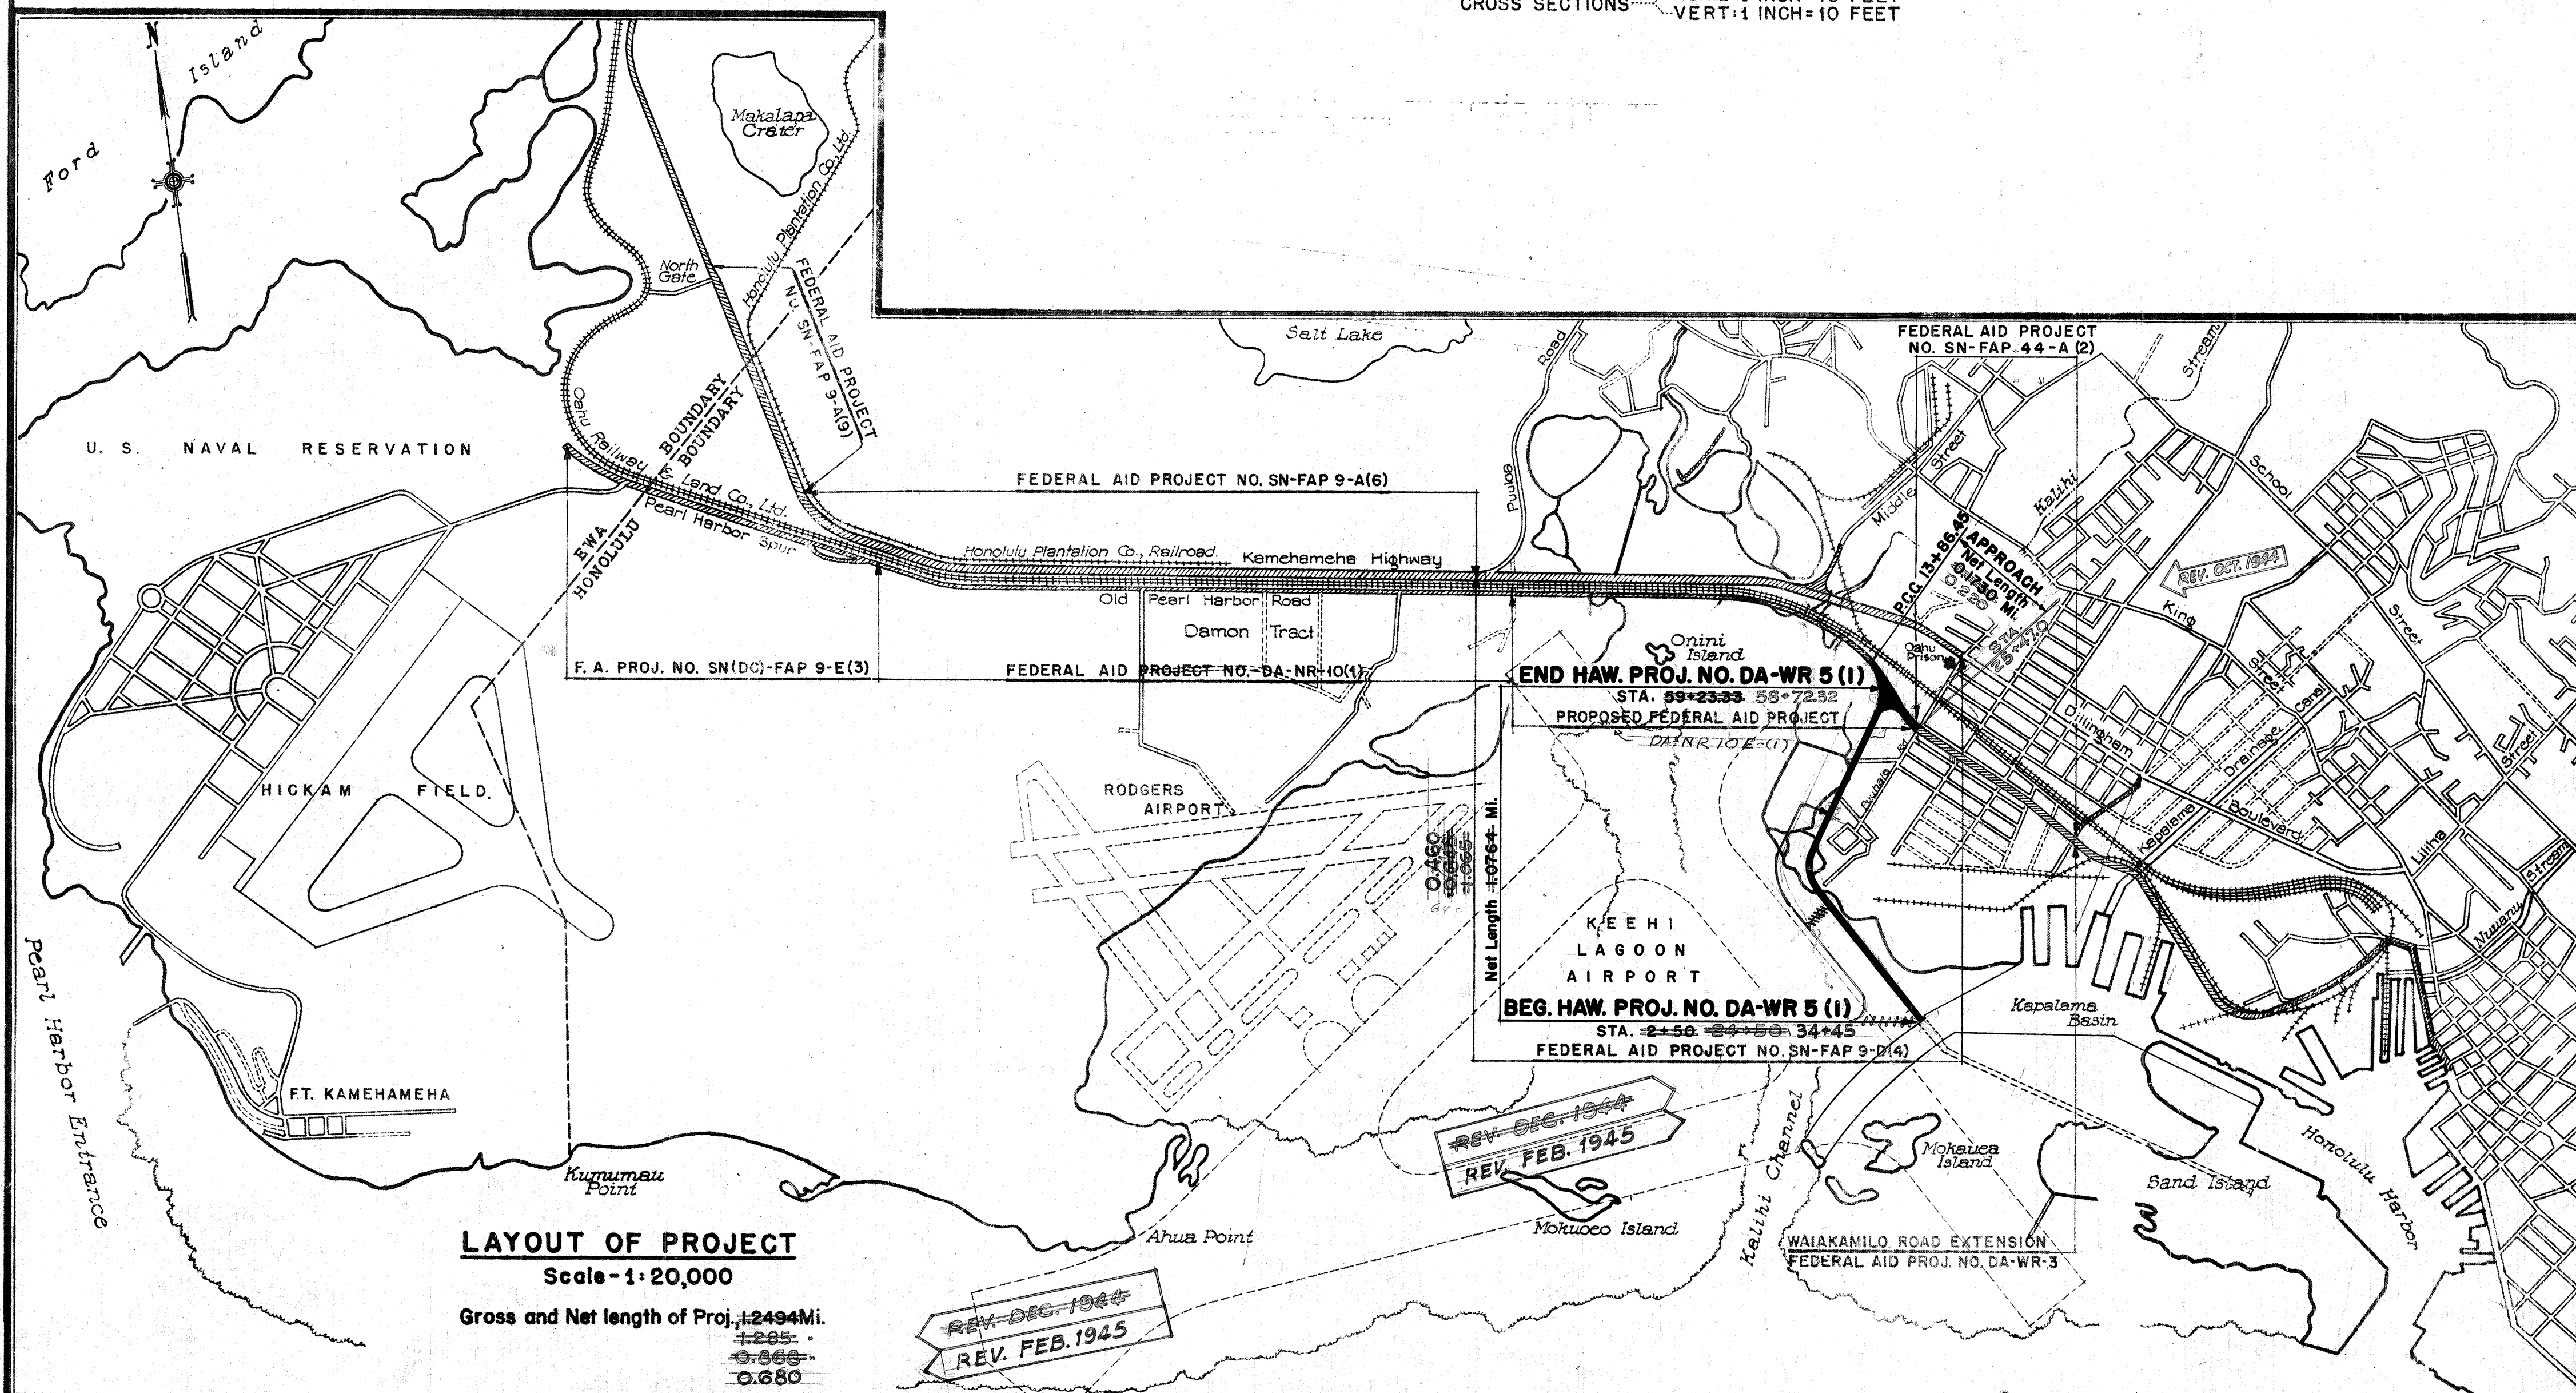

LAYOUT OF PROJECT
 Scale - 1" = 20,000'
 Gross and Net length of Proj. 1.2494 Mi.
 ±285'
 ±666'
 0.680'

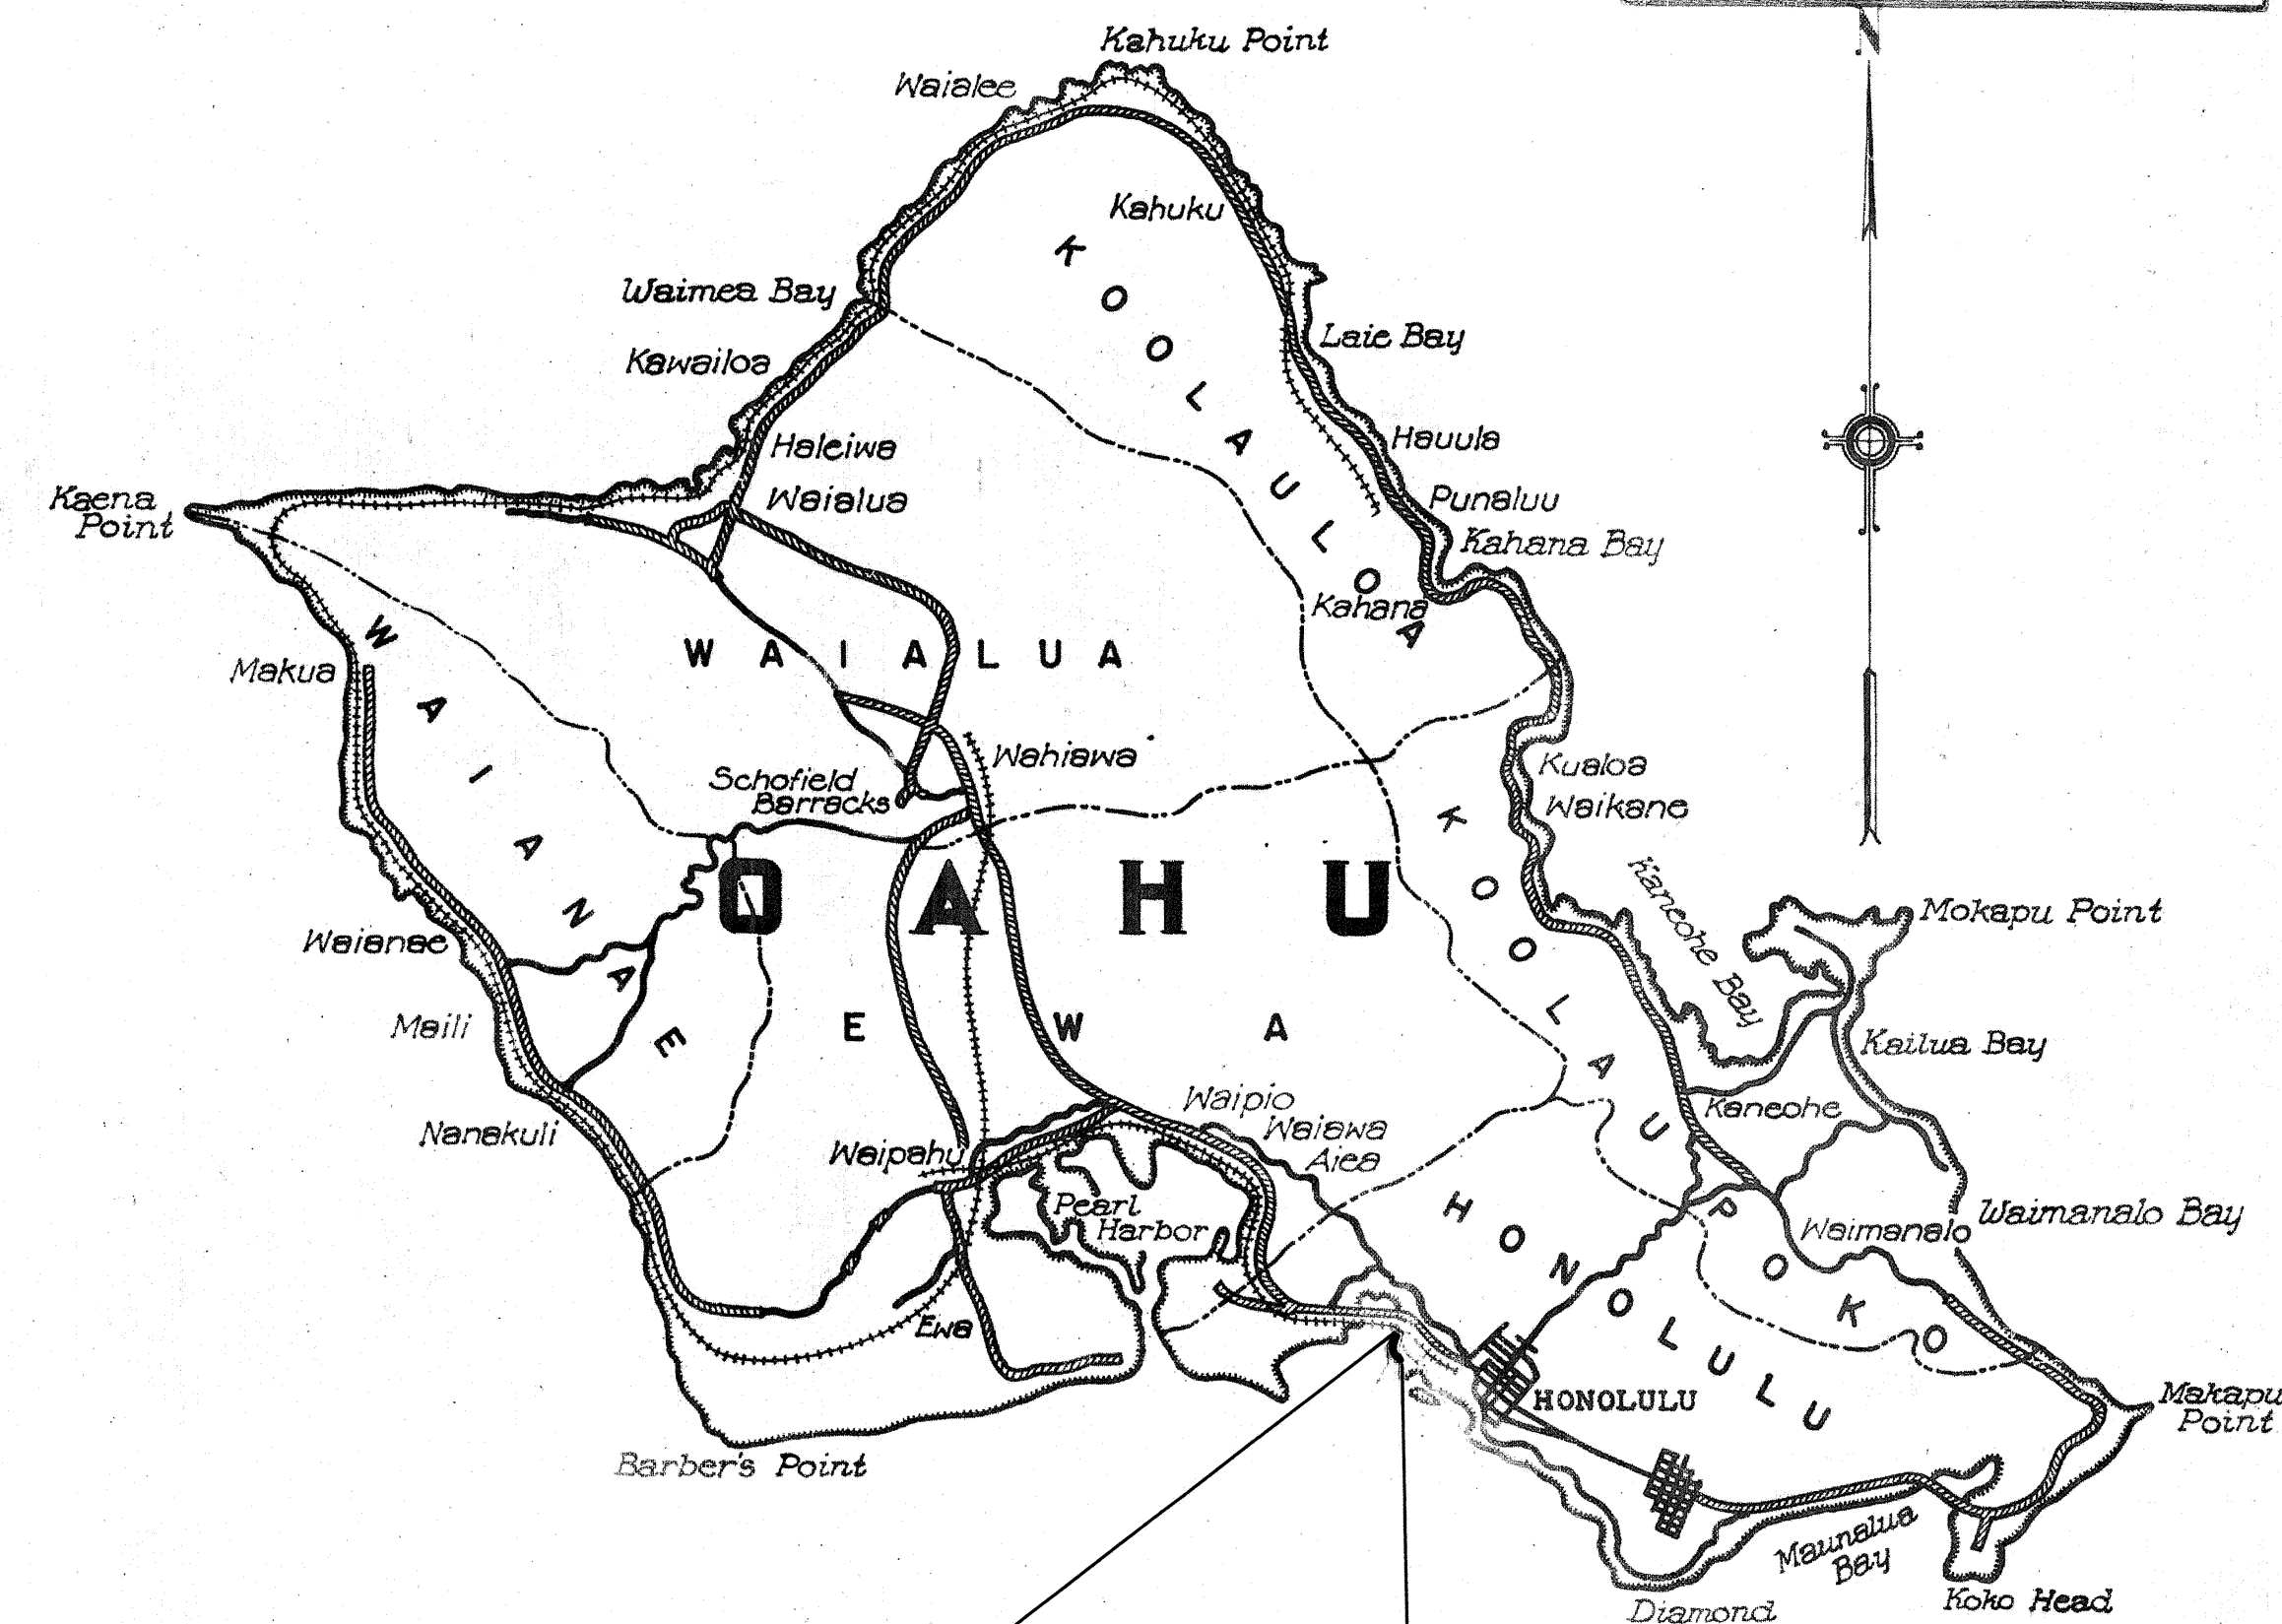

HAWAII PROJECT
 NO. DA-WR 5 (I)

Federal Aid Projects Previously Constructed Or Under Construction

RECOMMENDED FOR APPROVAL

• PRINCIPAL HIGHWAY ENGINEER •
 Public Roads Administration,
 Federal Works Agency

RECOMMENDED FOR APPROVAL

• CHIEF, WESTERN REGION •
 Public Roads Administration,
 Federal Works Agency

APPROVED

• • • COMMISSIONER • • •
 Public Roads Administration,
 Federal Works Agency

APPROVED

B. F. Rush
 Territorial Highway Engineer
 Date: 7-17-44