



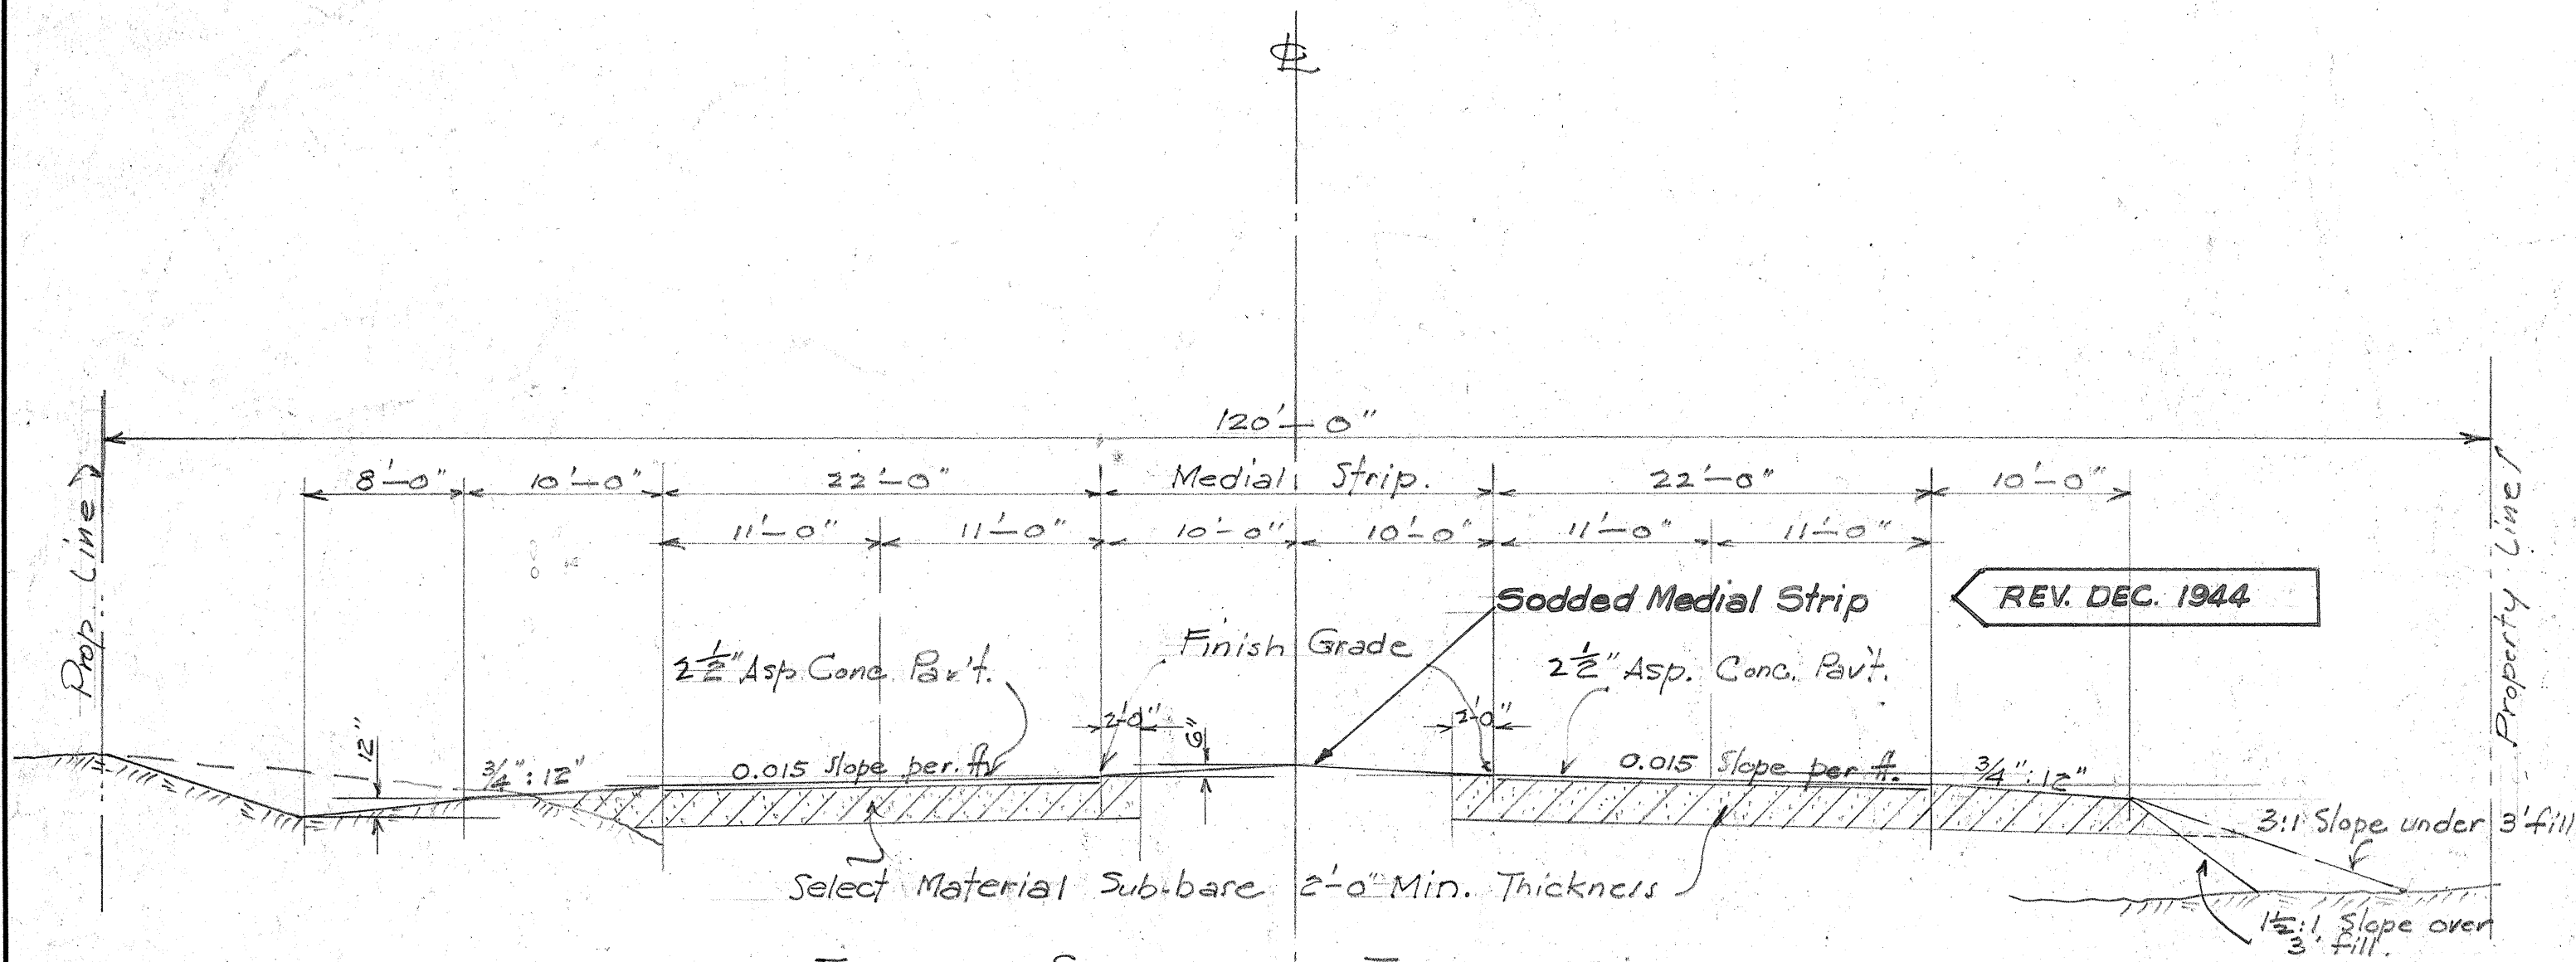


TYPICAL SECTION AT TANGENT
STA. 27+38+58.70 TO 28+55+43.31


TYPICAL SECTION STA. 24+50 TO STA. 55+43.31

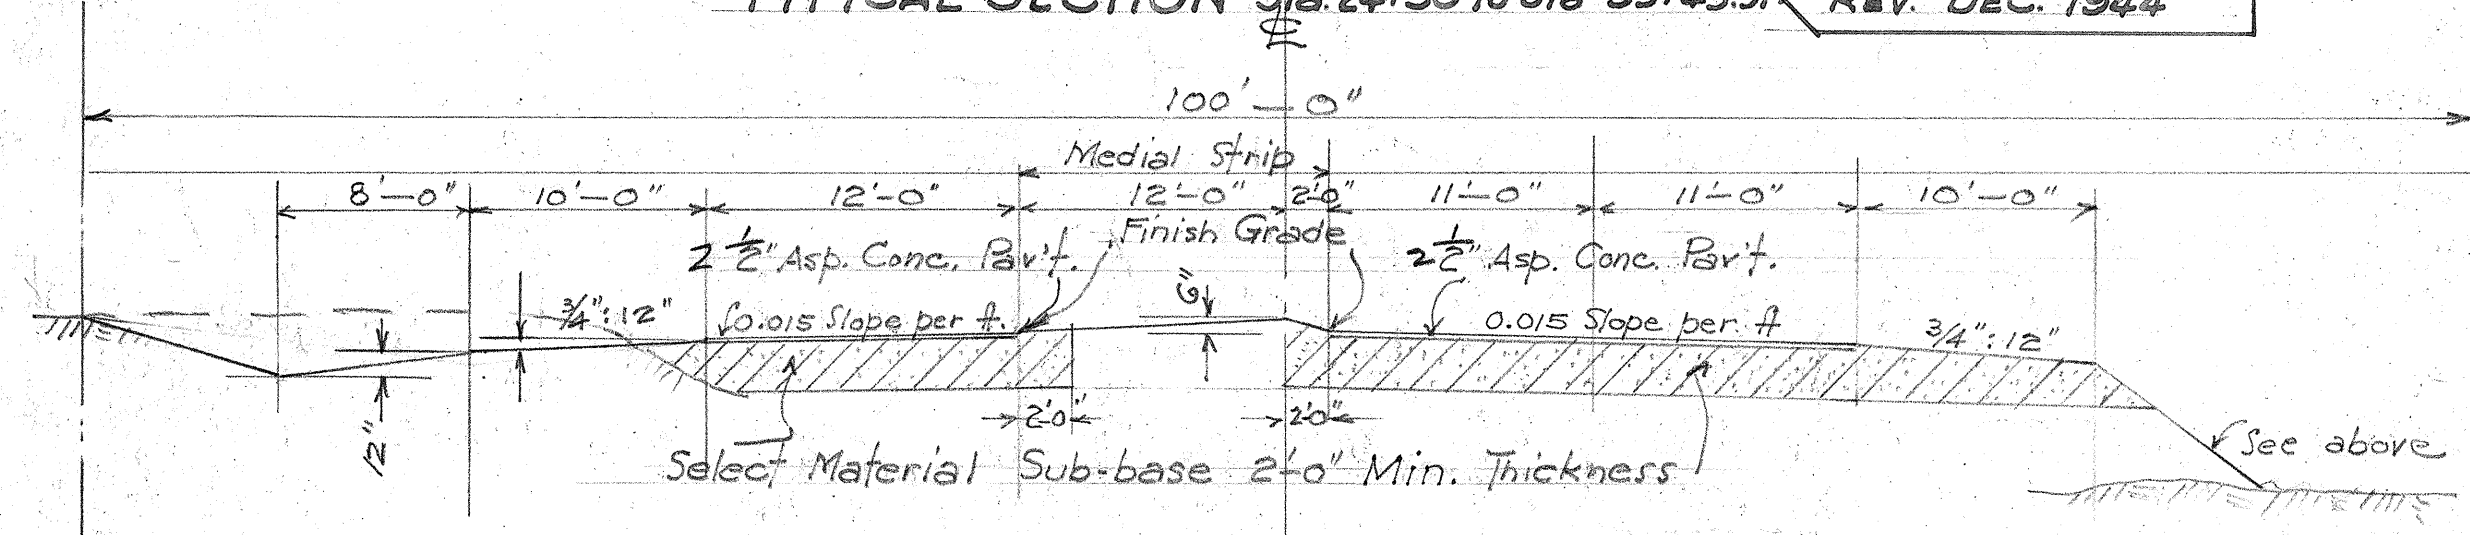


TYPICAL SECTION STA. 20+00 TO 25+00

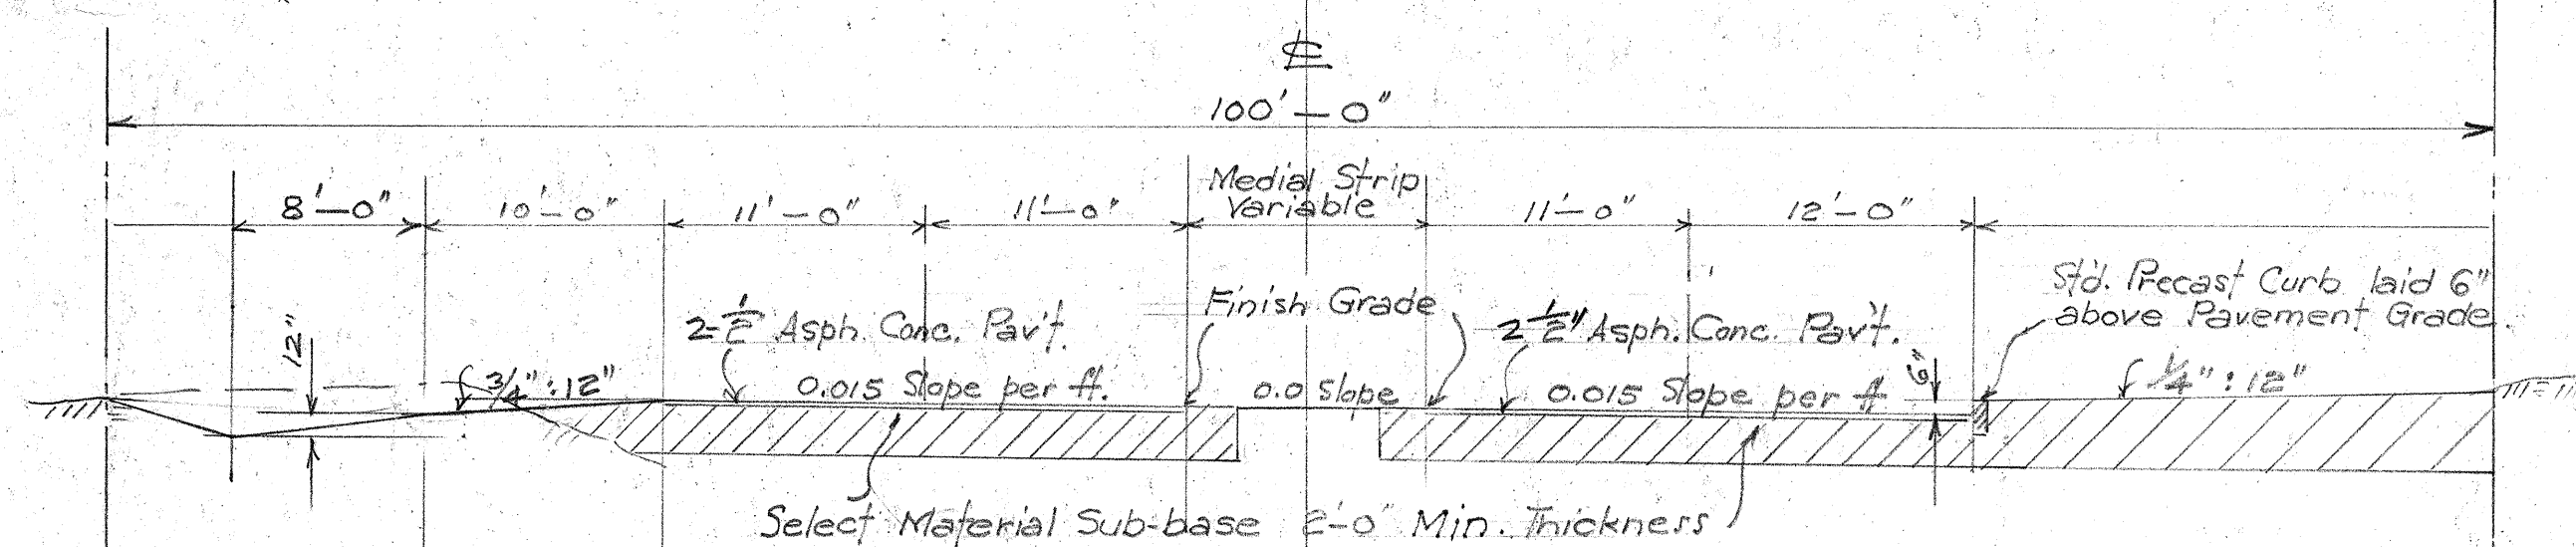


SECTION AT CURVE
STA. 26+25.51 TO 32+00

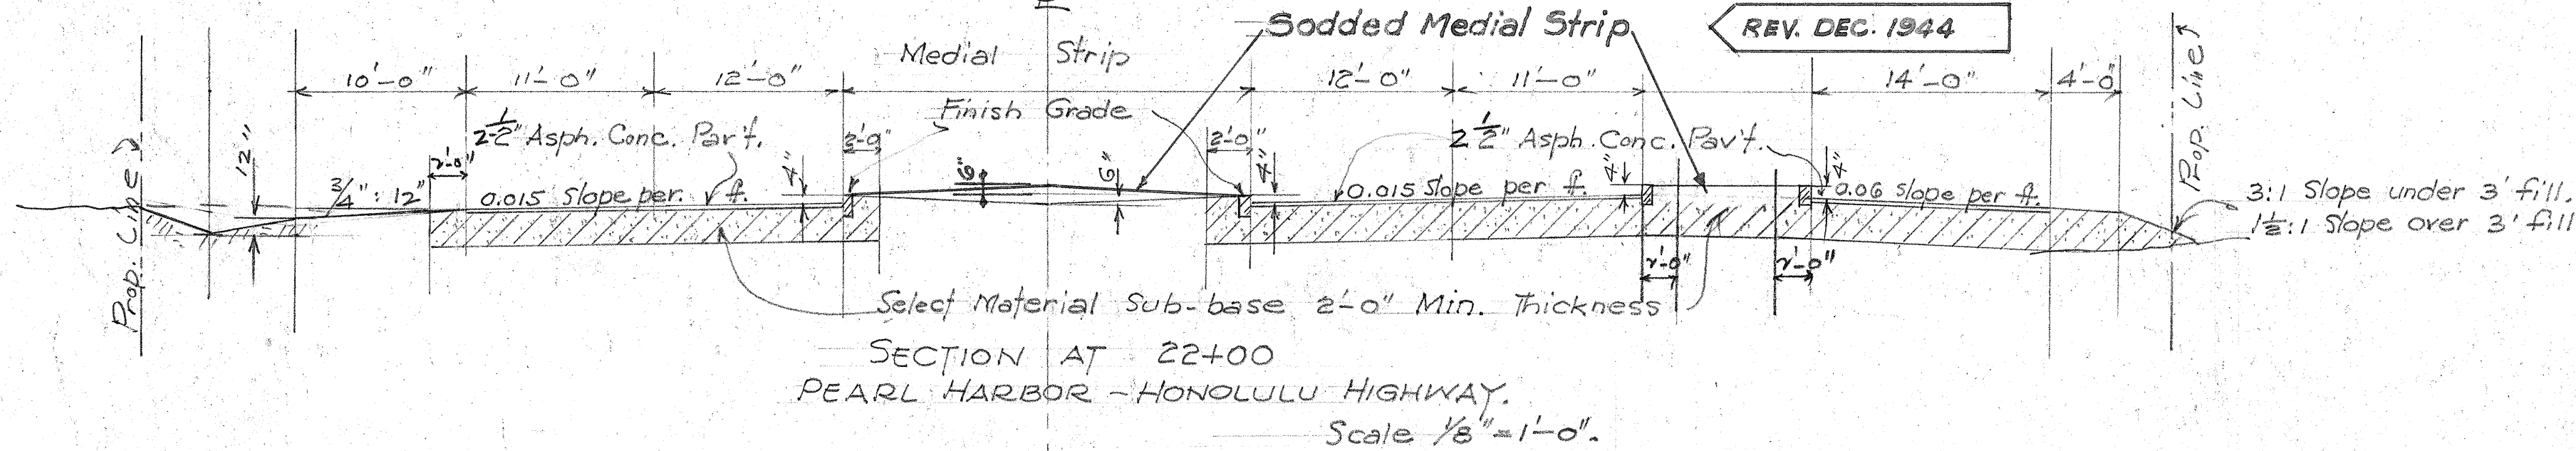

SECTION AT 22+00
PEARL HARBOR - HONOLULU HIGHWAY
Scale 1/8" = 1'-0"

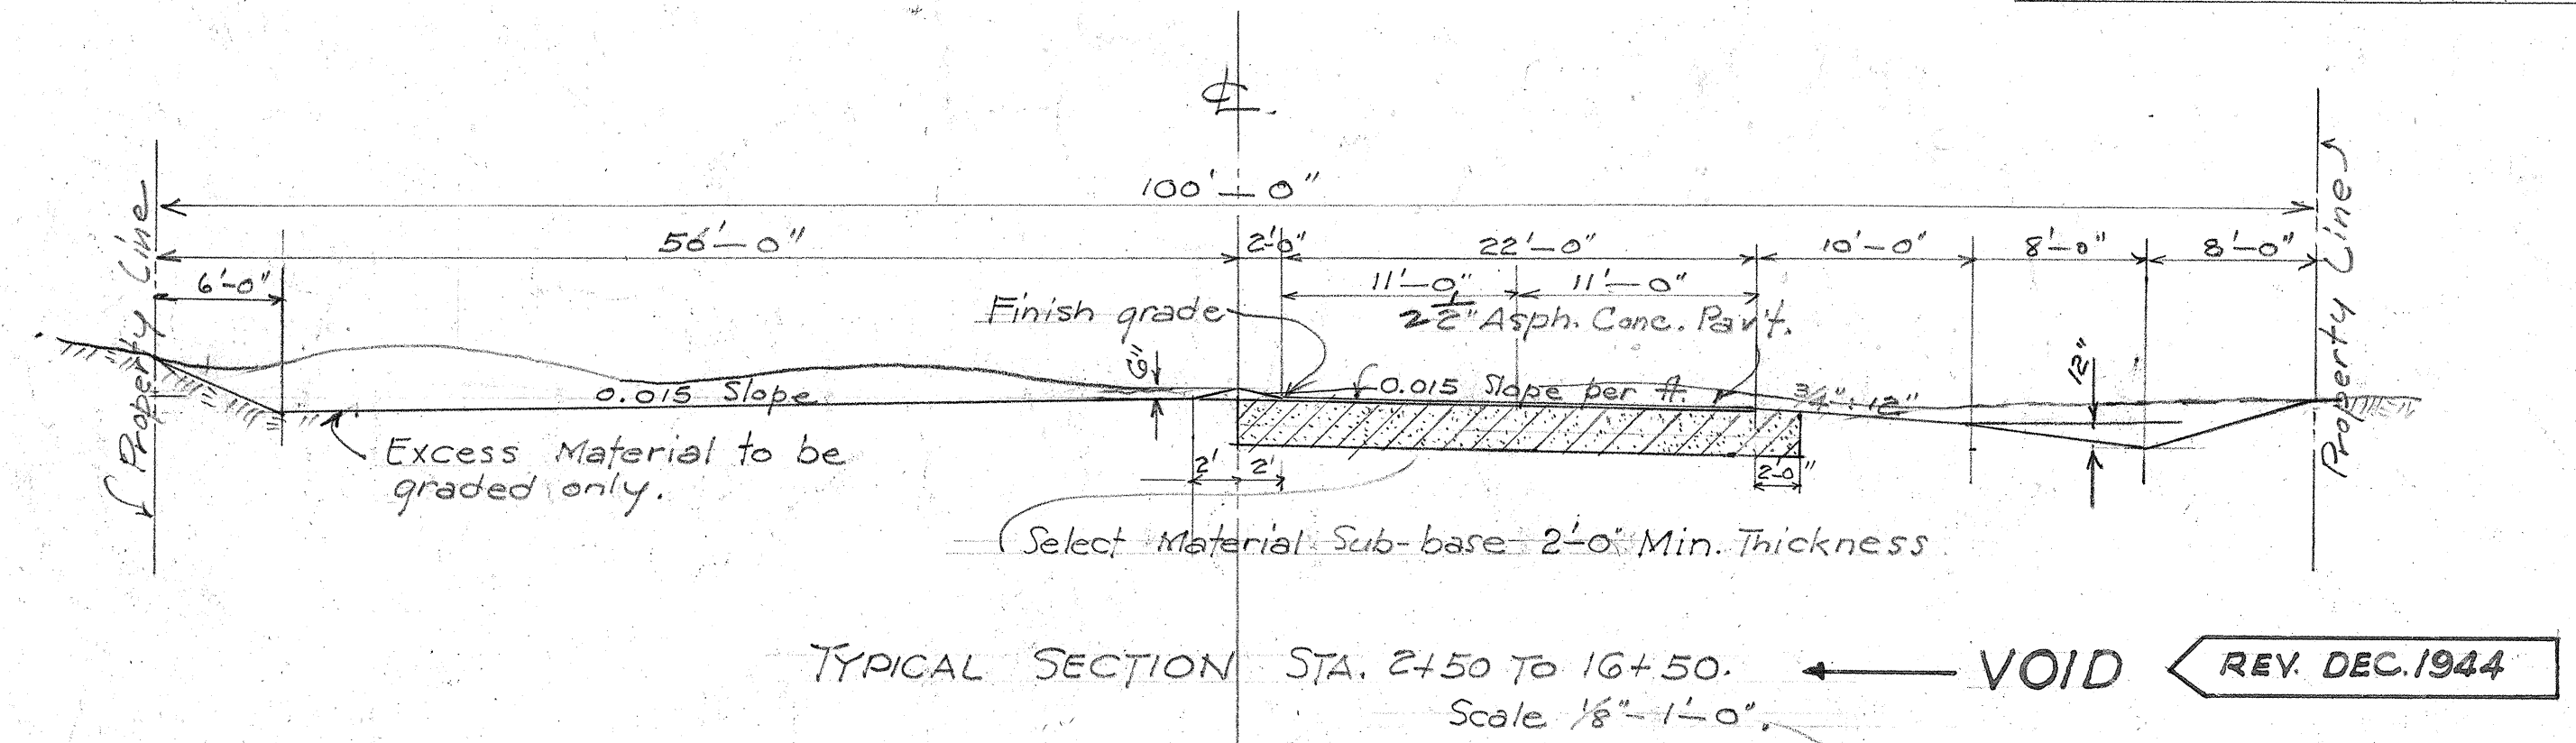


TYPICAL SECTION STA. 24+50 TO 16+50
Scale 1/8" = 1'-0"

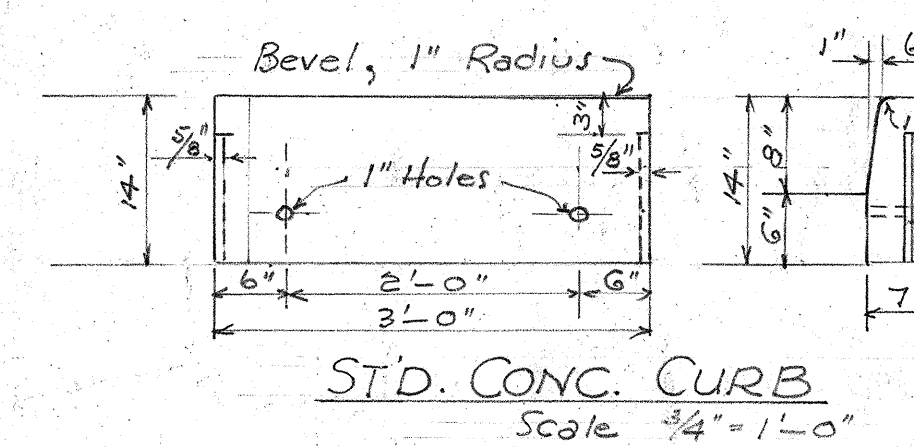

CAST IN PLACE
CONCRETE CURB
Scale 3/4" = 1'-0"

CAST IN PLACE
CONCRETE CURB
MAY BE CONSTRUCTED IN
THIS MANNER
Scale: 3/4" = 1'-0"

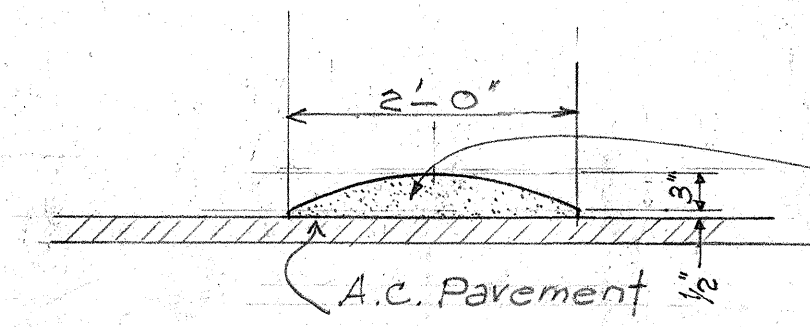

DETAIL OF A.C. ROLL

NOTE!
If wanted, the Territory will loan
the Contractor a spreader box
which spreads loose material
to the desired section.

REV. DEC. 1944

REV. DEC. 1944

DATE	
SURVEY PLOTTED BY	
PLAN	
DRAWN BY	
TRACED BY	
NOTE BOOK	
QUANTITIES CHECKED BY	
CHECKED BY	
No.	