




PROJ. ROAD DIST. NO.	STATE	FED. AID PROJ. NO.	FISCAL YEAR	DISTRICT	TOTAL SHEETS
HAWAII	HAW.	SN FAP 9-D(4)	1944	9	35

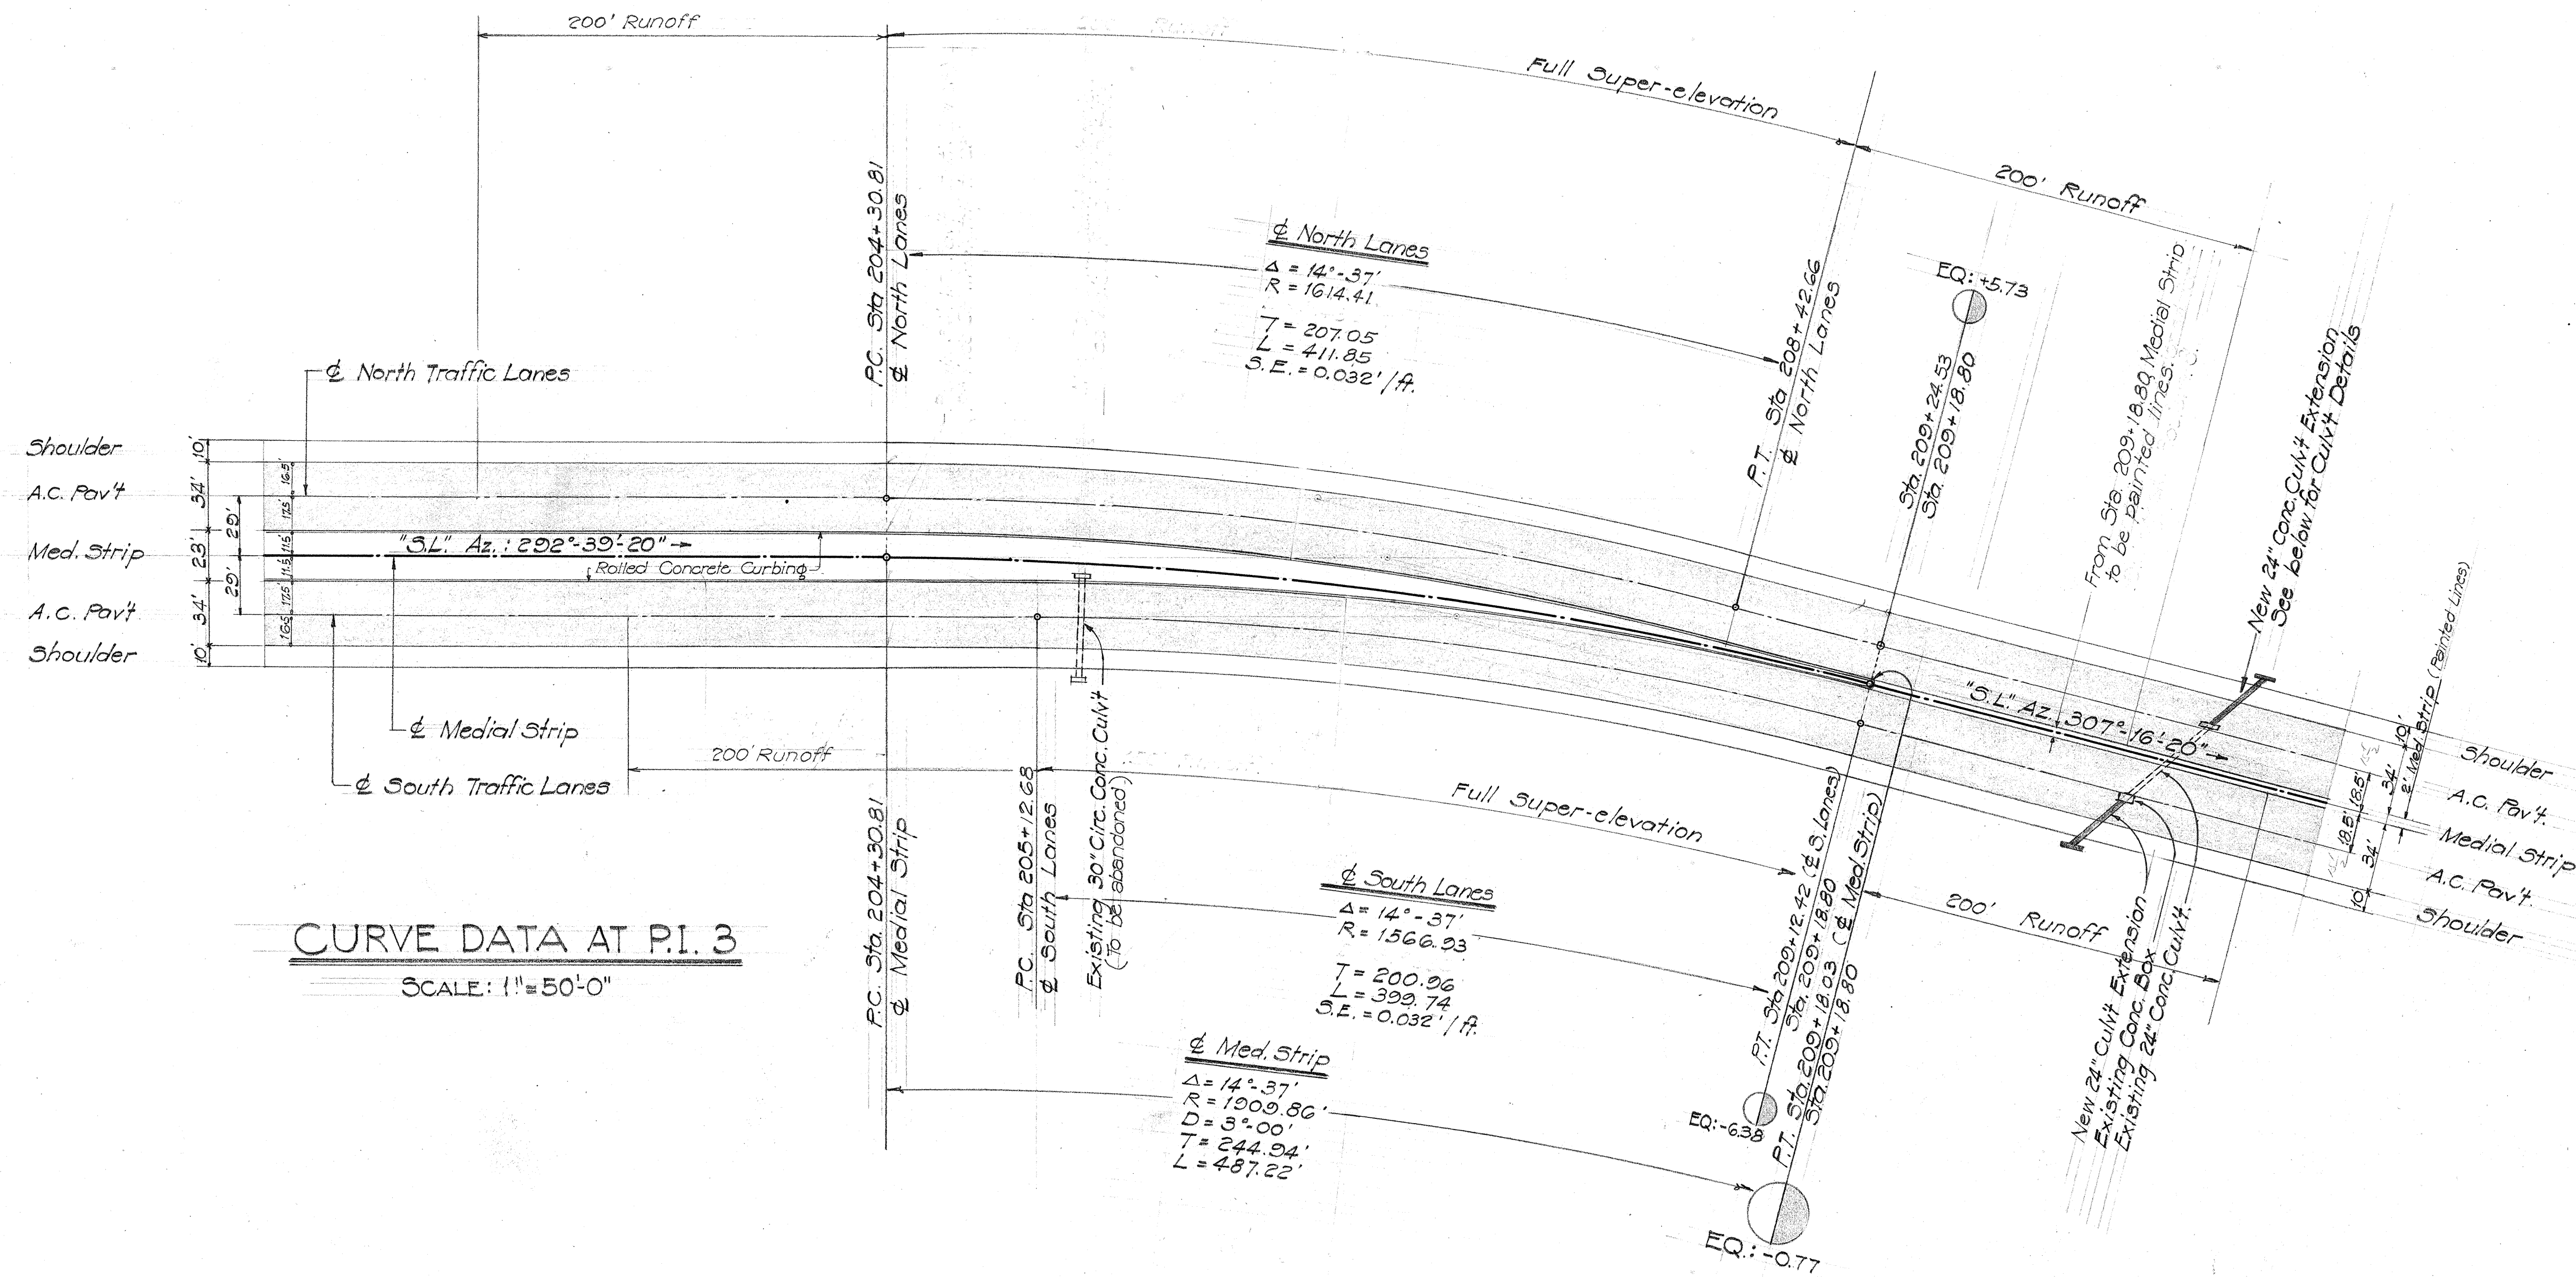

CURVE DATA AT P.I. 3
SCALE: 1"=50'-0"

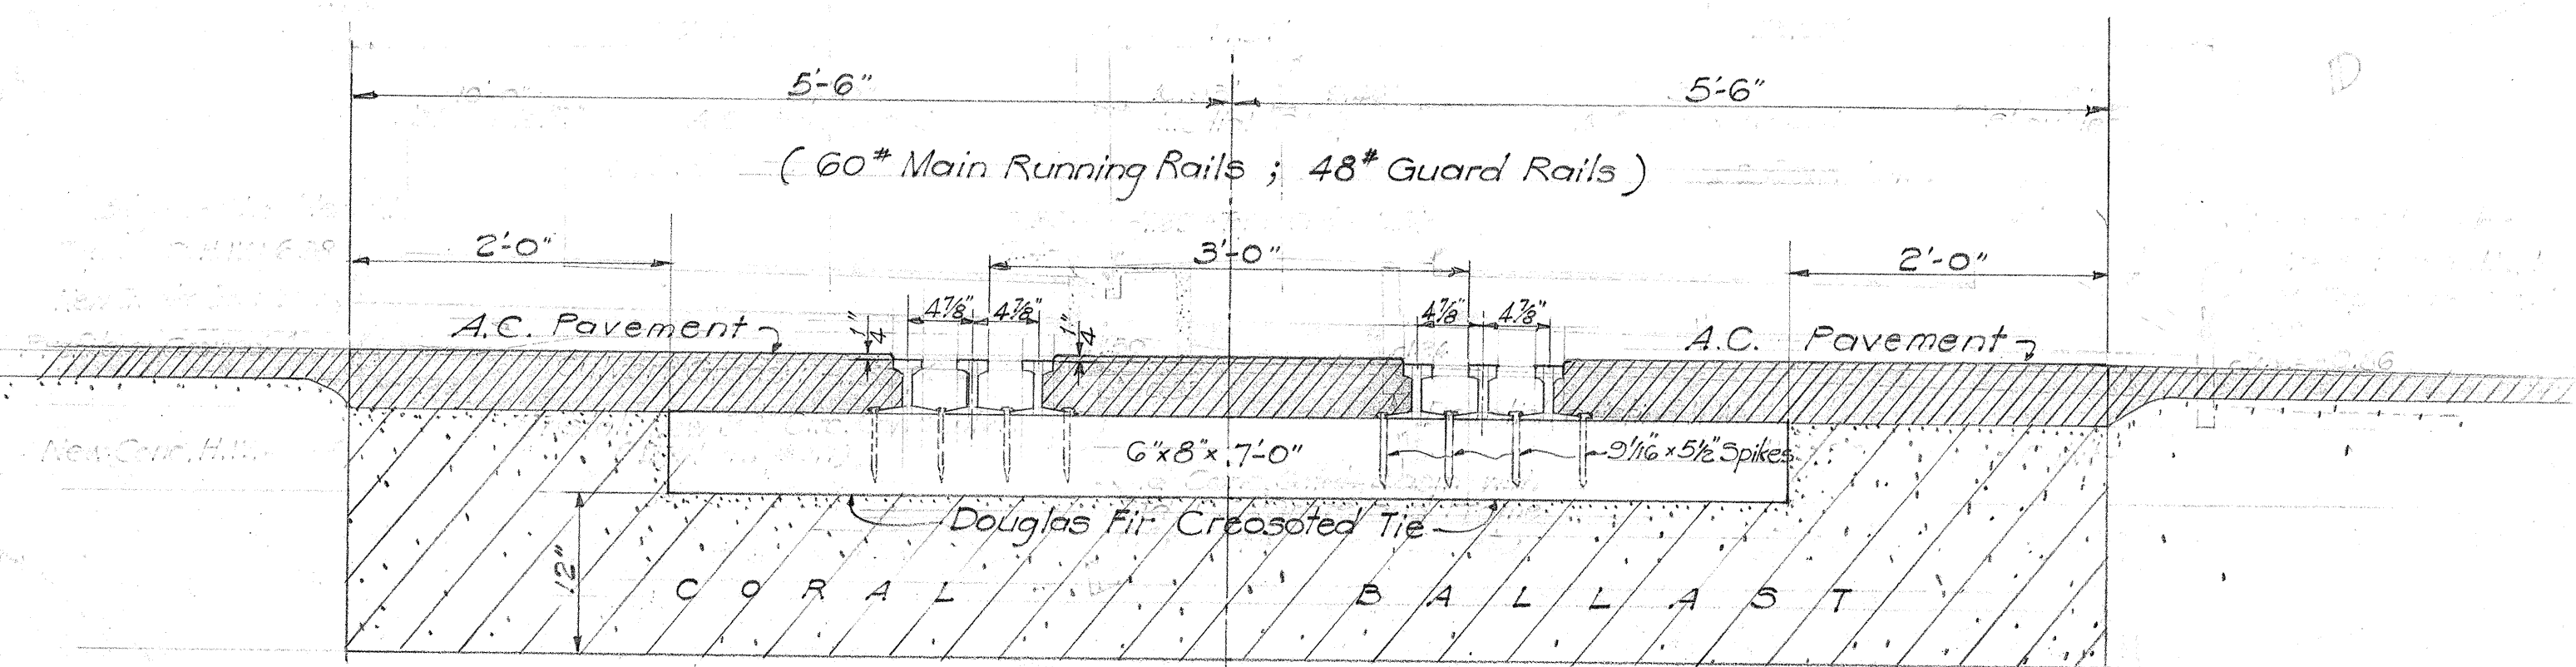

TYPICAL SECTION ~ R.R. CROSSING
SCALE: 1"=1'-0"

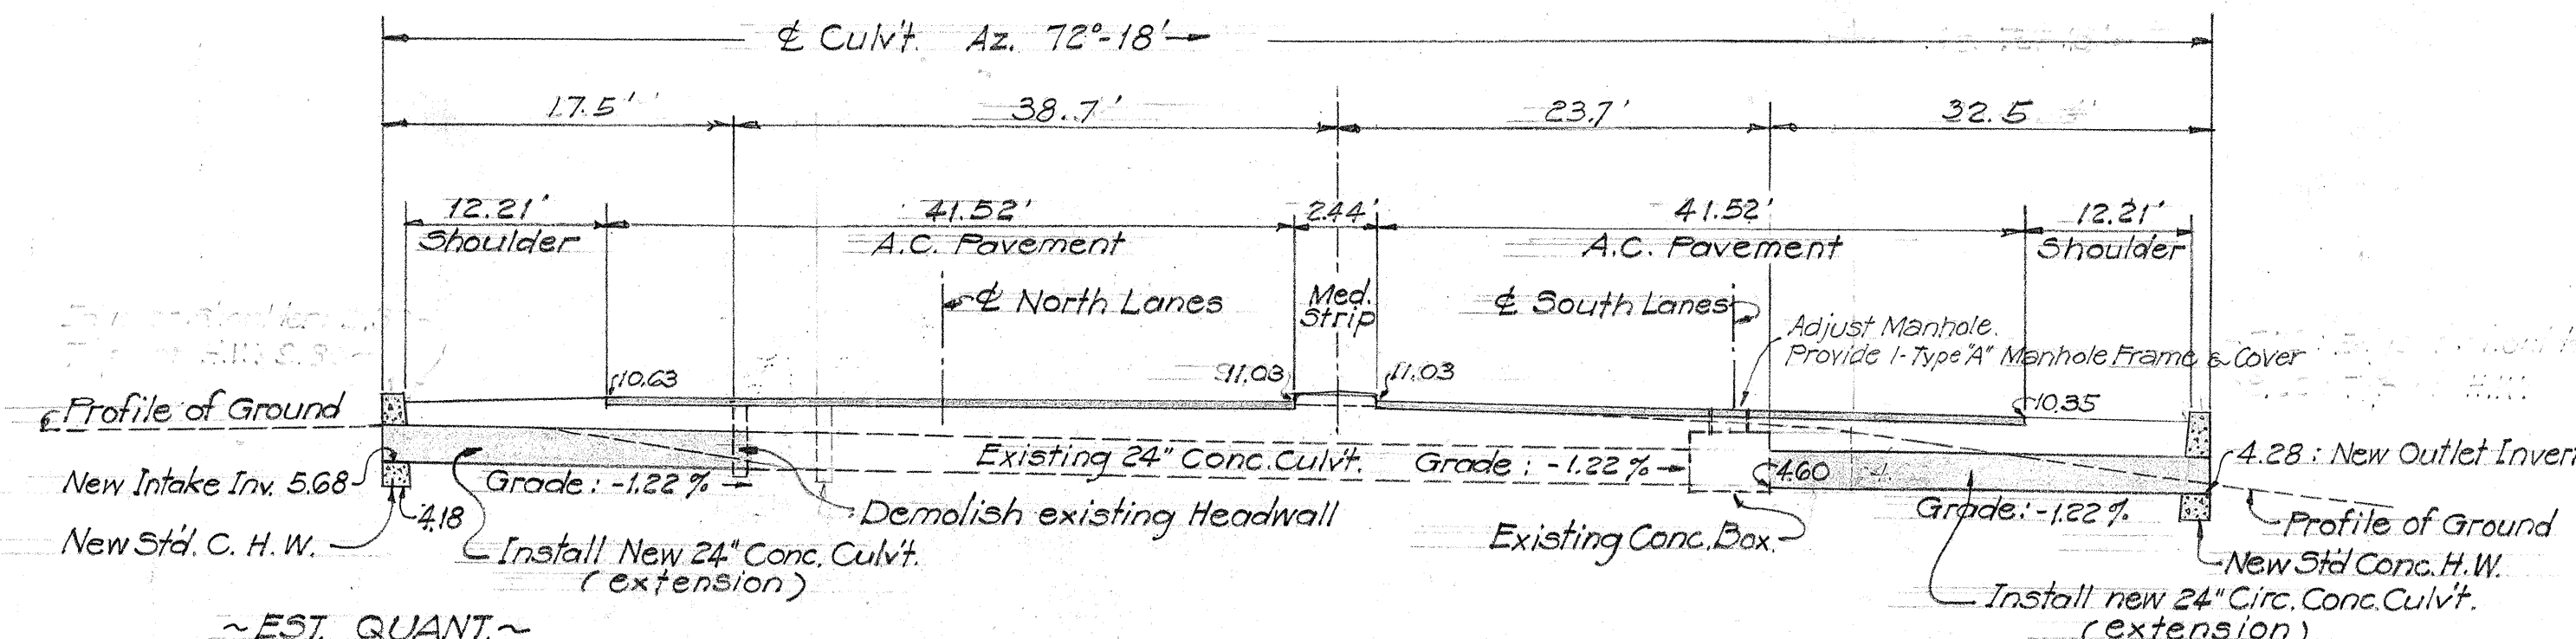

CULVERT DETAIL
SCALE: 1"=10'-0"

TERRITORIAL HIGHWAY DEPARTMENT
TERRITORY OF HAWAII
CURVE DETAIL AT P.I. # 3
& DETAIL OF CULVERTS
KAMEHAMEHA HIGHWAY
FROM PUULOA ROAD TO OAHU PRISON
SN FAP 9-D(4) JULY 19, 1944

5142.9