

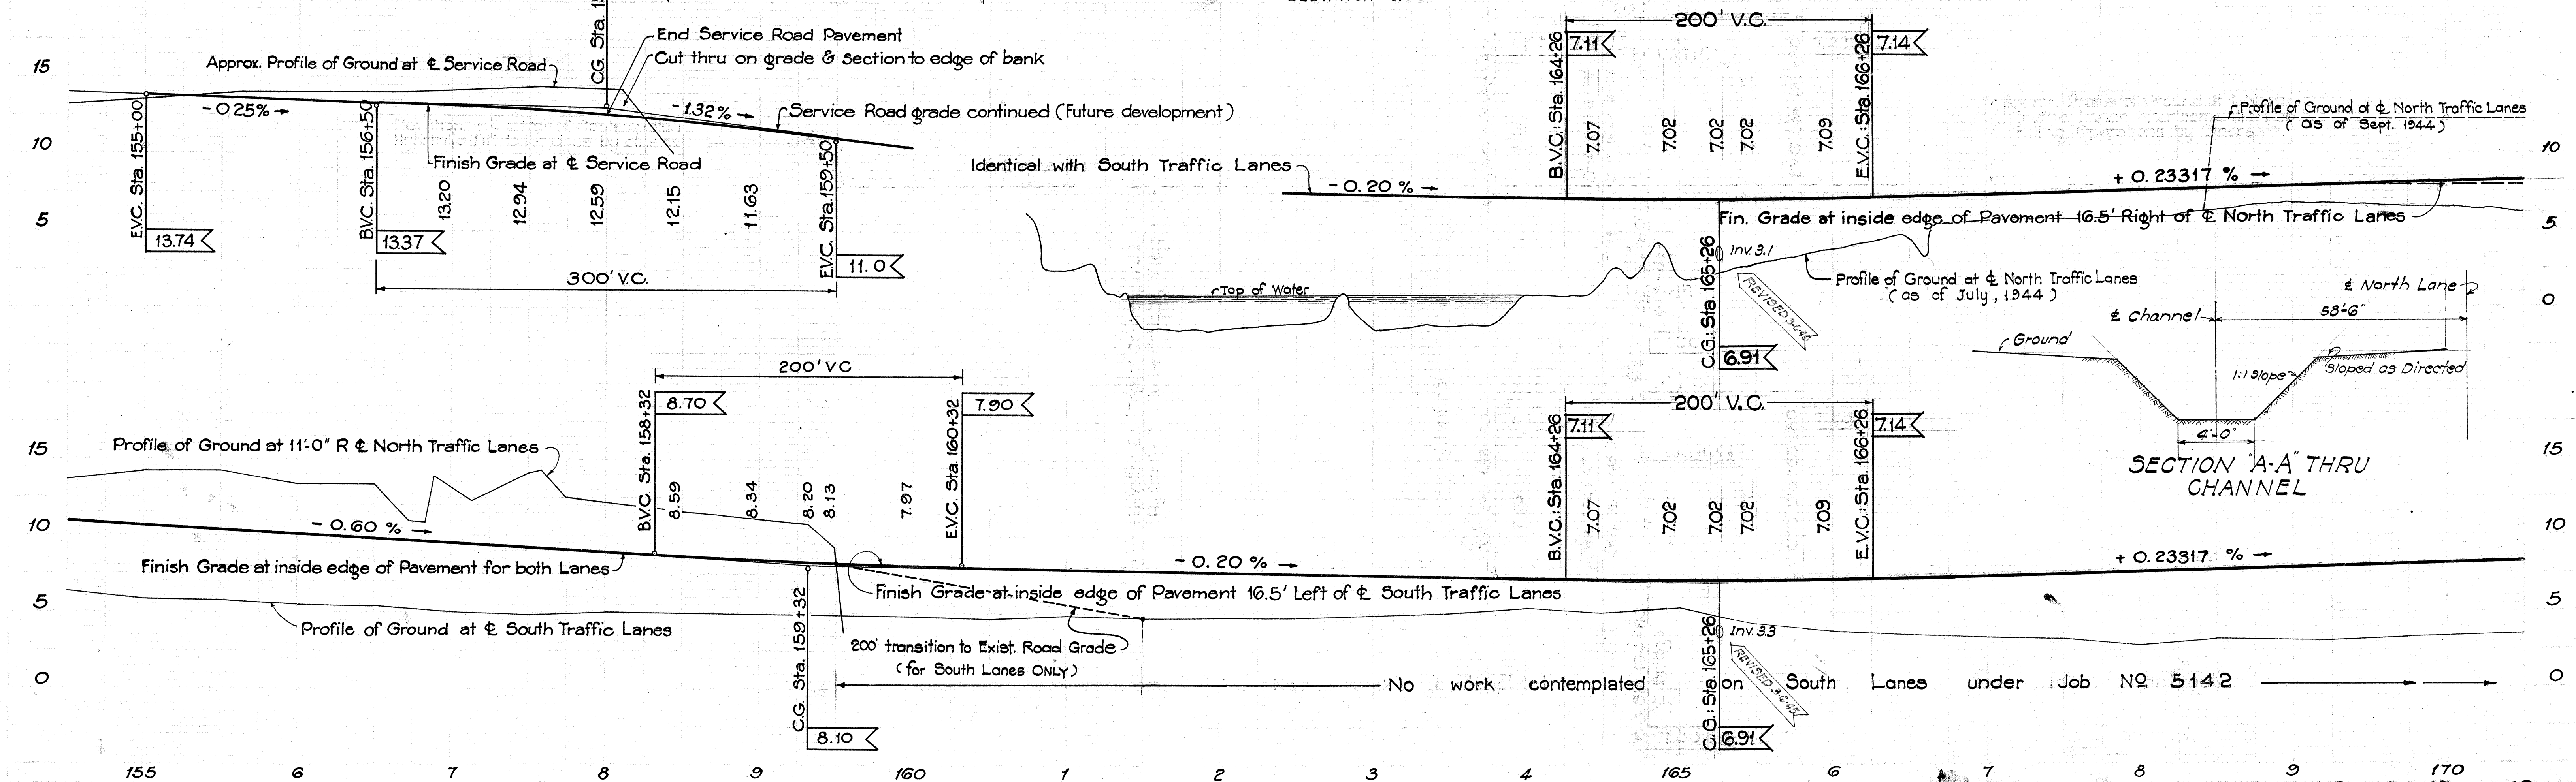
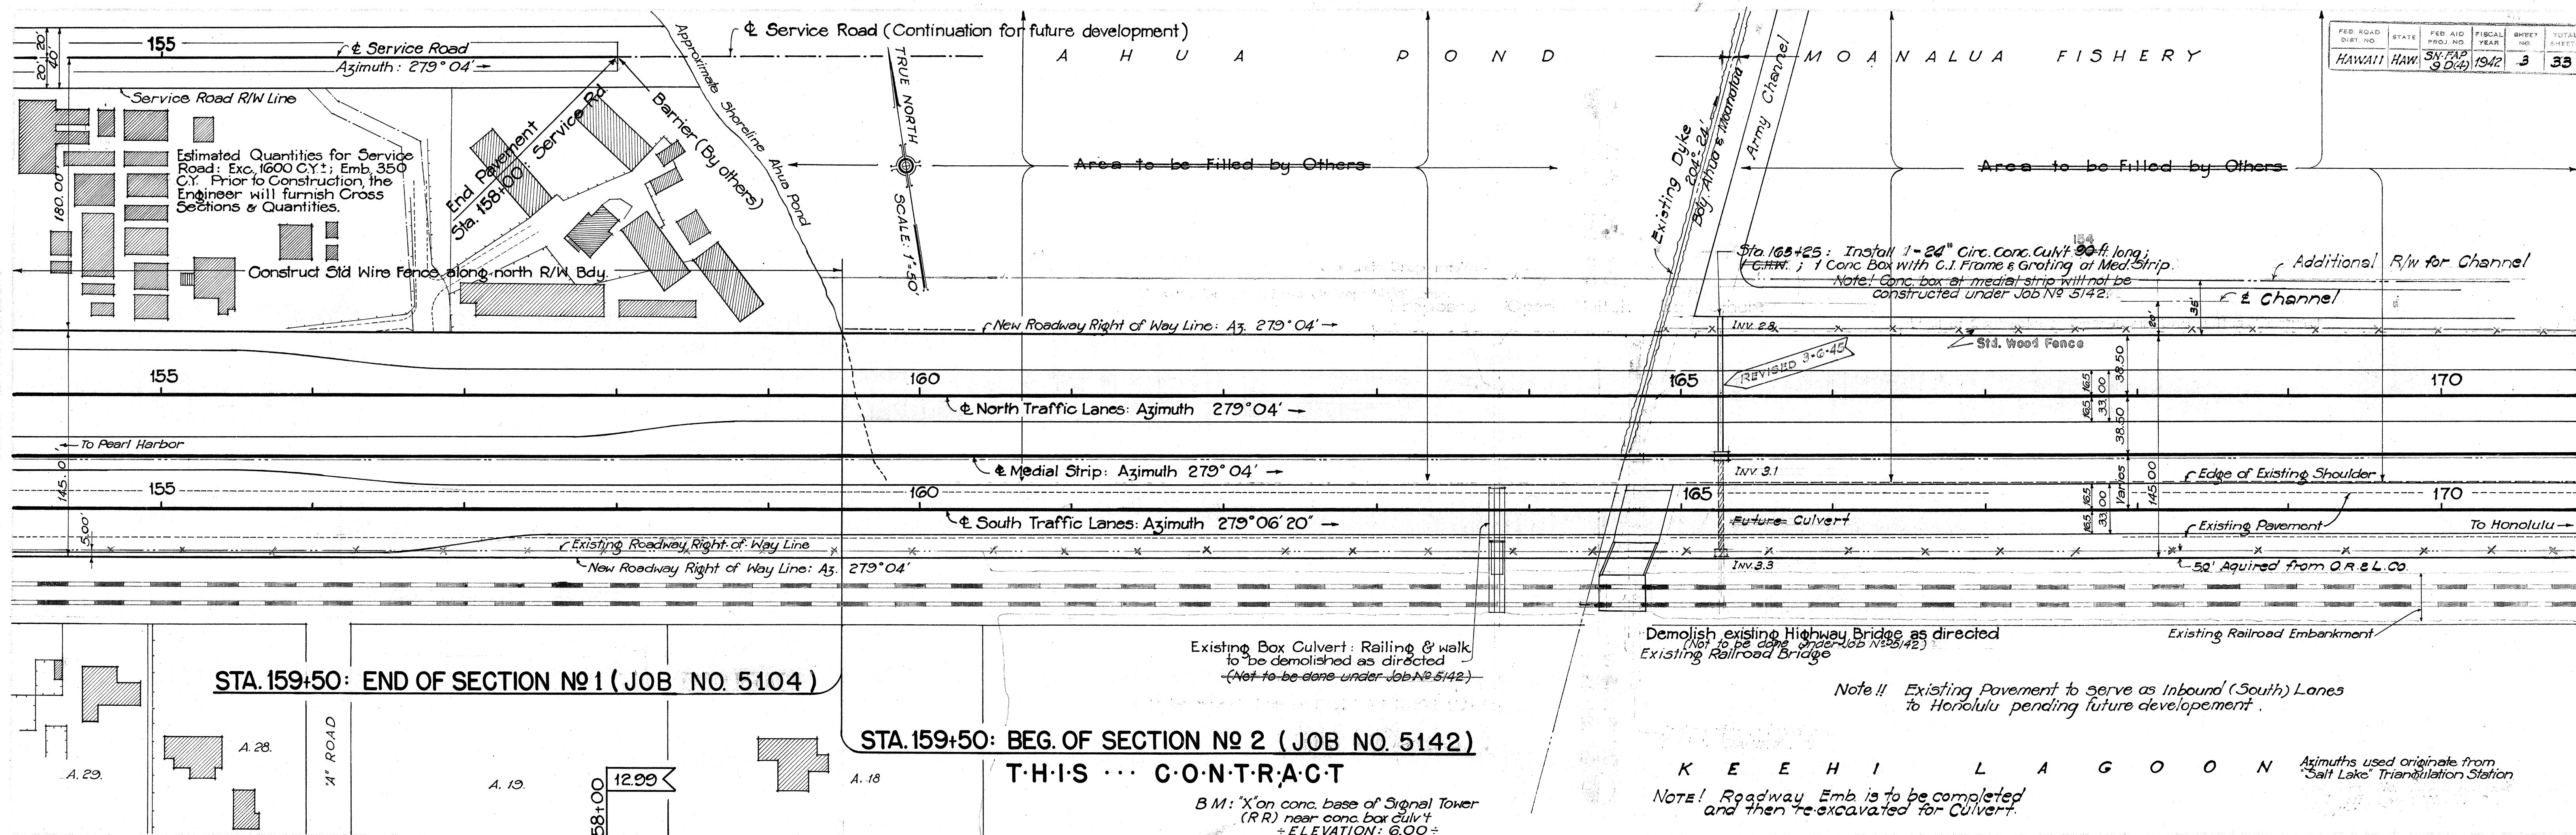


FED. ROAD DIST. NO.	STATE	FED. AID PROJ. NO.	FISCAL YEAR	SHEET NO.	TOTAL SHEETS
HAWAII	HAW.	31	1942	3	33

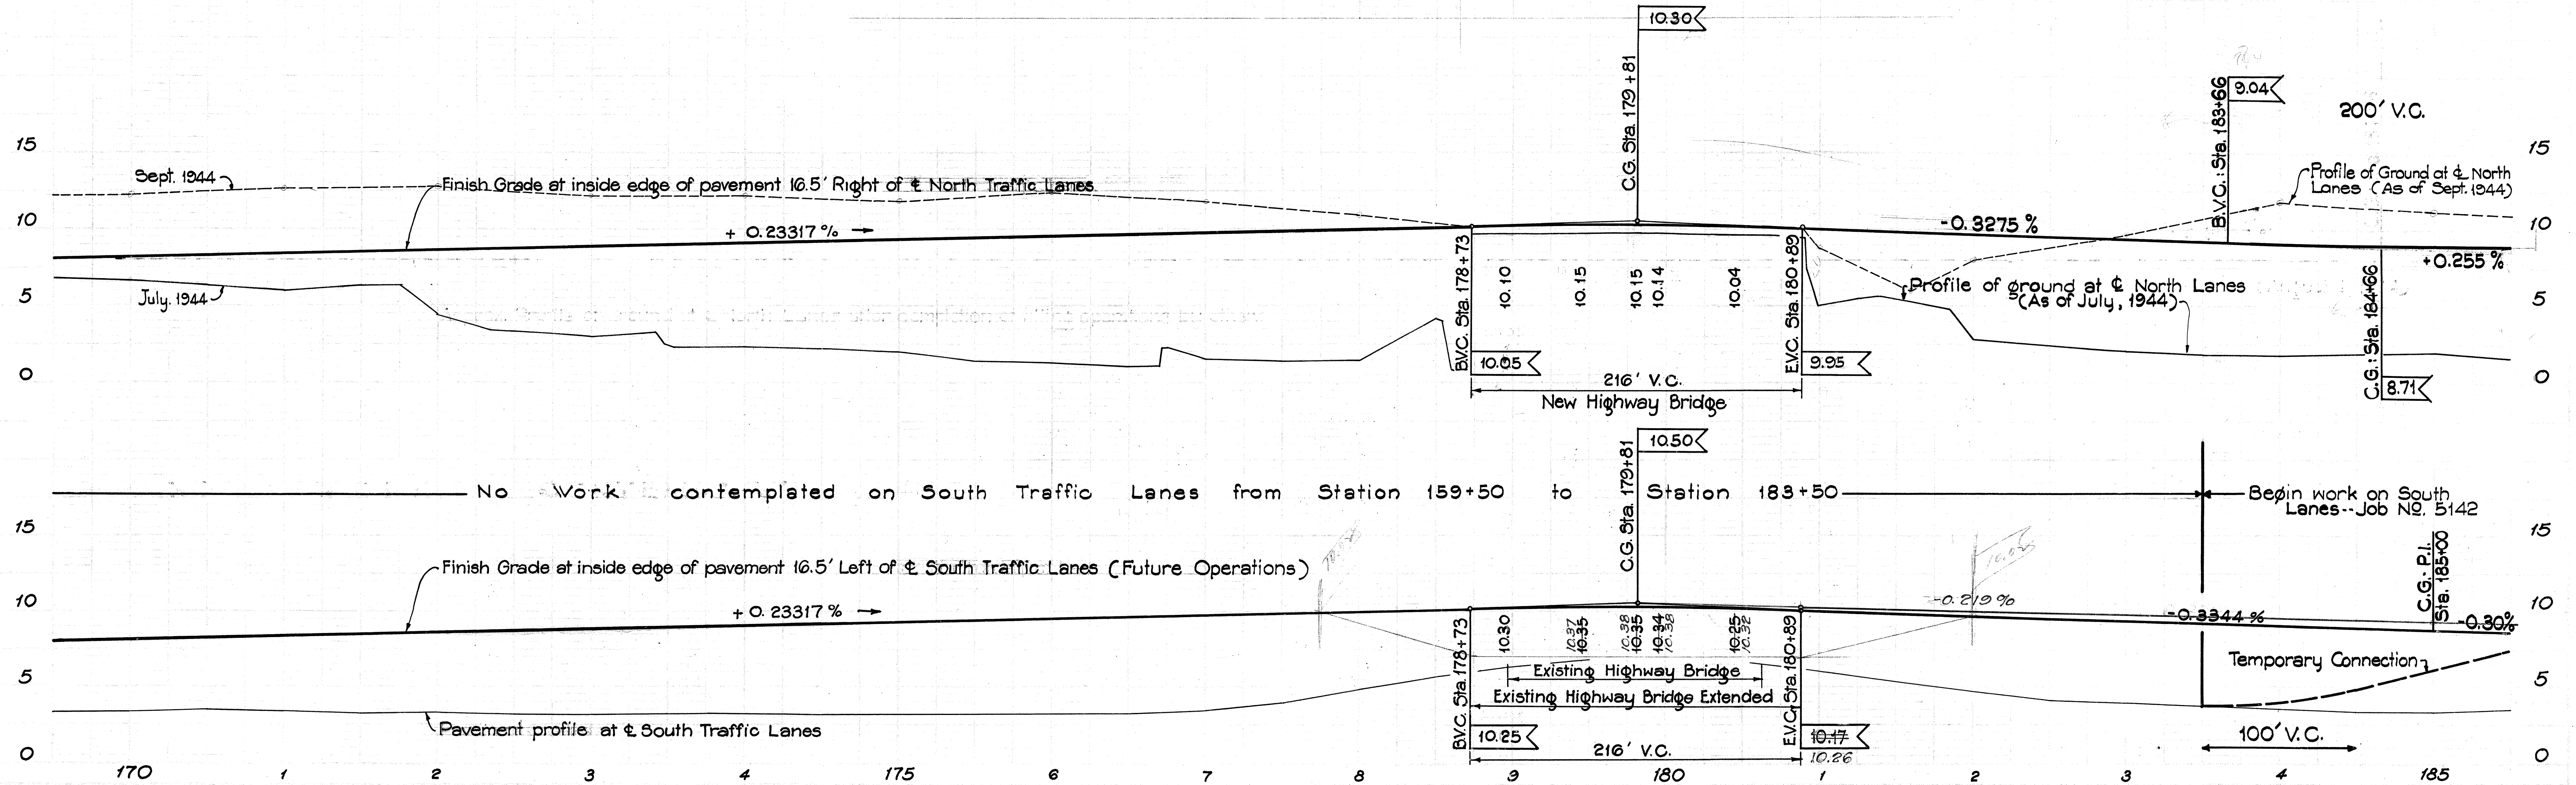



Revised: March, 1945
 Revised: July, 1944
 Rechecked: May, 1944
 Checked by: J.O.Y.

FED. ROAD DIST. NO.	STATE	FED. AID PROJ. NO.	FISCAL YEAR	SHEET NO.	TOTAL SHEETS
HAWAII	HAW.	SN FAP 9-D (4)	1944	4	33

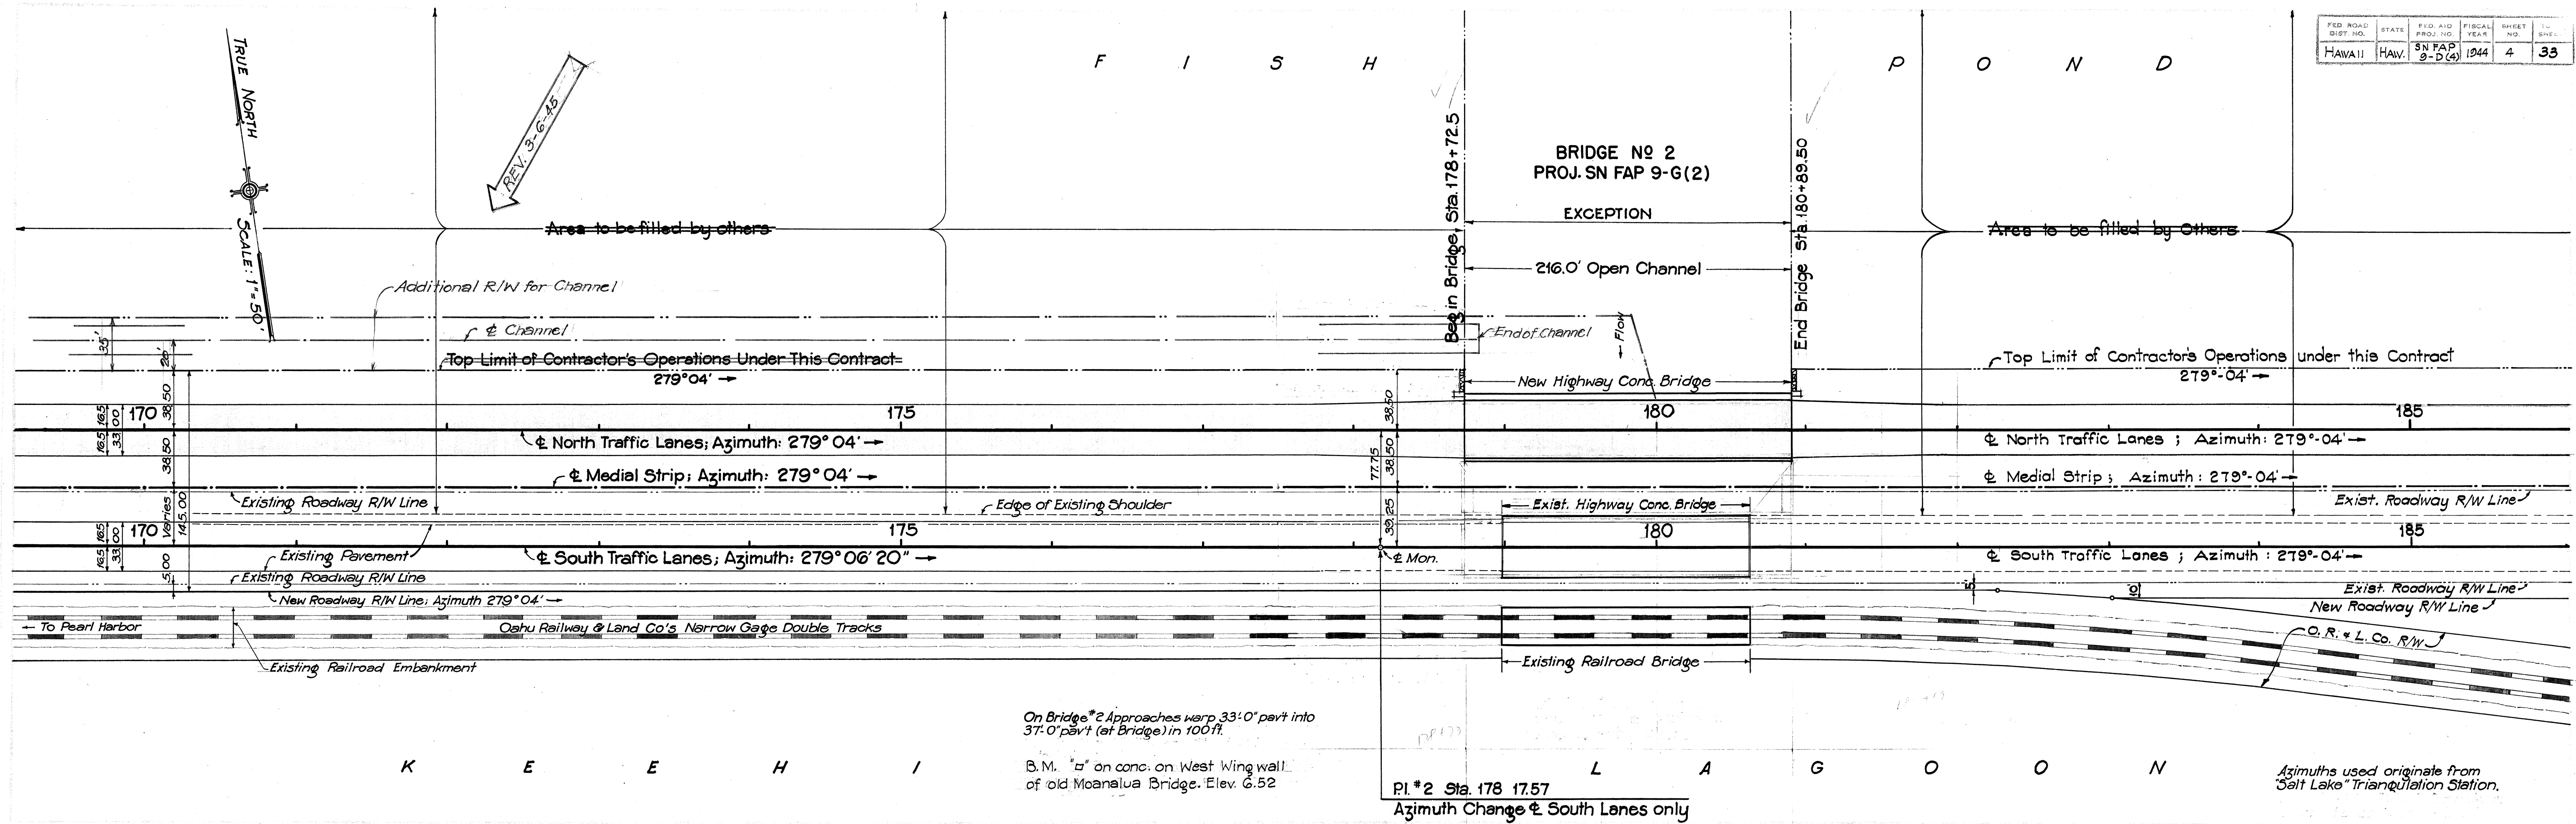


5142.4

FED. ROAD DIST. NO.	STATE	FED. AID PROJ. NO.	FISCAL YEAR	SHEET NO.	TOTAL SHEETS
Hawaii	Haw.	SN-FAP 9D(4)	1944	5	33

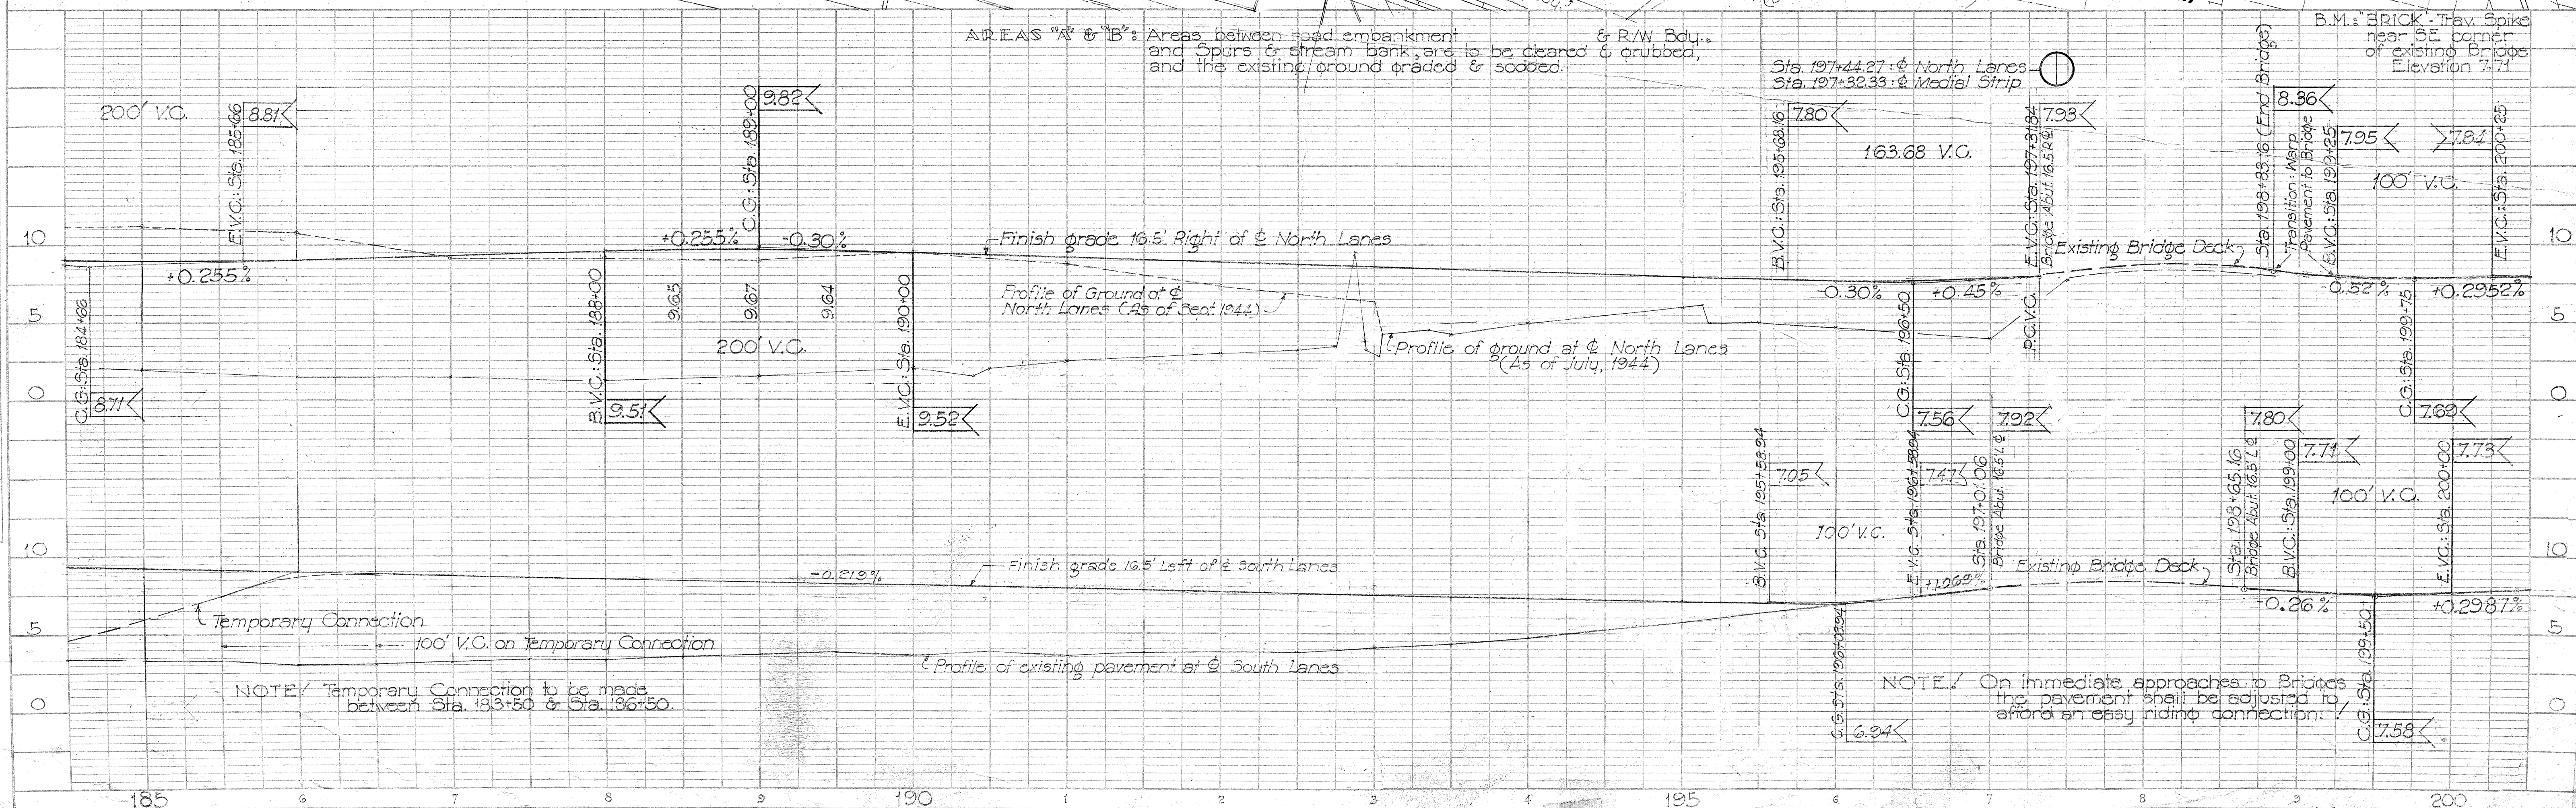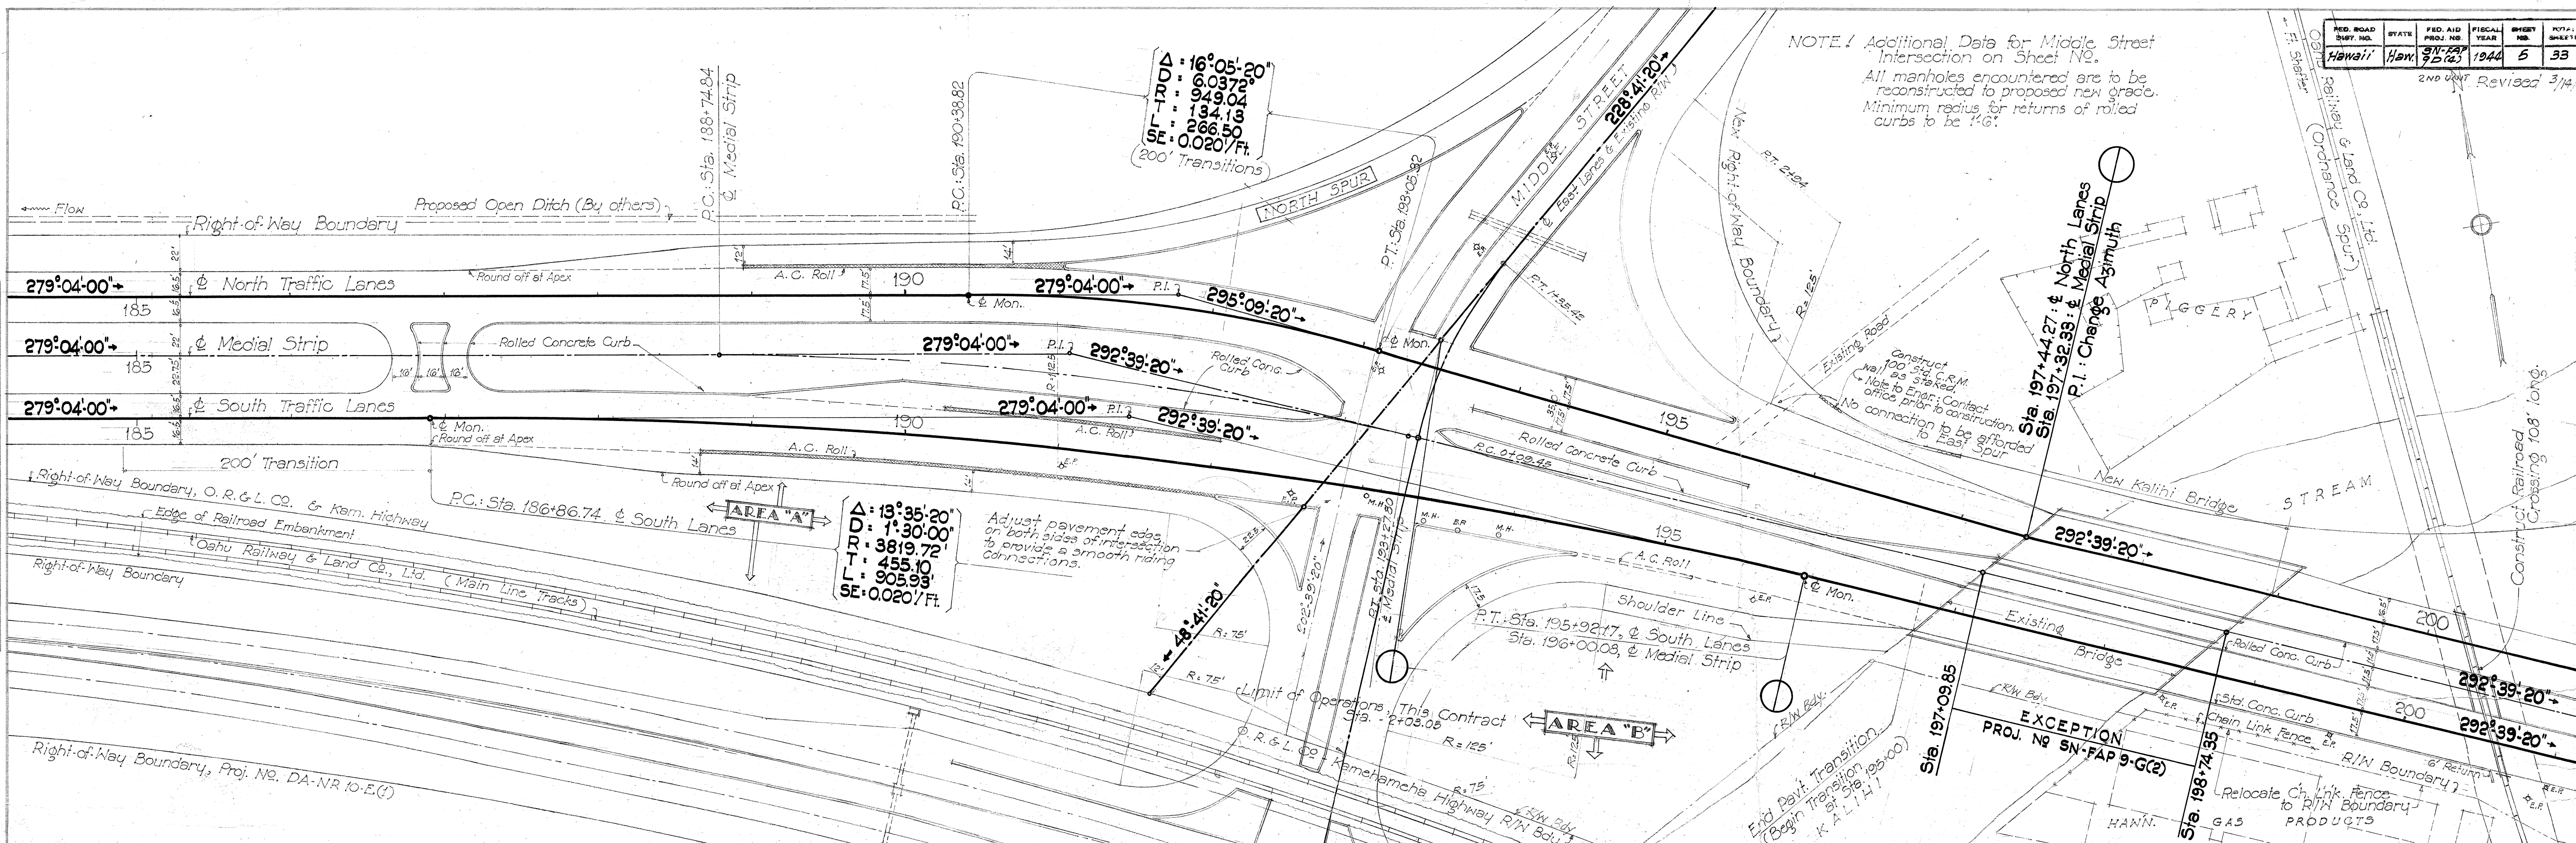

FED. ROAD DIST. NO.	STATE	FED. AID PROJ. NO.	FISCAL YEAR	SHEET NO.	TOTAL SHEETS
HAWAII	HAW.	SN-FAP 9 D (4)	1944		

TRUE NORTH
SCALE 1"=500'

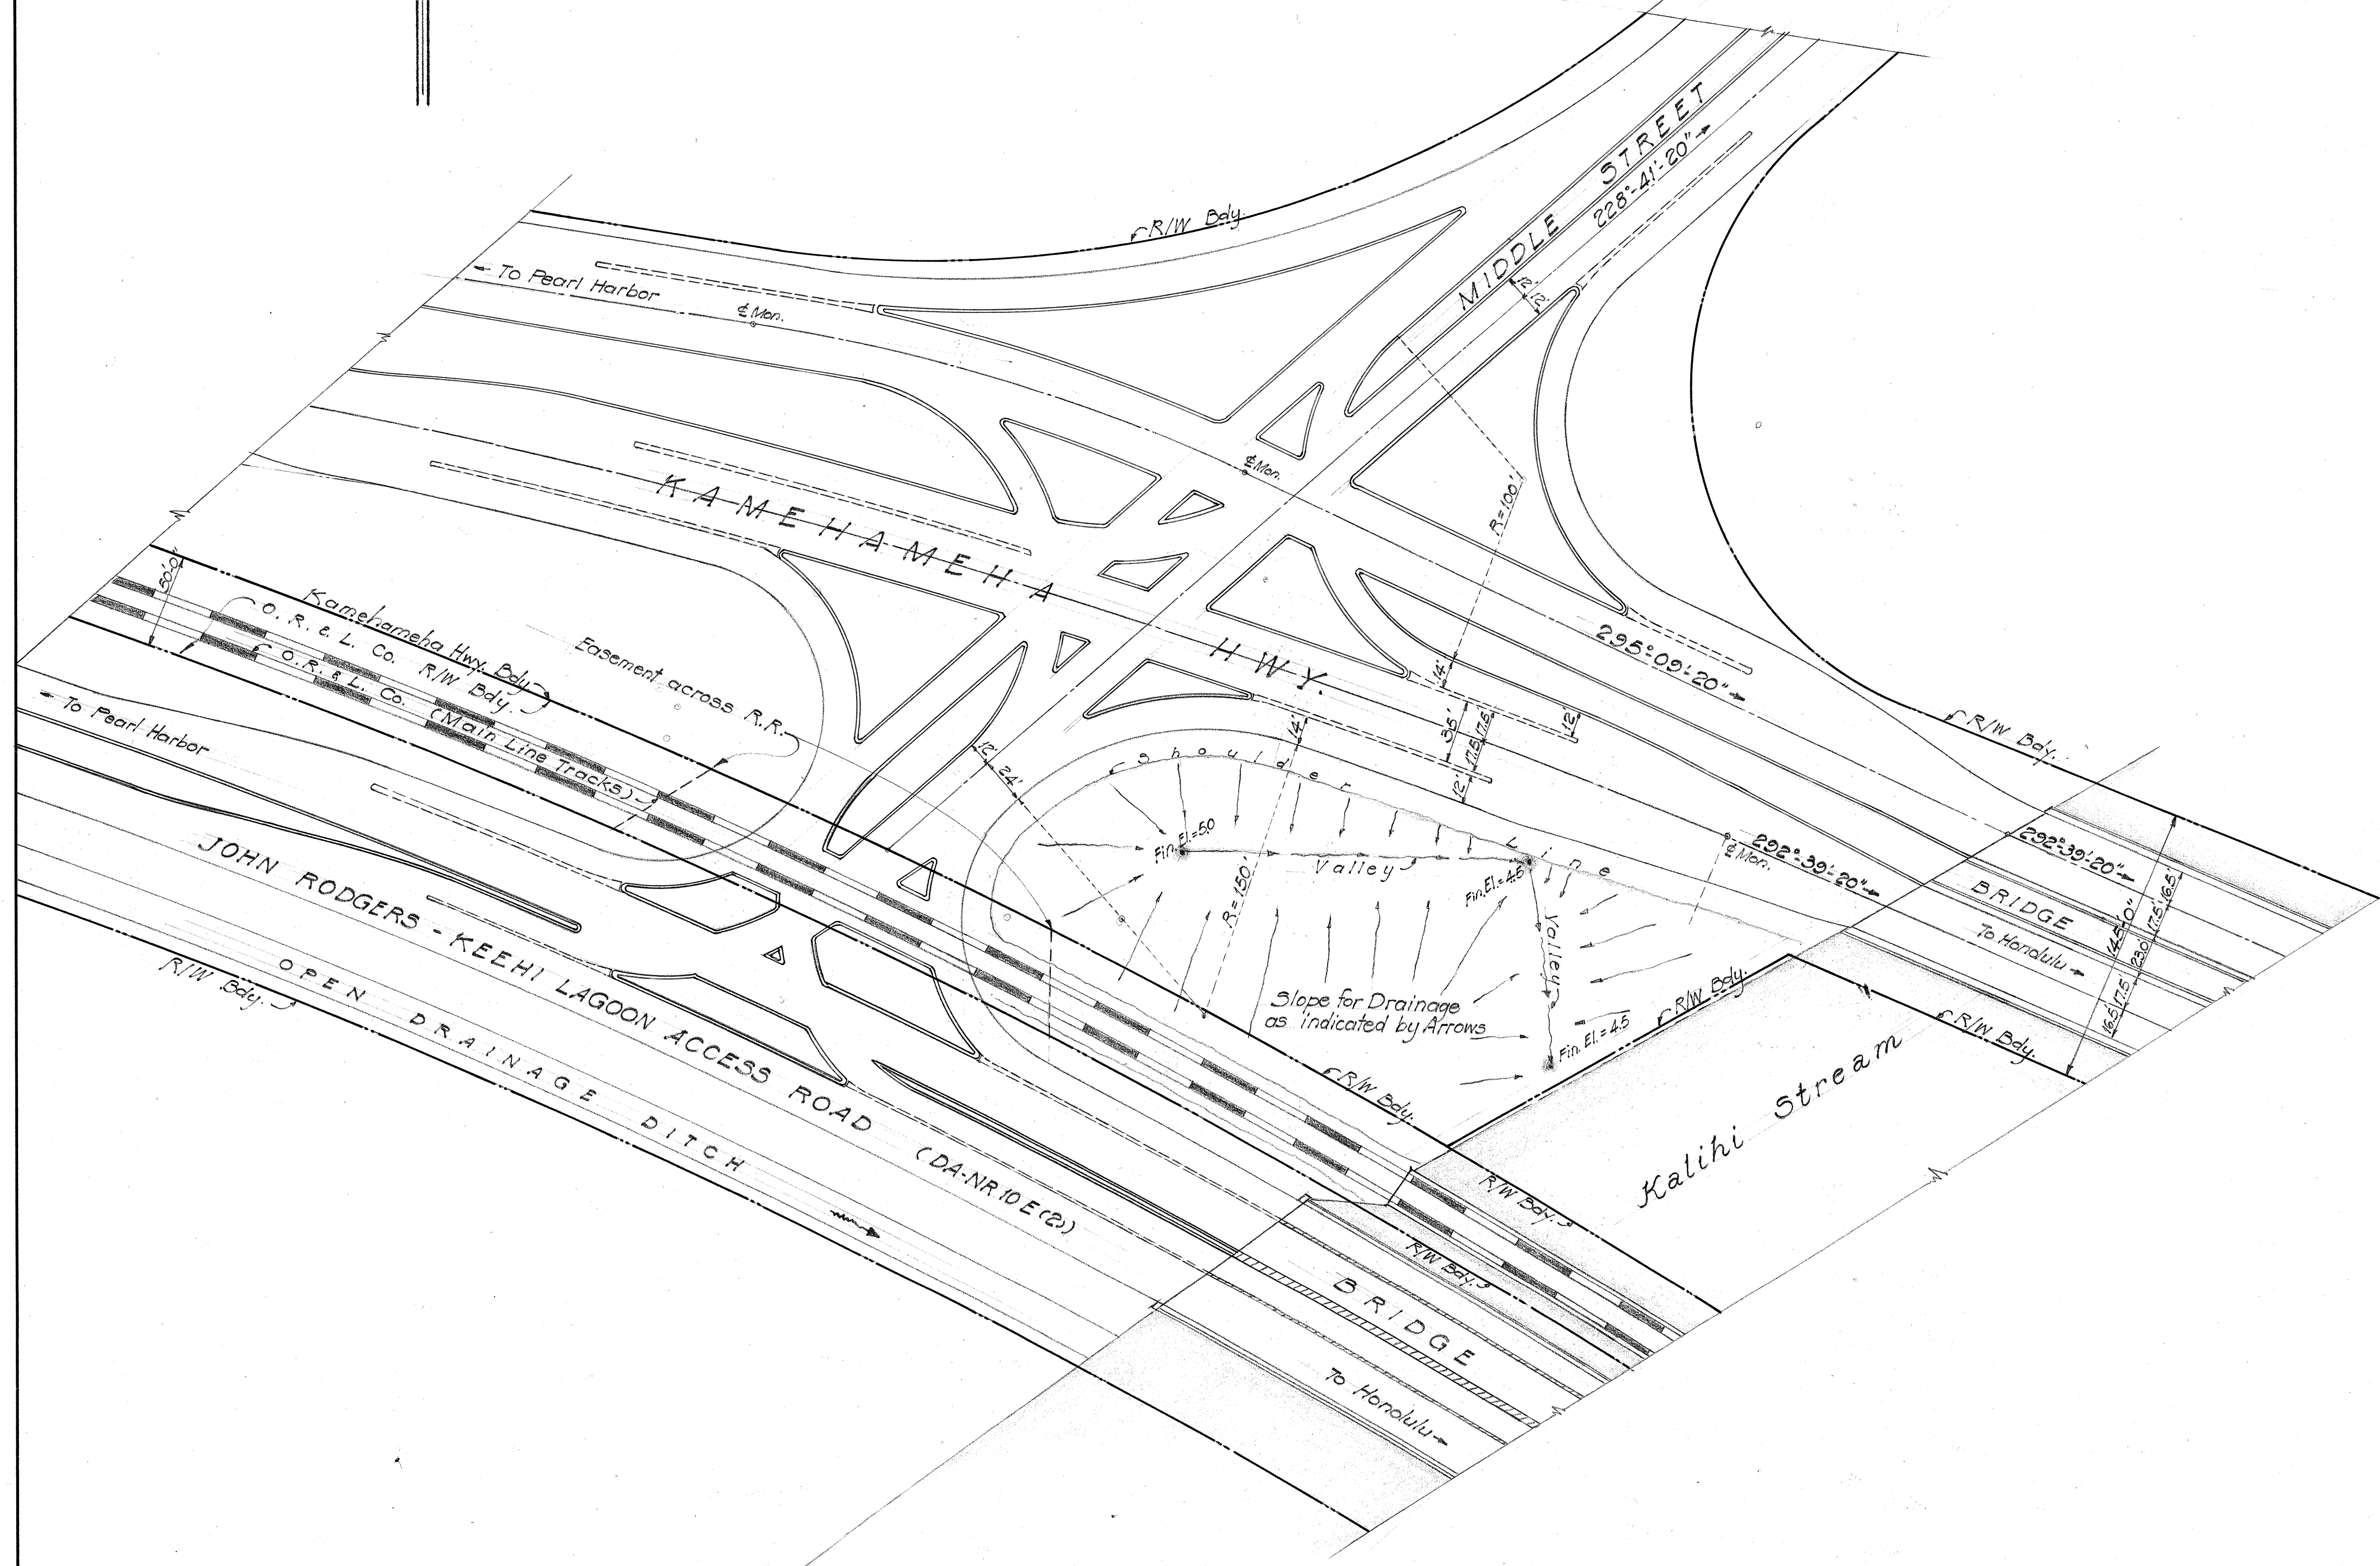

TERRITORIAL HIGHWAY DEPARTMENT
TERRITORY OF HAWAII
SUPPLEMENTARY SHEET TO
SHEET No 5
KAMEHAMEHA HWY.
PROJECT No SN-FAP 9 D (4)
Sept. 1944



ORIGINAL PLAN	DATE
NOTED BY	
QUANTITIES BY	
CHECKED BY	
No.	

TERRITORY OF HAWAII
TERRITORIAL HIGHWAY DEPARTMENT
HONOLULU T. H.

PLAN OF PROPOSED
FLASHER SIGNALS FOR RAILROAD CROSSING ON KAMEHAMEHA HIGHWAY
FEDERAL AID PROJECT NO. SN FAP 9-D(4)
DISTRICT OF HONOLULU
ISLAND OF OAHU

2.5 20 (1)
4-10-46

Kaena Pt.

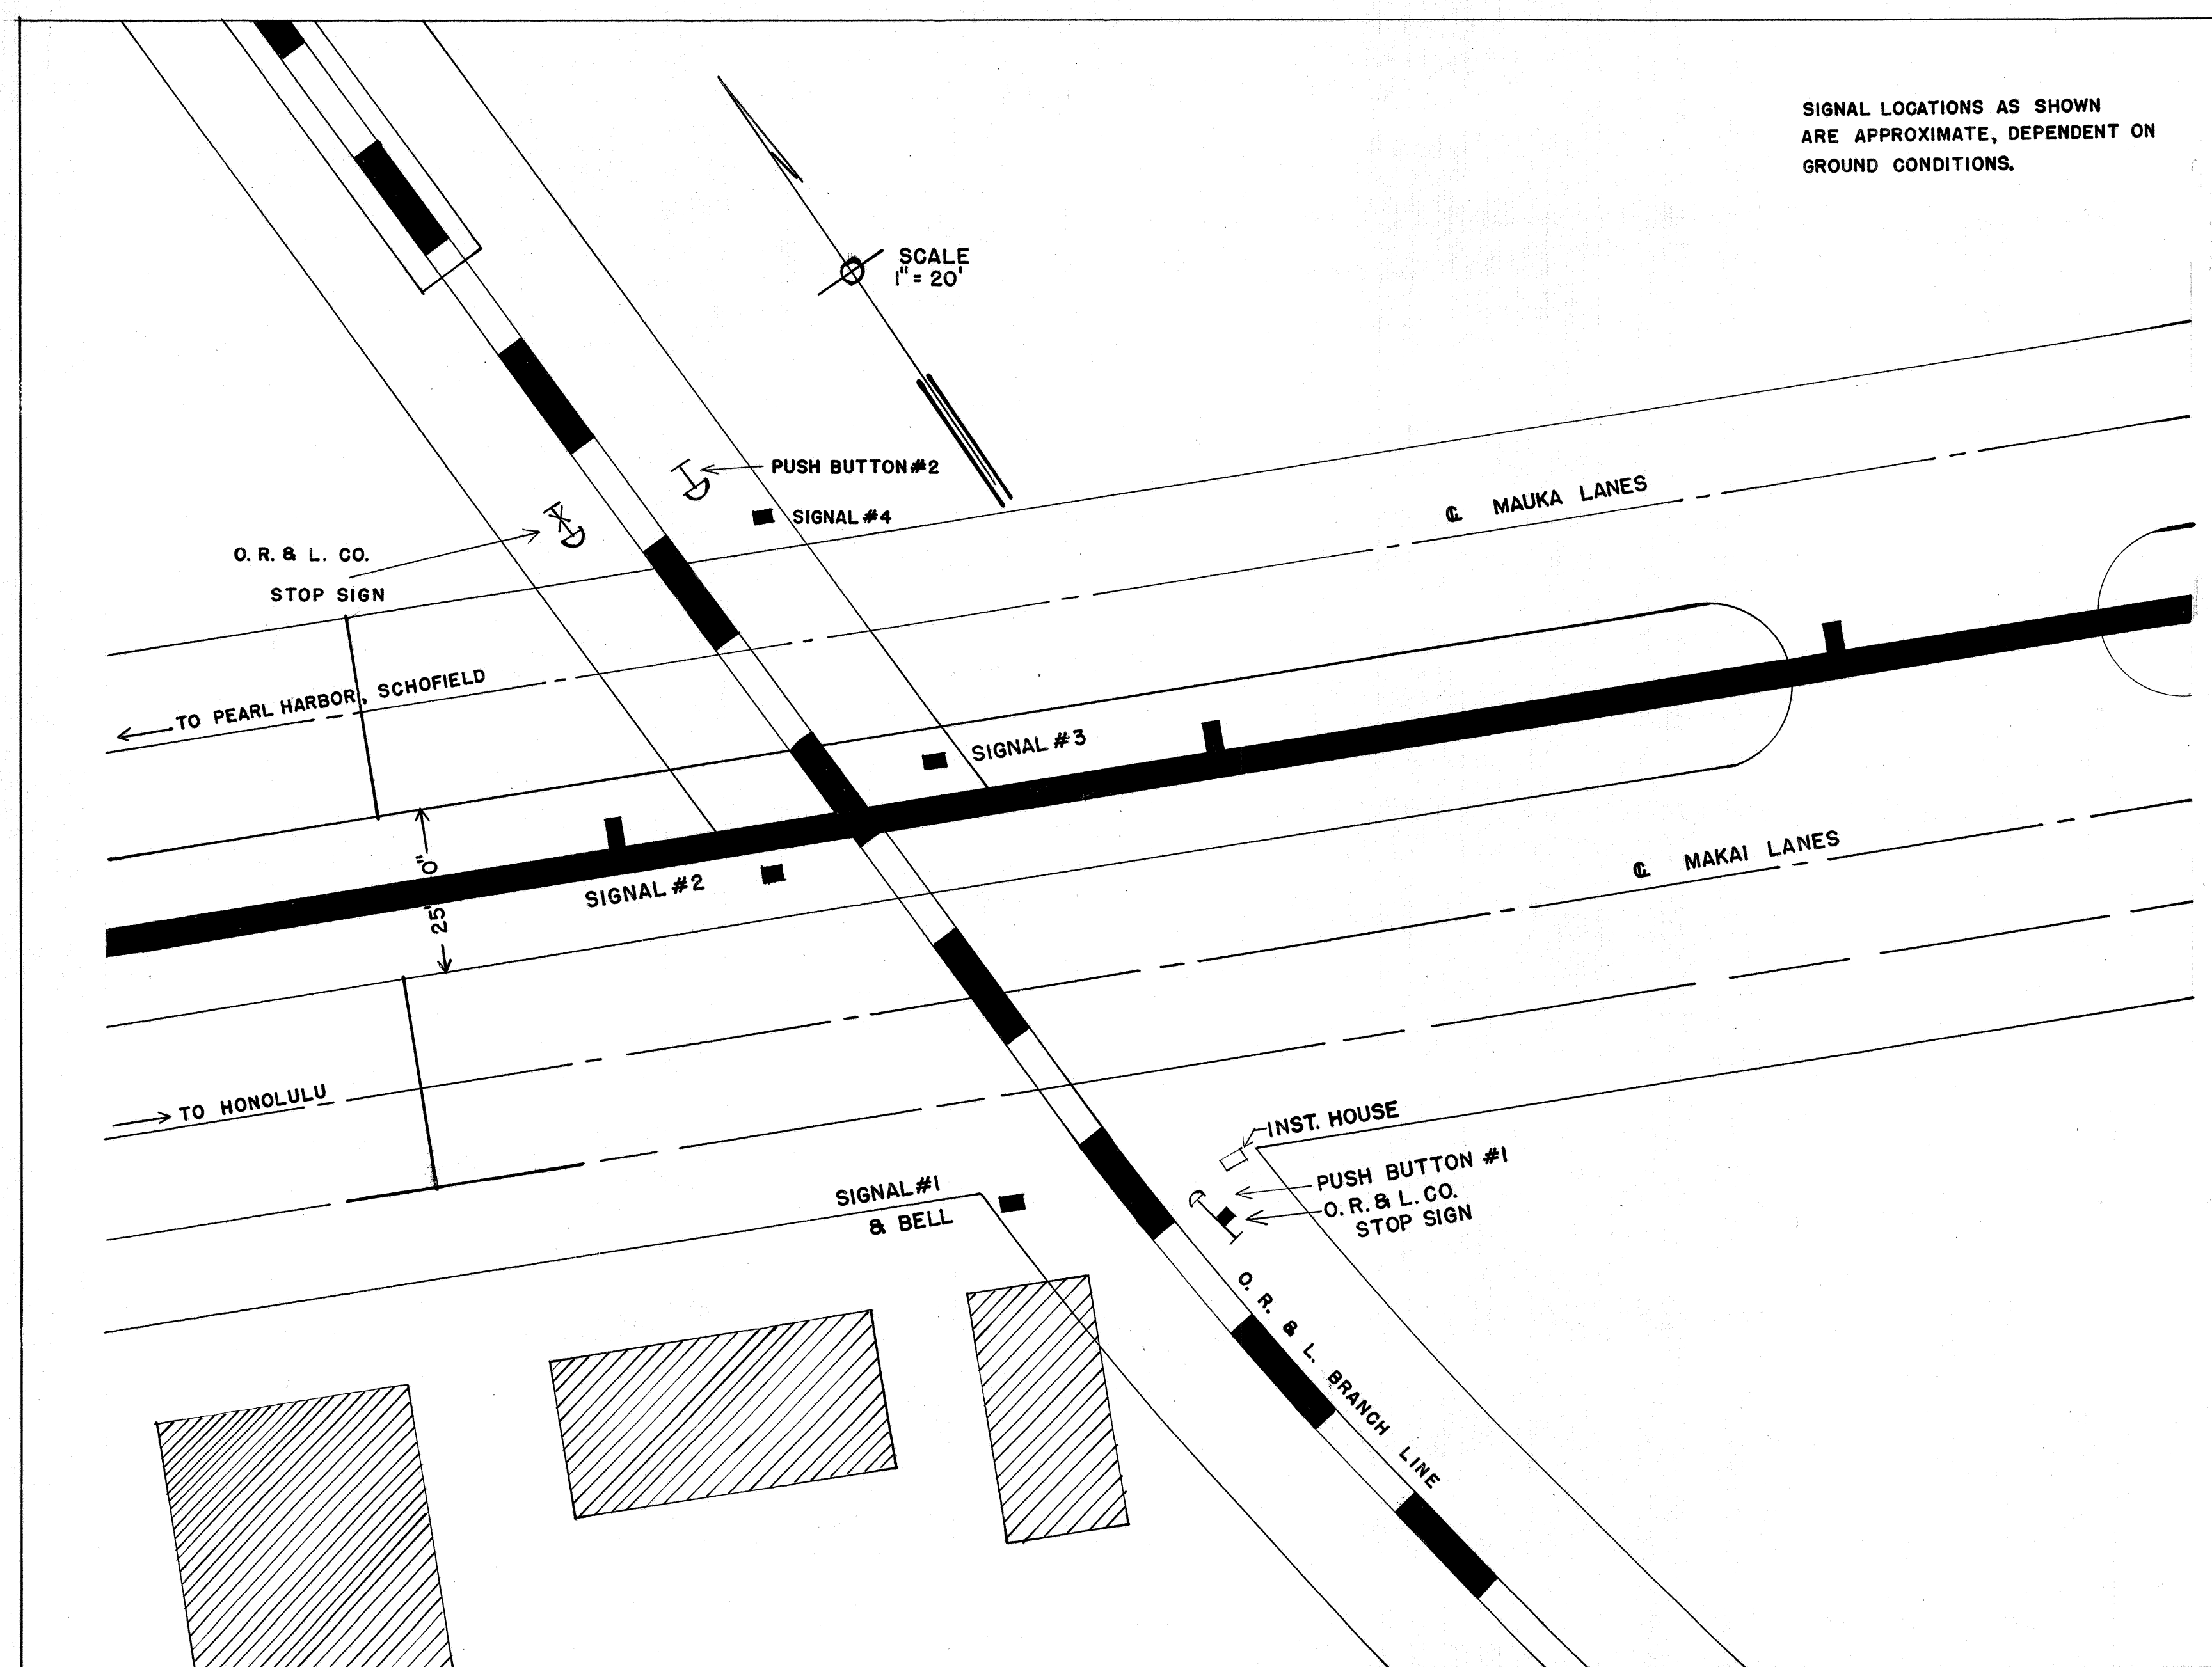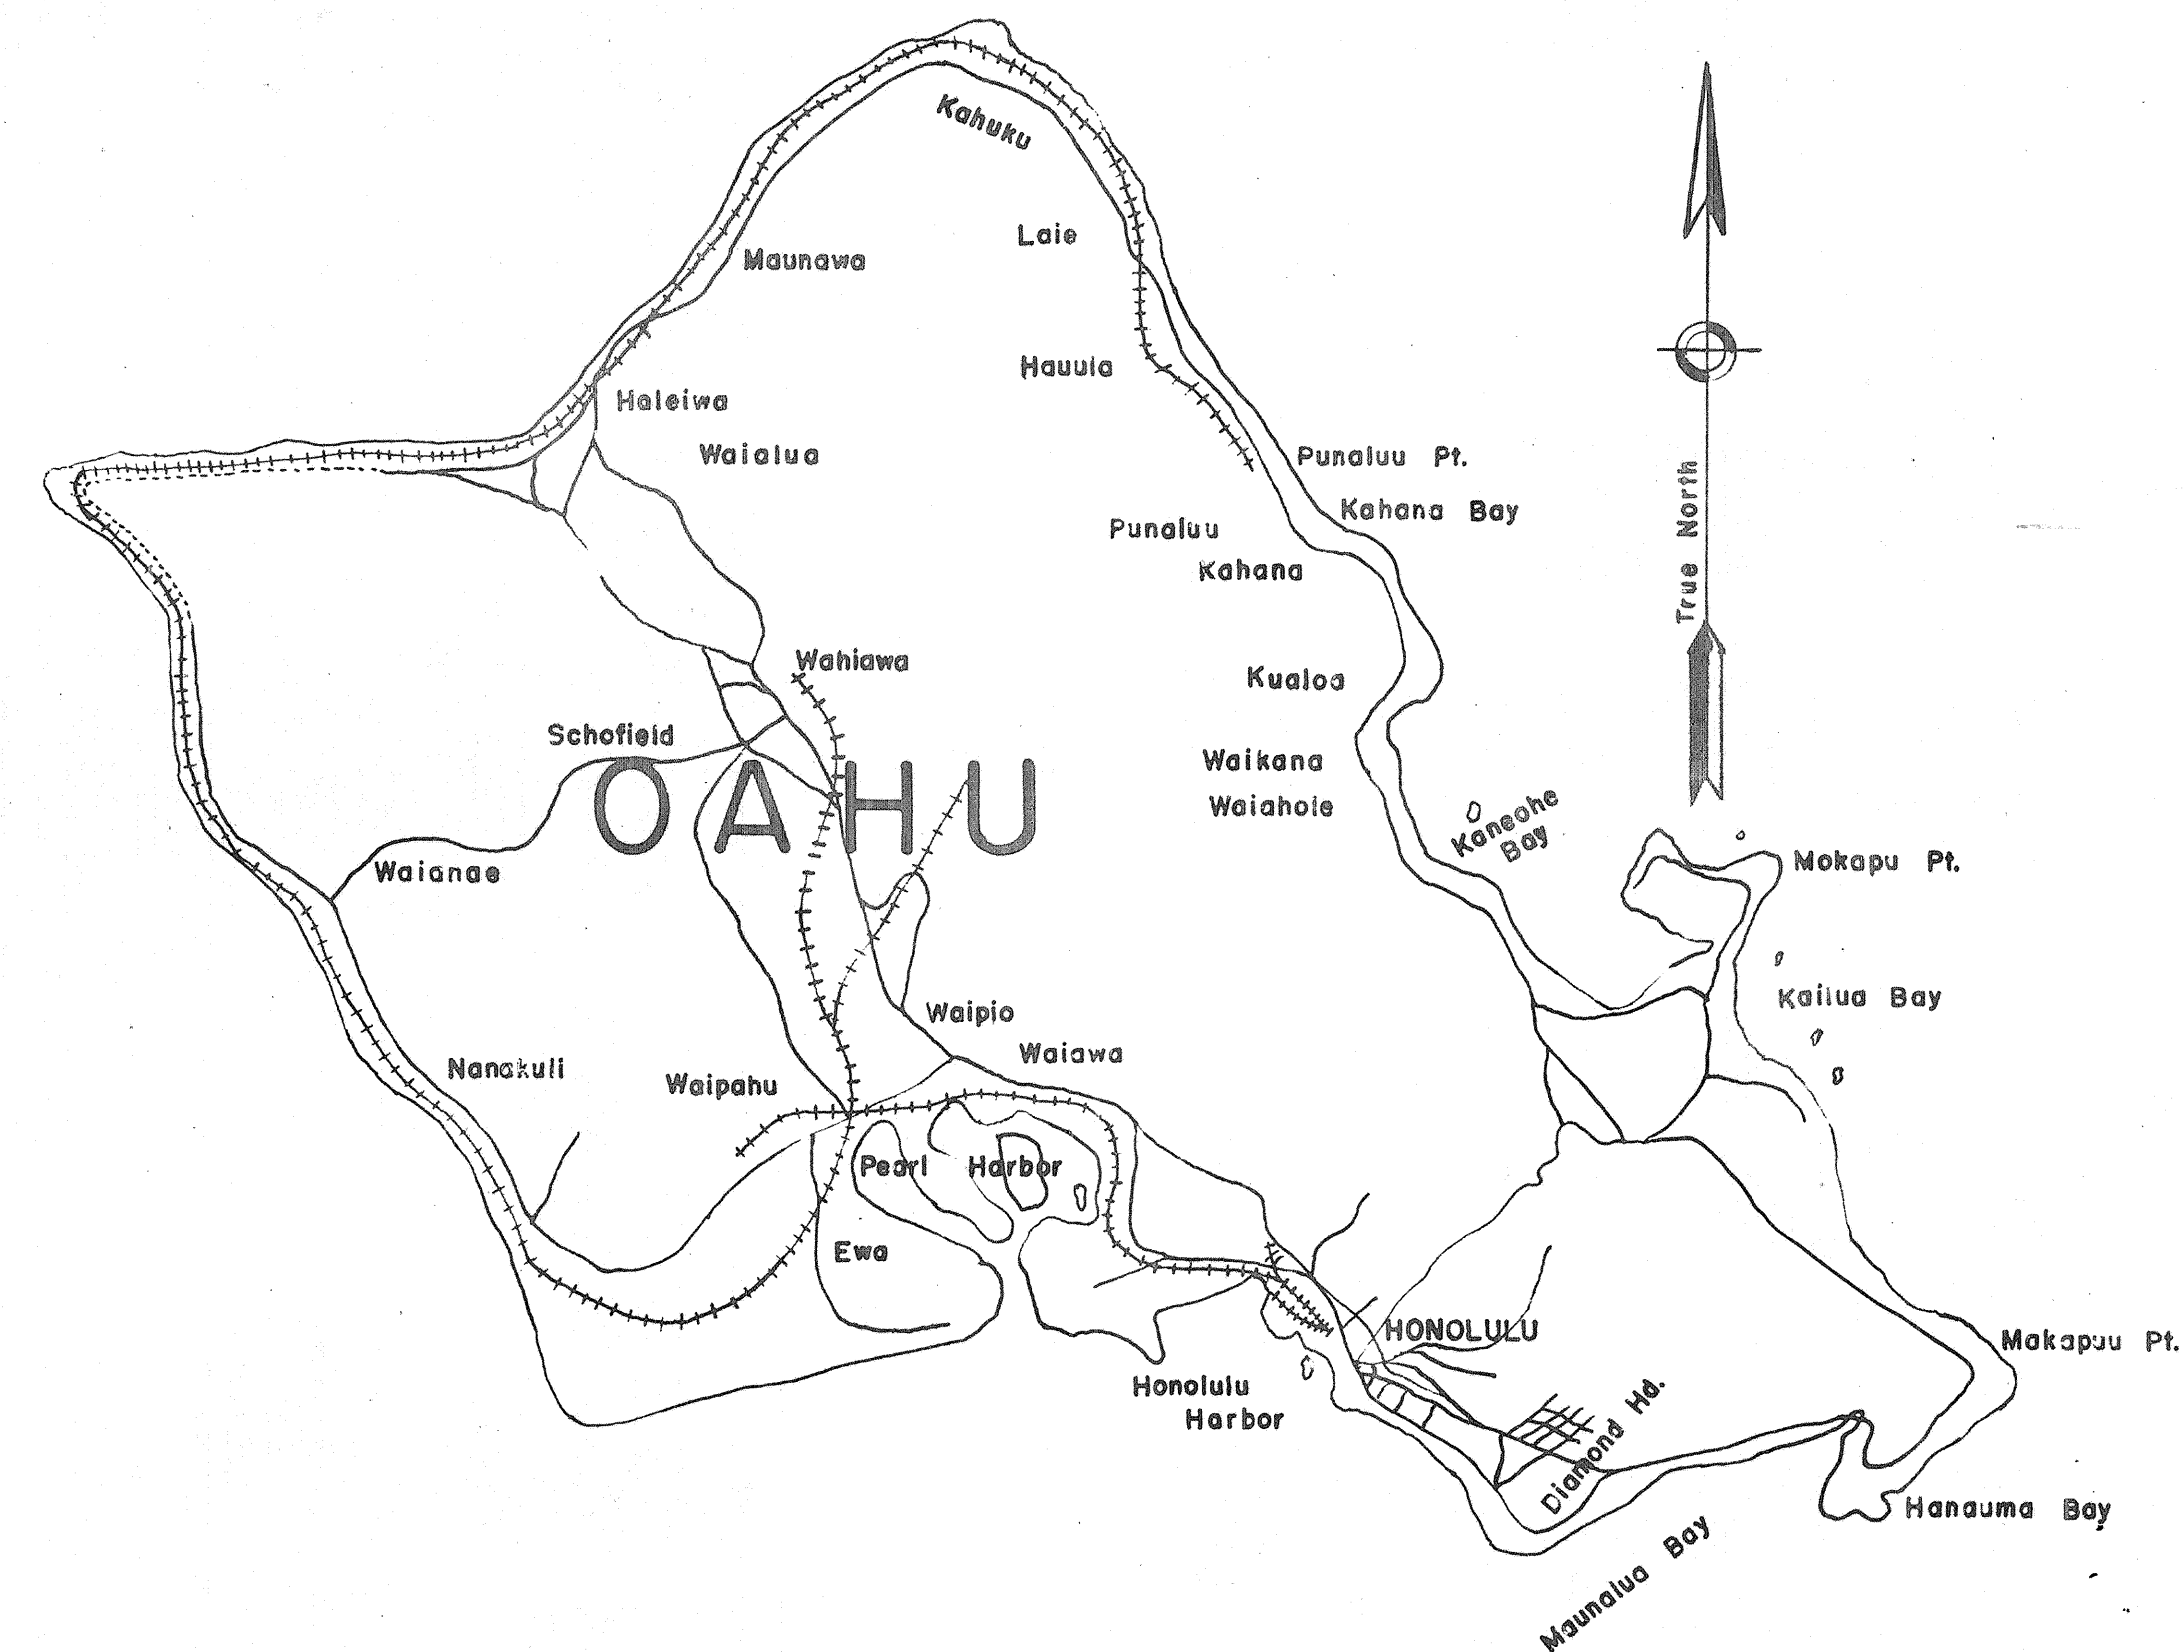


SIGNAL LOCATIONS AS SHOWN
ARE APPROXIMATE, DEPENDENT ON
GROUND CONDITIONS.

APPROVED
Territorial Highway Engineer


RECOMMENDED FOR APPROVAL
District Engineer
PUB.RDS.ADM. FED. WKS.AGENCY
APPROVED
Division Engineer
PUB.RDS.ADM. FED. WKS.AGENCY

5142.6A

DATE
SURVEY PLOTTED BY
DESIGNED BY
DRAWN BY
NOTE BOOK
QUANTITIES CHECKED BY
CHECKED BY

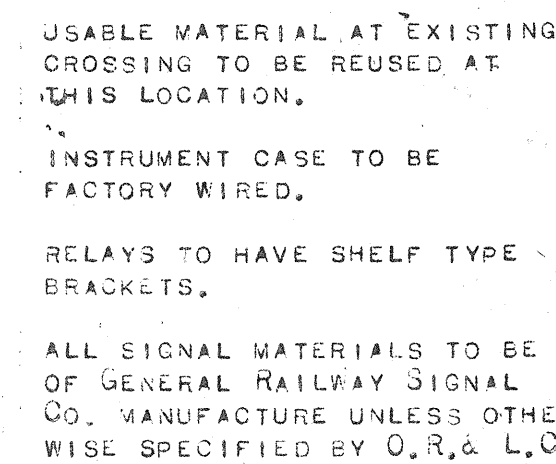

The Sordis Railway Crossing on
 Kanchamunda Hwy. SW 74° 9 9-10 (L)
 Part No

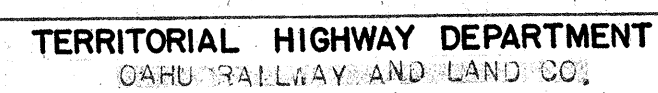

HONOLULU, HAWAII.

CHS 1030

TYPICAL CIRCUIT AND STANDARD MATERIALS FOR AAR FLASHING
LIGHT HIGHWAY CROSSING PROTECTION MANUALLY CONTROLLED.


MALKA - MAKAL LANE CROSSING

Flasher Signals for Railroad Crossing on Kamehameha Highway
EAP No. SN EAP 9-D(4)


1995-1996 22:1

FED. ROAD DIST. NO.	STATE	FED. AID PROJ. NO.	FISCAL YEAR	SHEET NO.	TOTAL SHEETS
HAWAII	HAW.	SN-FAP 9-D(4)	1944	7	33

FED. ROAD DIST. NO.	STATE	FED. AID PROJ. NO.	FISCAL YEAR	SHEET NO.	TOTAL SHEETS
HAWAII	HAW.	SN-FAP 9-H(2)	1944	3	9

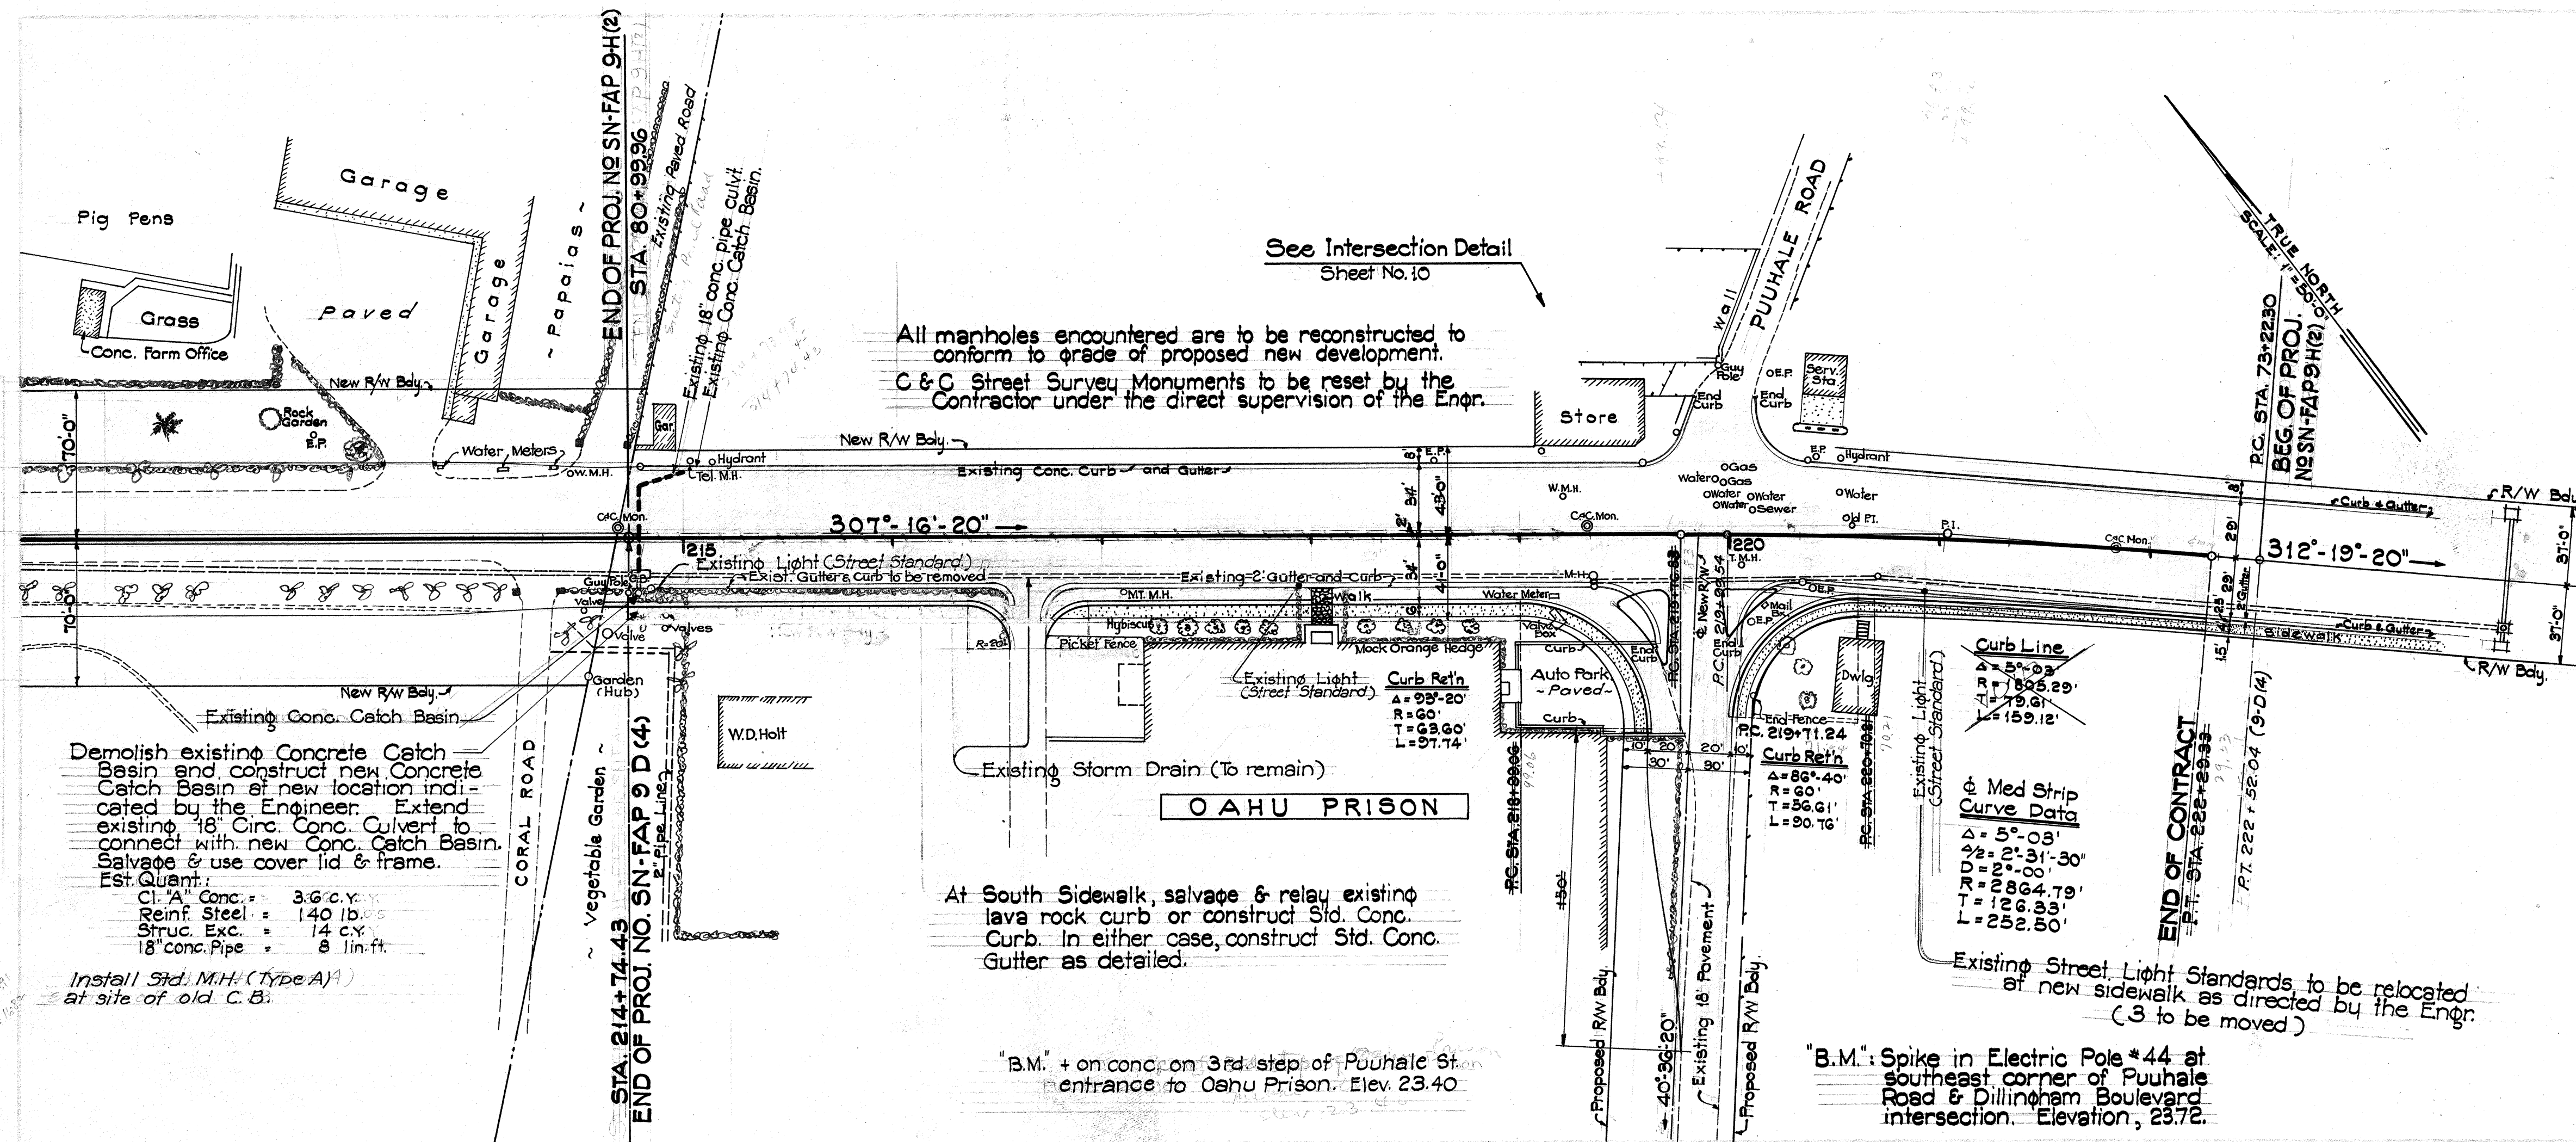

Azimuths used originate from "Salt Lake" Triangulation Station. Salvage all existing lava rock curbs and use them in new location.

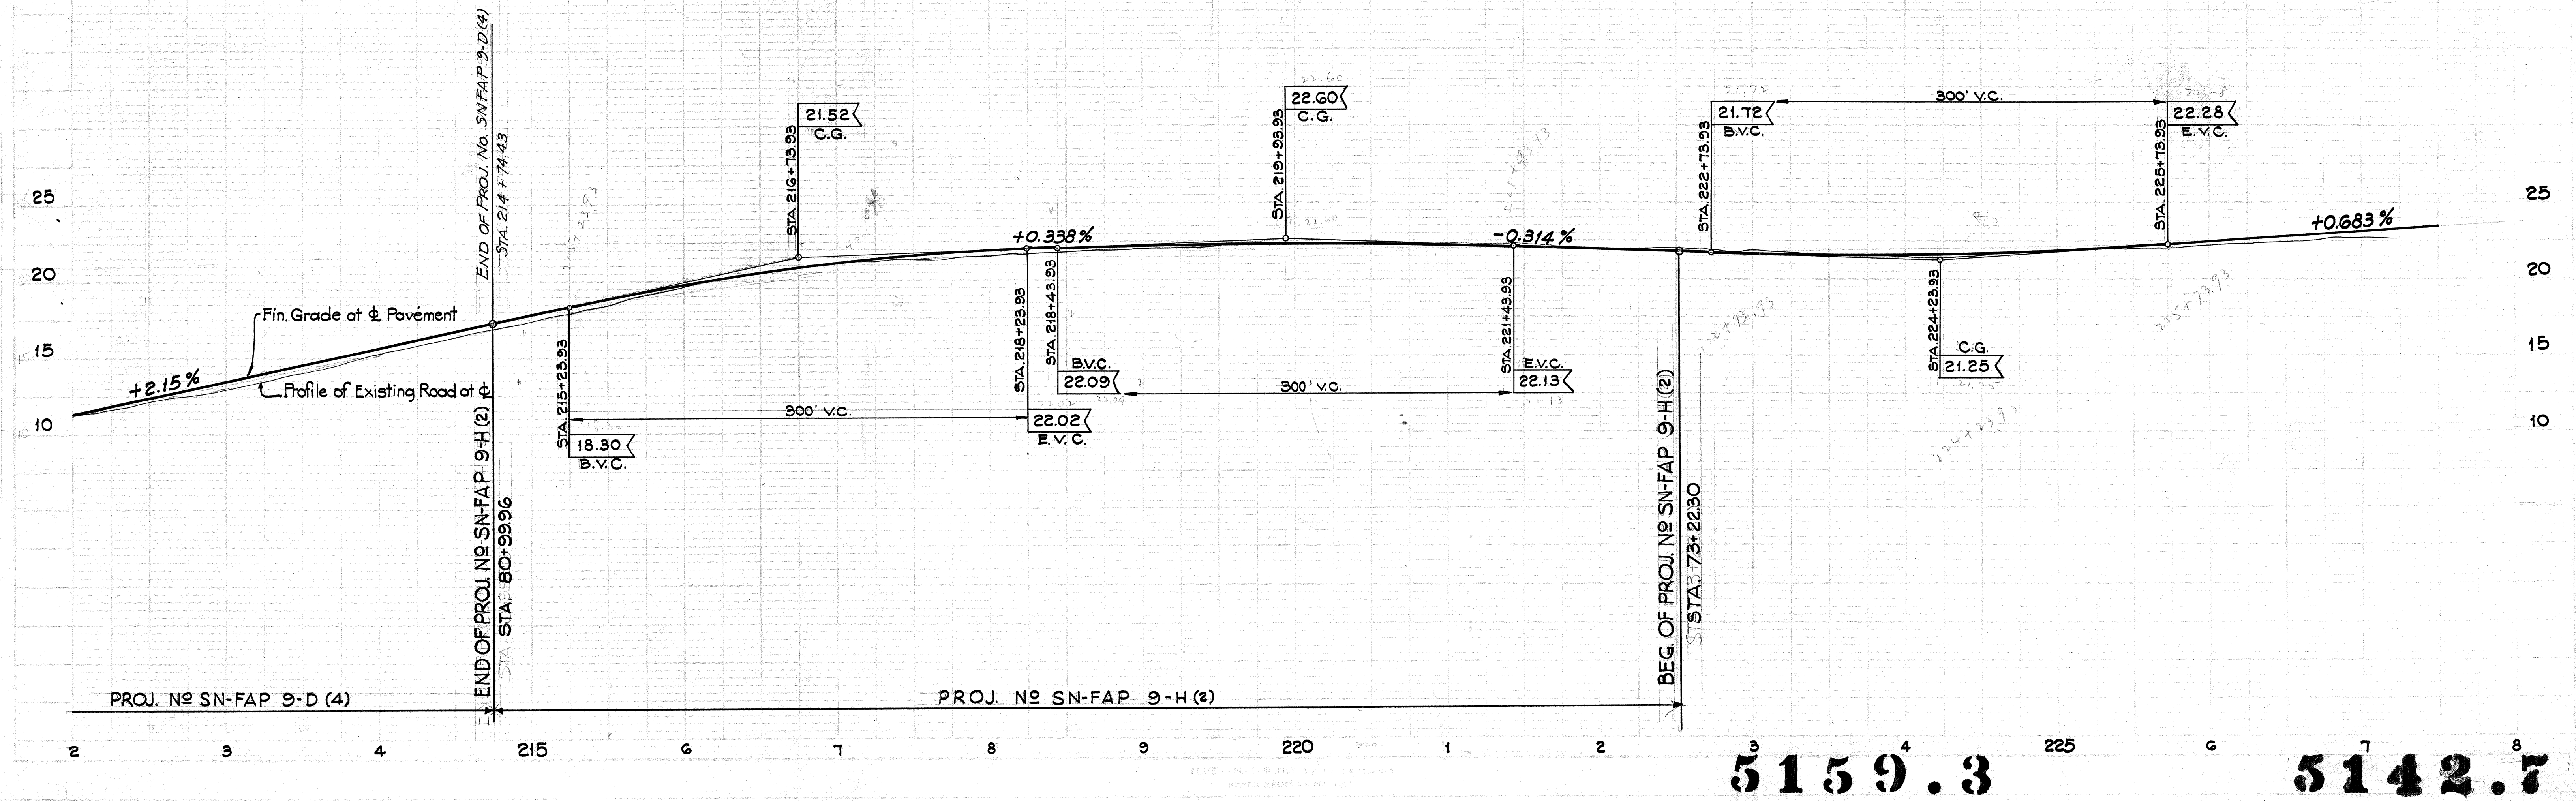

5159.3

5142.7

2nd Unit.
Revised 3/14/45

