

INDEX TO DRAWINGS	
SHEET NO.	DESCRIPTION
1	Title Sheet
2	Typical Sections
3- 8	Plan & Profile
9	Curve & Culvert Details
10	Puuhale Road Intersection
11- 14	Standard Details
15- 33	Cross Sections

All changes made during construction have been shown in red on these tracings and checked by

Resident Engineer.
Date _____

TERRITORY OF HAWAII
TERRITORIAL HIGHWAY DEPARTMENT
HONOLULU T.H.

PLANS OF KAMEHAMEHA HIGHWAY PUULOA ROAD TO OAHU PRISON


FEDERAL AID PROJECT NO. SN-FAP 9-D(4) *Sw. #2*

HONOLULU DISTRICT
ISLAND OF OAHU


SCALE

PLAN 1 INCH = 50 FEET
 PROFILE (HOR.) 1 INCH = 50 FEET
 (VER.) 1 INCH = 5 FEET
 CROSS SECTIONS (HOR.) 1 INCH = 10 FEET
 (VER.) 1 INCH = 10 FEET

Centerline 175
 Boundary (Not Fenced)
 Boundary (Fenced)
 Existing Road
 Railroad Track
 Circular Conc. Culvt.
 Concrete Box Culvt.
 Bridge
 Telephone Pole
 Electric Pole
 Coconut Palm

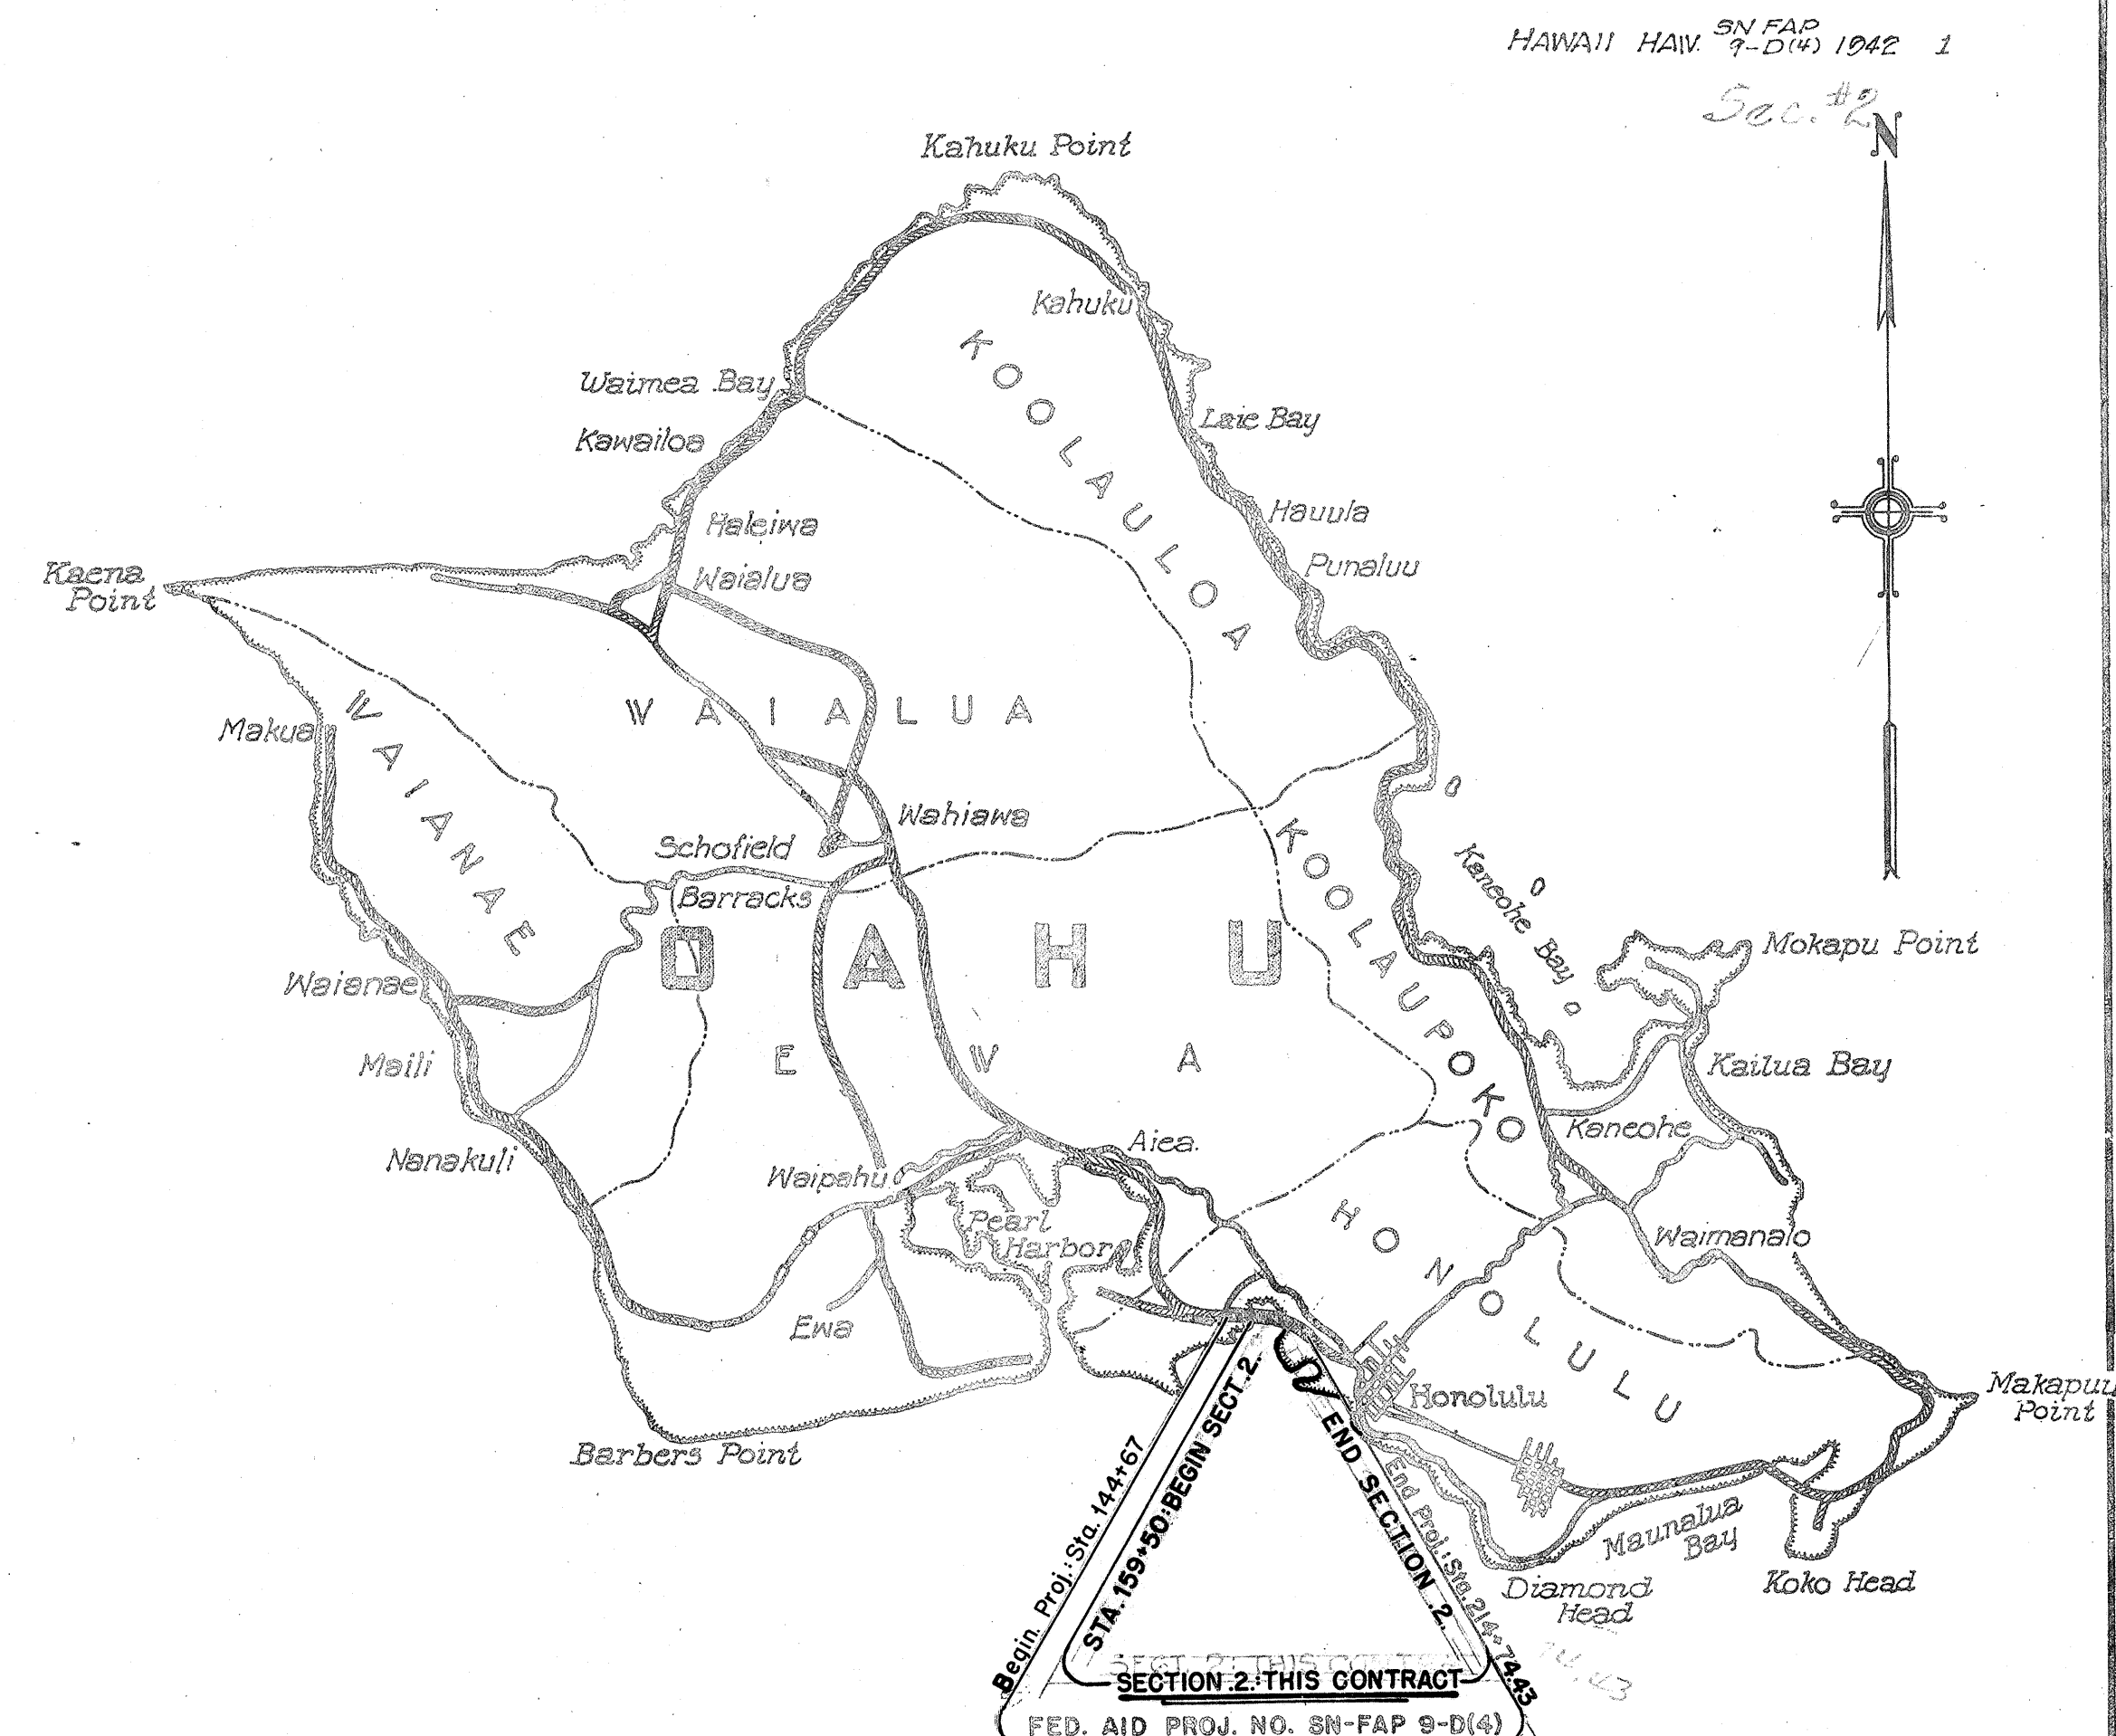

Federal Aid Projects previously constructed or under construction

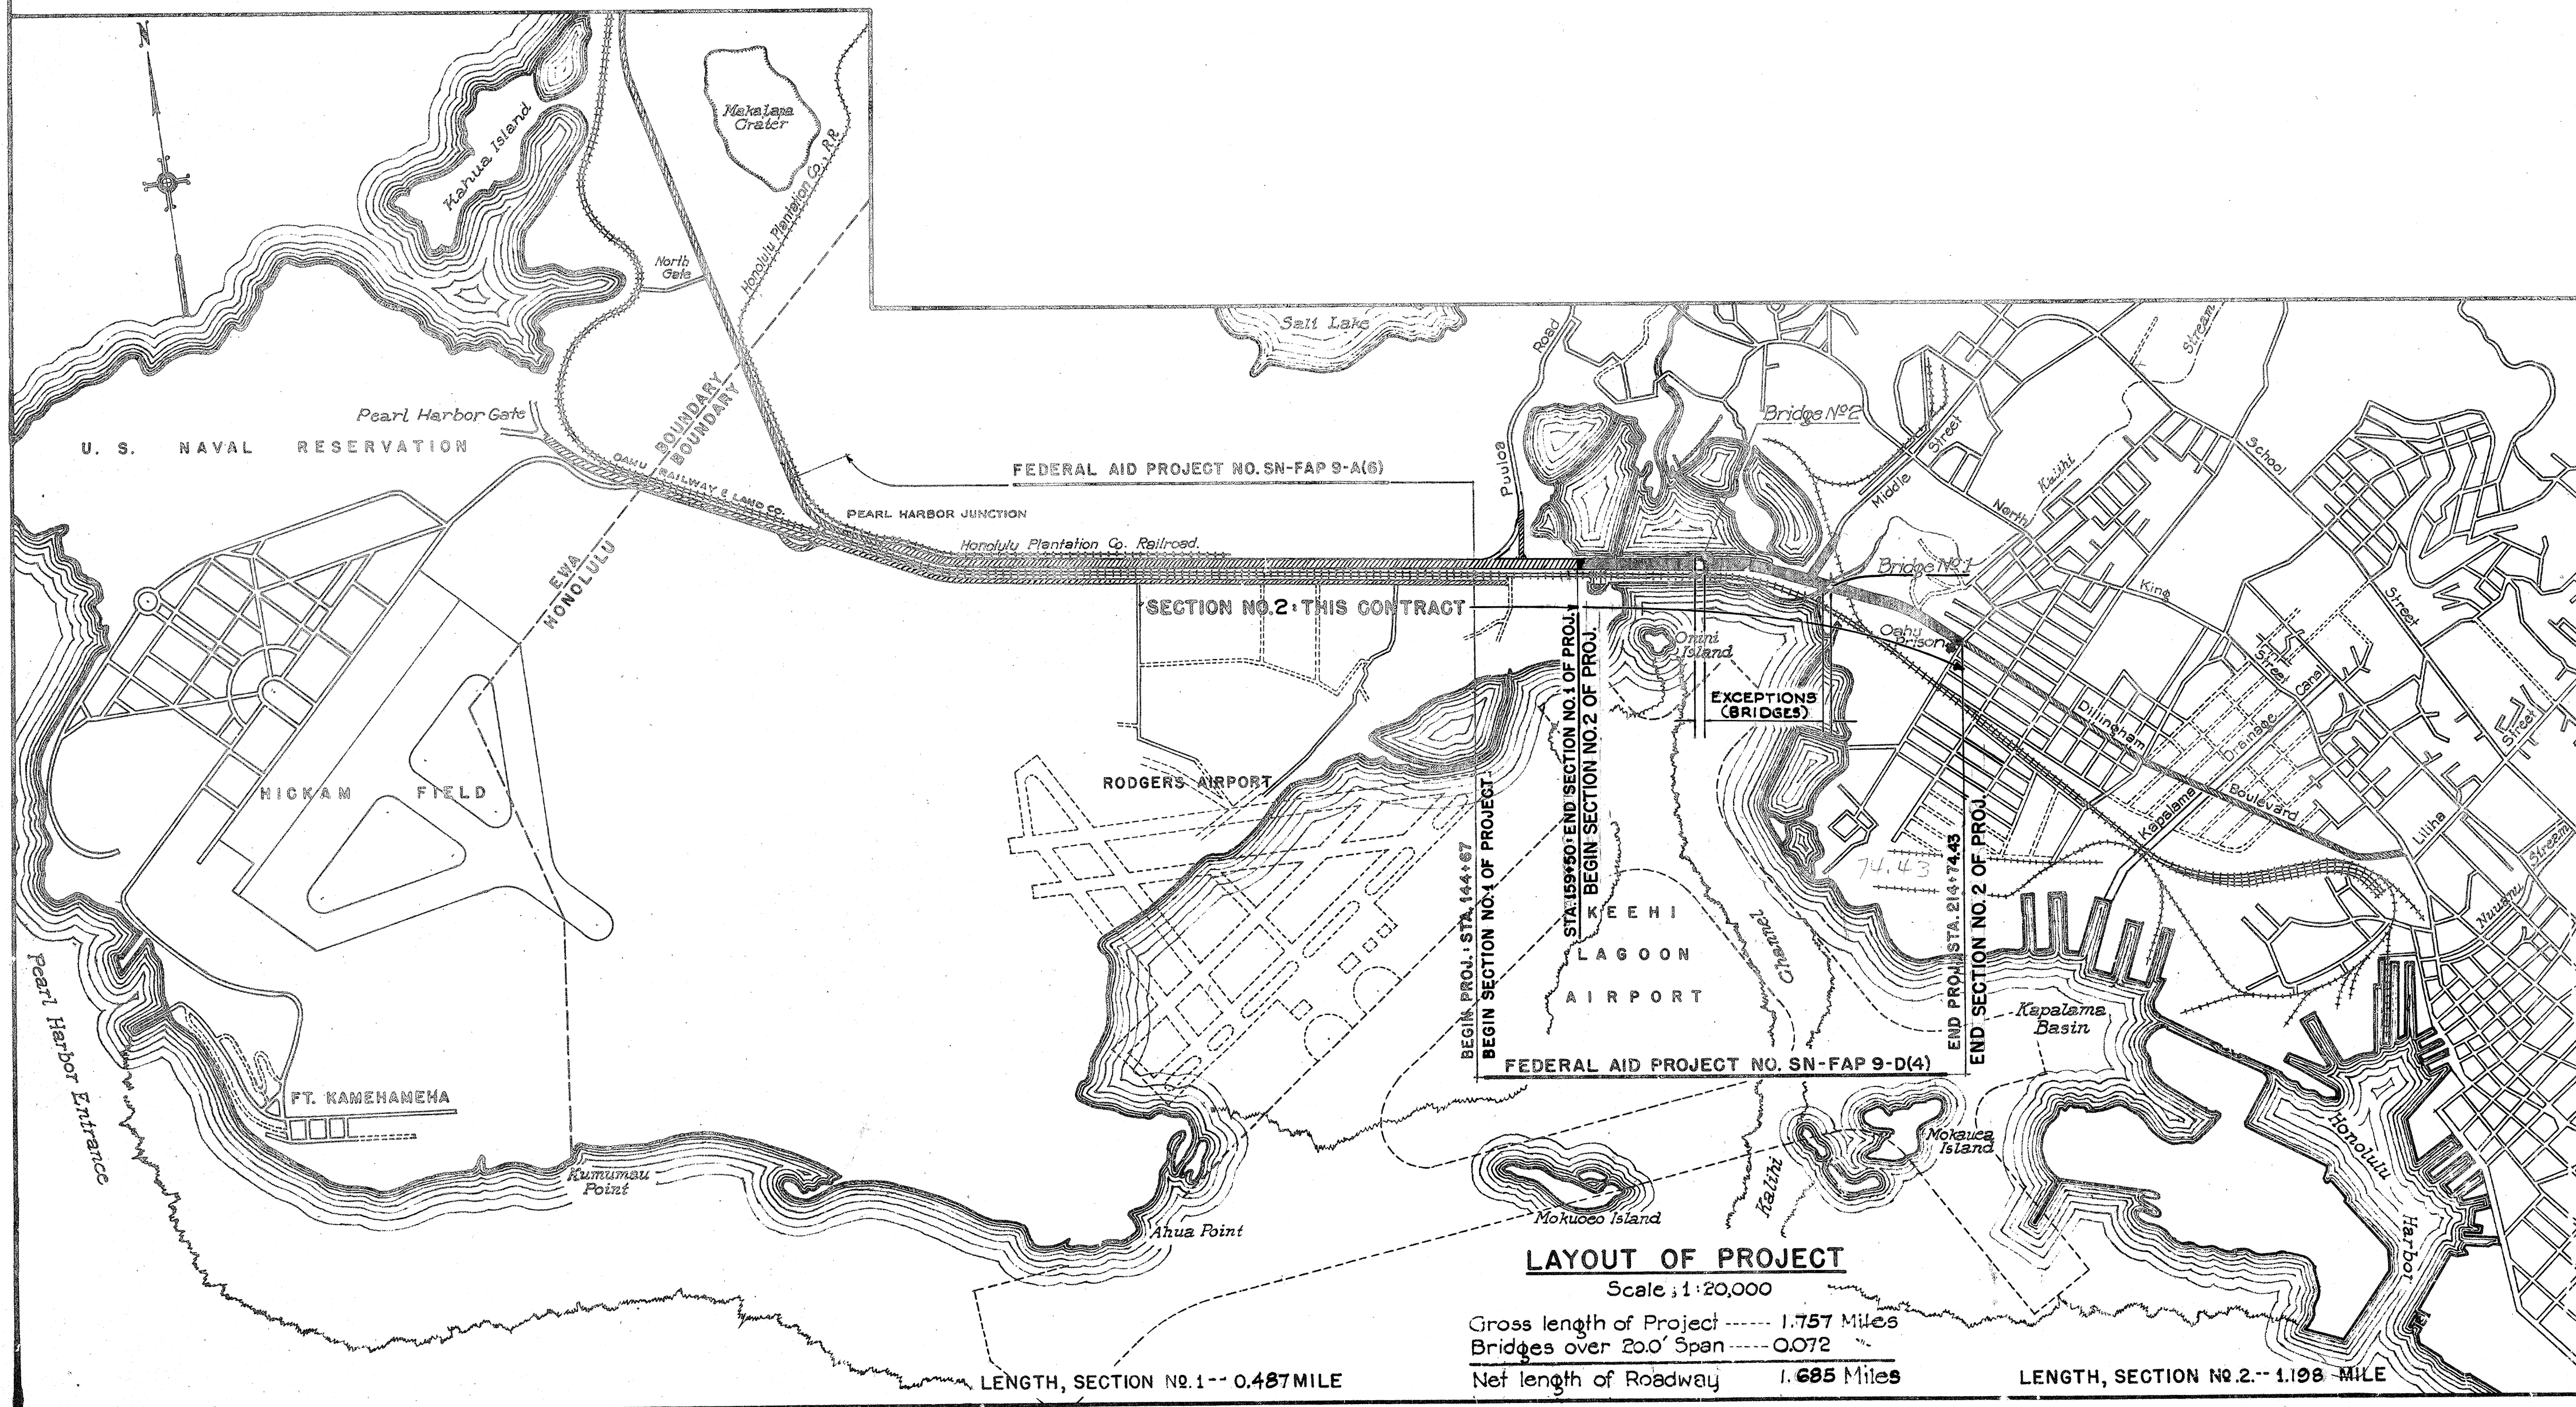

APPROVED
B.F. Rush
 Territorial Highway Engineer
 Date: 8-26-44

APPROVED

RECOMMENDED FOR APPROVAL
 PRINCIPAL HIGHWAY ENGINEER
 Public Roads Administration
 Federal Works Agency

RECOMMENDED FOR APPROVAL
 CHIEF, WESTERN REGION
 Public Roads Administration
 Federal Works Agency

APPROVED
 COMMISSIONER
 Public Roads Administration
 Federal Works Agency

5142.1