
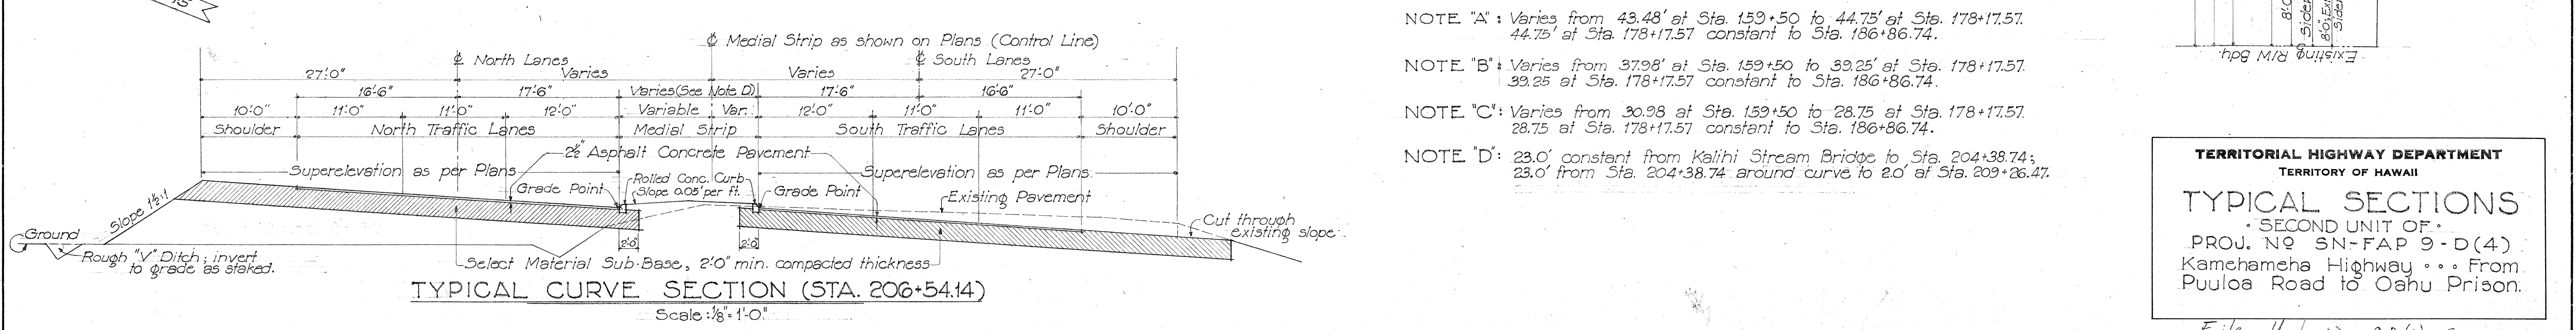
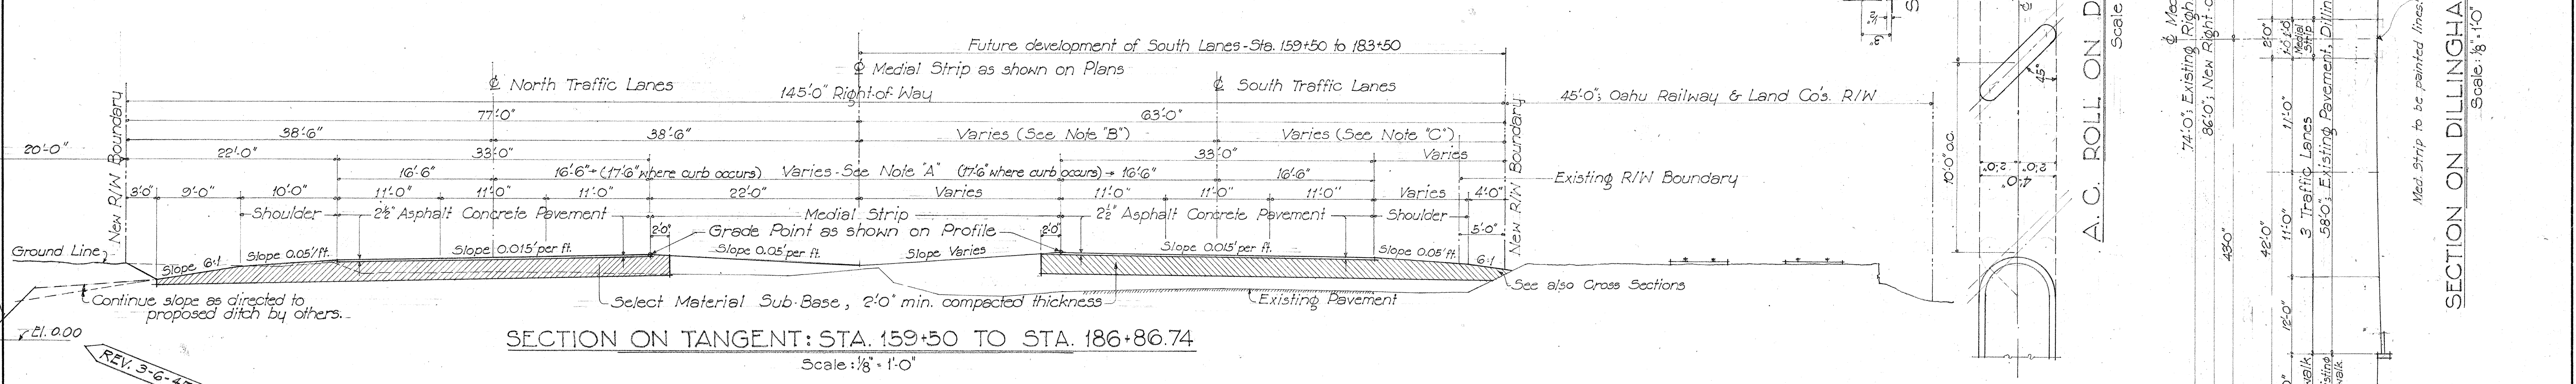
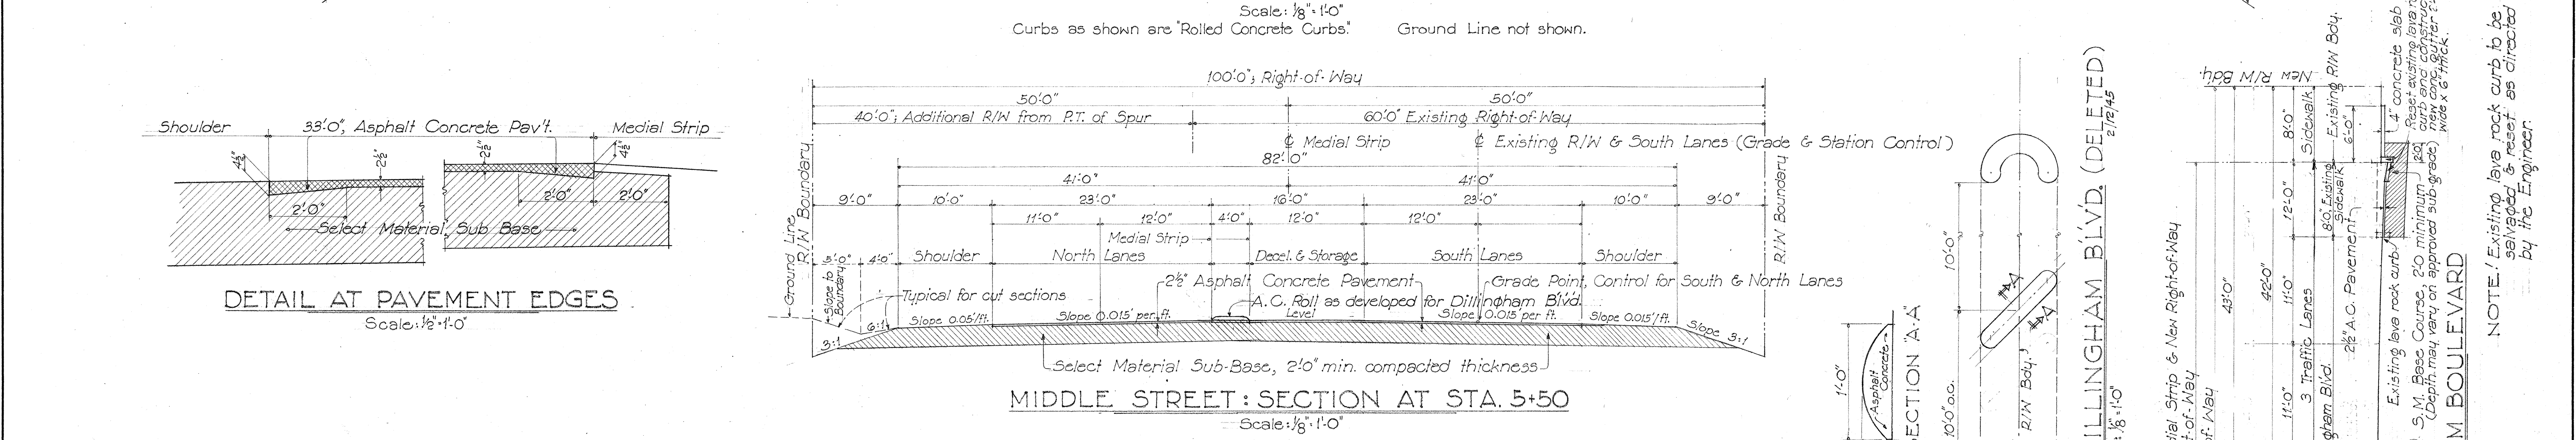


REG. ROAD DIST. NO.	STATE	FED. AID PROJ. NO.	FISCAL YEAR	SHEET NO.	TOTAL SHEETS
HAWAII	HAW.	SN-FAP 9-D(4)	1944	2	33

REG. ROAD DIST. NO.	STATE	FED. AID PROJ. NO.	FISCAL YEAR	SHEET NO.	TOTAL SHEETS
HAWAII	HAW.	SN-FAP 9-D(4)	1944	2	33

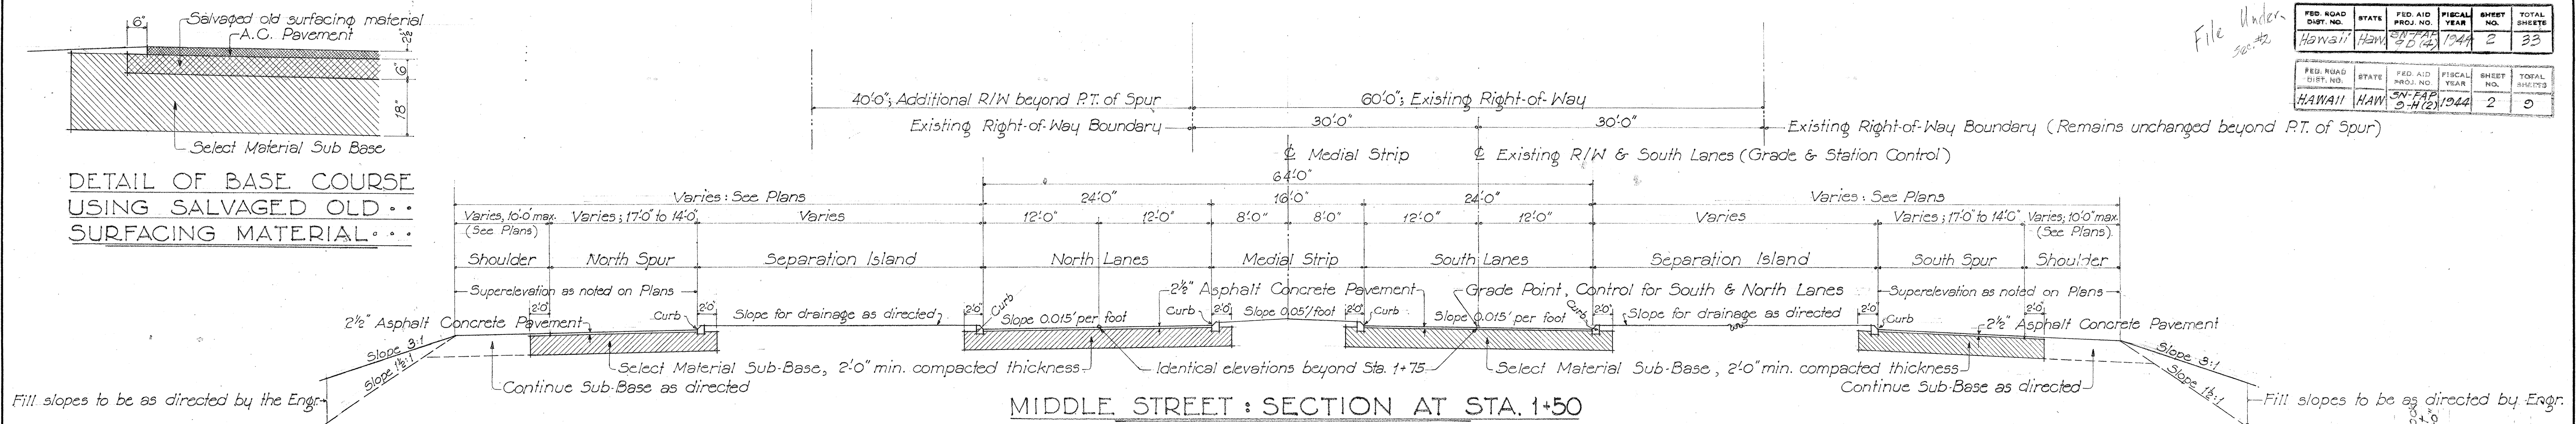

NOTE "A": Varies from 43.48' at Sta. 159+50 to 44.75' at Sta. 178+17.57.
44.75' at Sta. 178+17.57 constant to Sta. 186+86.74.

NOTE "B": Varies from 37.98' at Sta. 159+50 to 39.25' at Sta. 178+17.57.
39.25' at Sta. 178+17.57 constant to Sta. 186+86.74.

NOTE "C": Varies from 30.98 at Sta. 159+50 to 28.75 at Sta. 178+17.57.
28.75 at Sta. 178+17.57 constant to Sta. 186+86.74.

NOTE "D": 23.0' constant from Kalihi Stream Bridge to Sta. 204+38.74;
23.0' from Sta. 204+38.74 around curve to 2.0' at Sta. 209+26.47.

TERRITORIAL HIGHWAY DEPARTMENT
TERRITORY OF HAWAII

TYPICAL SECTIONS
• SECOND UNIT OF •
PROJ. NO. SN-FAP 9-D(4)
Kamehameha Highway ... From
Puuloa Road to Oahu Prison.

5159.2 5142.2