


INDEX TO DRAWINGS	
SHEET NO.	DESCRIPTION
1	Title Sheet
2	Typical Sections
3-5	Plan & Profile
6-8 & 8A	Standard Details
9	R.R. Crossing Details
11	Culvert Details
10	Deleted

Centerline	55
Boundary Lines	or
Fences (Noted)	or
Existing Roadway	
Circular Concrete Culvert	
Railroad	
Telephone Pole	5"
Electric Power Line Pole	5"
Sewer Manhole	5"
Telephone Manhole	5"
Fire Hydrant	5"

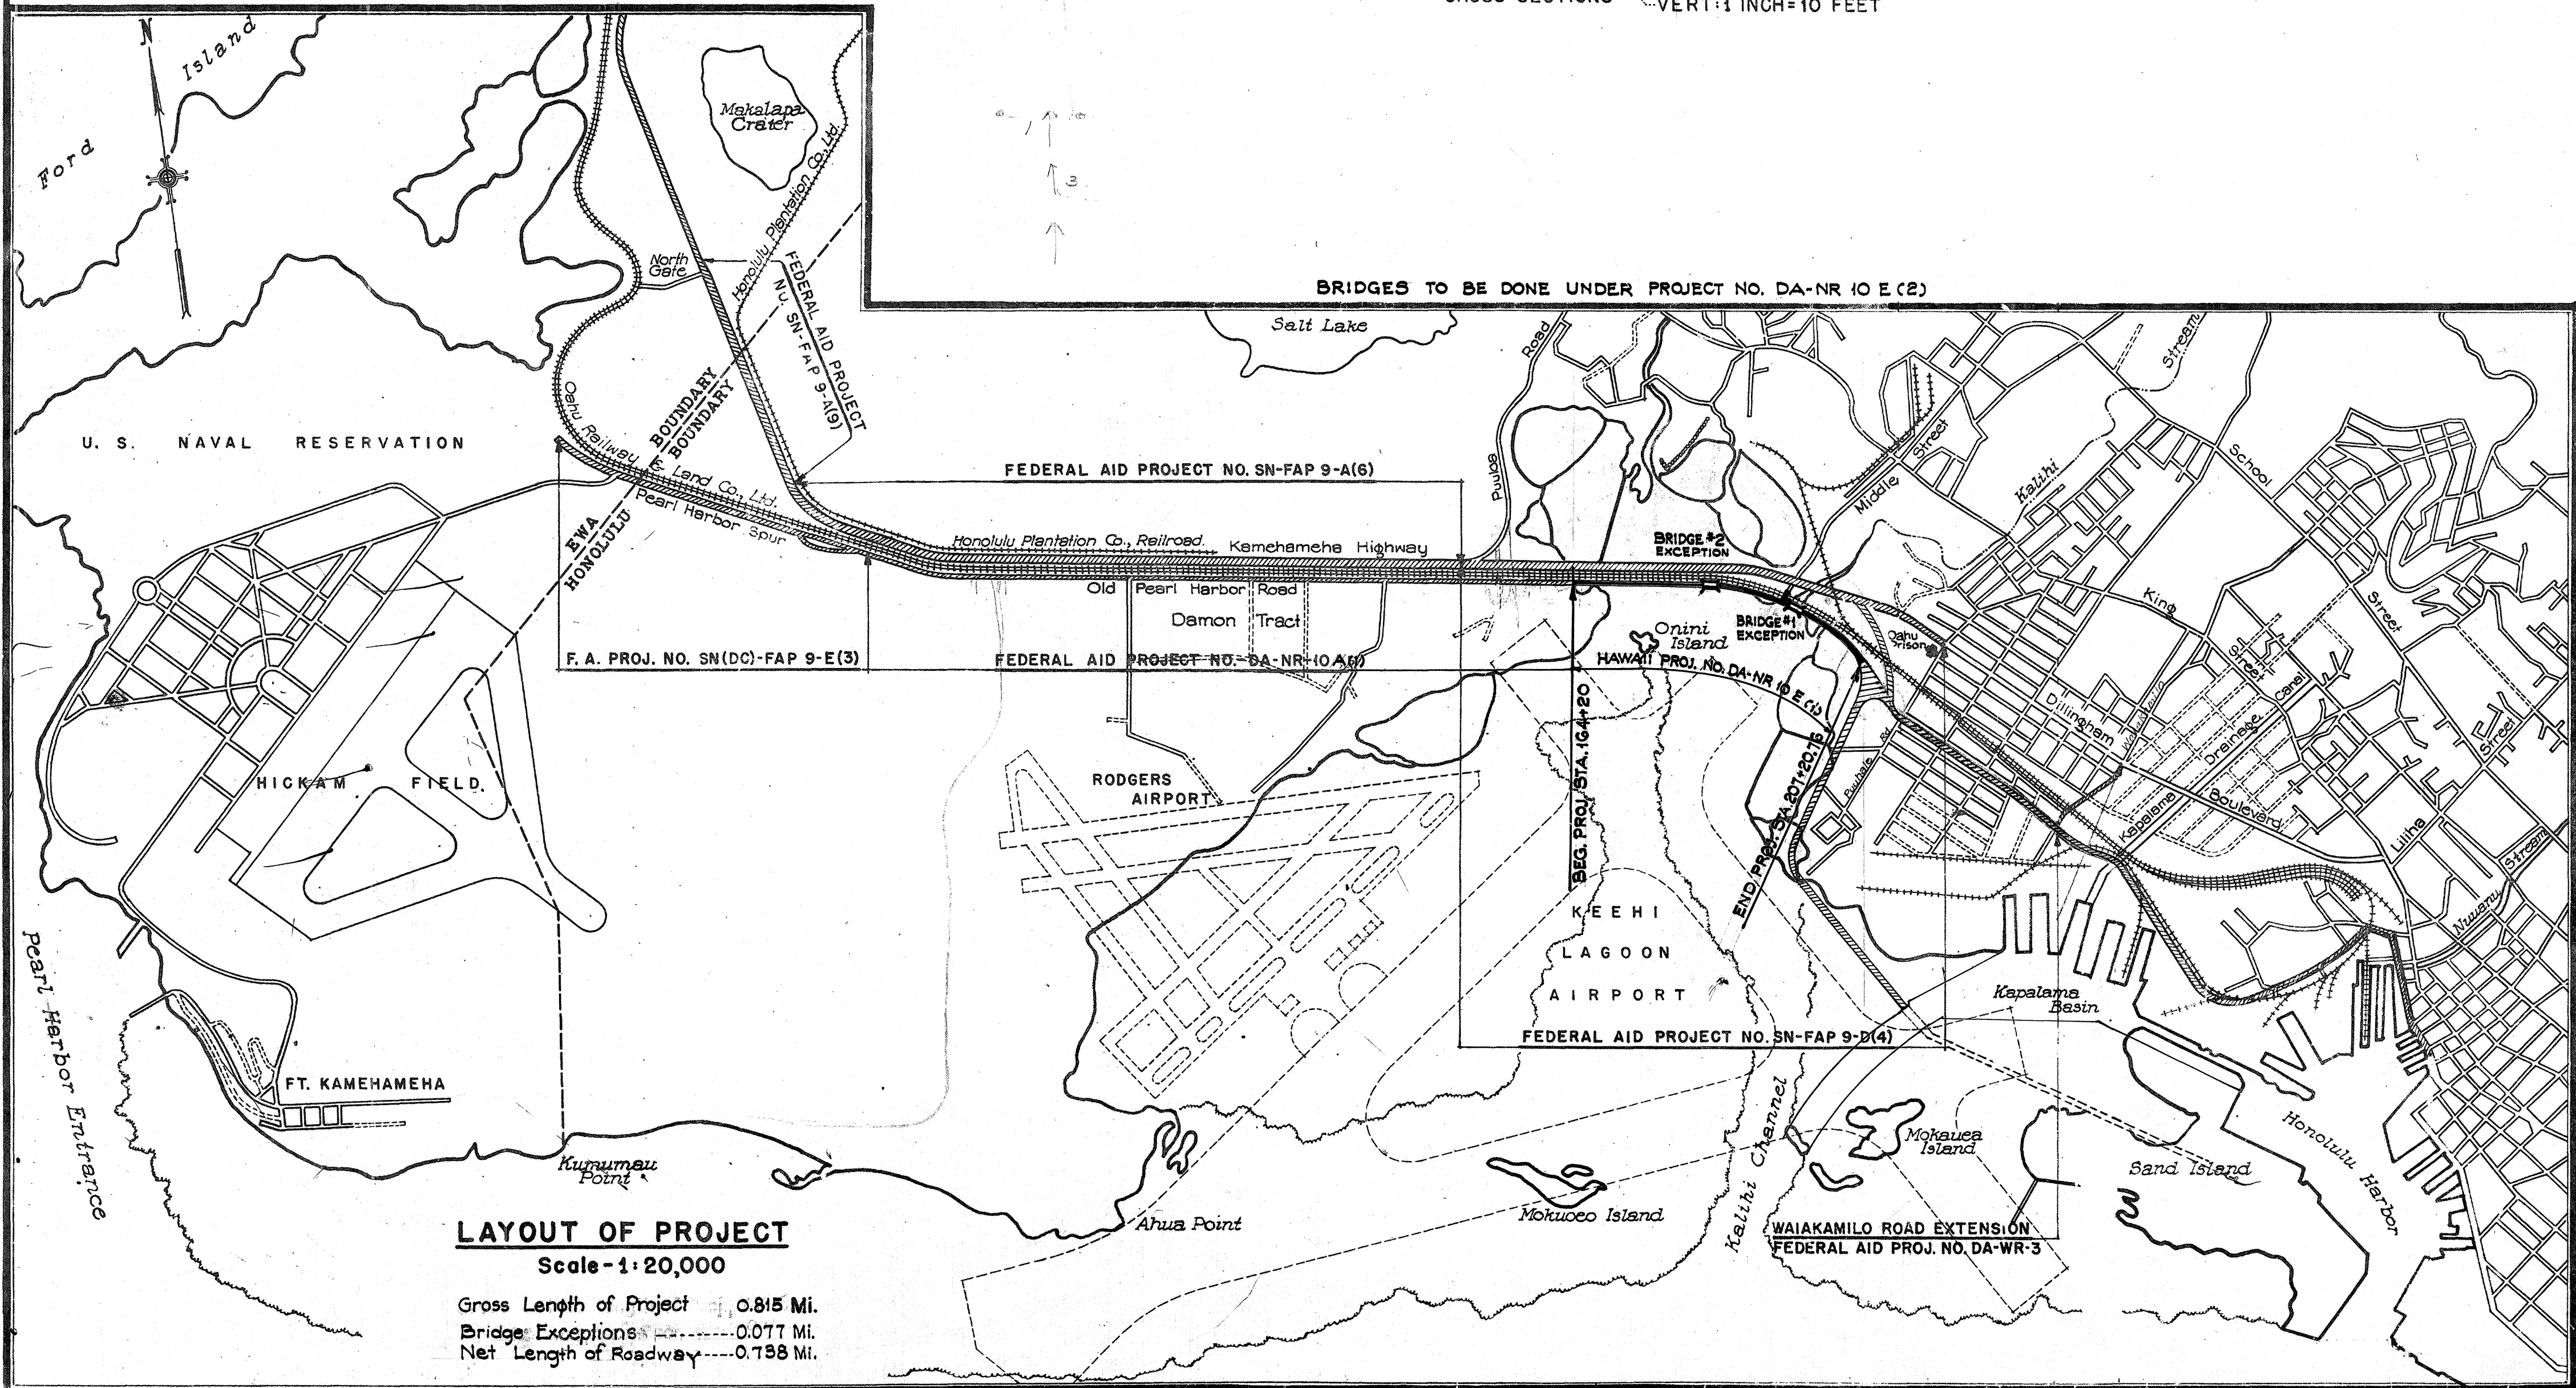


TERRITORY OF HAWAII TERRITORIAL HIGHWAY DEPARTMENT HONOLULU - T. H. PLANS OFJOHN RODGERS - KEEHI LAGOON ACCESS RD.AHUA POND TO SAND ISLAND RD.

HAWAII PROJECT NO. DA-NR 10E(1)

HONOLULU DISTRICT
ISLAND OF OAHU

SCALES

PLAN	1 INCH = 50 FEET
PROFILE	HORIZ: 1 INCH = 50 FEET
	VERT: 1 INCH = 5 FEET
CROSS SECTIONS	HORIZ: 1 INCH = 10 FEET
	VERT: 1 INCH = 10 FEET

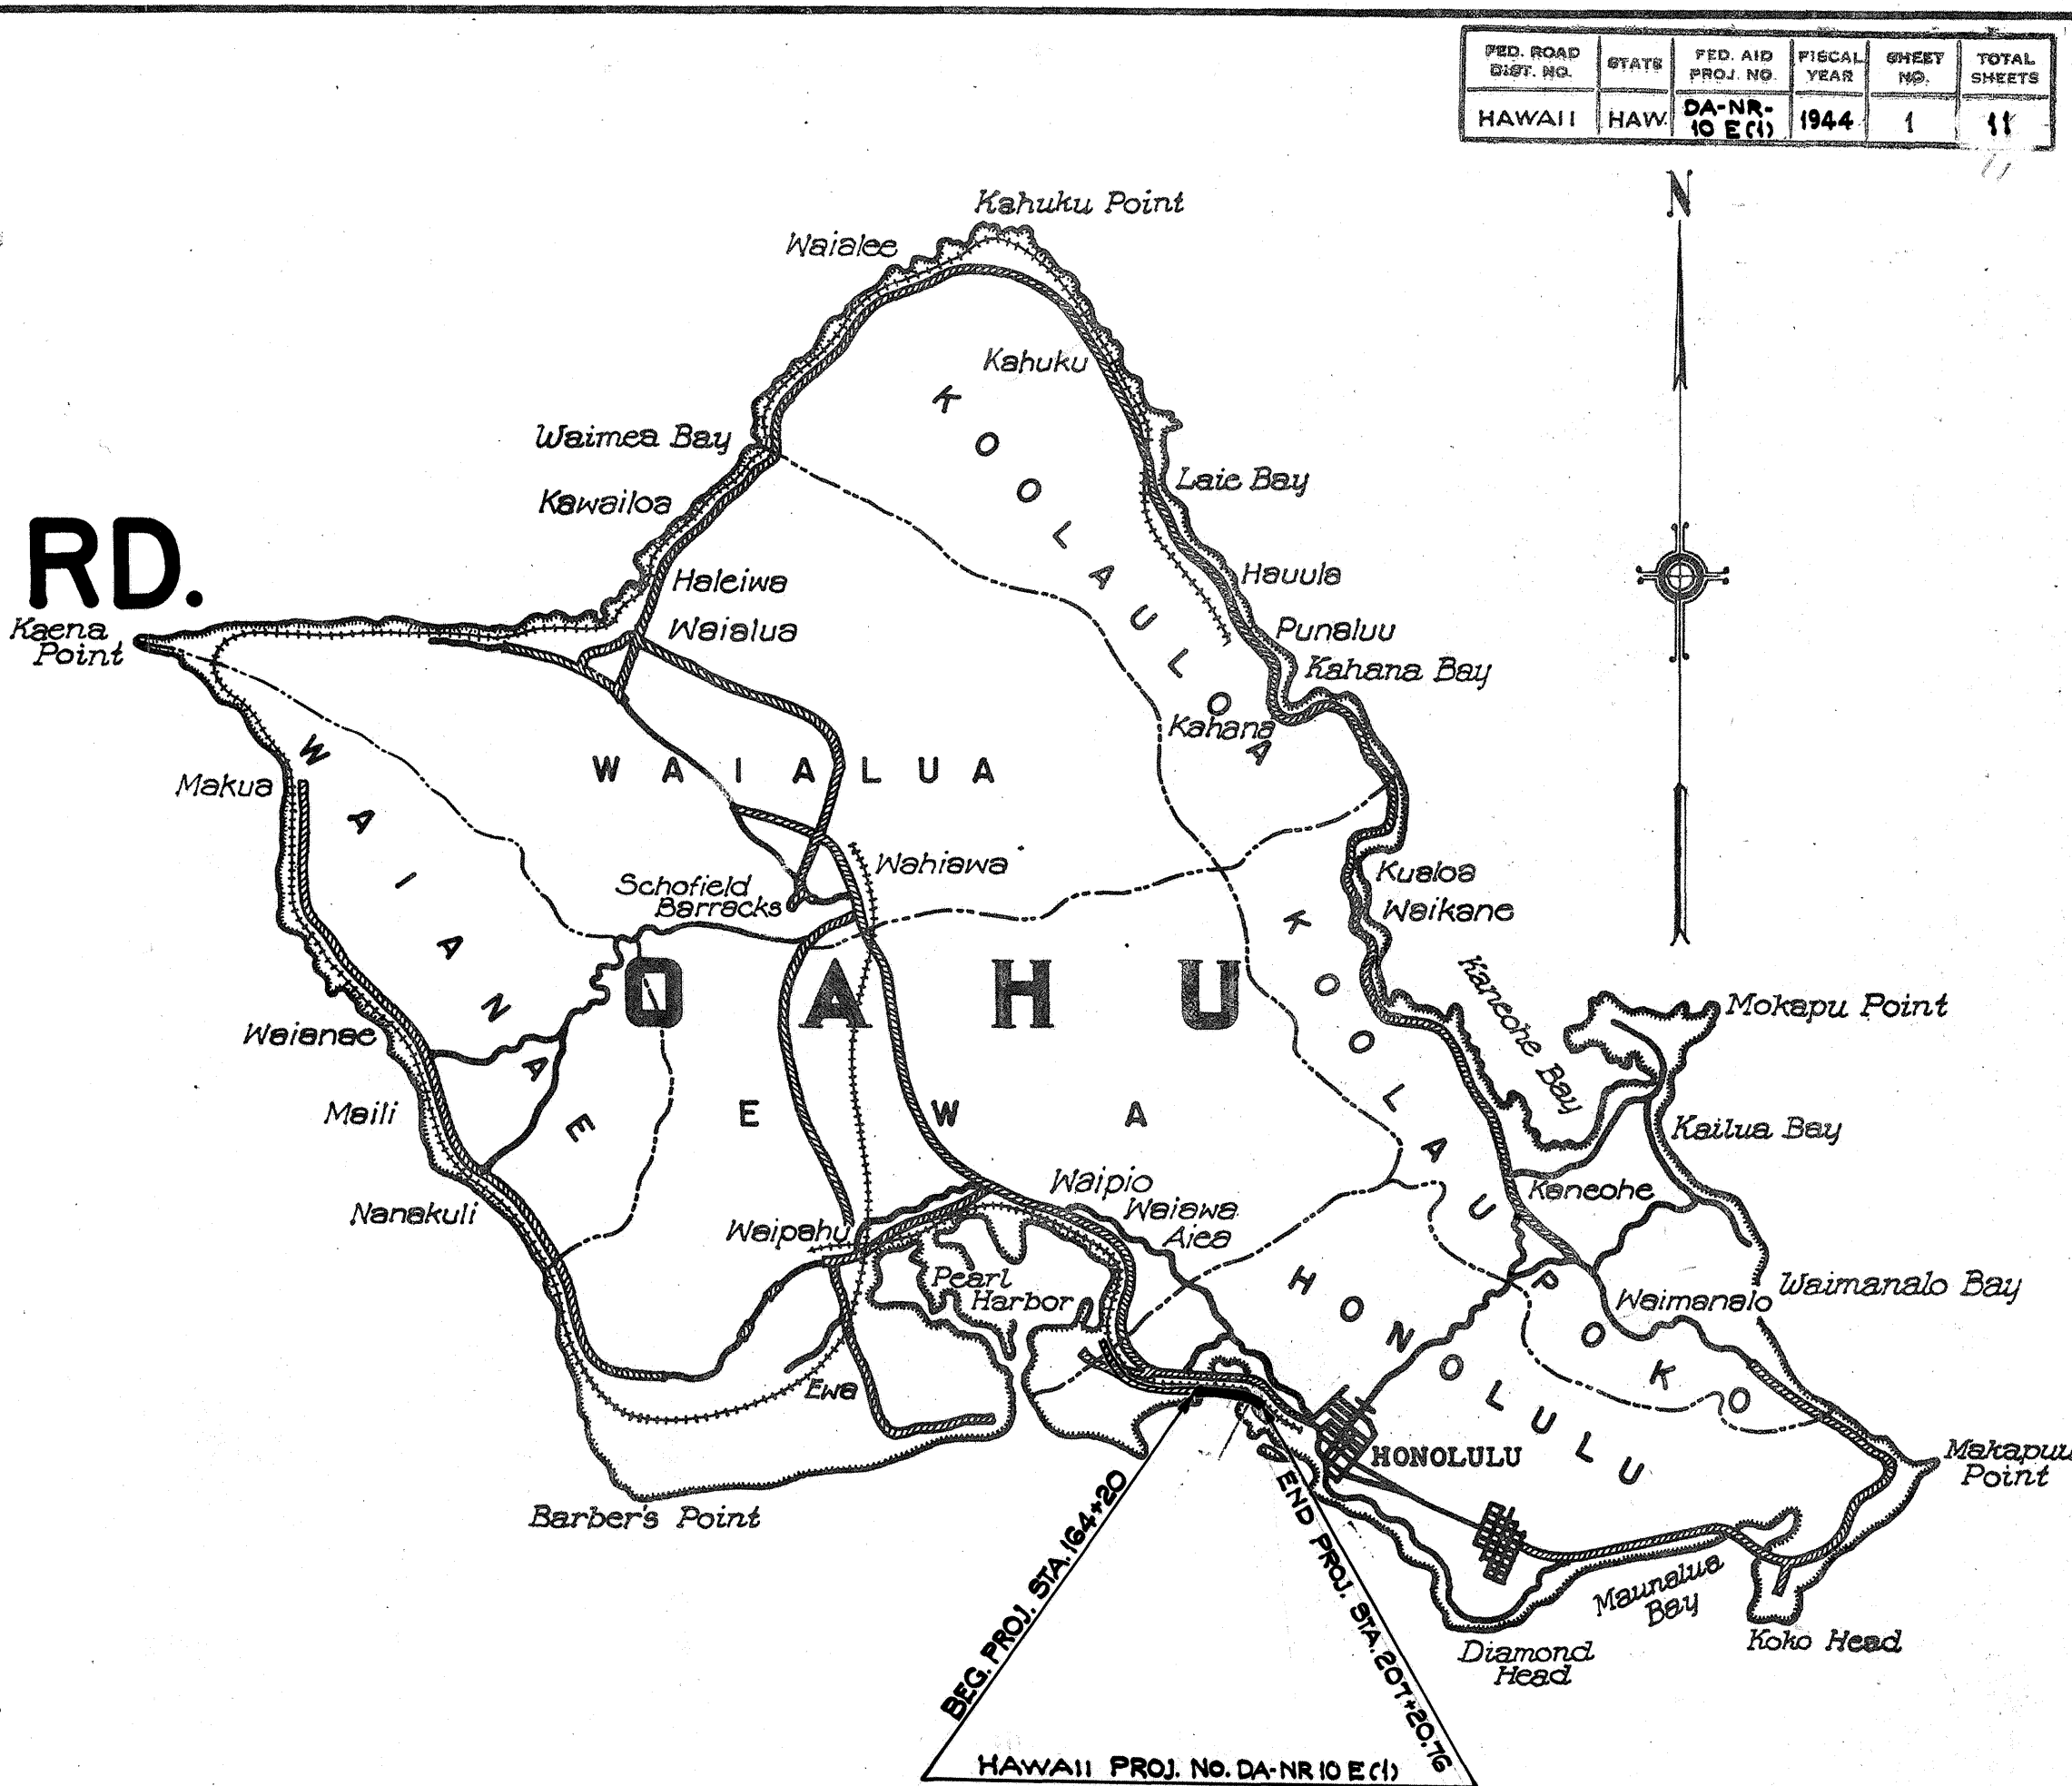

Federal Aid Projects Previously Constructed Or Under Construction

NOTE: All changes made during construction have been shown in red on these tracings, and have been checked by

Resident Engineer
Date:

RECOMMENDED FOR APPROVAL

• PRINCIPAL HIGHWAY ENGINEER •
Public Roads Administration,
Federal Works Agency

RECOMMENDED FOR APPROVAL

• CHIEF, WESTERN REGION •
Public Roads Administration,
Federal Works Agency

APPROVED

• COMMISSIONER •
Public Roads Administration,
Federal Works Agency

APPROVED
B. F. Rush
Territorial Highway Engineer
Date: Aug. 21, 1944