

INDEX TO DRAWINGS	
SHEET NO.	DESCRIPTION
1	Title Sheet
2	Layout Plan
3	Traffic Signal Details
4	Wiring Diagram


ALL CHANGES MADE DURING CONSTRUCTION
HAVE BEEN SHOWN IN RED ON THESE
TRACINGS AND CHECKED BY:

PROJECT ENGINEER
DATE: _____


TERRITORY OF HAWAII
TERRITORIAL HIGHWAY DEPARTMENT
HONOLULU, OAHU, T. H.

PLANS OF
INSTALLATION OF
TRAFFIC CONTROL SIGNALS
AT INTERSECTION OF
HONOLULU - PEARL HARBOR RD. AND MOKAUEA ST.
FEDERAL AID PROJECT NO. F 44 (7)
DISTRICT OF HONOLULU
ISLAND OF OAHU

CONVENTIONAL SIGNS	
Centerline.....	125
Boundary Lines.....	or
Fences (Named).....	
Existing Roadways.....	
Circular Culvert.....	
Box Culvert.....	
Bridge.....	
Telephone Pole.....	
Electric Power Pole.....	
Water Main.....	W ₆ W ₈ (W ₄ , 8, 12, Etc.)
Storm Drain.....	SD ₁₂ SD ₁₈ (SD ₁₂ , 24, Etc.)
Concrete Drop Intake.....	C.D.I.
Standard Catch Basin.....	S.C.B.
Standard Manhole.....	M.H.S.
Sewer Manhole.....	S.M.H.
Telephone Manhole.....	T.M.H.
Fire Hydrant.....	F.H.
Tree (Large, named).....	Mango Coco
Railroad.....	

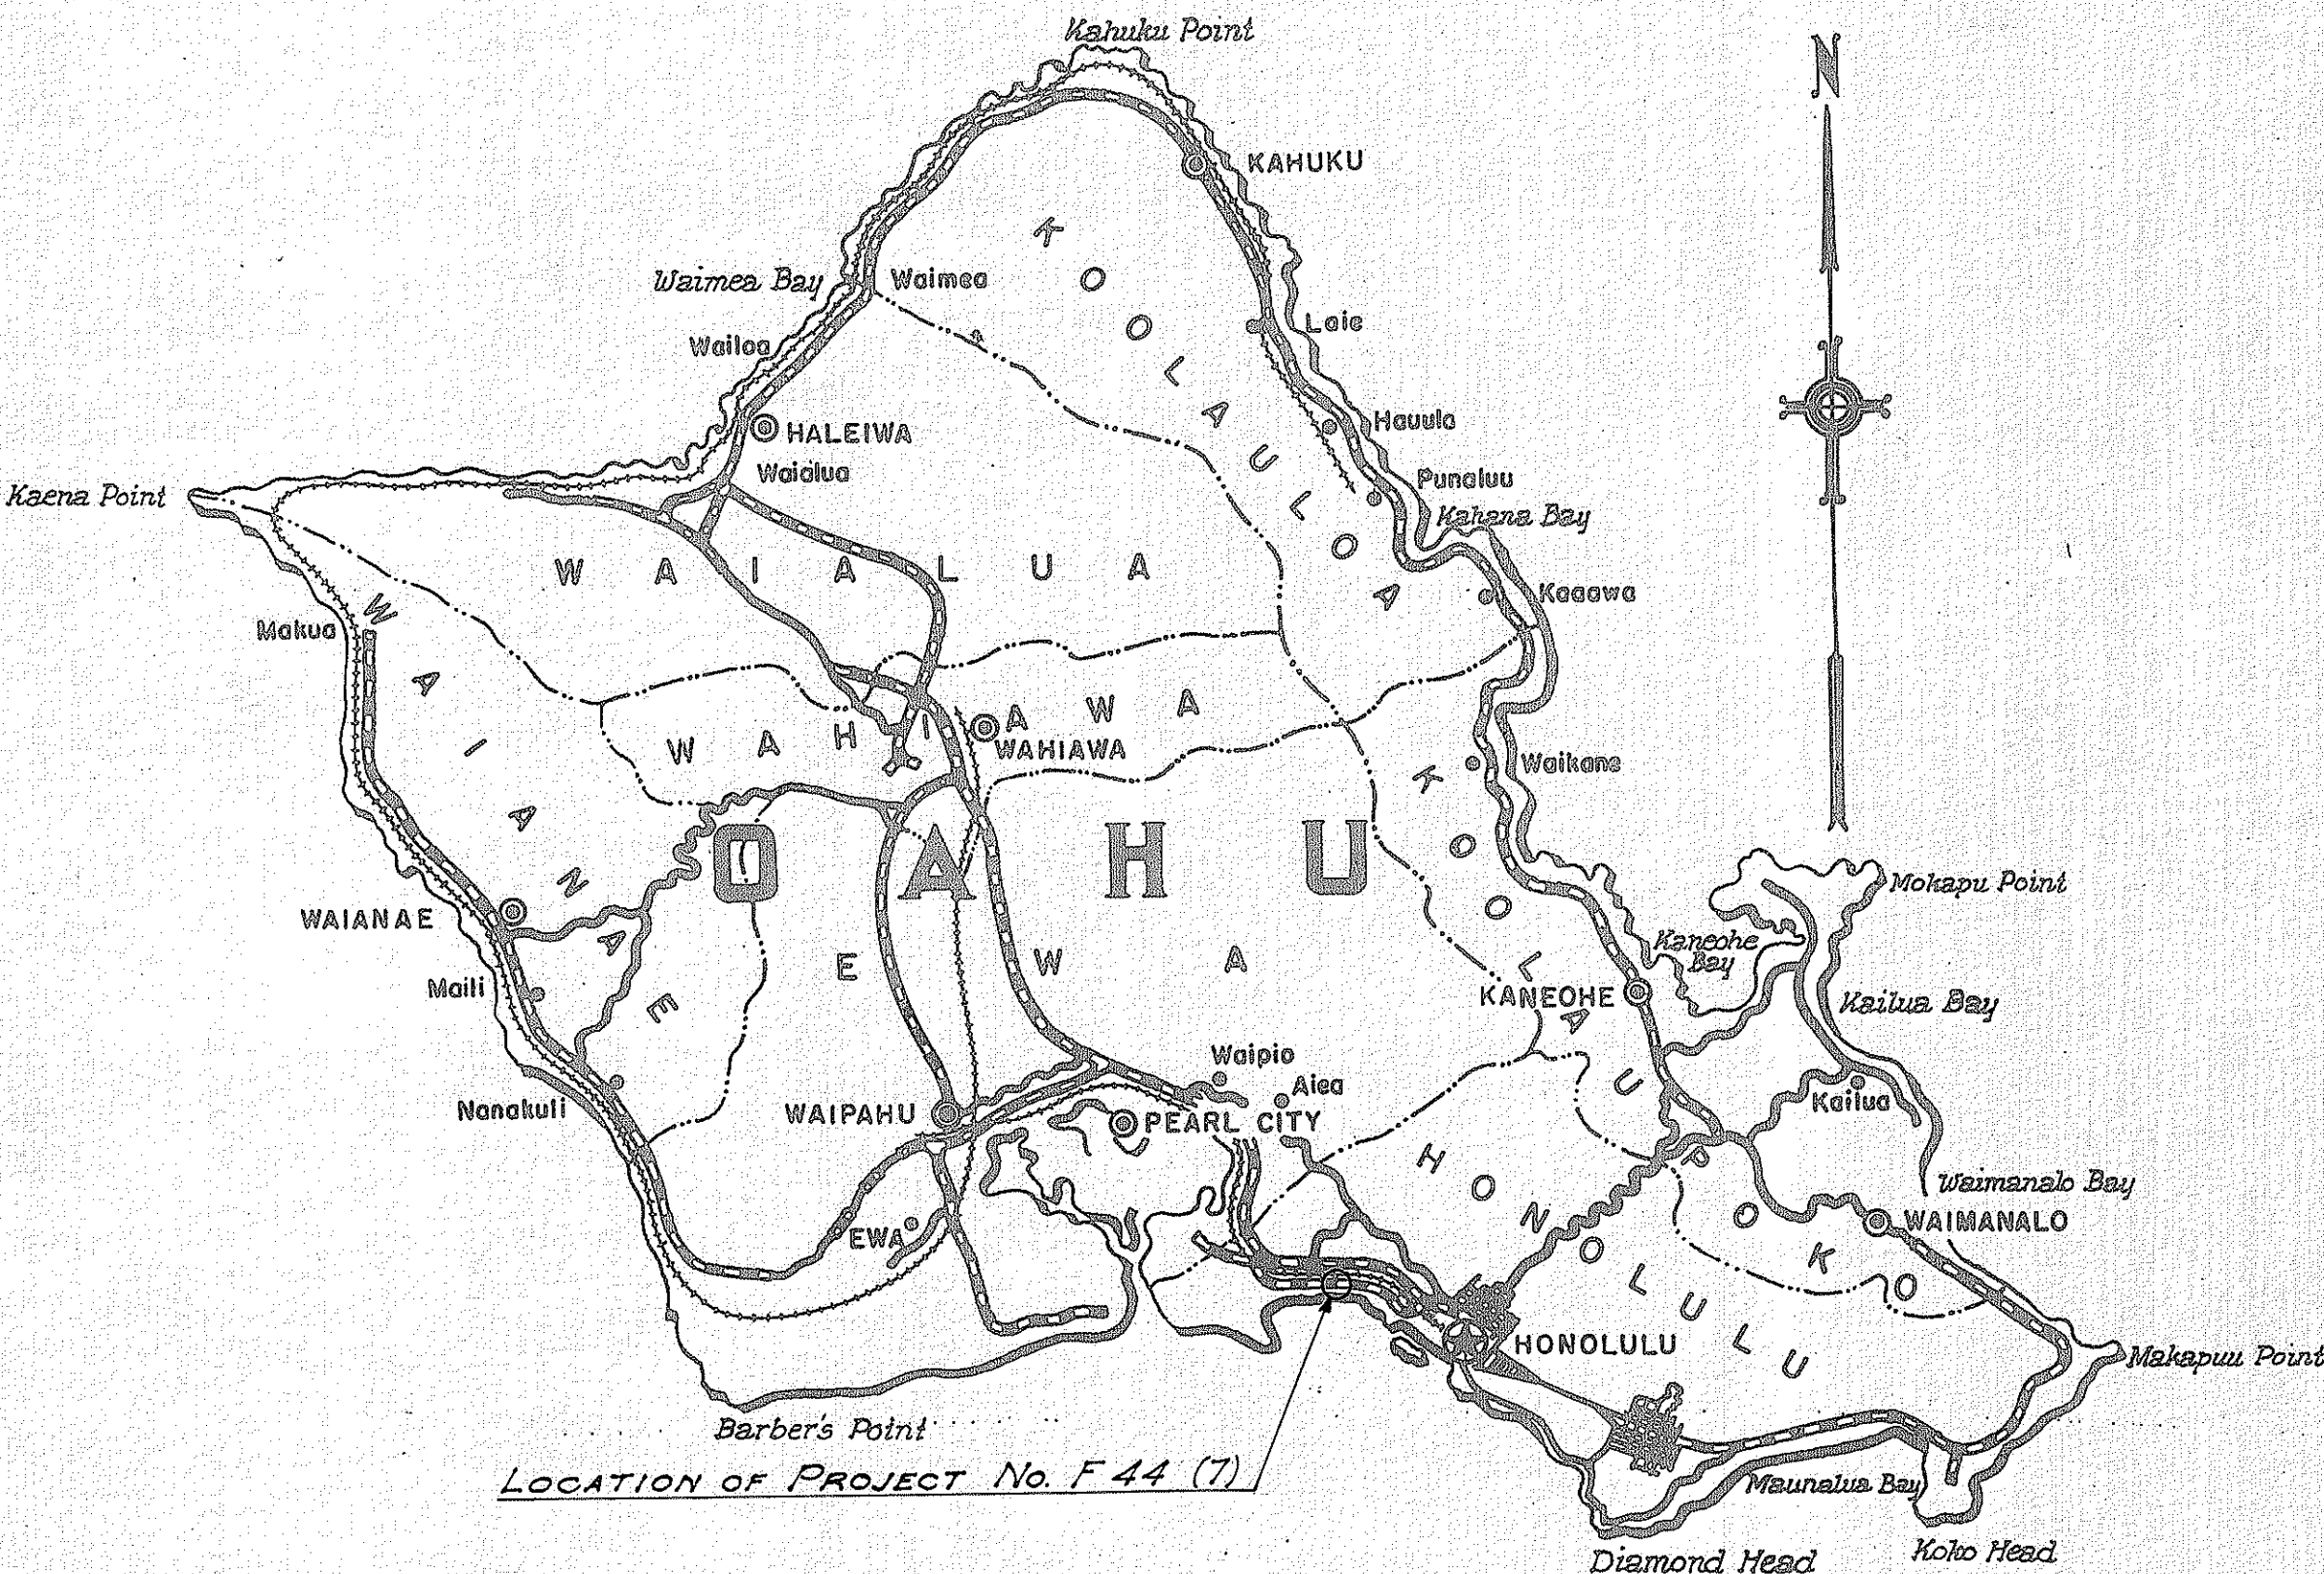

Federal Aid Projects Previously Constructed Or Under Construction

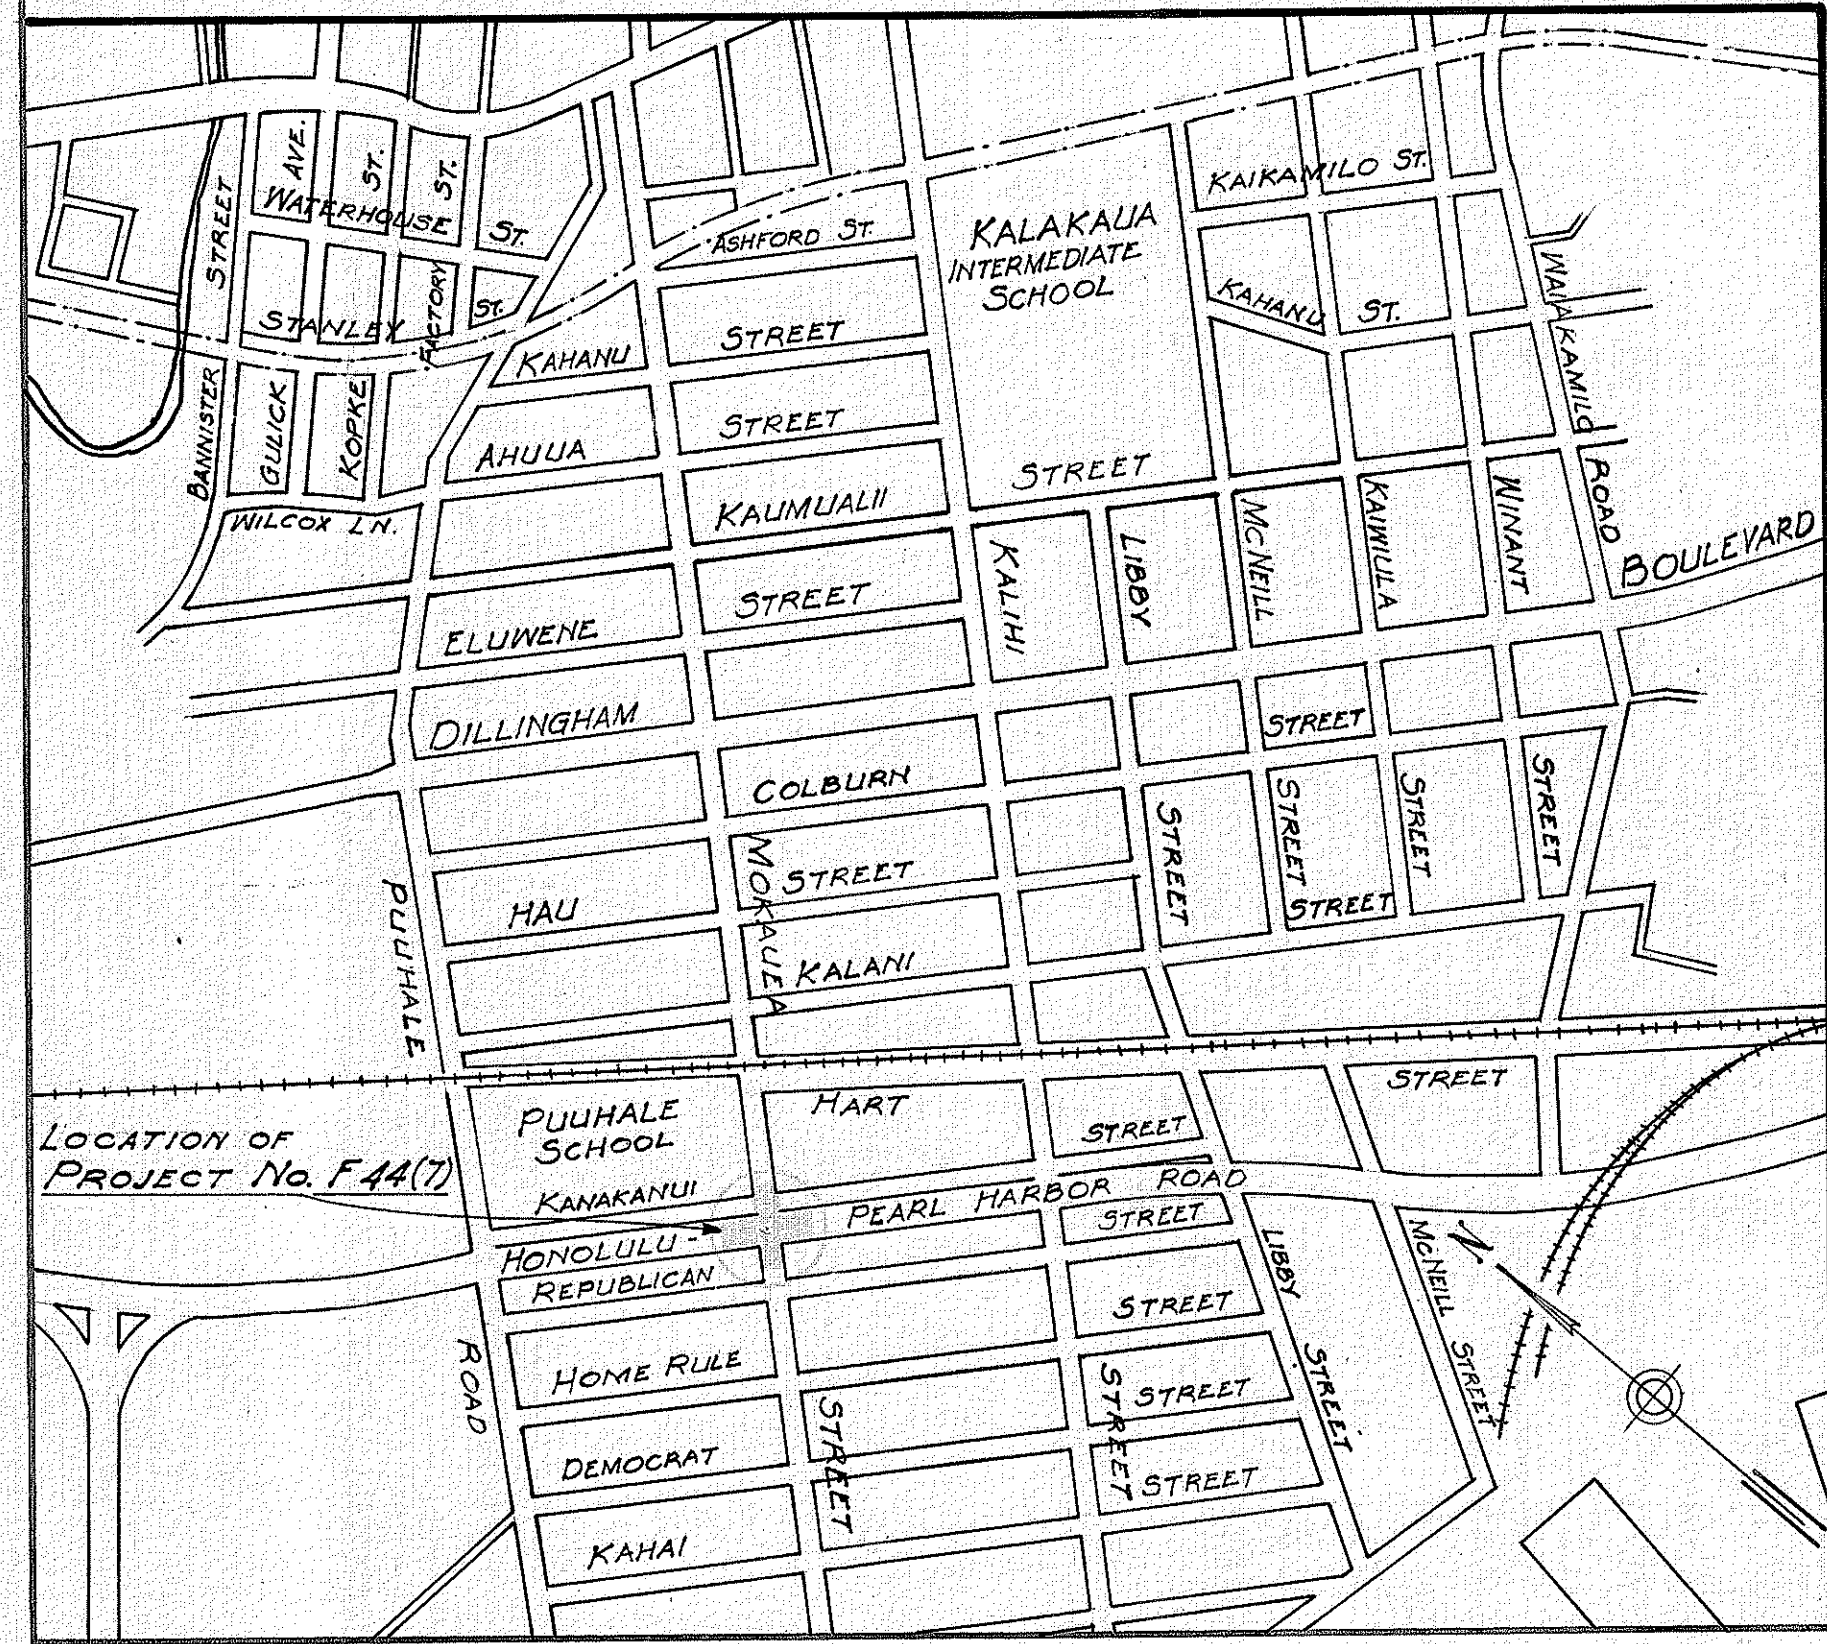

DESIGNED BY	DATE
DRAWN BY	
CHECKED BY	
QUANTITIES CHECKED BY	
ORIGINAL PLAN	
NOTE BOOK	
No.	

RECOMMENDED FOR APPROVAL DATE.....	
DISTRICT ENGINEER PUBLIC ROADS ADMINISTRATION FEDERAL WORKS AGENCY	
APPROVED DATE.....	
DIVISION ENGINEER PUBLIC ROADS ADMINISTRATION FEDERAL WORKS AGENCY	

APPROVED	DATE 8-28-48
TERRITORIAL HIGHWAY ENGINEER	