


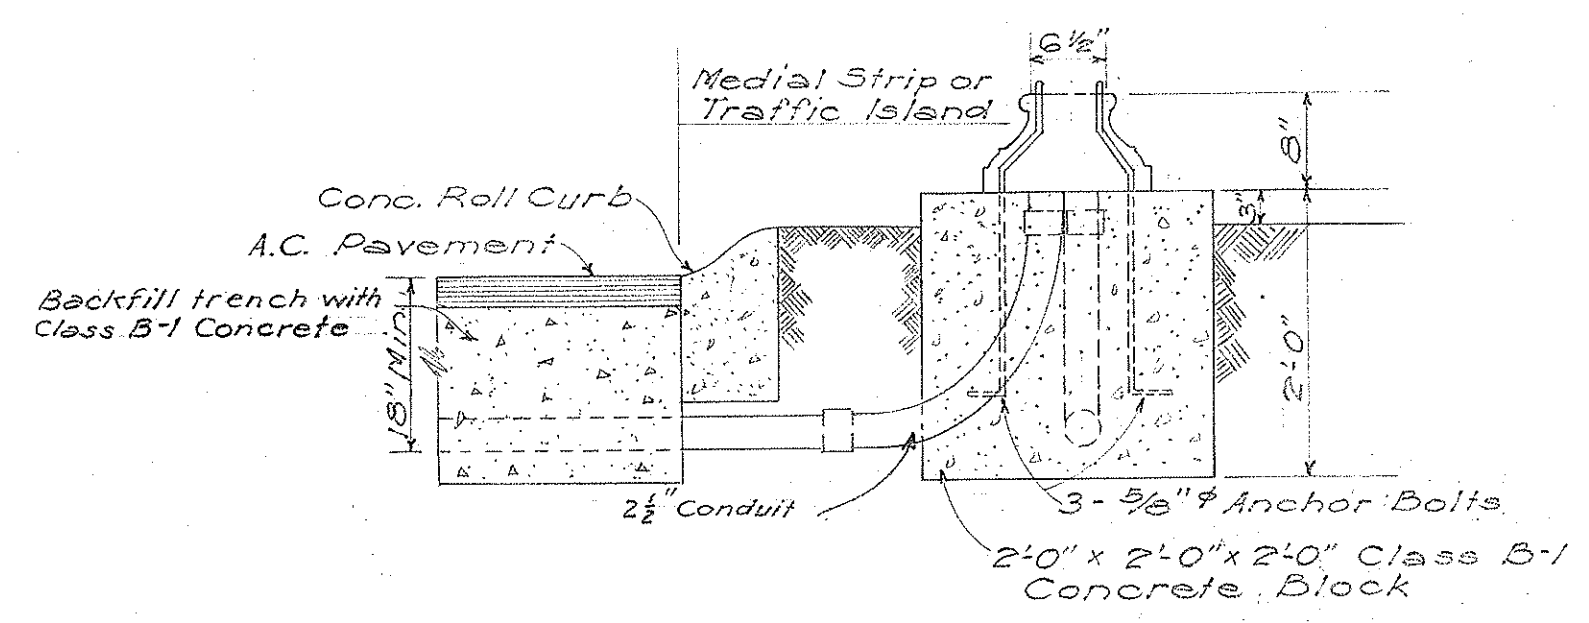
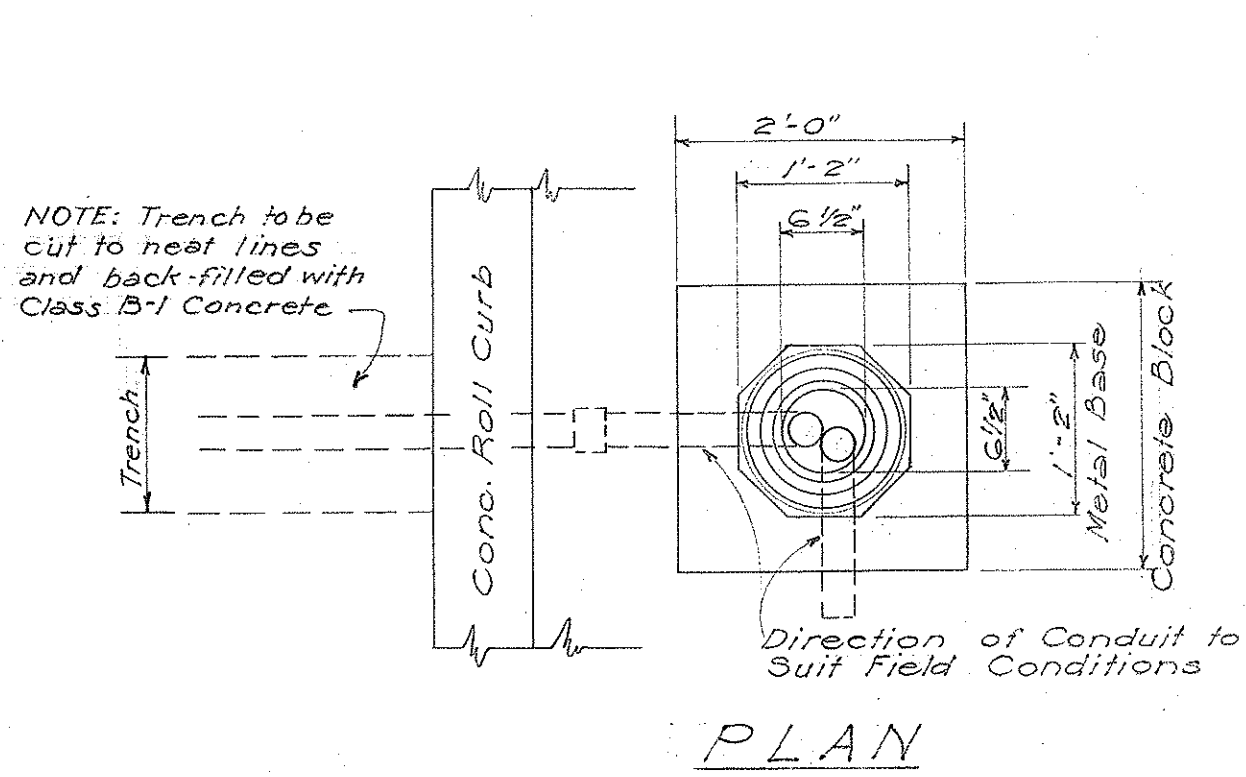
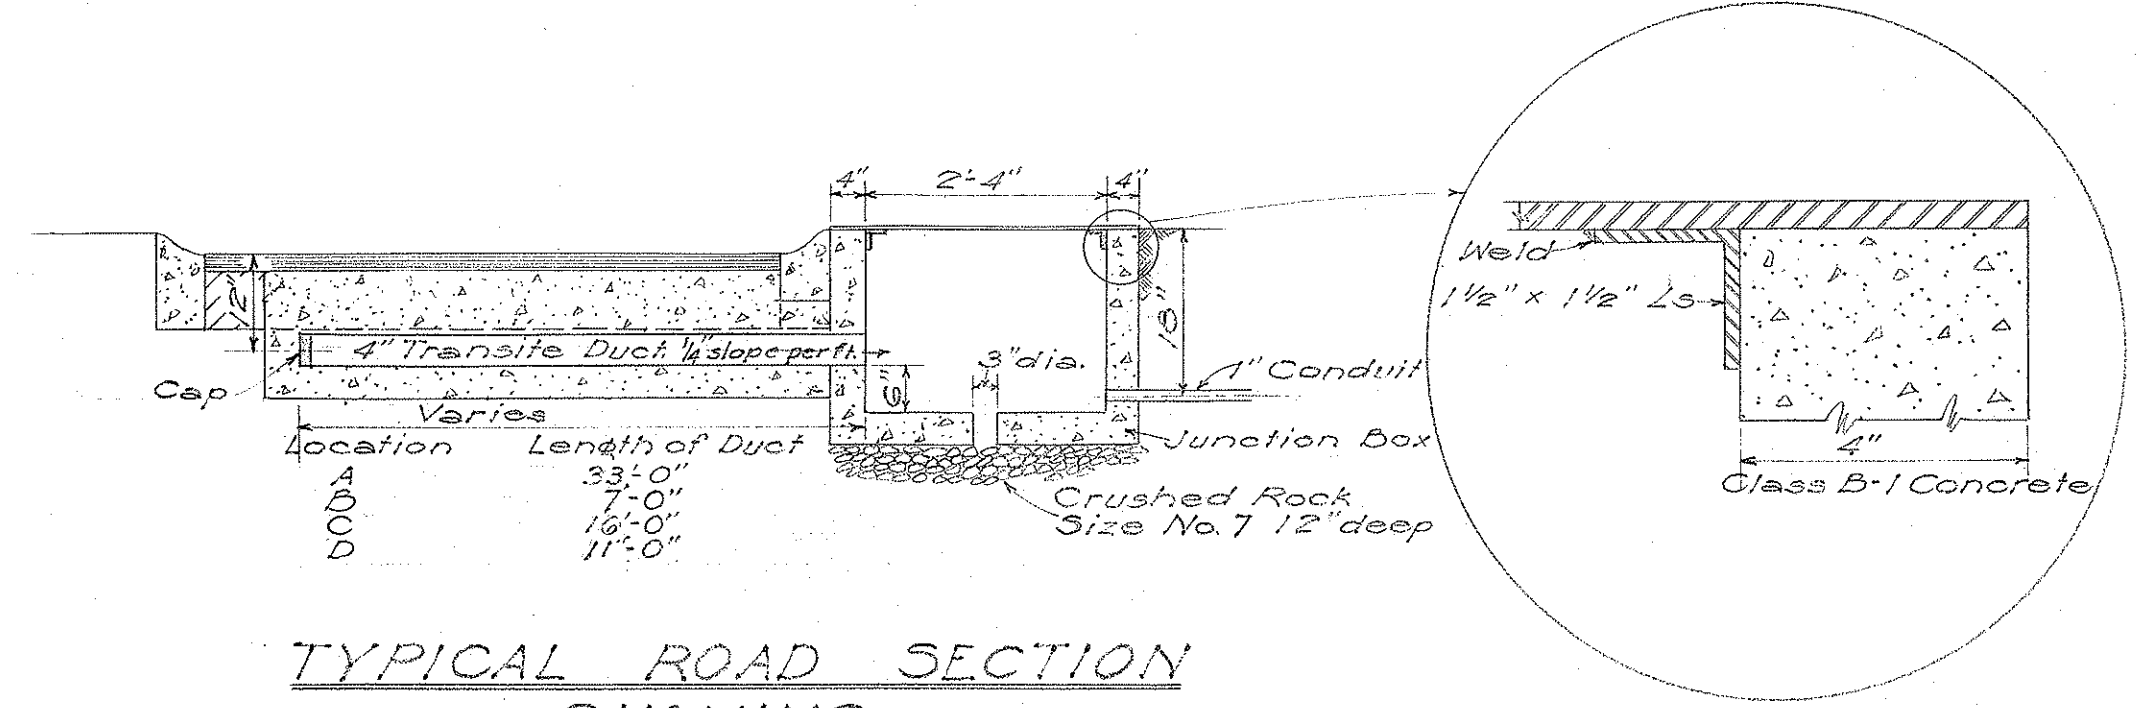
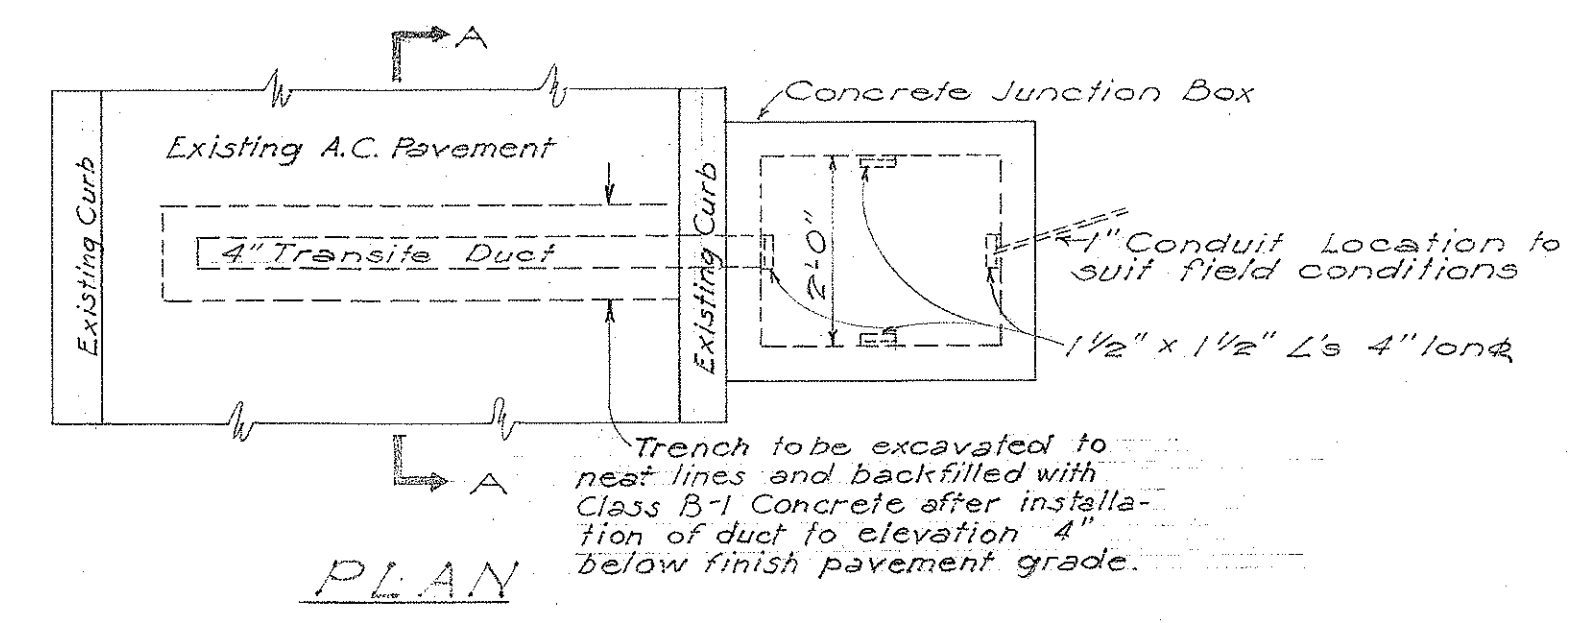


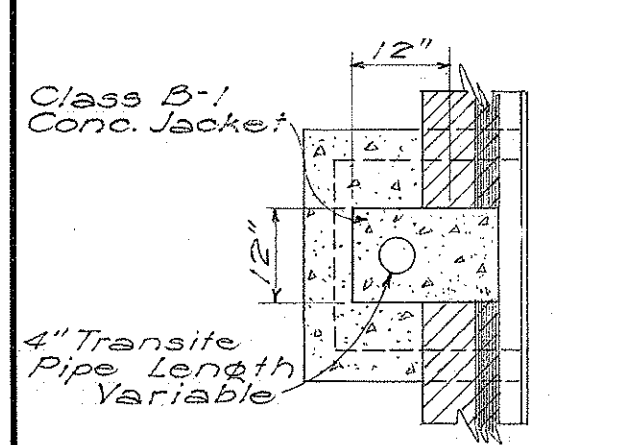



DETAIL OF BASE FOR TRAFFIC STANDARDS AND DISPATCHER PEDESTALS

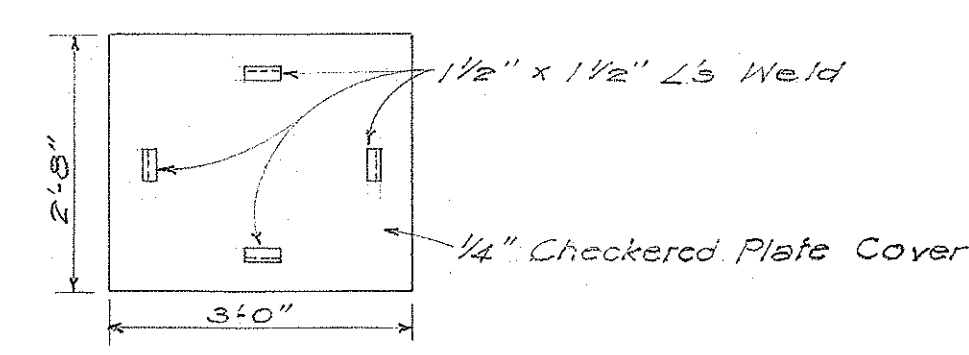



NOTE: Unless otherwise specified, all concrete for base for Traffic Standards, Pull Boxes, Concrete Jackets for Transite Ducts shall be Class B-1 Concrete. Concrete Roll Curb when replaced shall be Class B-1 Concrete.

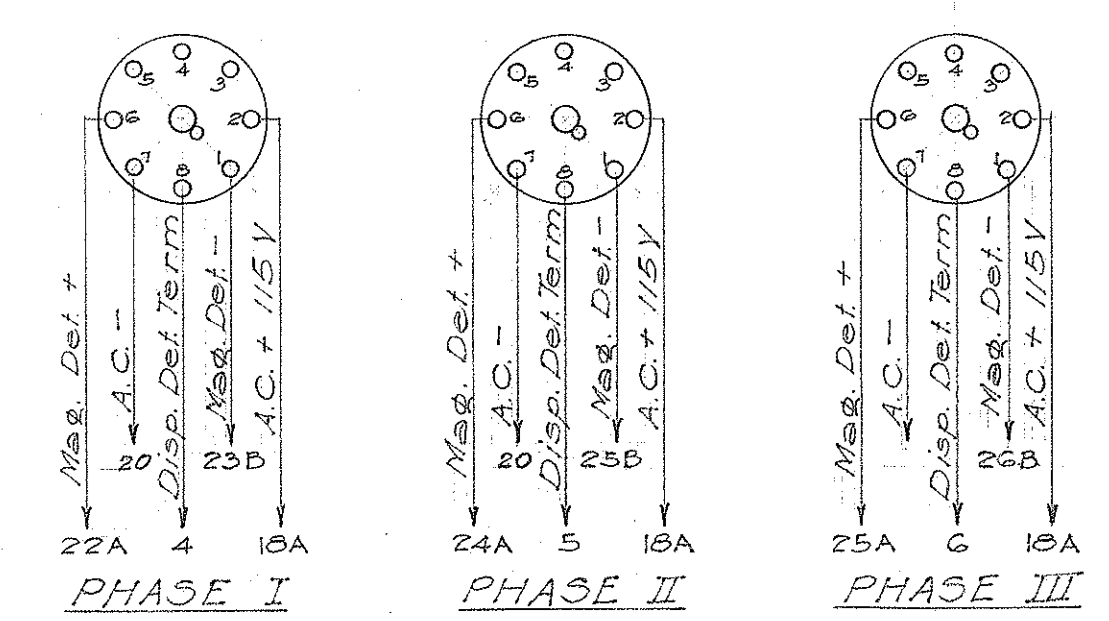

MAGNETIC DETECTOR RELAY UNITS CONNECTING CABLES A-1263B

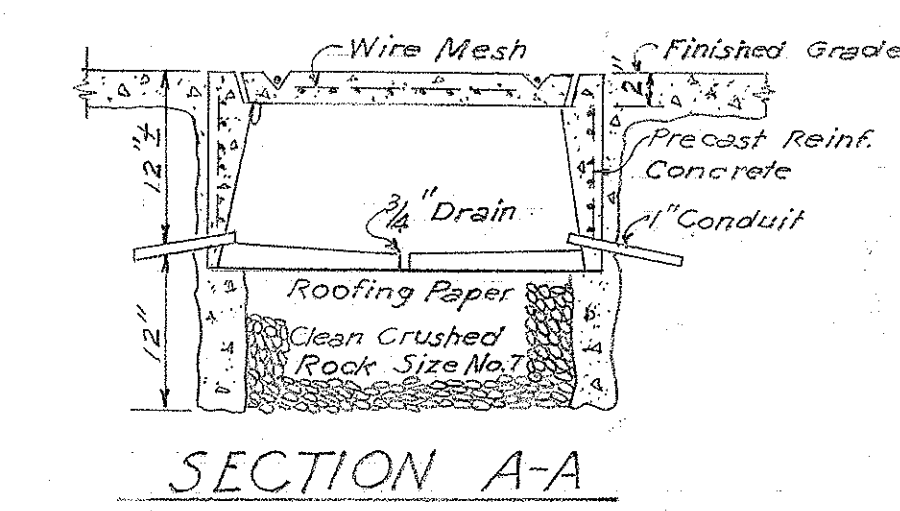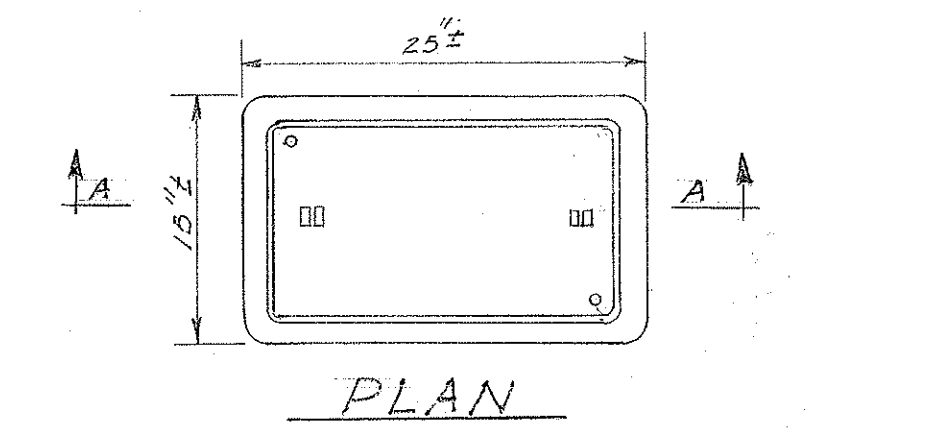

DETAIL OF PULL BOX Scale: 1"=1'-0"

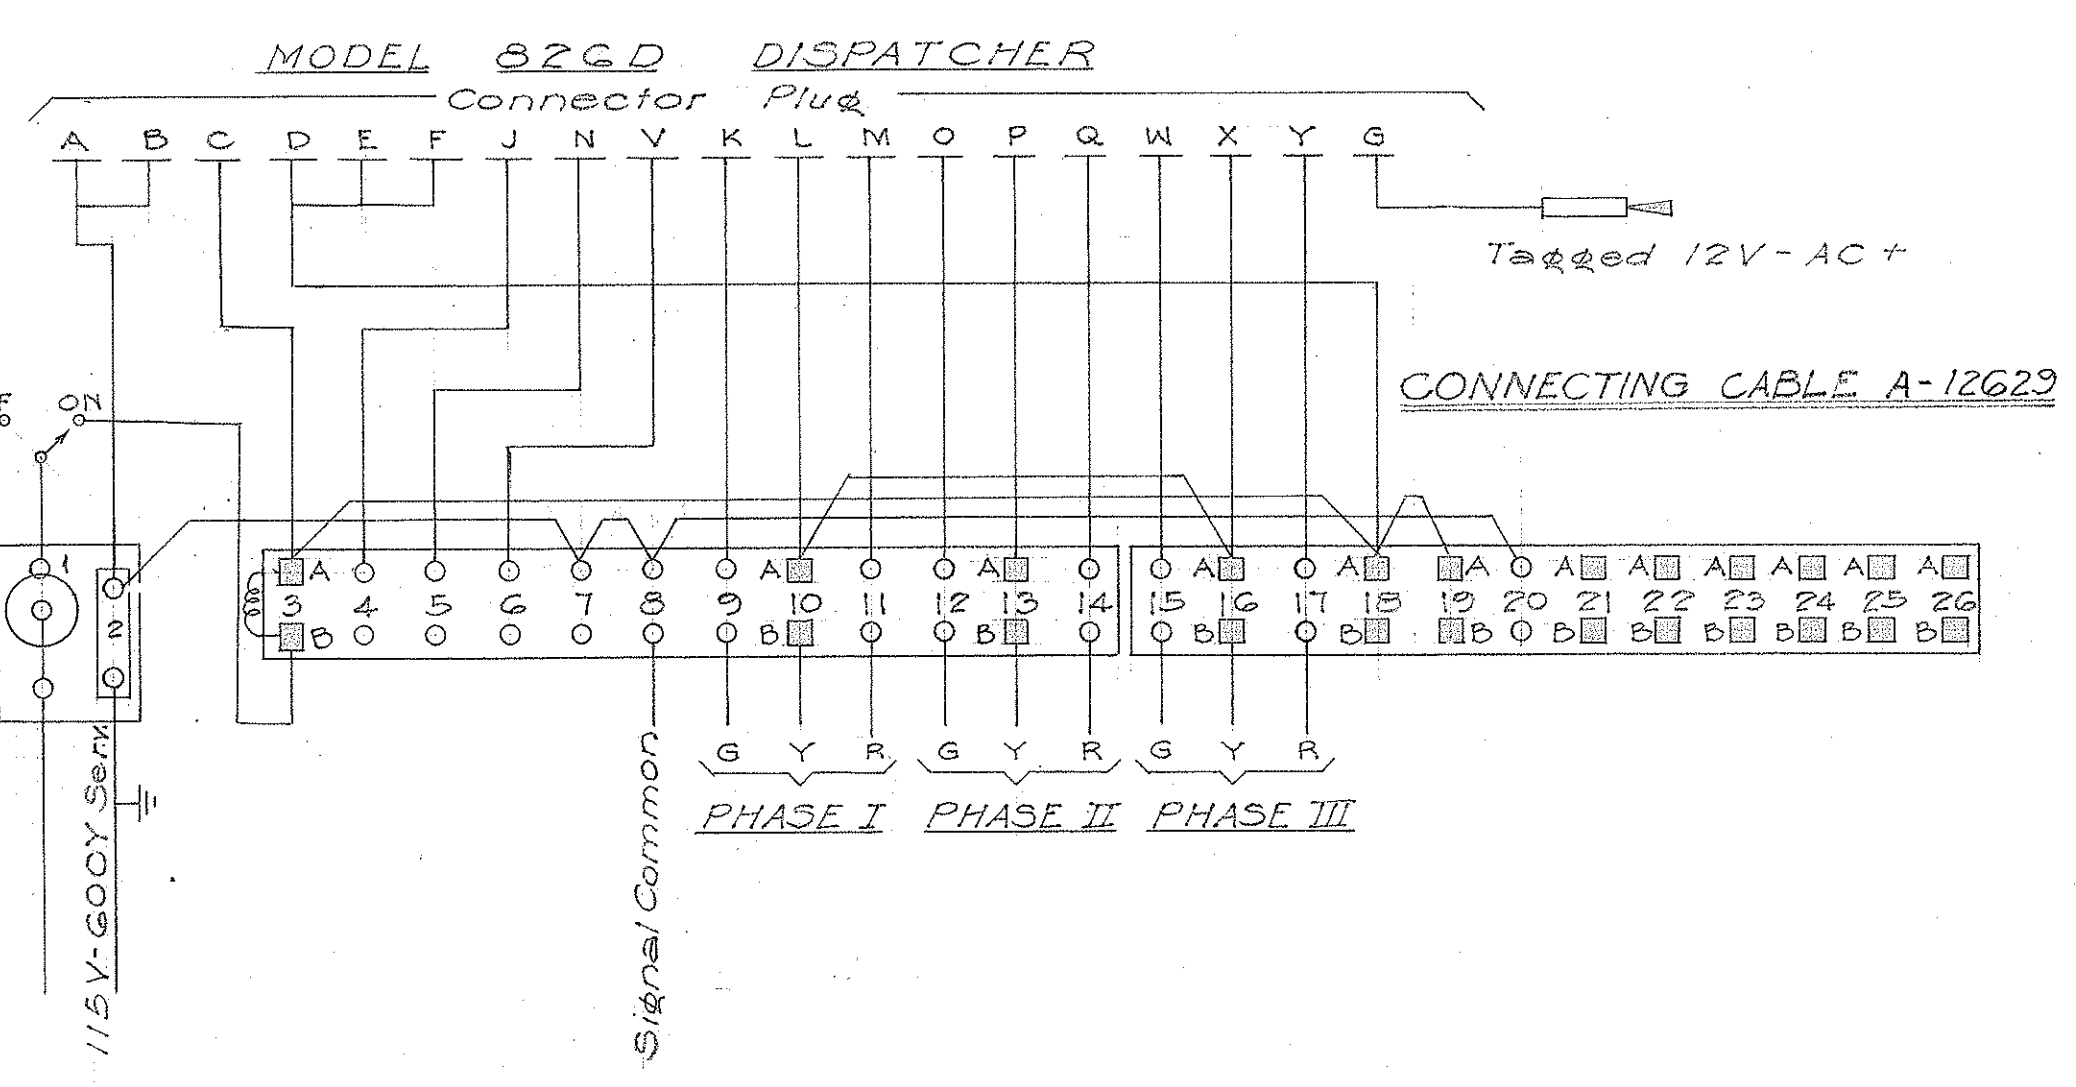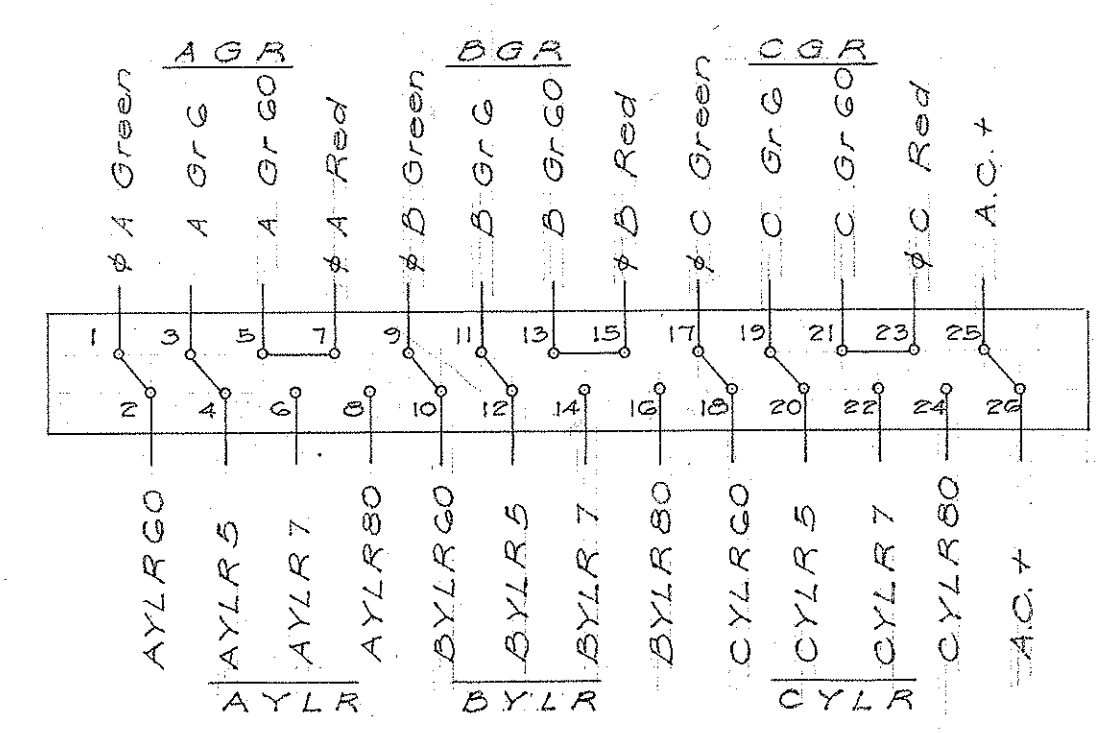

TERRITORIAL HIGHWAY DEPARTMENT
TERRITORY OF HAWAII
INSTALLATION OF
TRAFFIC CONTROL SIGNALS
AT INTERSECTION OF
HONOLULU-PEARL HARBOR RD.
AND MOKAUEA ST.
FEDERAL AID PROJECT No. F 44 (7)
Scale: As Noted. Aug. 1948