



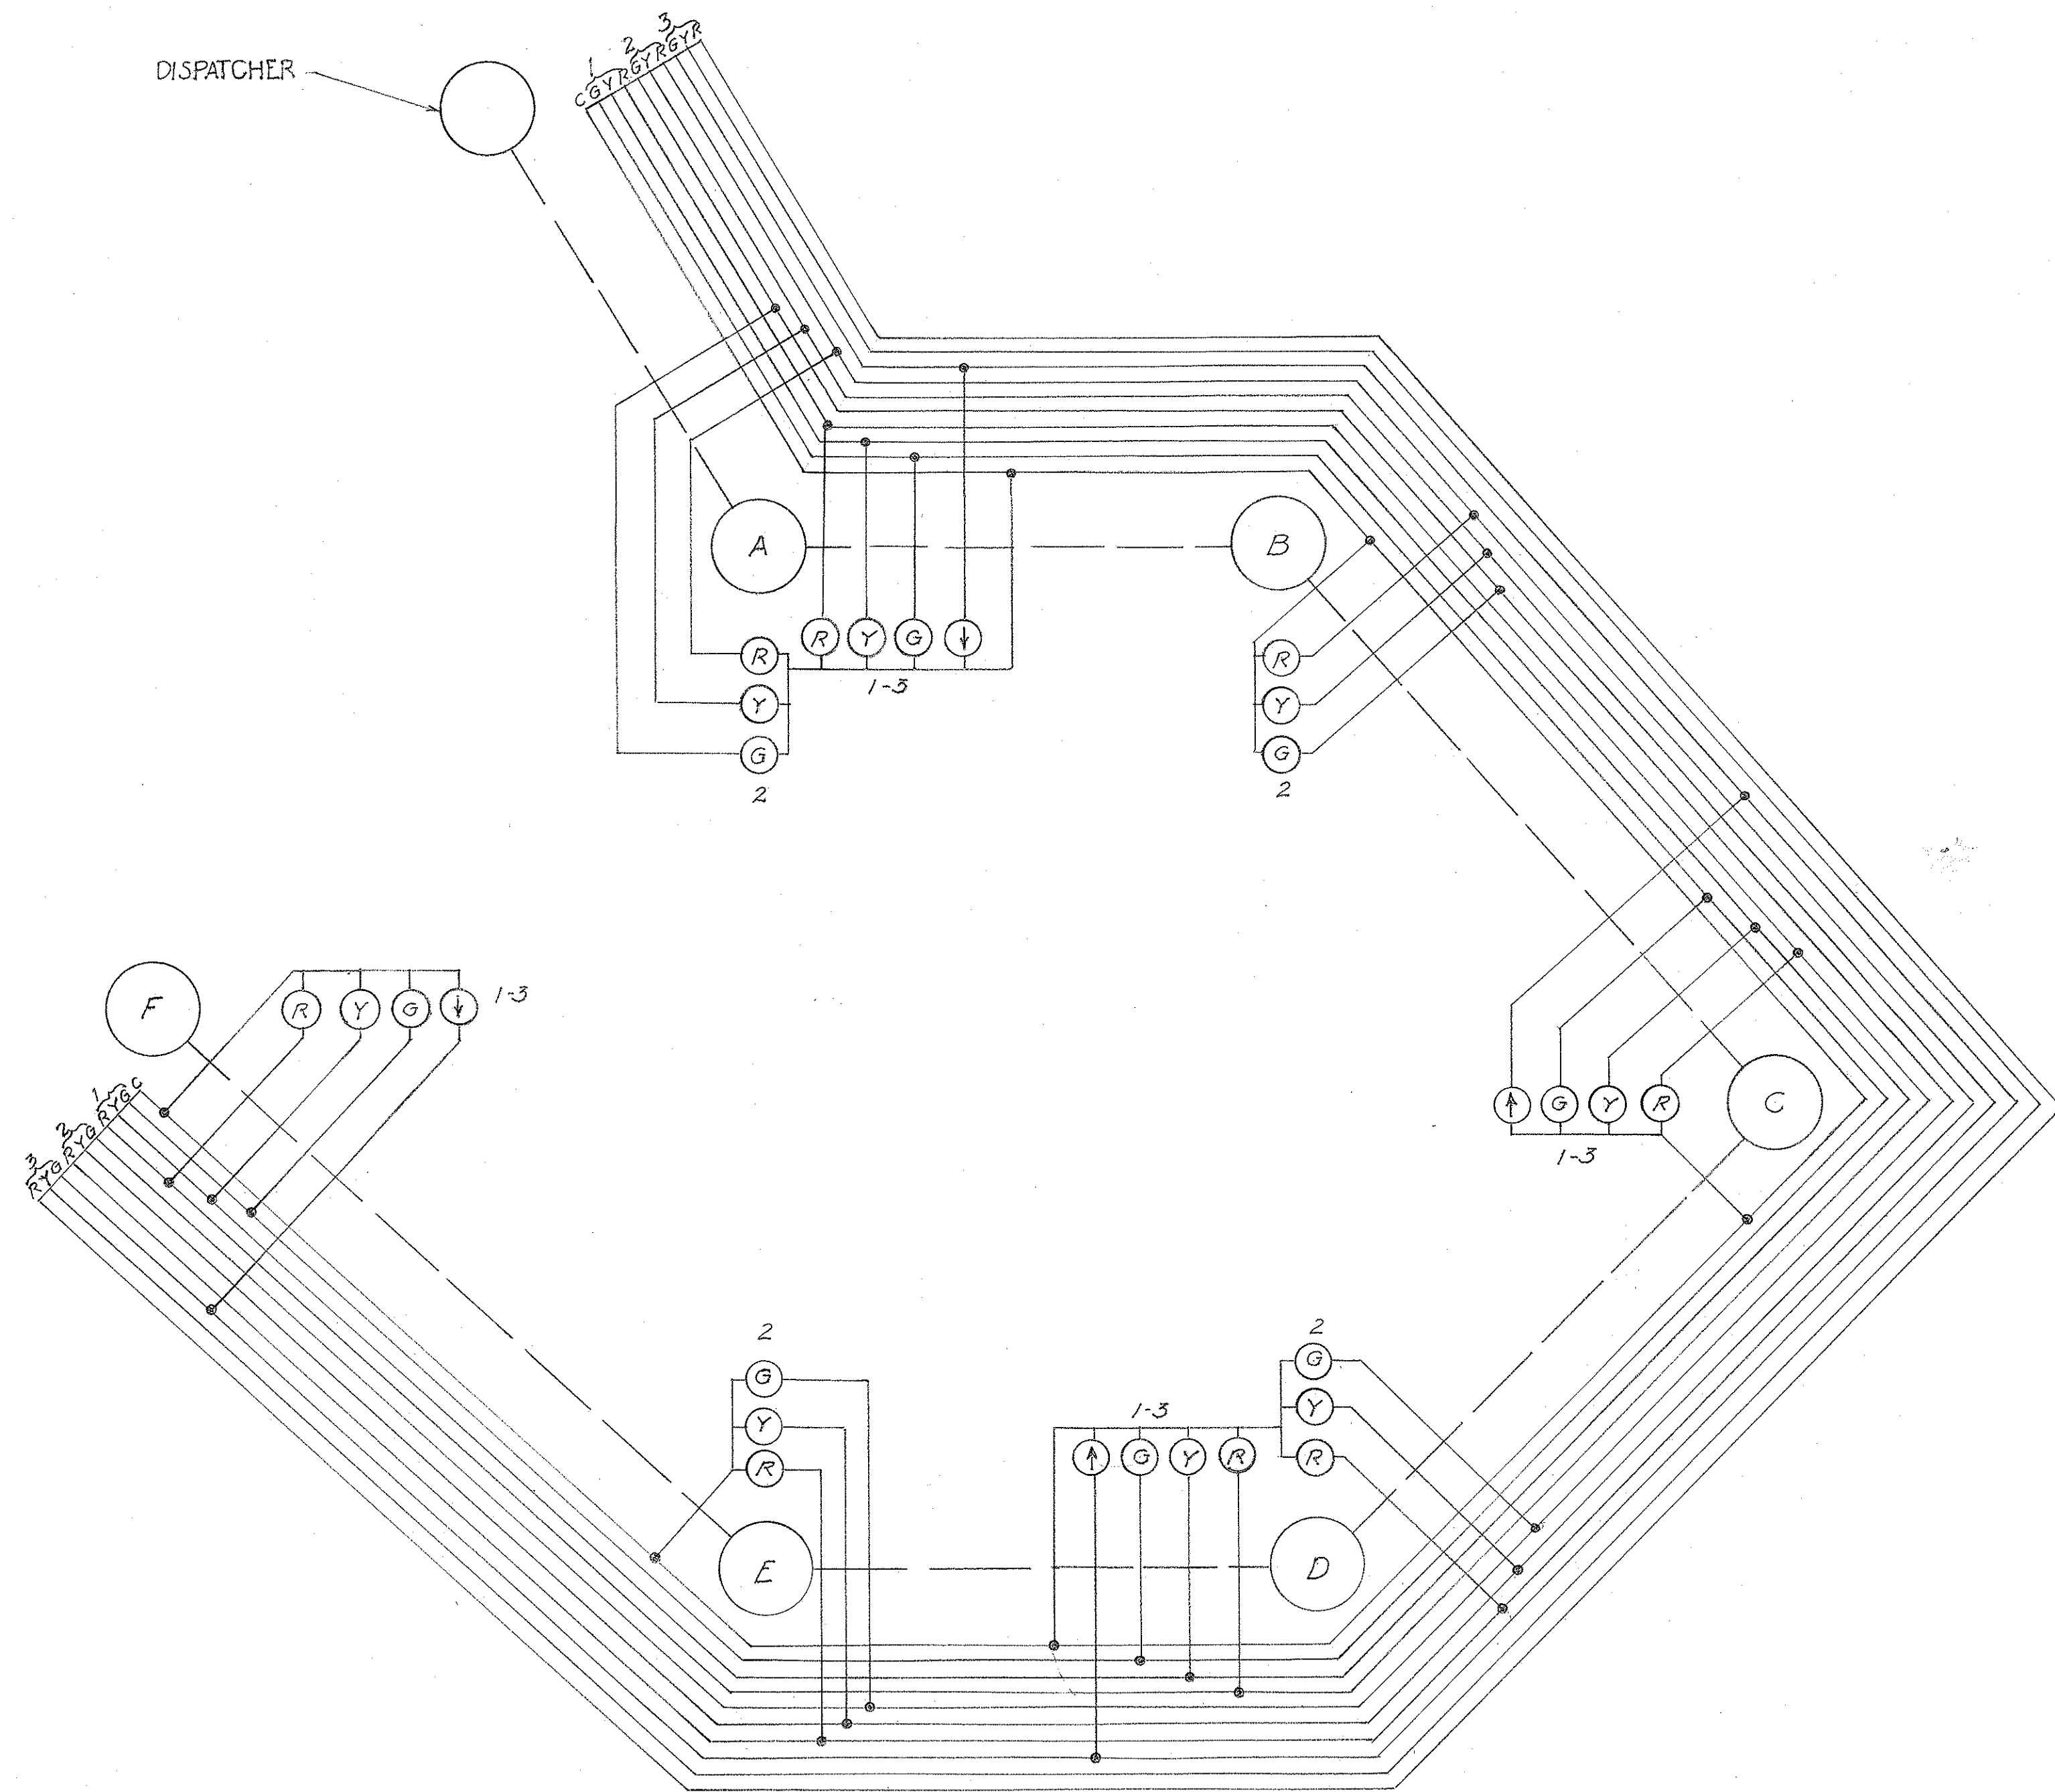

GEOGRAPHICAL CIRCUIT WIRING DIAGRAM

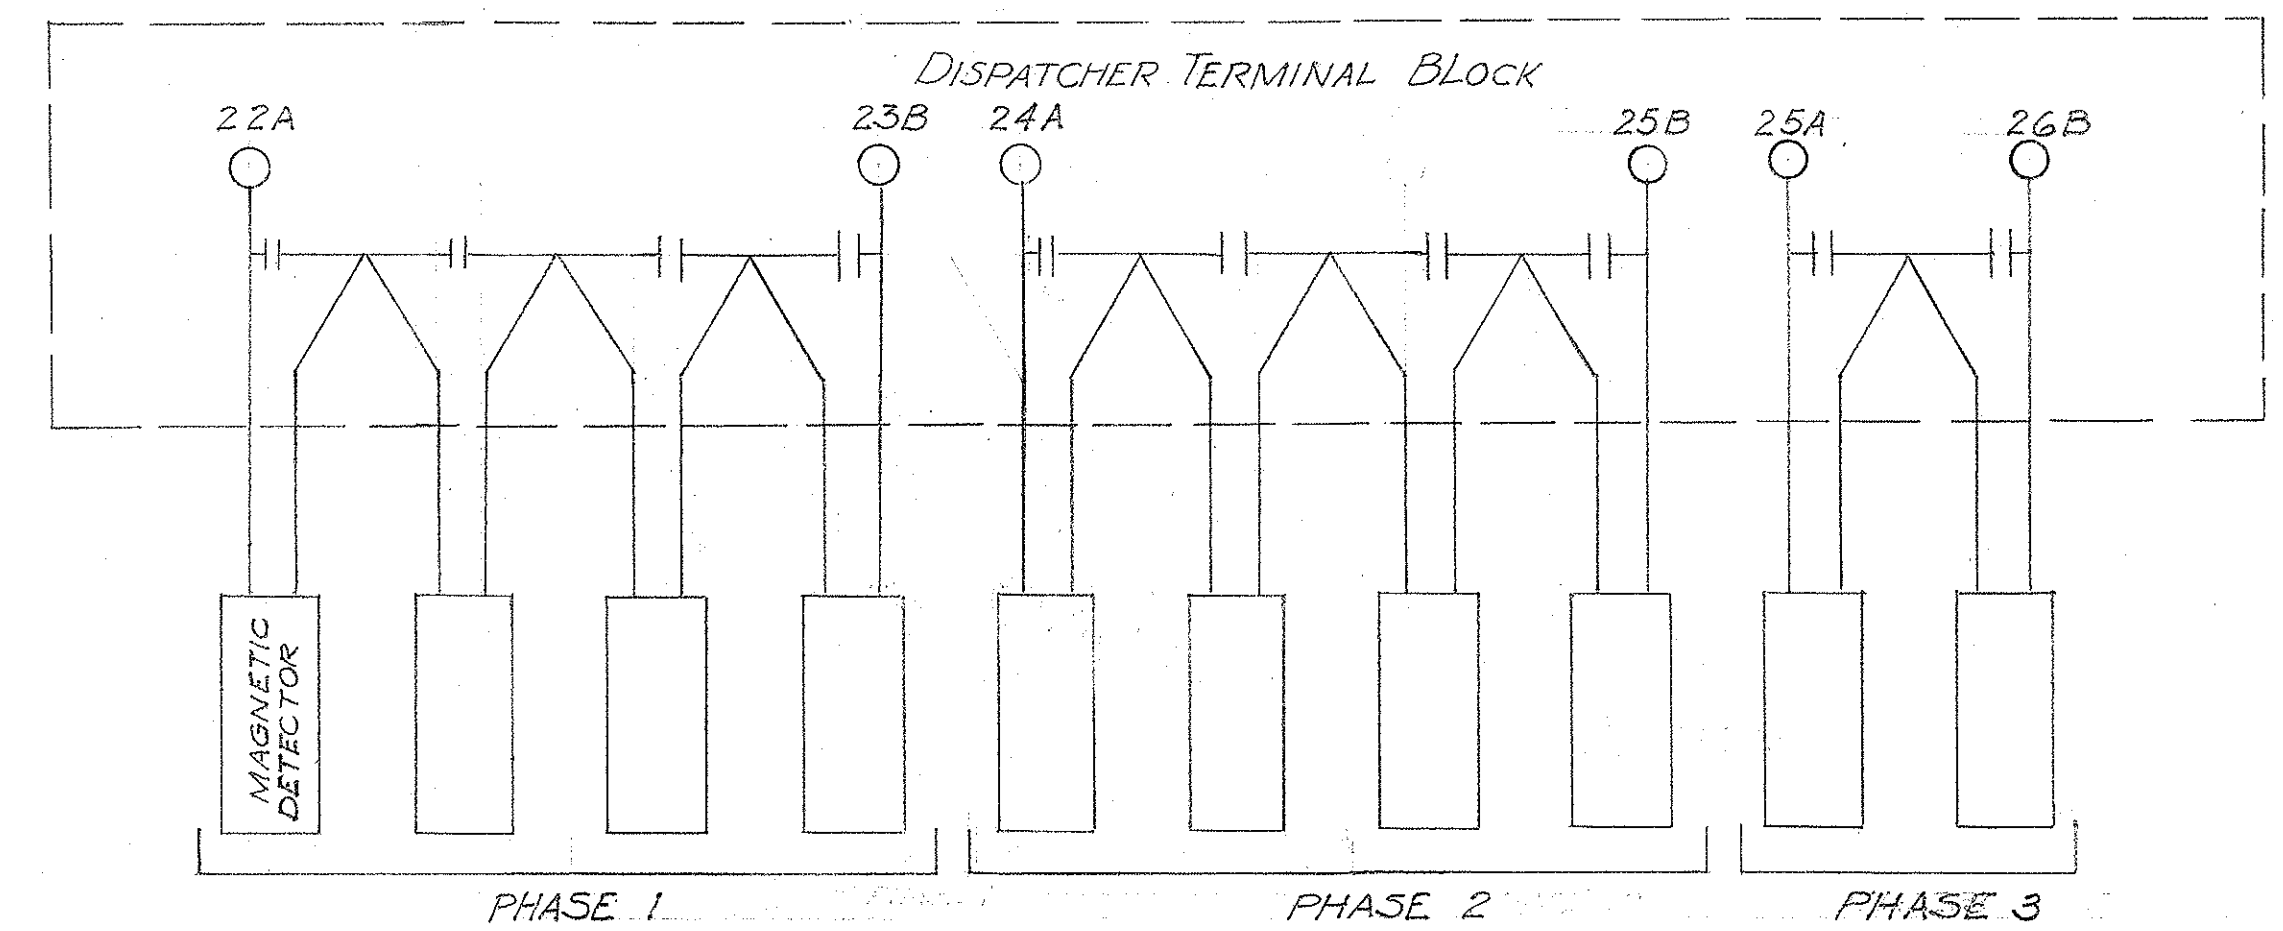

DETECTOR WIRING DIAGRAM

SURVEY PLOTTED BY _____ DATE _____
 DESIGNED BY _____
 DRAWN BY _____
 CHECKED BY _____
 NOTE BOOK _____
 QUANTITIES CHECKED BY _____
 CHECKED BY _____

TERRITORIAL HIGHWAY DEPARTMENT
 TERRITORY OF HAWAII
 INSTALLATION OF
 TRAFFIC CONTROL SIGNALS
 AT INTERSECTION OF
 HONOLULU-PEARL HARBOR RD.
 AND MOKAUEA ST.
 SCALE: AS NOTED FED. AID PROJ. NO. F44(7)
 AUG. 1948

SHEET NO. OF SHEETS

5347.4

2-14-48