


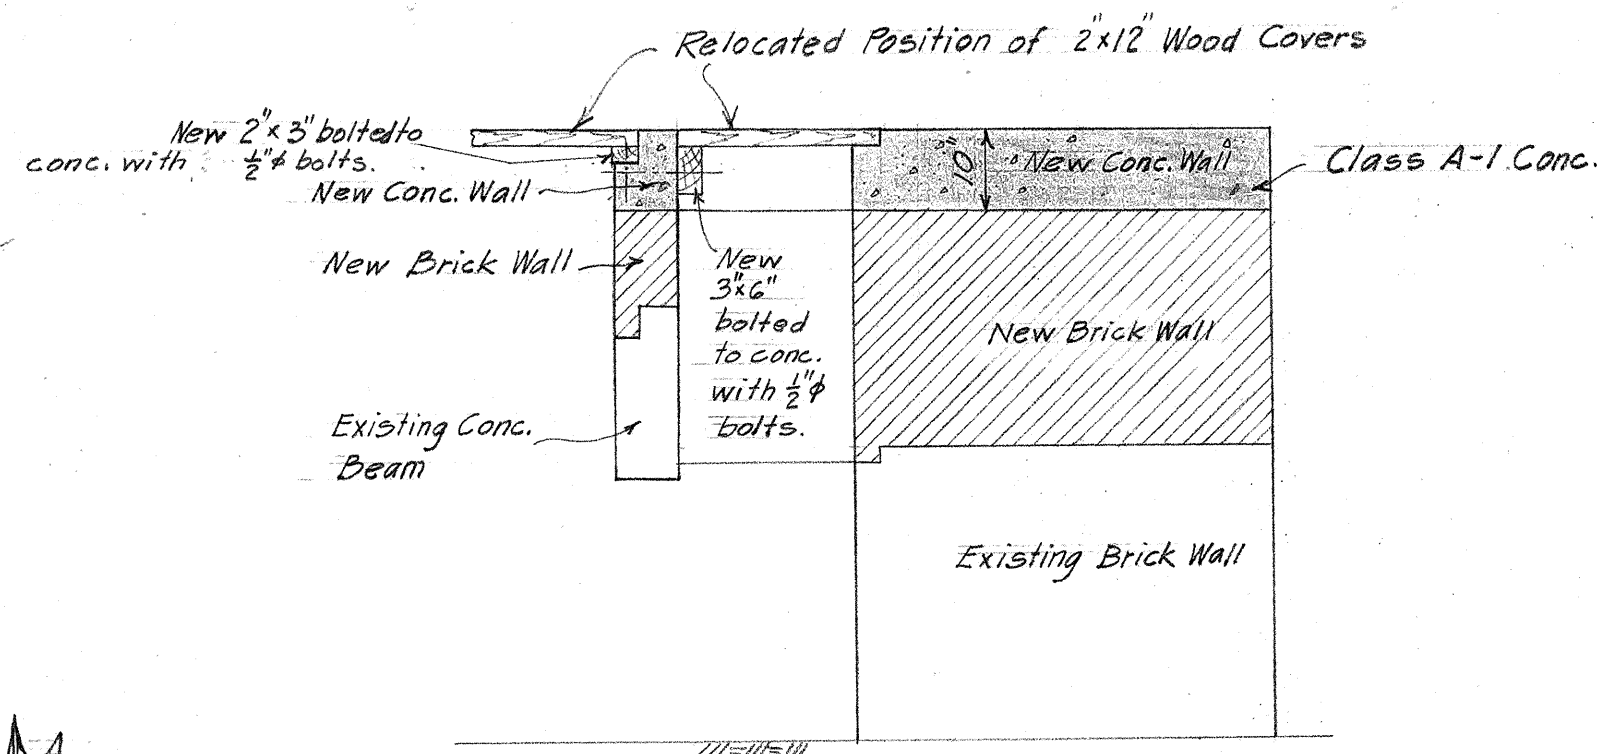


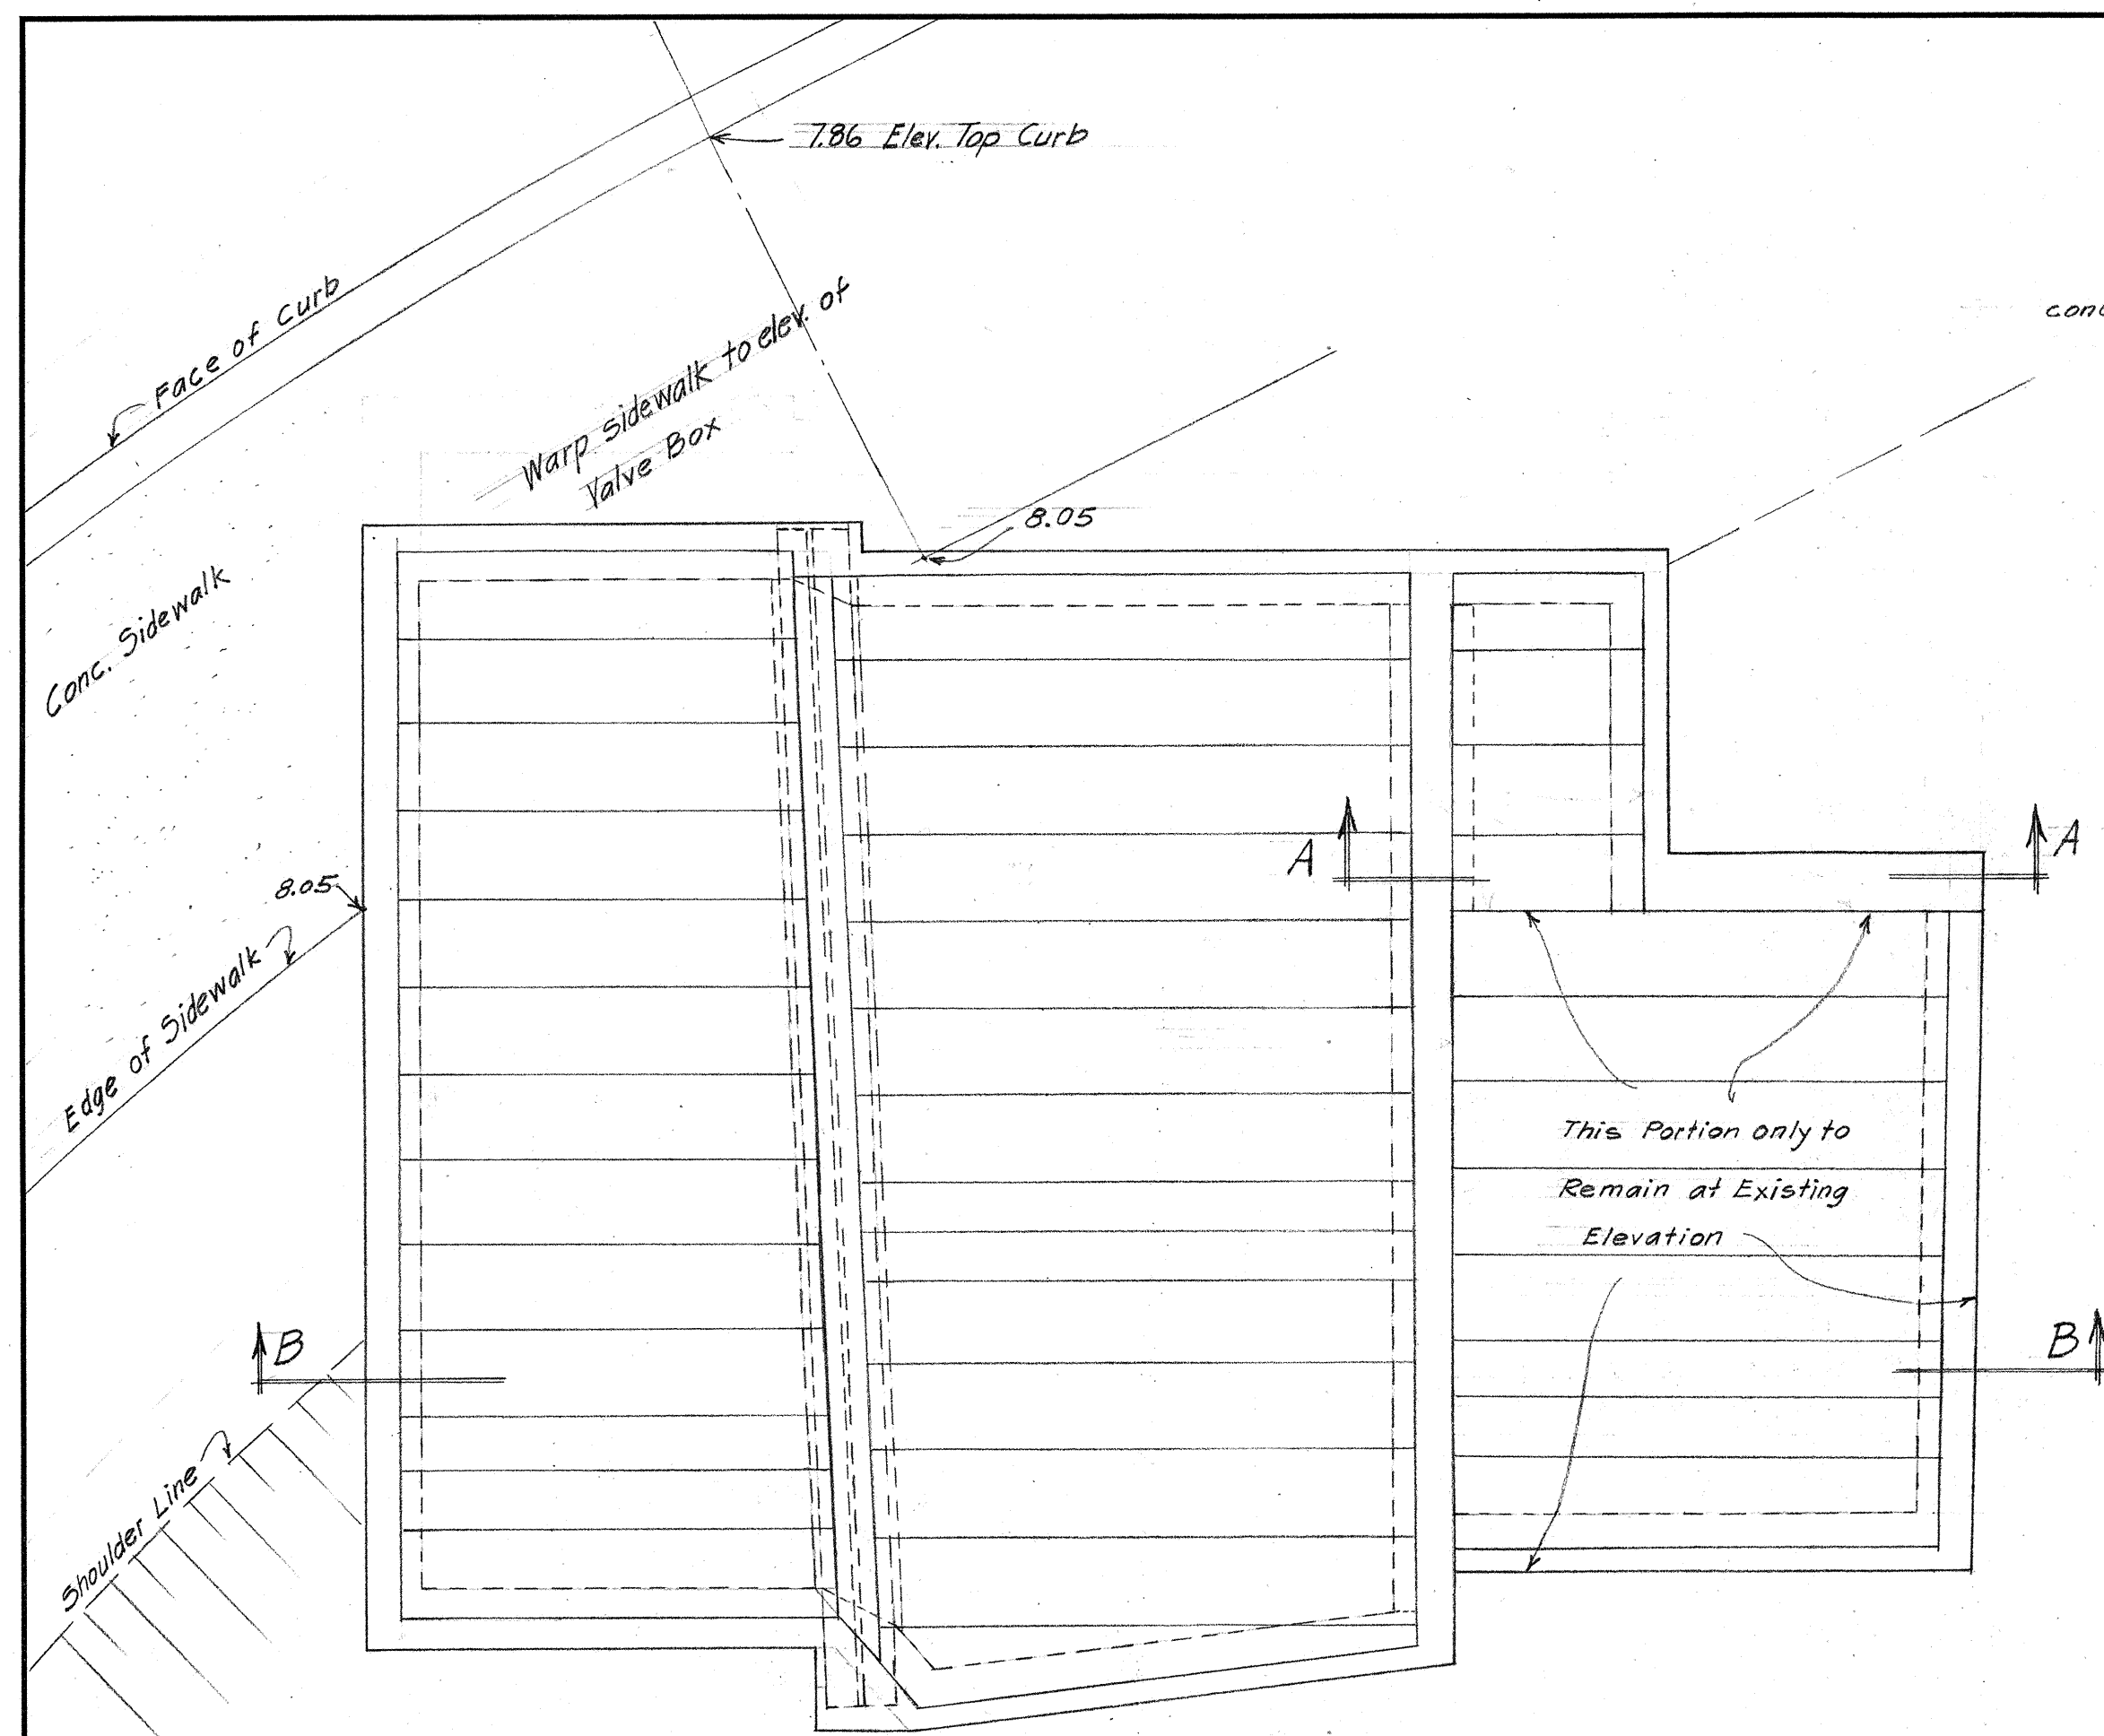

SECTION A-A
1/2" = 1'-0"

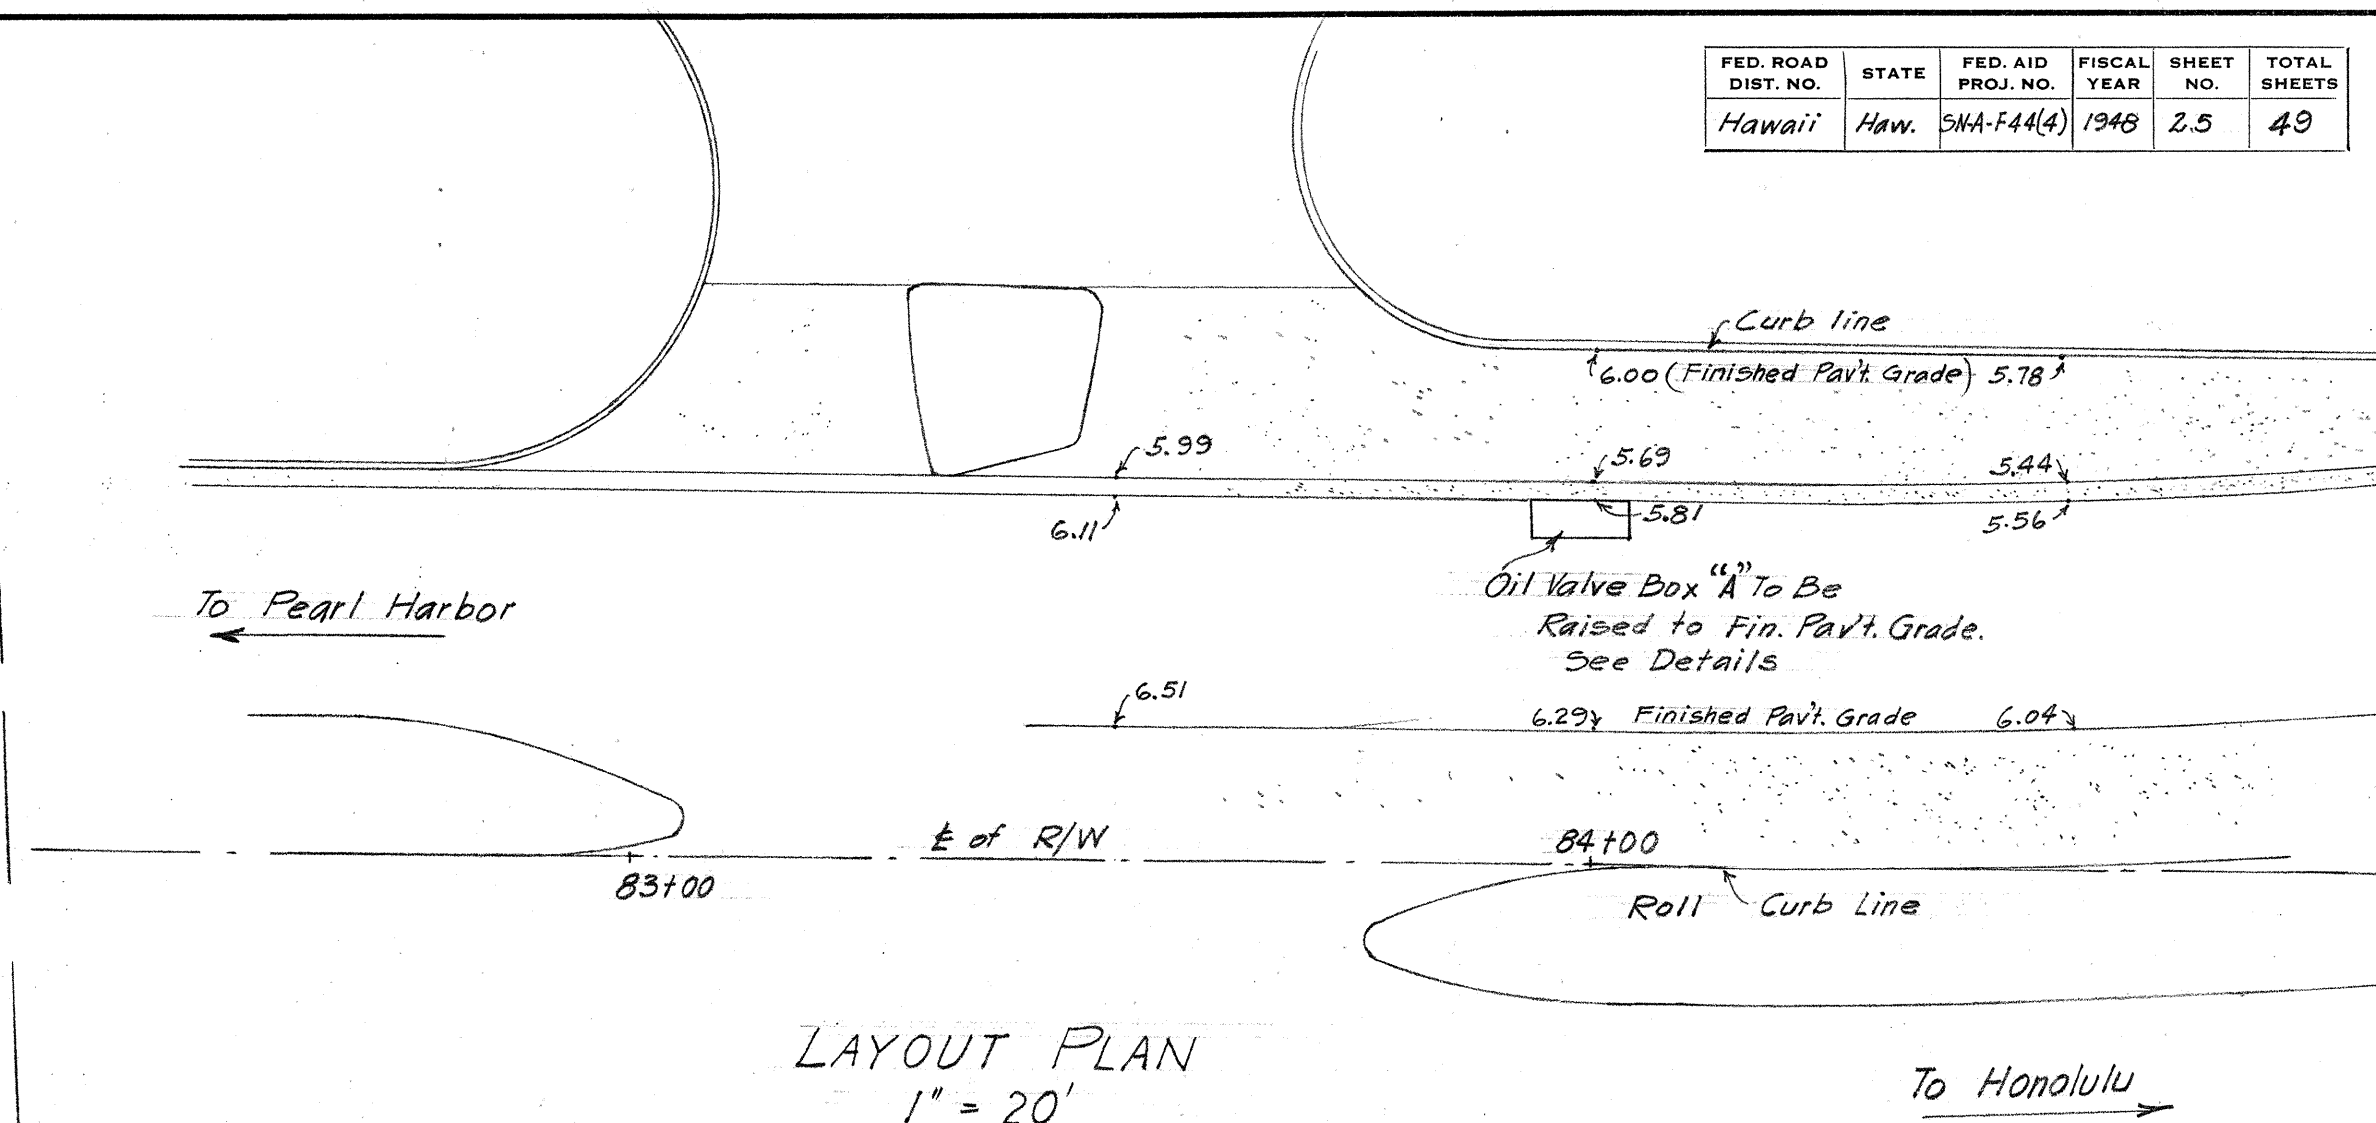


LAYOUT PLAN
1" = 20'

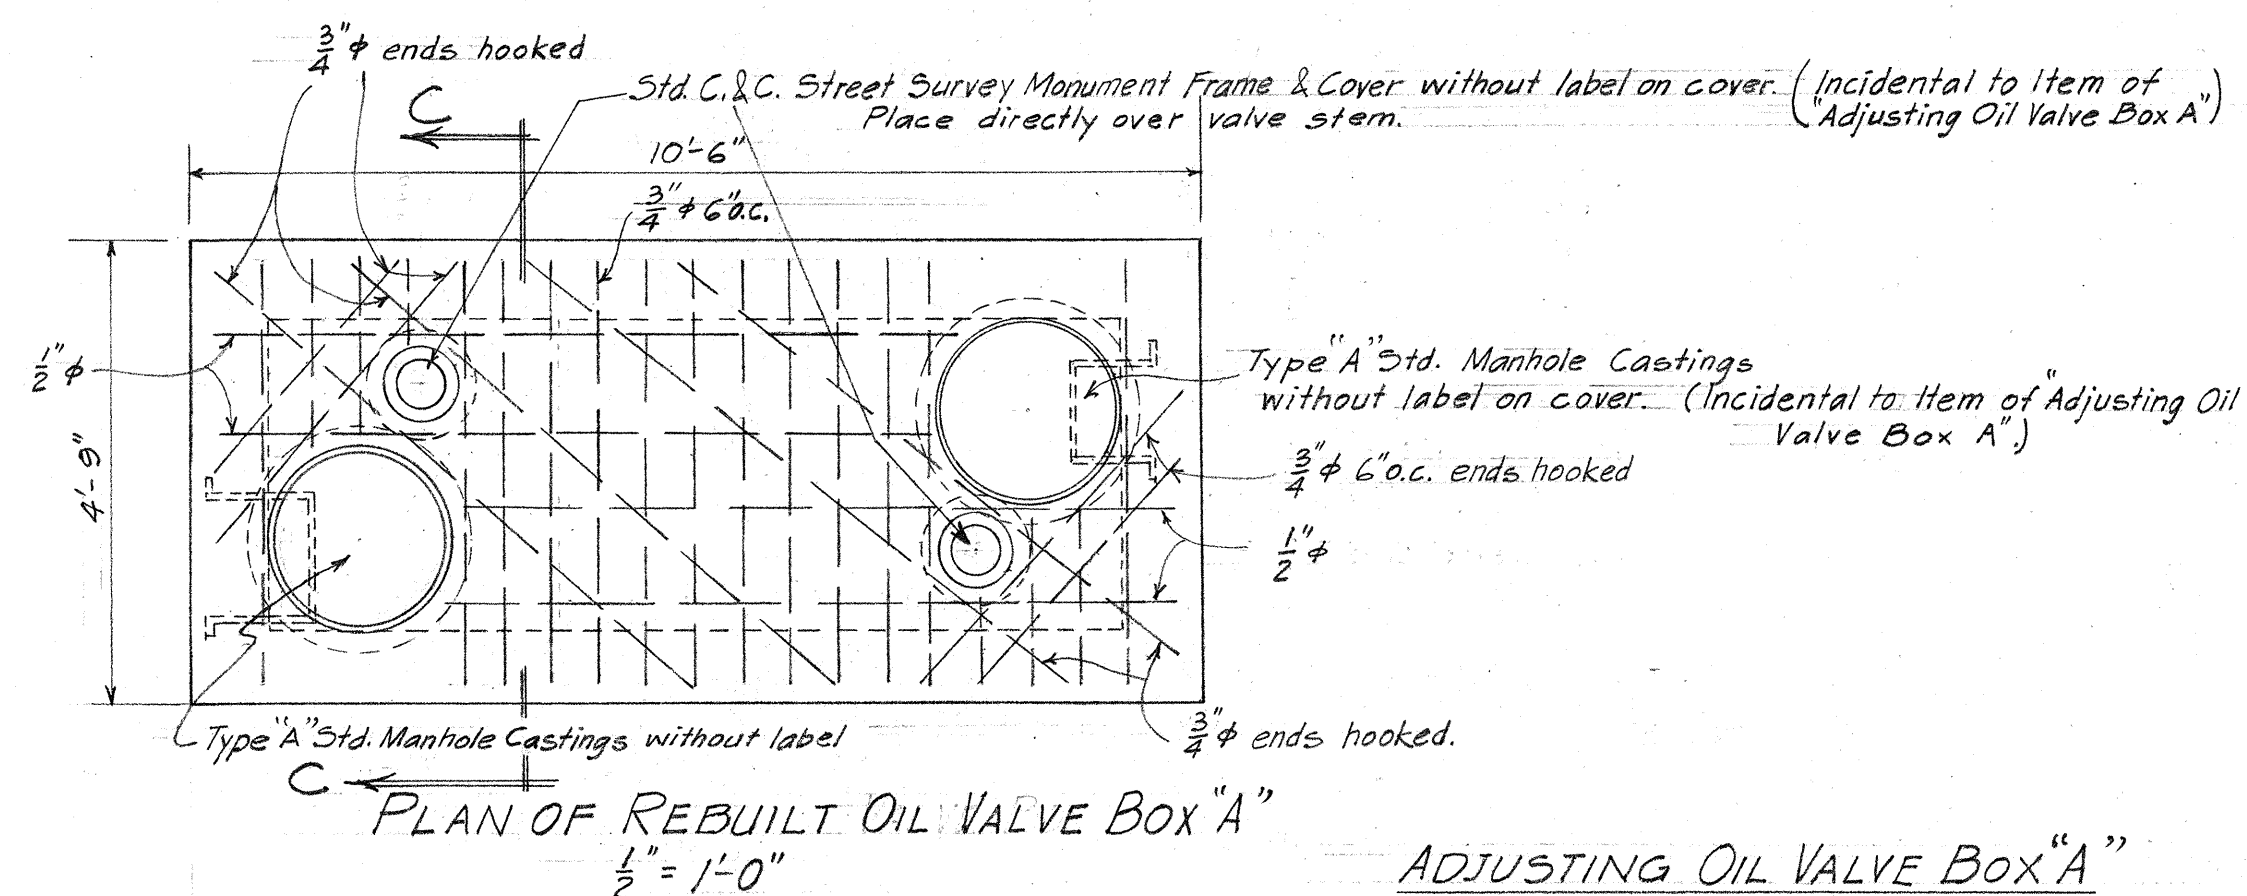

PLAN OF REBUILT OIL VALVE BOX "A"
1/2" = 1'-0"

ADJUSTING OIL VALVE BOX "A"


Class A-1 Conc. 1.50 Cu.Yd.
Reinforcing Steel 250 lbs.

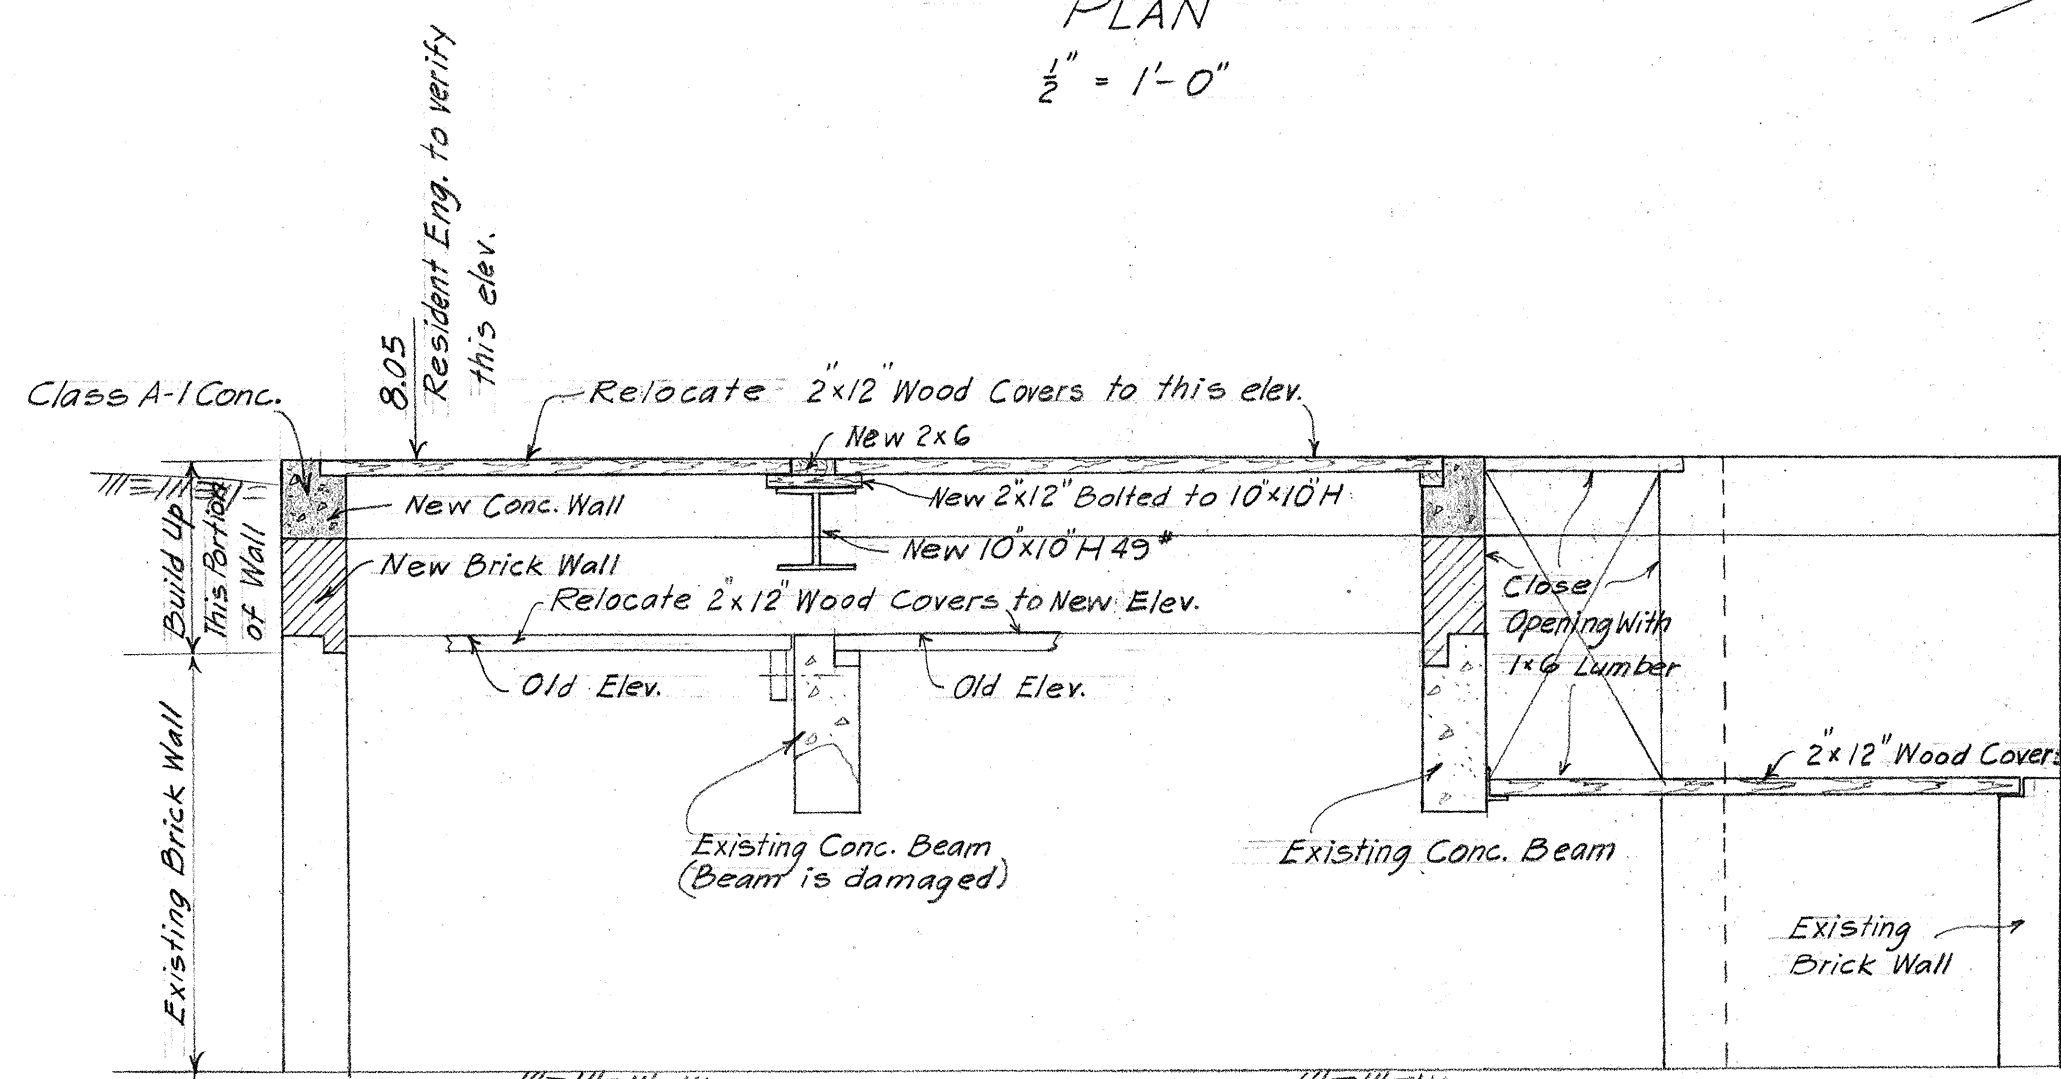


SECTION B-B
1/2" = 1'-0"

ADJUSTING OIL VALVE BOX "B"

Class A-1 Conc. 1.15 Cu.Yd.

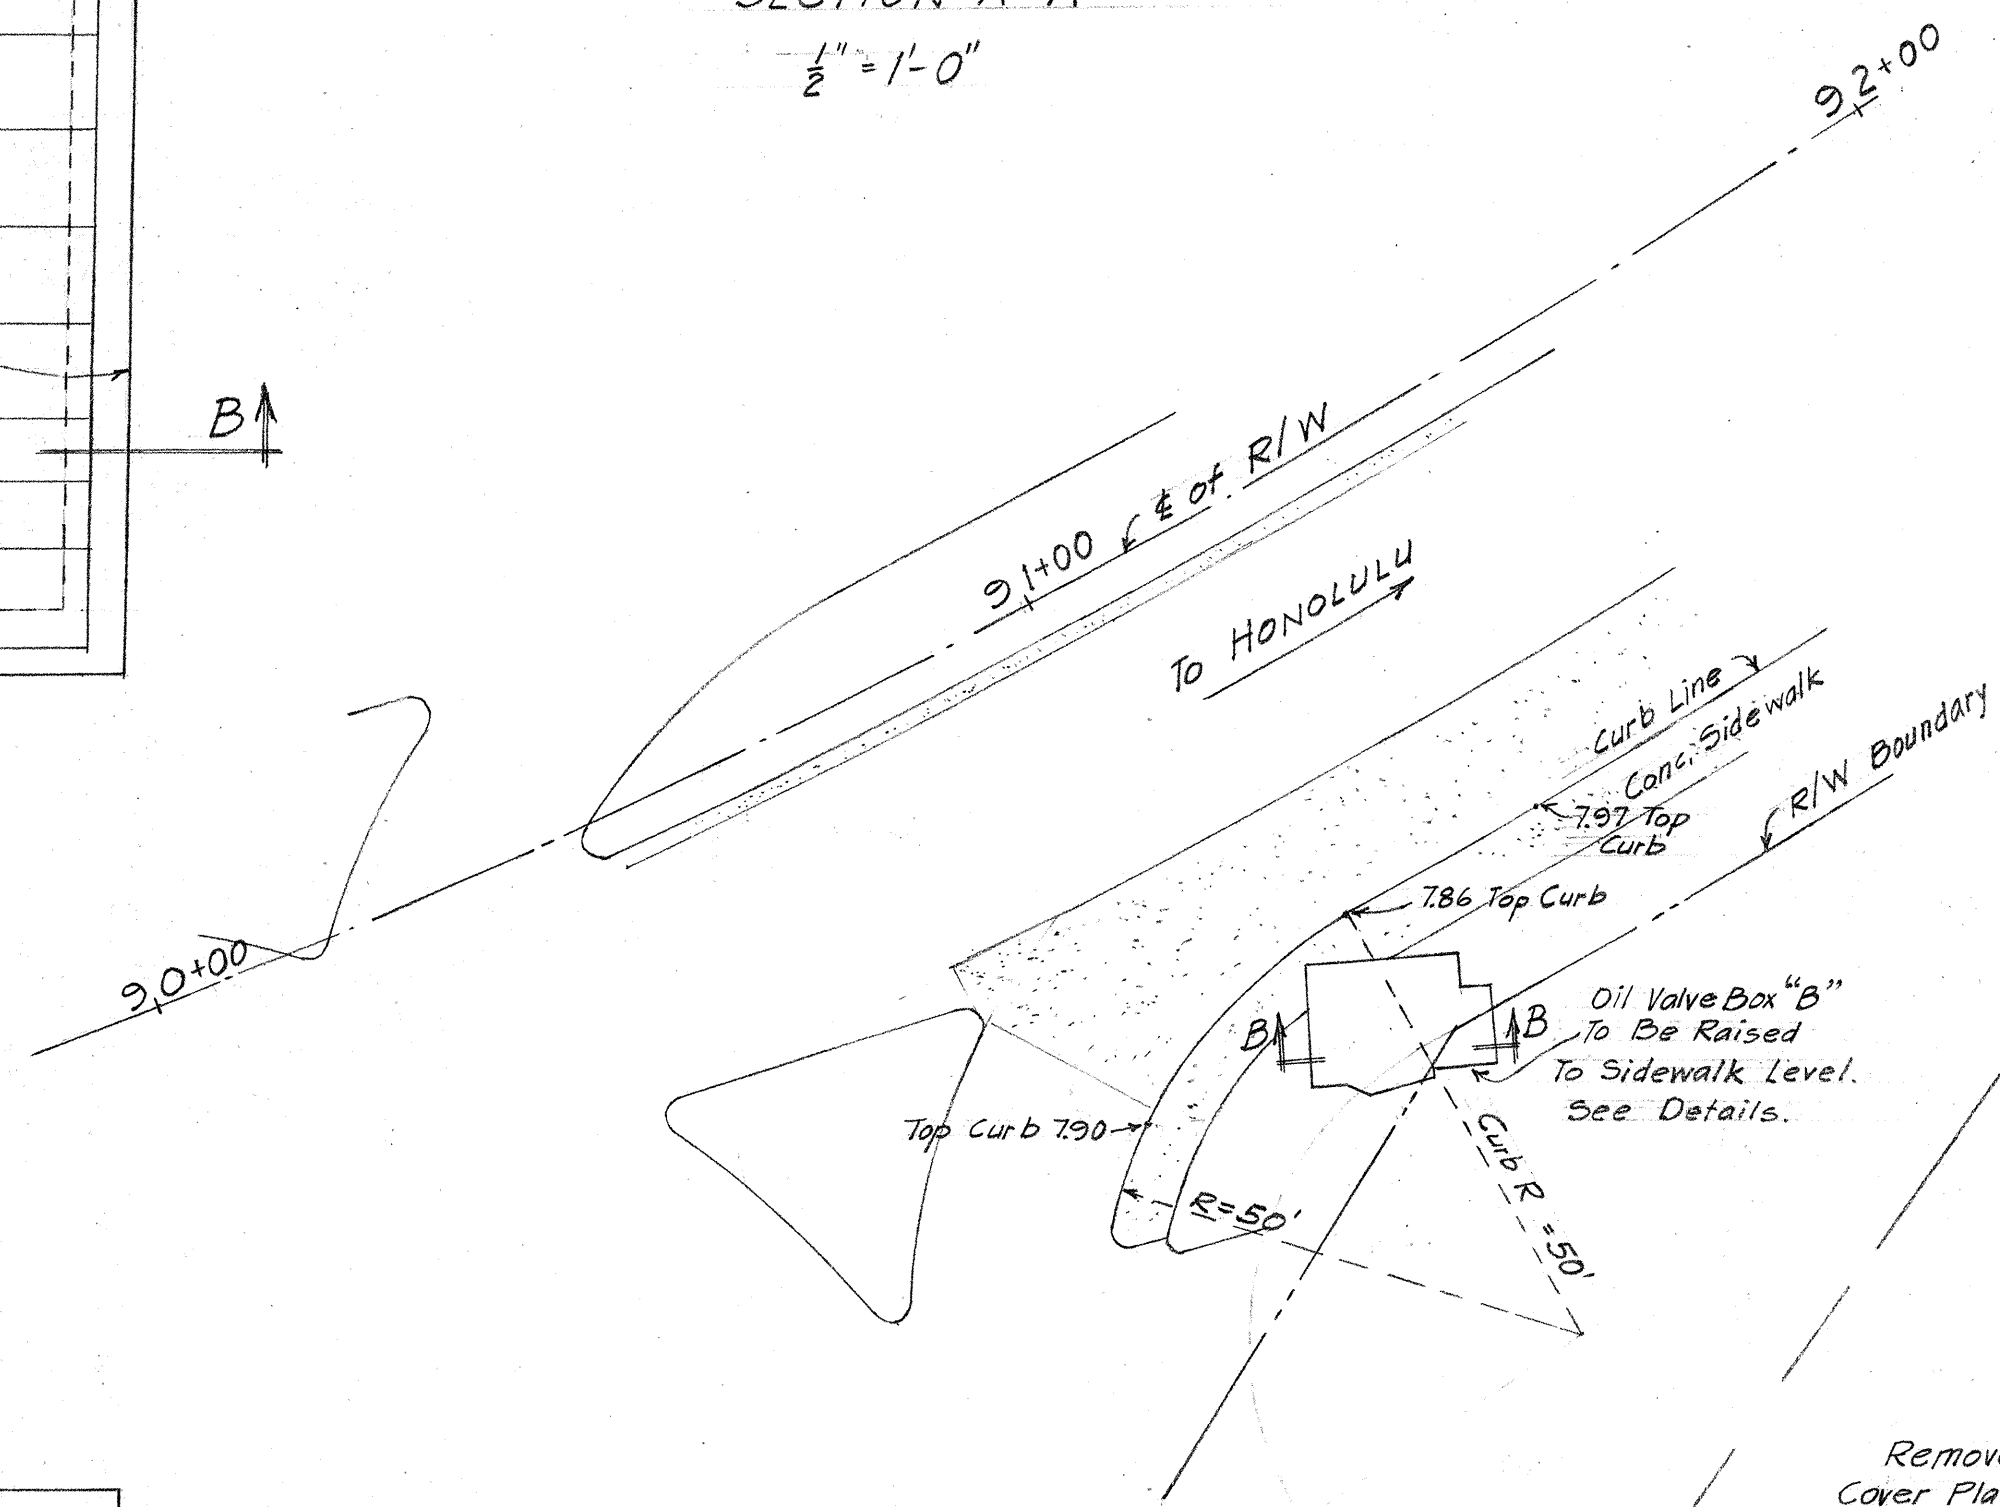

LAYOUT PLAN
1" = 20'-0"

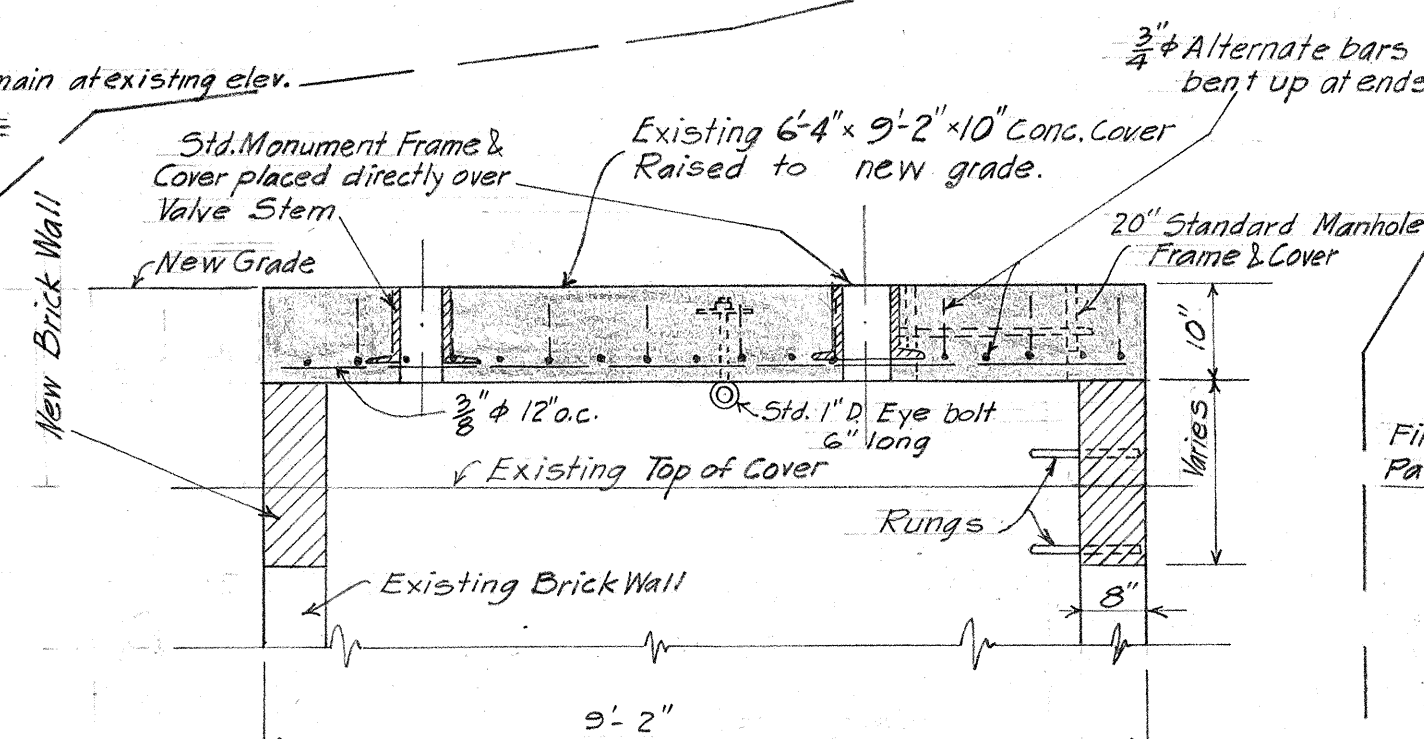


SECTION D-D SHOWING ADJUSTMENT TO WATER VALVE BOX
FOR BEVEL GEARED 16" GATE VALVES.
1/2" = 1'-0"


For Location of Water Valve Boxes see Plan Sheets.

Water Valve Box No.	Sta.
1	69 + 40 ±
2	73 + 87 ±
3	80 + 08 ±
4	84 + 92 ±
5	118' Right of Sta. 90 + 21 ±

NOT IN CONTRACT

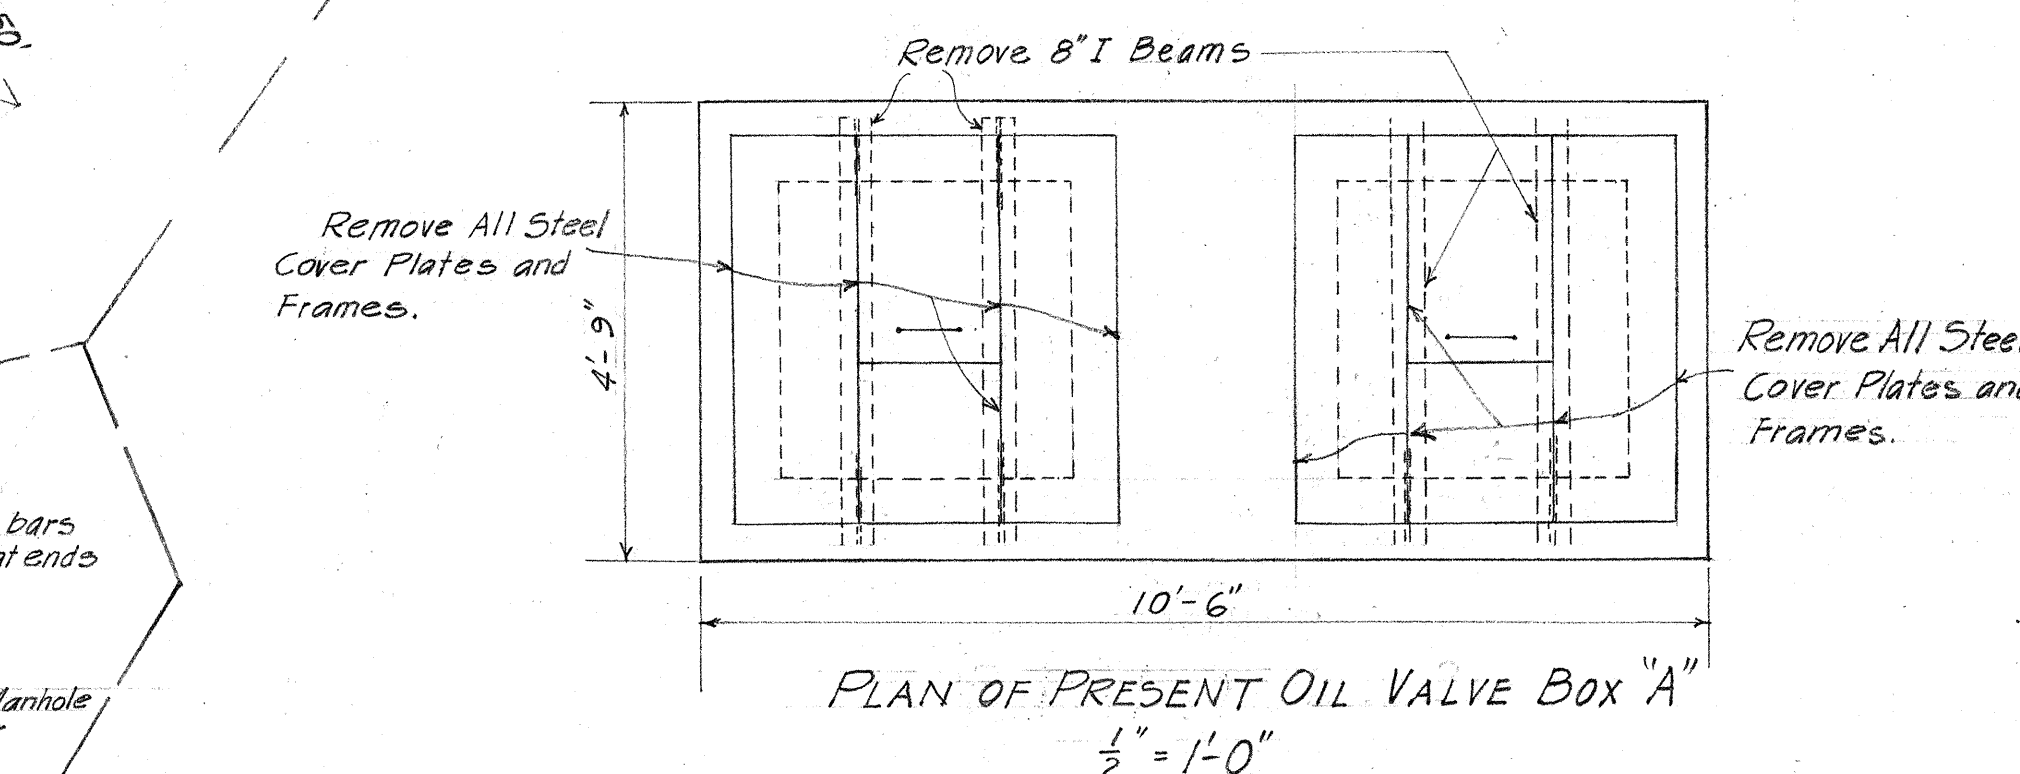

PLAN OF PRESENT OIL VALVE BOX "A"
1/2" = 1'-0"

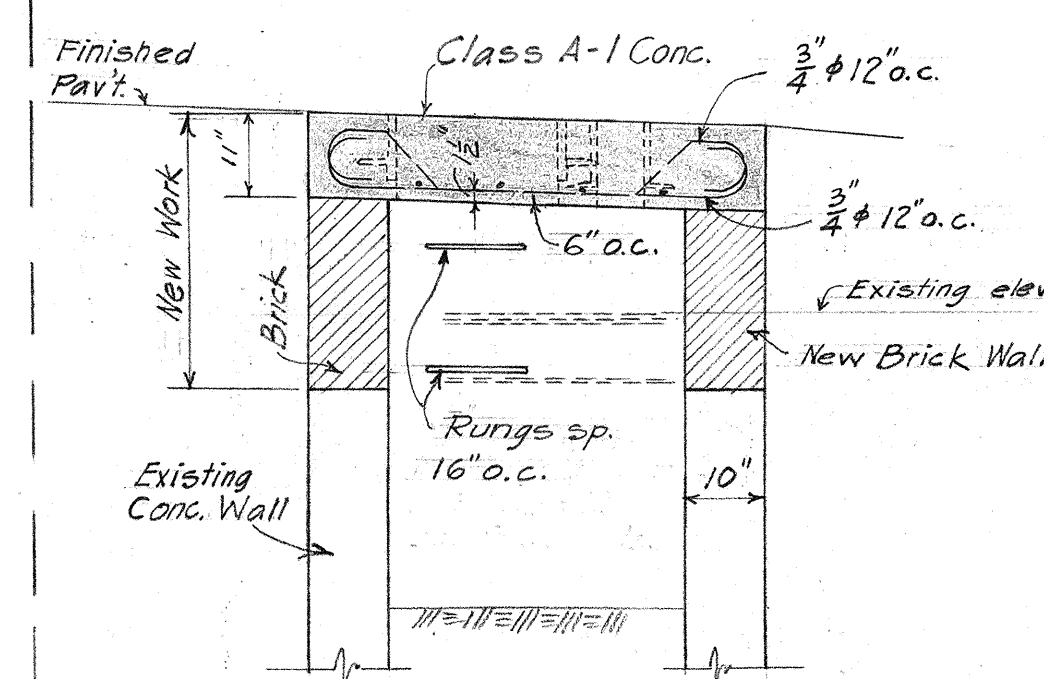

SECTION C-C
1/2" = 1'-0"

Note: The work involved in adjusting Oil and Water Valve Boxes will be paid for as a unit except new Class A-1 Concrete and Reinforcing Steel which will be paid for by their appropriate items.

TERRITORIAL HIGHWAY DEPARTMENT
TERRITORY OF HAWAII
ADJUSTING OIL AND WATER VALVE BOXES
HONOLULU PEARL HARBOR RD. SNAF 44-(4)
March, 1947

SHEET NO. OF SHEETS

5242.25

Correction 11-18-47

NOTE! ADJUSTING OIL VALVE BOX "B" IS NOT PART OF CONTRACT.

DATE: _____
DESIGNED BY: _____
CHECKED BY: _____
QUANTITIES BY: _____
NOTED BY: _____
ORIGINAL PLAN NO. _____