


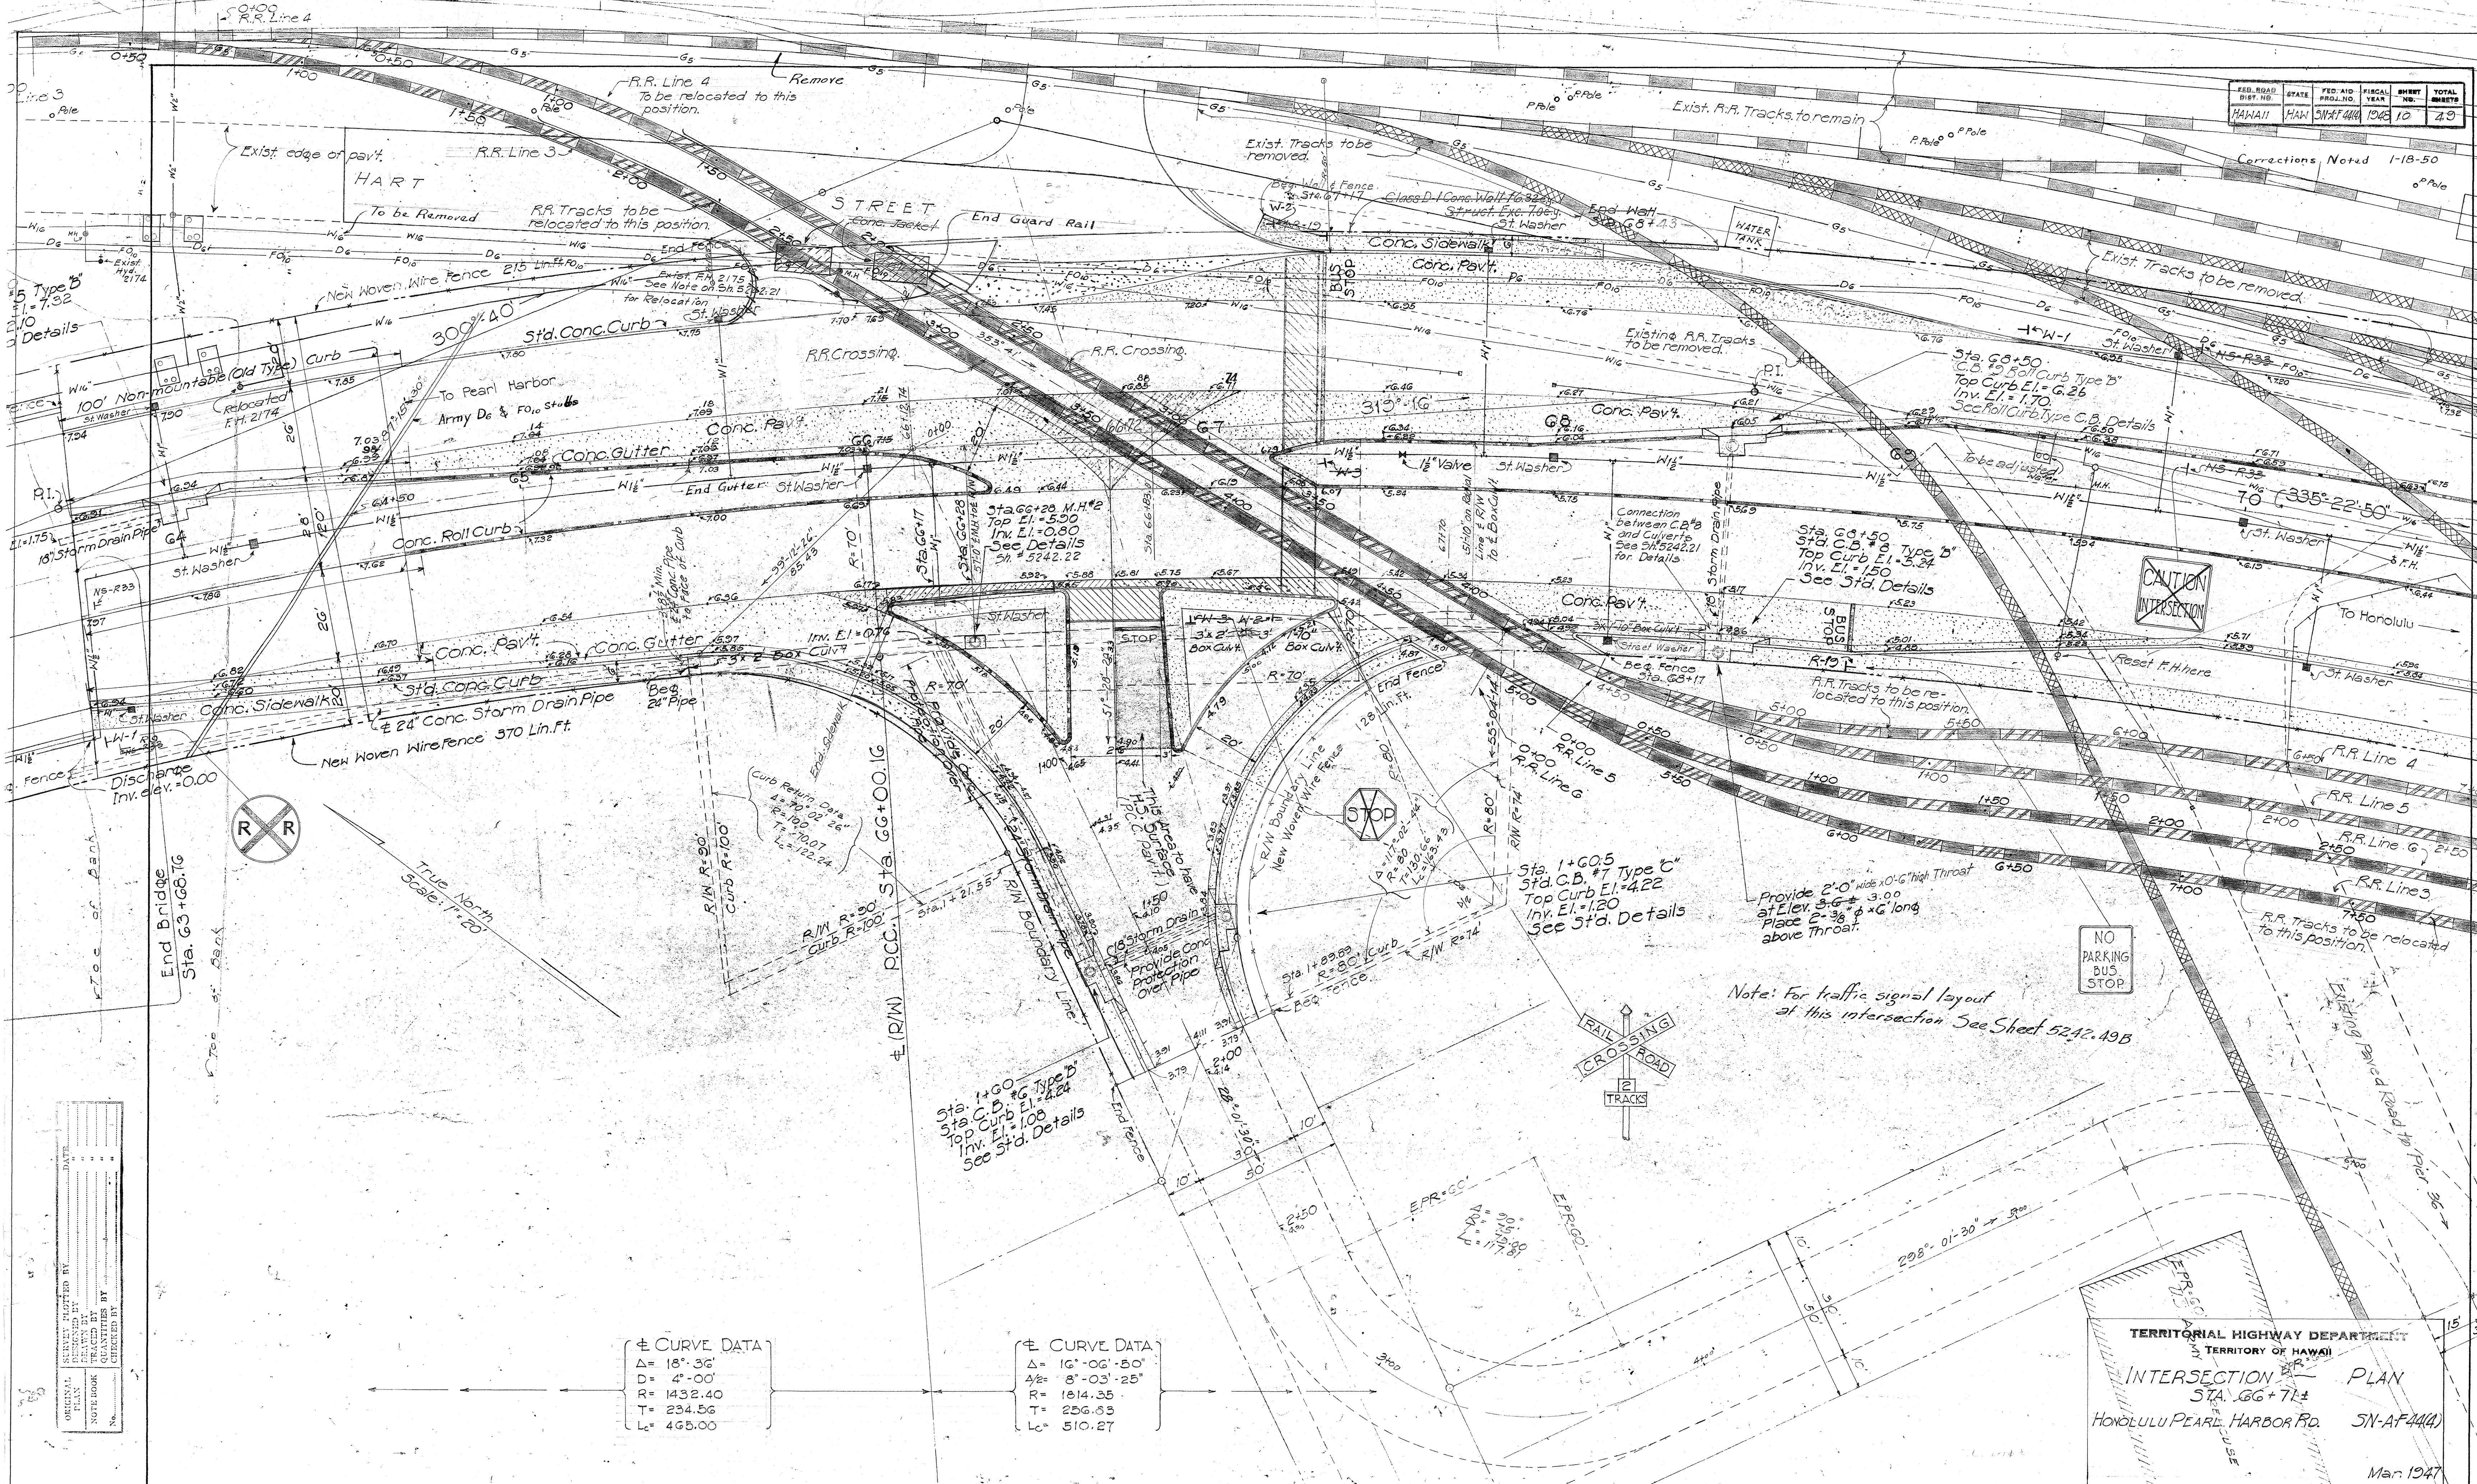

FED. ROAD DIST. NO.	STATE	FED. AID PROJ. NO.	FISCAL YEAR	SHEET NO.	TOTAL SHEETS
HAWAII	HAWAII	SN-AF 444	1947	10	40


Corrections Noted 1-18-50

CURVE DATA	
Δ	18° 36'
Δ/2	9° 18'
R	1432.40
T	234.56
L	465.00

CURVE DATA	
Δ	16° 06' 50"
Δ/2	8° 03' 25"
R	1814.35
T	256.53
L	510.27

TERRITORIAL HIGHWAY DEPARTMENT
 TERRITORY OF HAWAII
INTERSECTION PLAN
 STA. 66+71±
 HONOLULU PEARL HARBOR RD. SN-AF 444
 Mar. 1947

5242.10

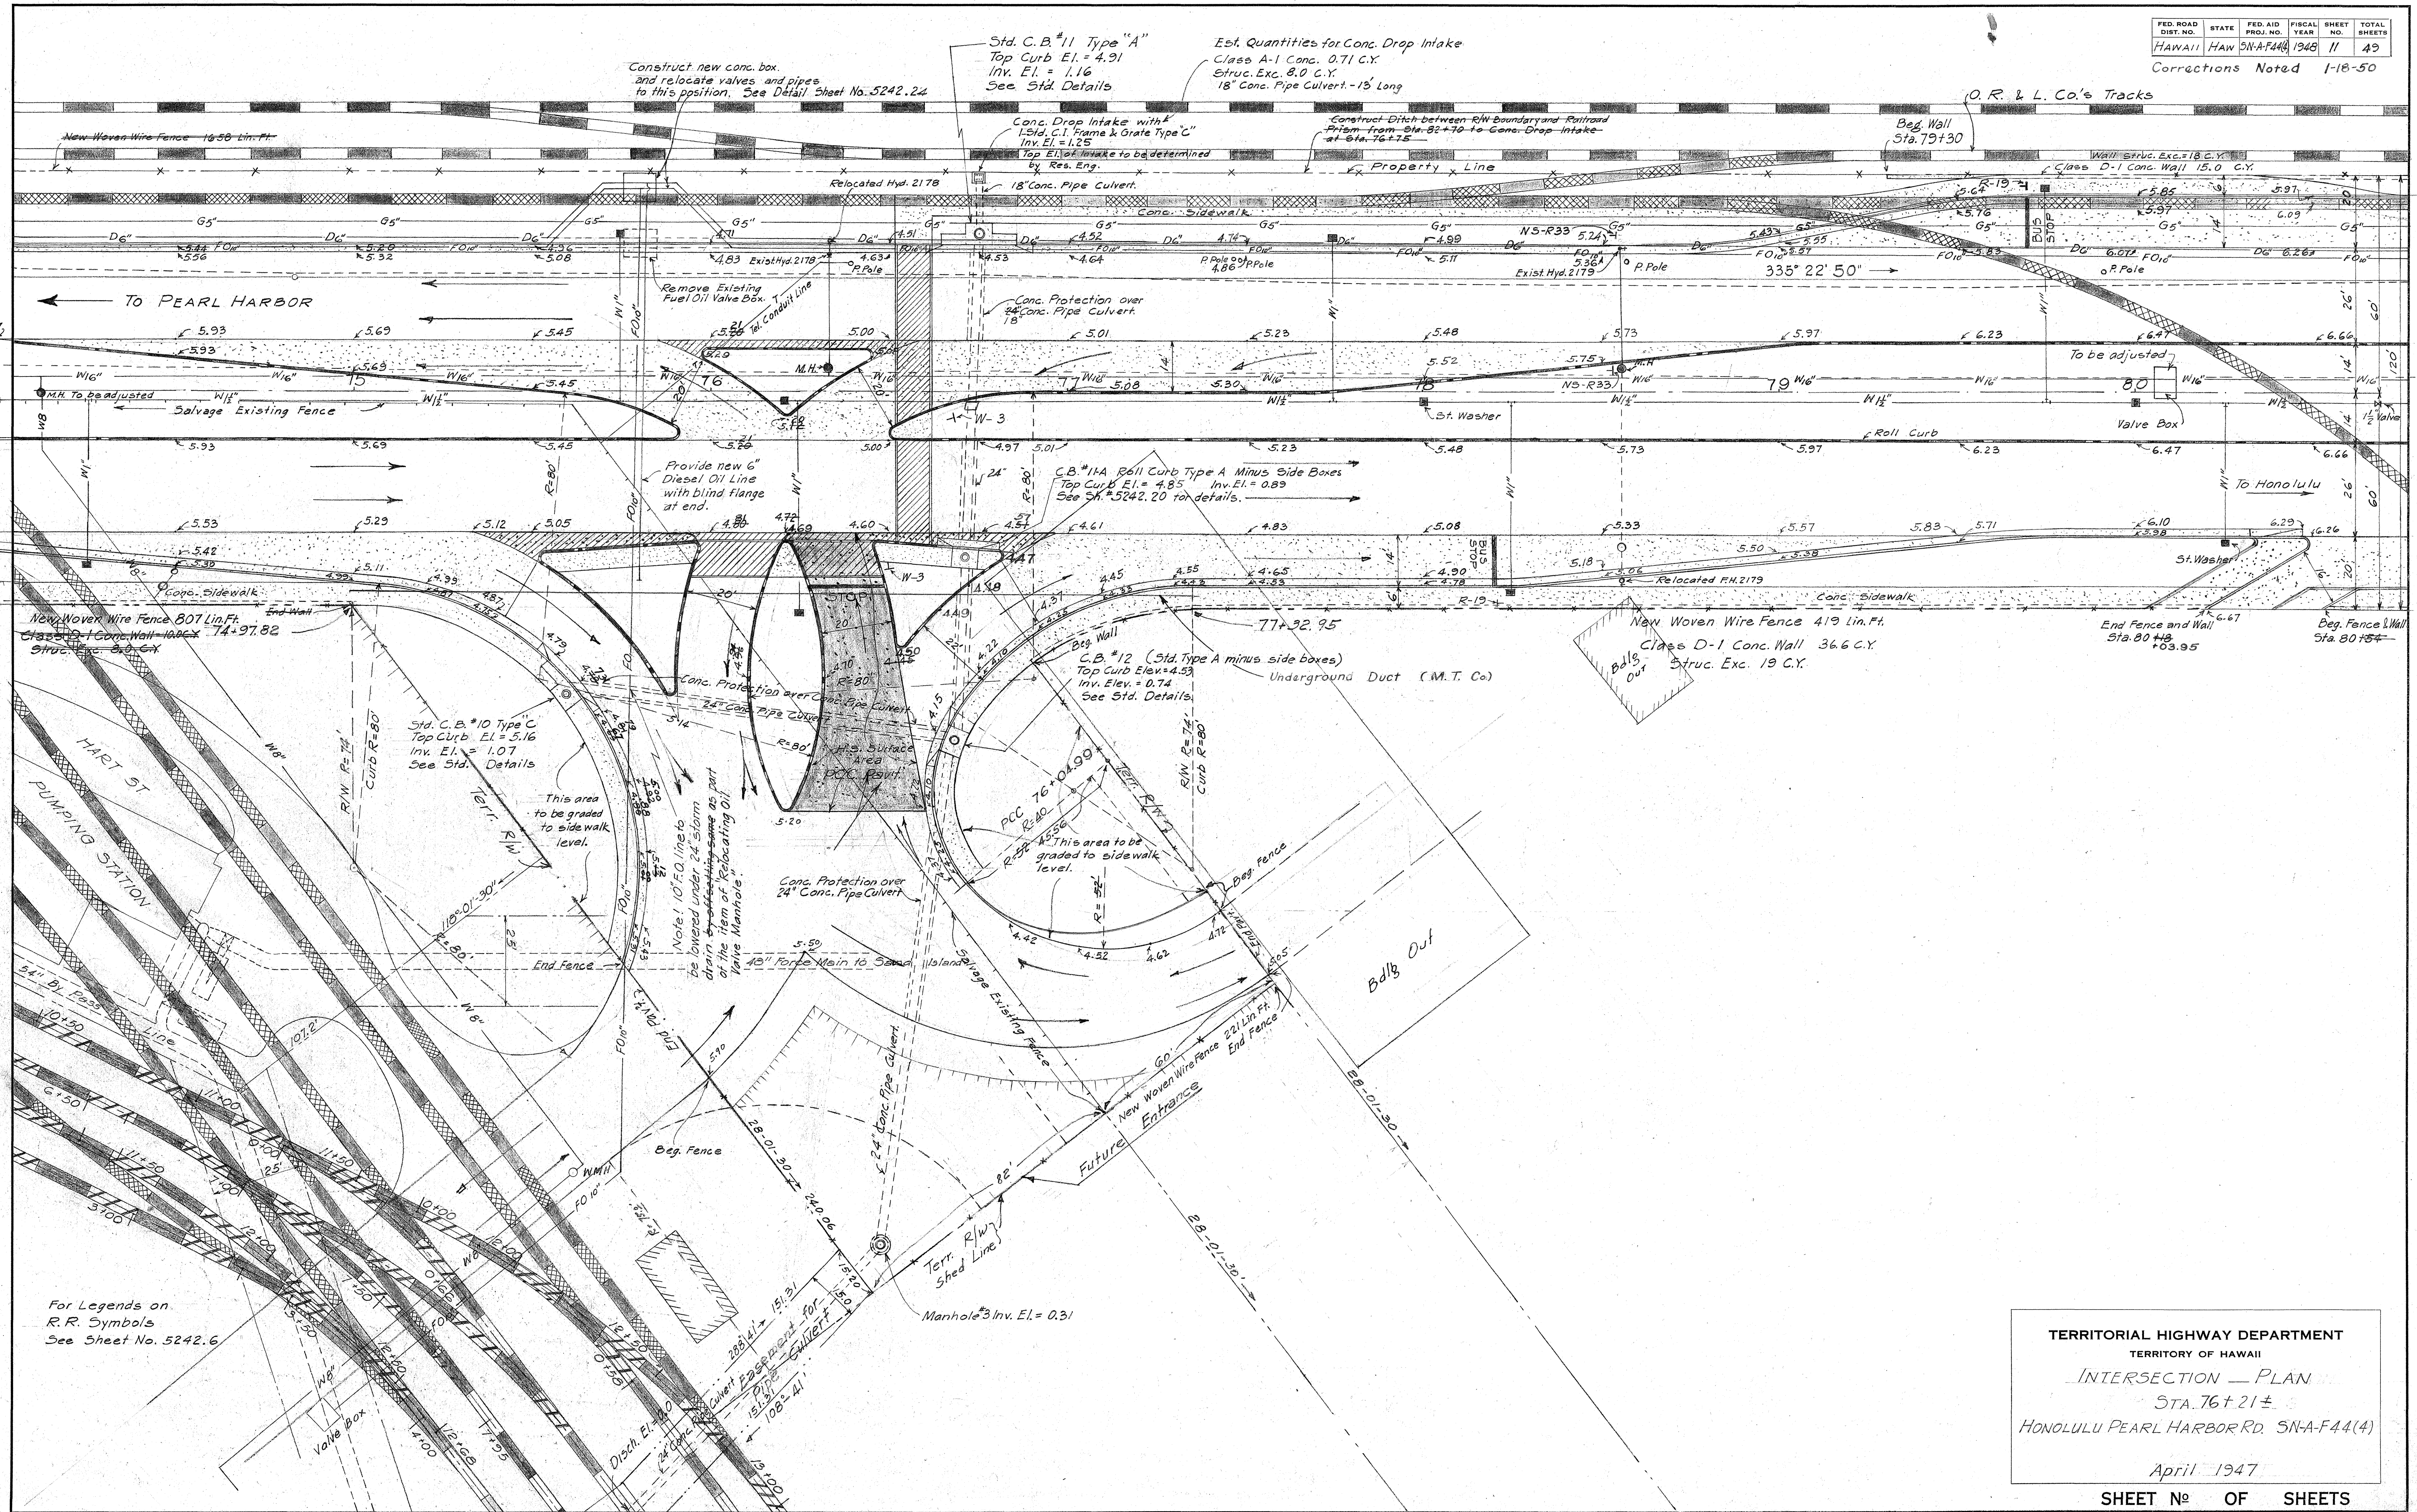

SURVEY PLOTTED BY _____ DATE _____
 DESIGNED BY _____
 TRACED BY _____
 QUANTITIES BY _____
 CHECKED BY _____
 No. _____

For Legends on
 R.R. Symbols
 See Sheet No. 5242.6

TERRITORIAL HIGHWAY DEPARTMENT
 TERRITORY OF HAWAII
INTERSECTION — PLAN
 STA. 76+21.5
 HONOLULU PEARL HARBOR RD. 5N-A-F44(4)
 April 1947
 SHEET No. 11 OF 49 SHEETS

