



| PLAN | DATE | BY | CHKD. |
|------|------|----|-------|
| NO.  |      |    |       |
| NO.  |      |    |       |
| NO.  |      |    |       |

| PROFILE | DATE | BY | CHKD. |
|---------|------|----|-------|
| NO.     |      |    |       |
| NO.     |      |    |       |
| NO.     |      |    |       |

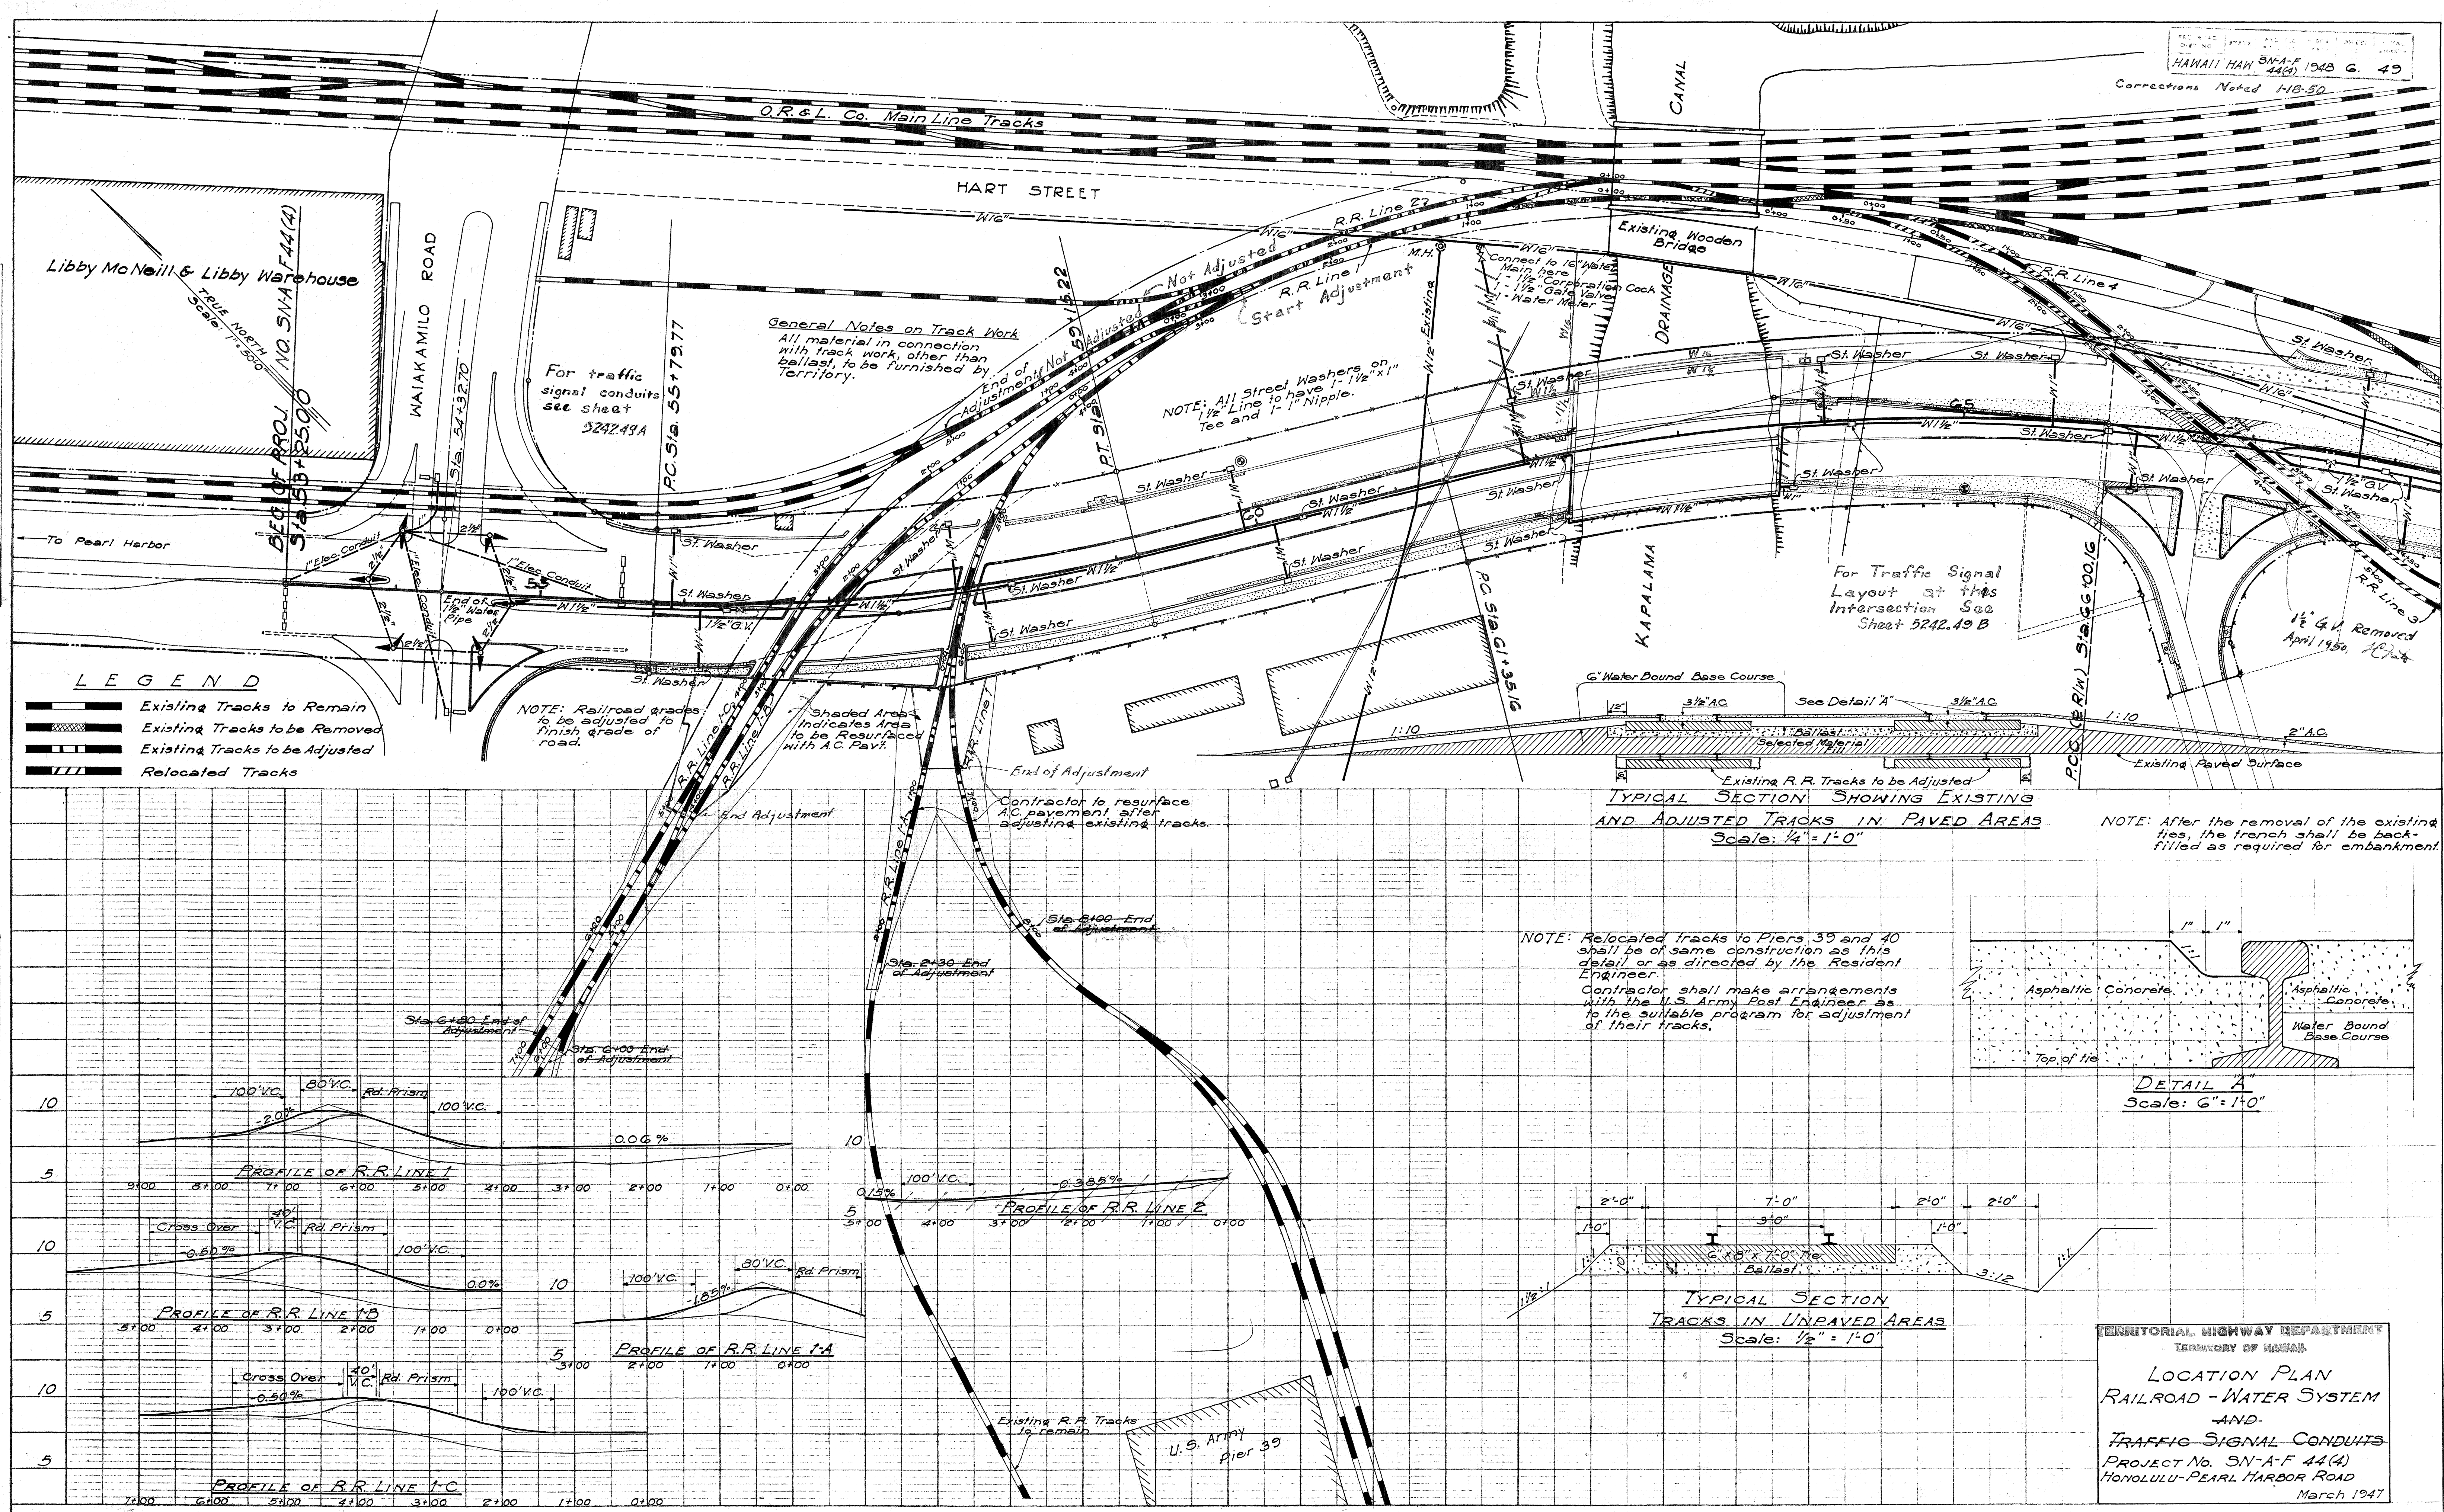



TERRITORIAL HIGHWAY DEPARTMENT  
 TERRITORY OF HAWAII  
**LOCATION PLAN**  
 RAILROAD - WATER SYSTEM  
 AND  
 TRAFFIC SIGNAL CONDUITS  
 PROJECT No. SN-A-F 44(A)  
 HONOLULU-PEARL HARBOR ROAD  
 March 1947

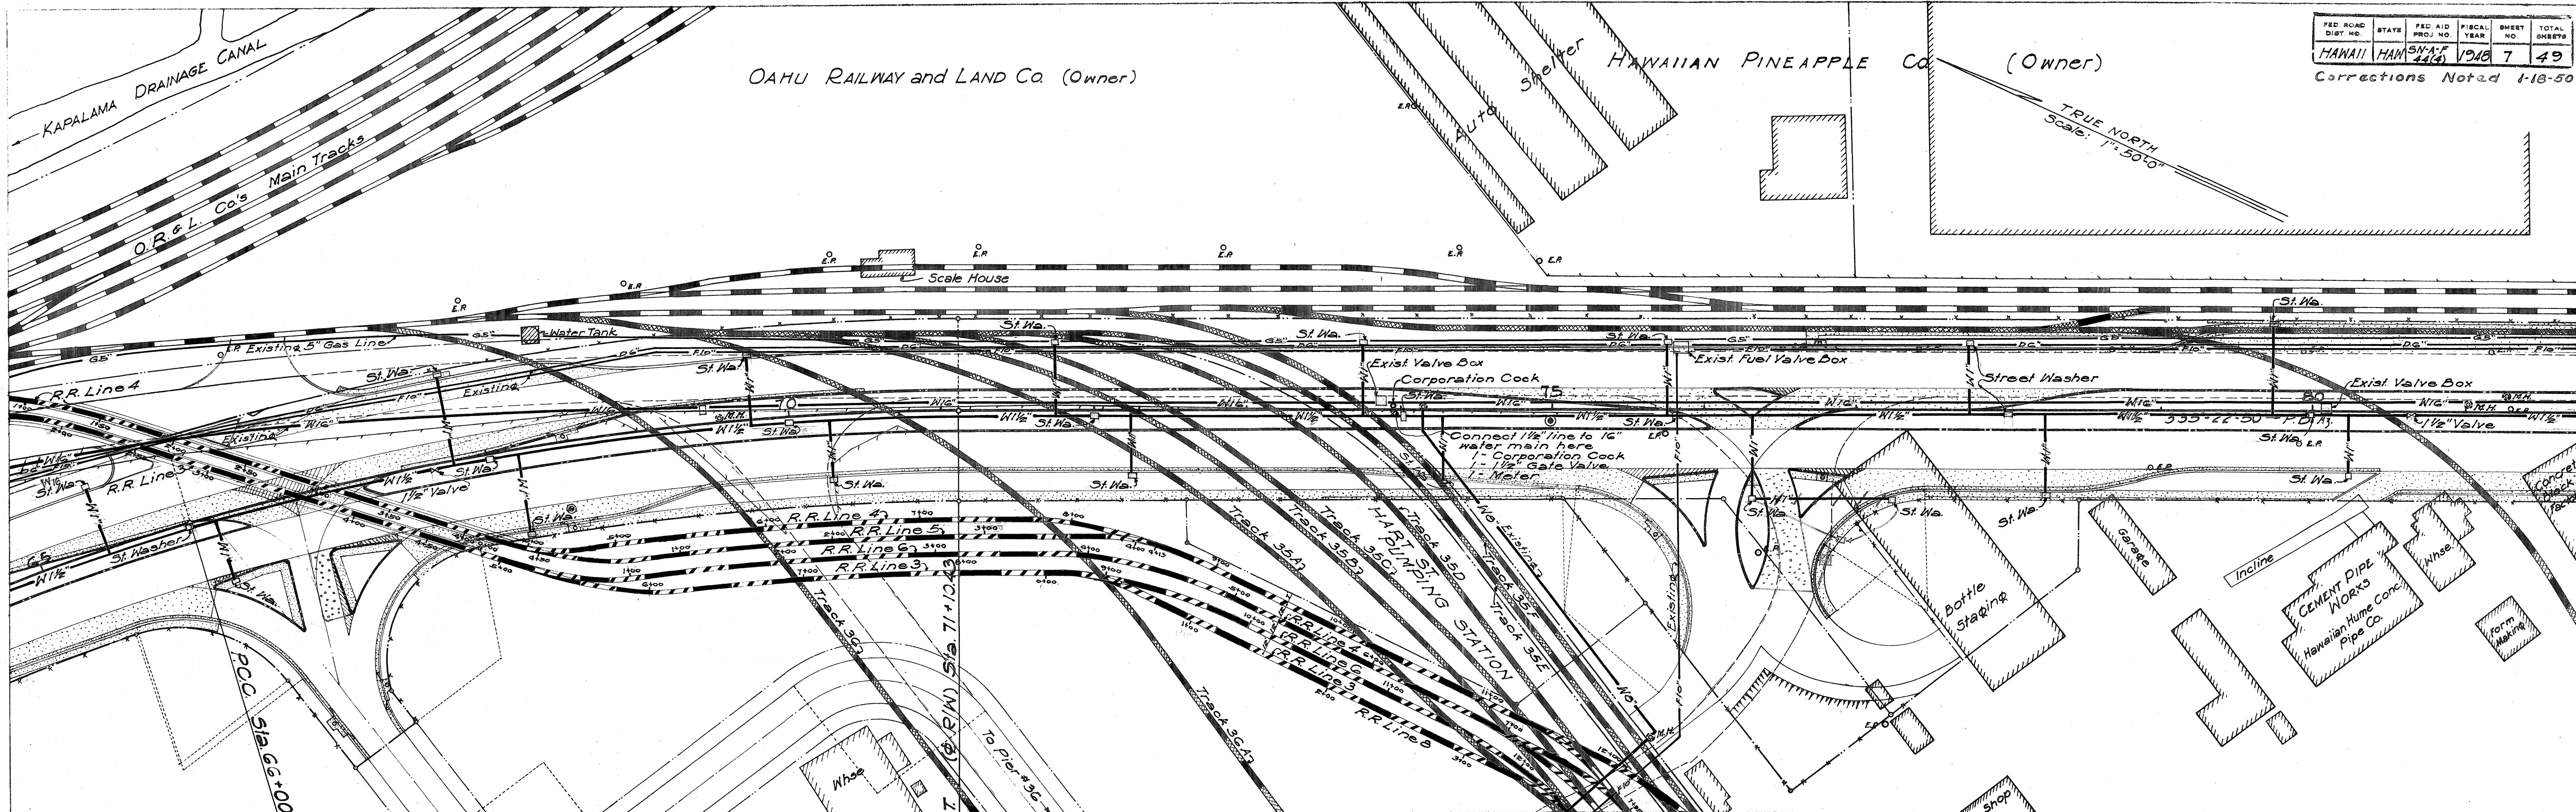


|                     |        |                    |             |           |              |
|---------------------|--------|--------------------|-------------|-----------|--------------|
| FED. ROAD DIST. NO. | STATE  | FED. AID PROJ. NO. | FISCAL YEAR | SHEET NO. | TOTAL SHEETS |
| HAWAII              | HAWAII | SN-A-F 44(A)       | 1948        | 7         | 49           |

Corrections Noted 1-18-50


|         |      |
|---------|------|
| PROFILE | DATE |
| NO. 1   | 1947 |
| NO. 2   | 1947 |
| NO. 3   | 1947 |
| NO. 4   | 1947 |
| NO. 5   | 1947 |
| NO. 6   | 1947 |
| NO. 7   | 1947 |
| NO. 8   | 1947 |
| NO. 9   | 1947 |
| NO. 10  | 1947 |
| NO. 11  | 1947 |
| NO. 12  | 1947 |
| NO. 13  | 1947 |

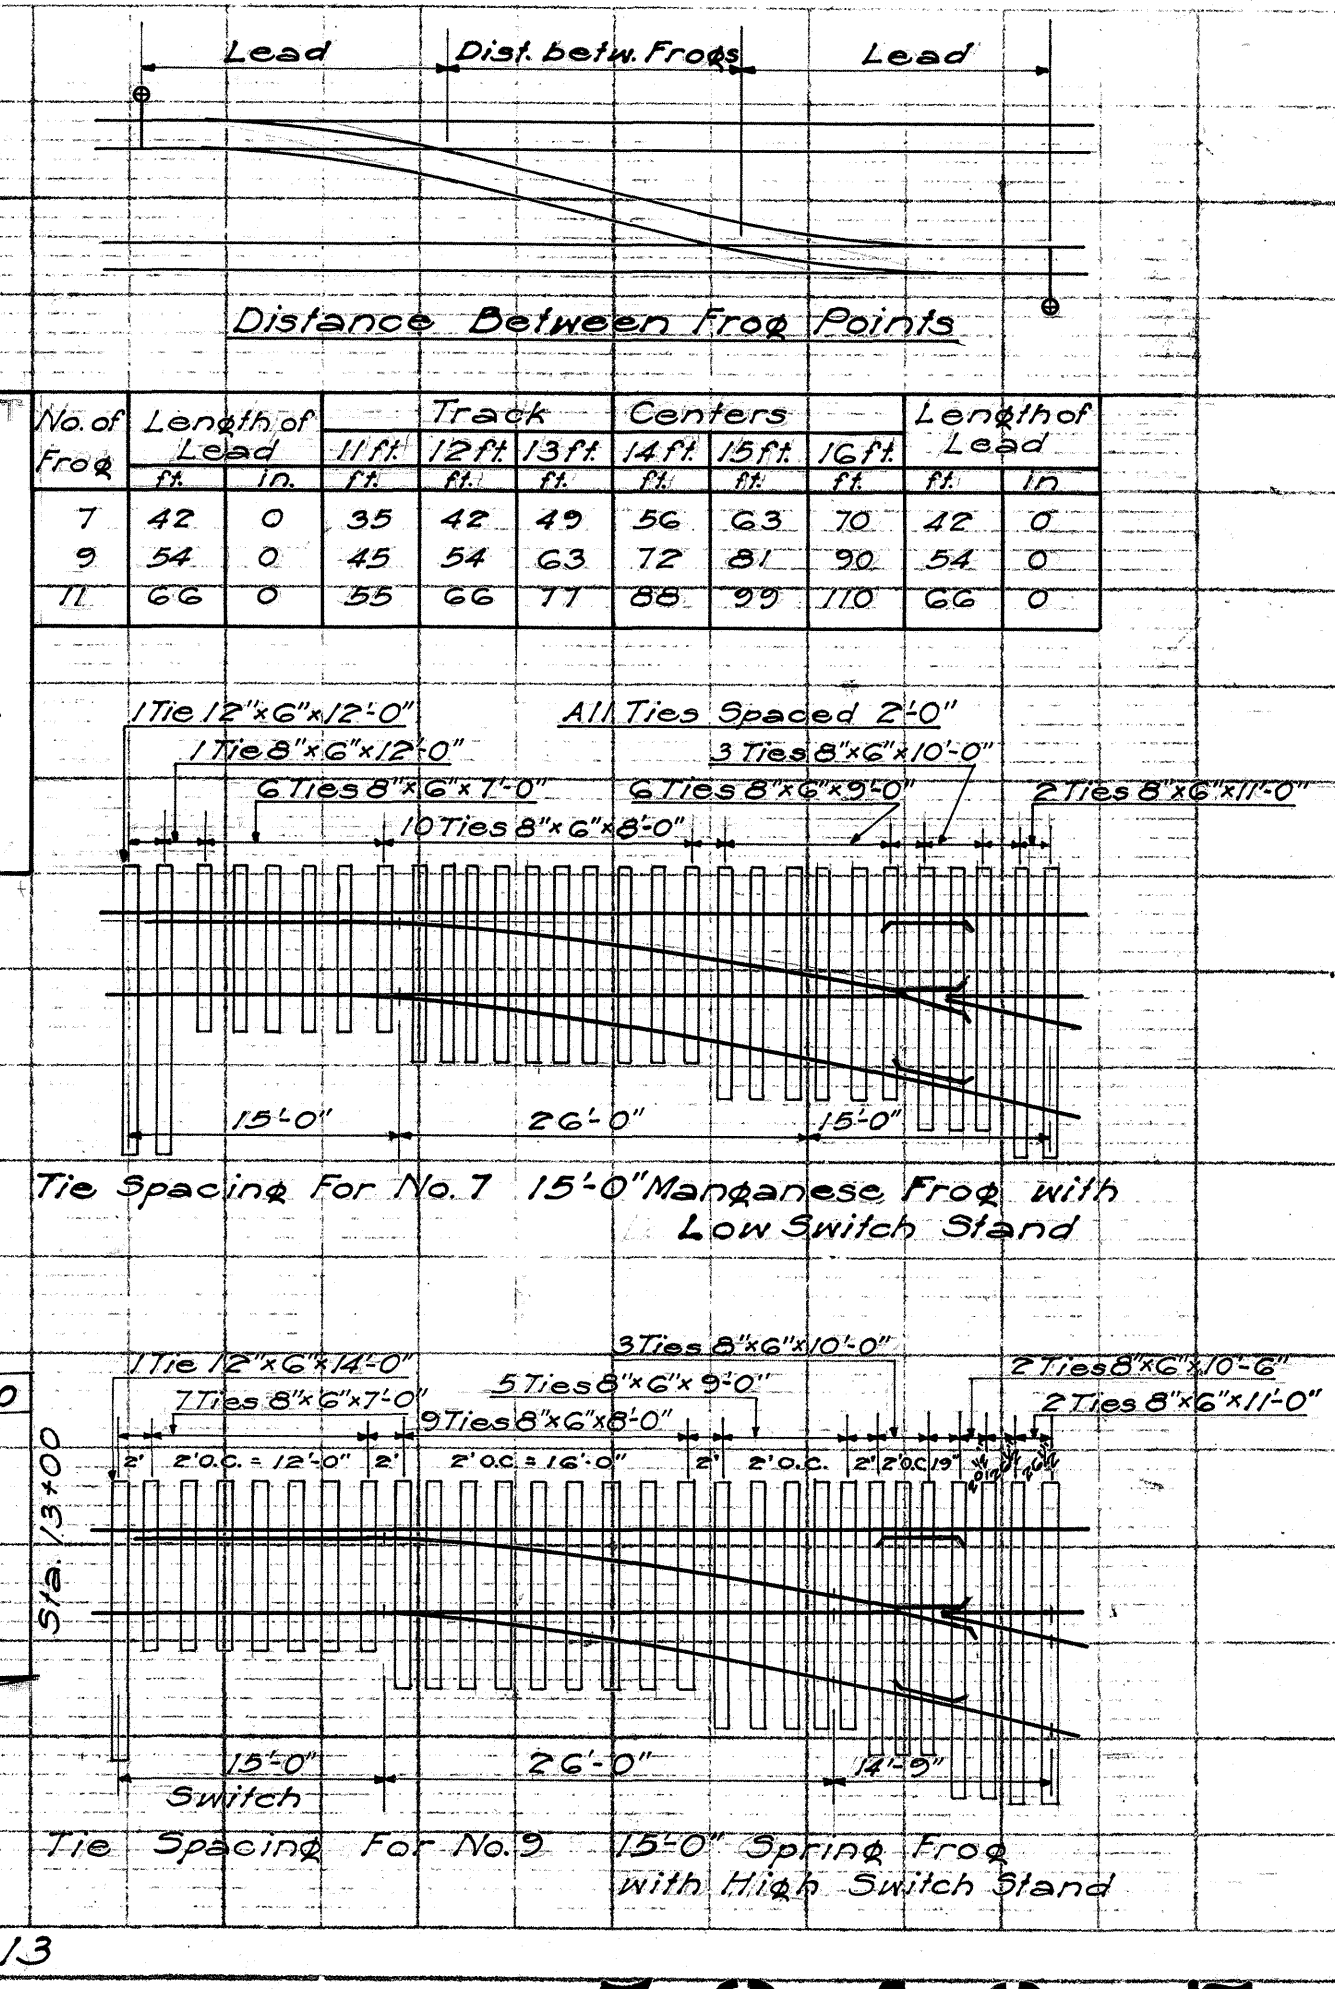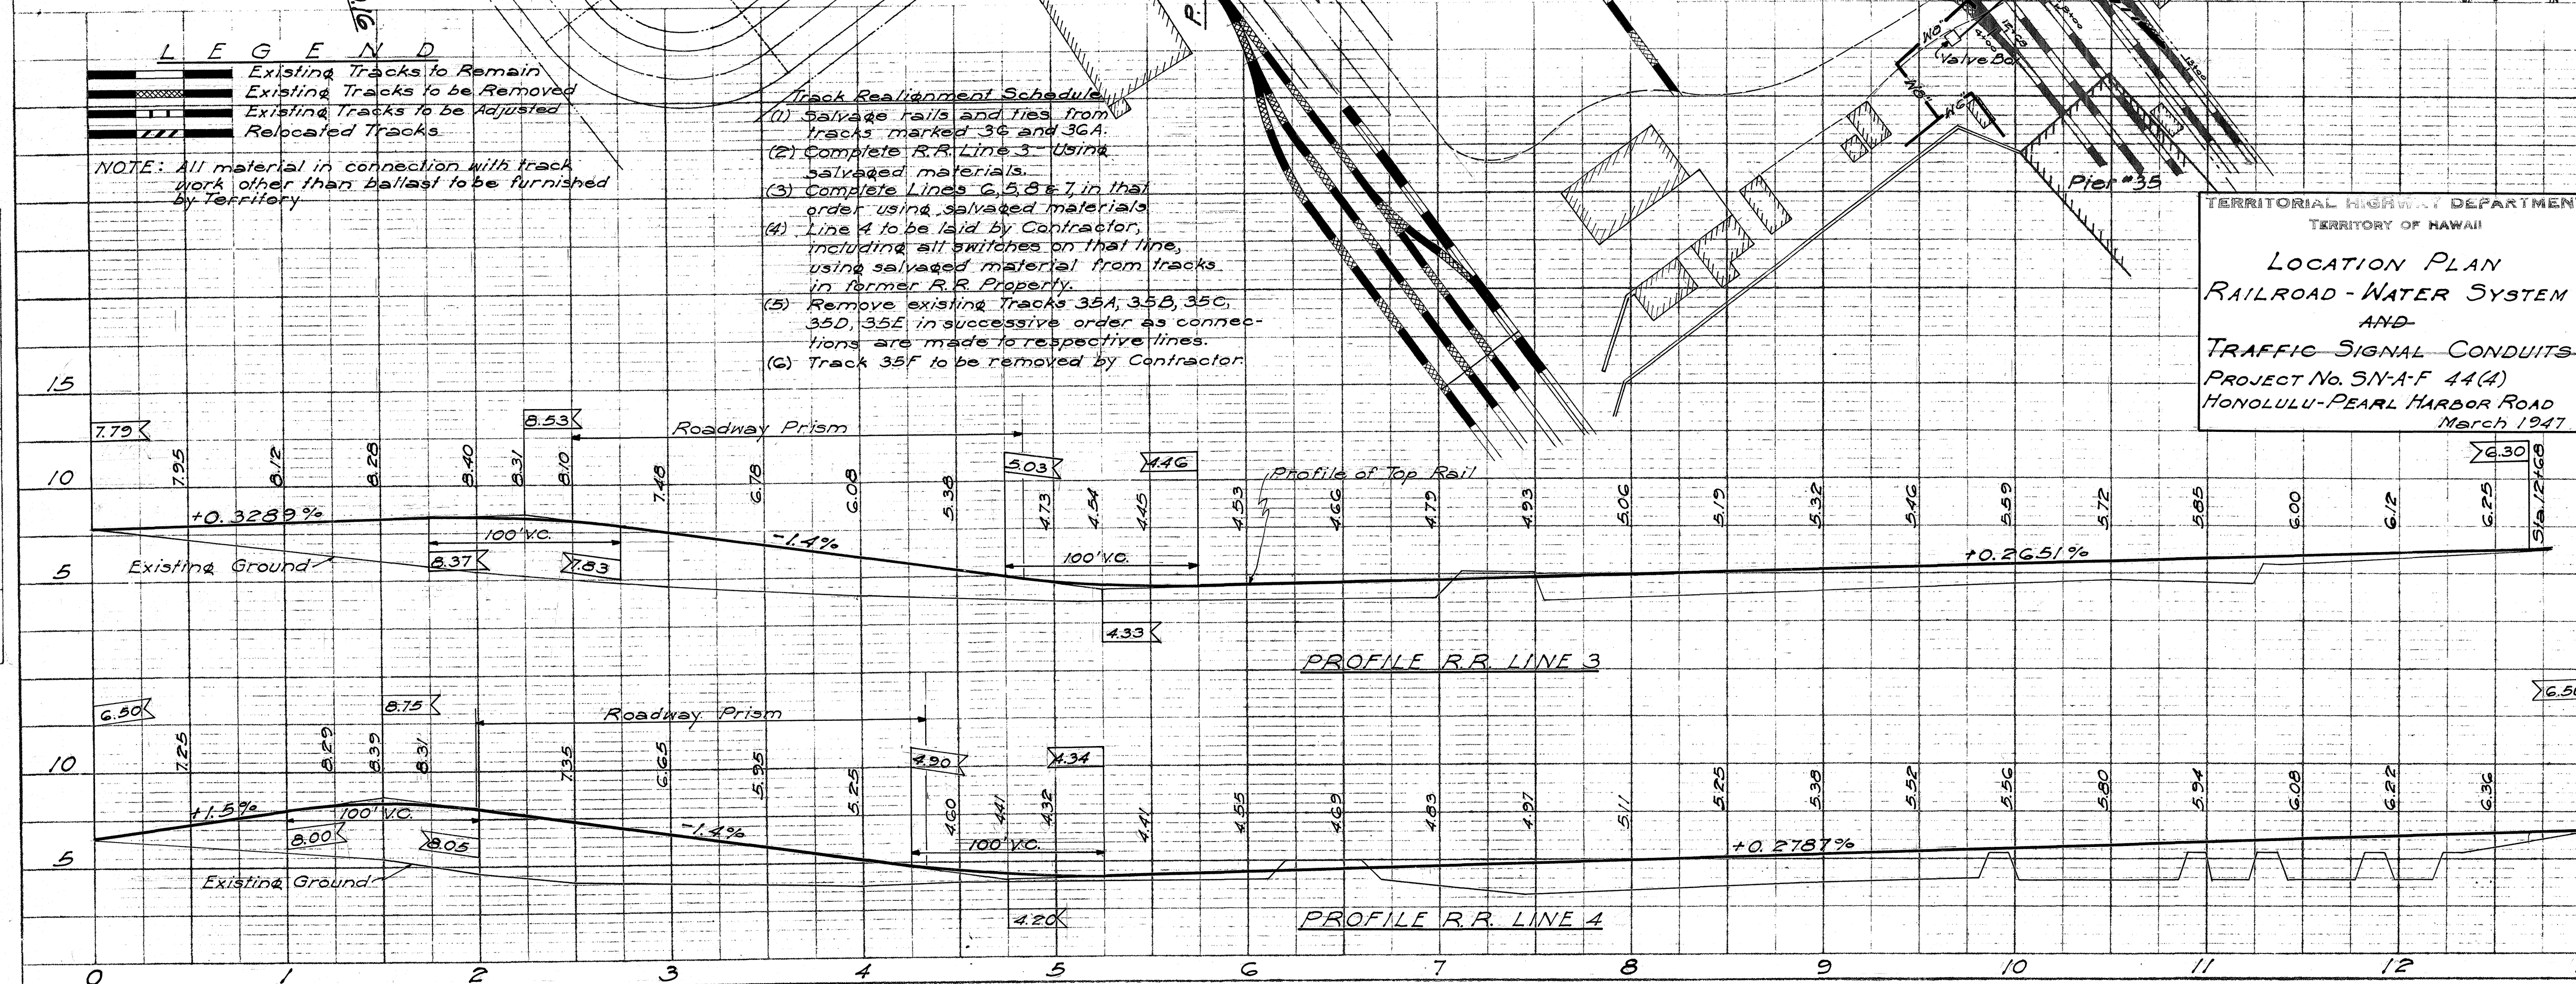

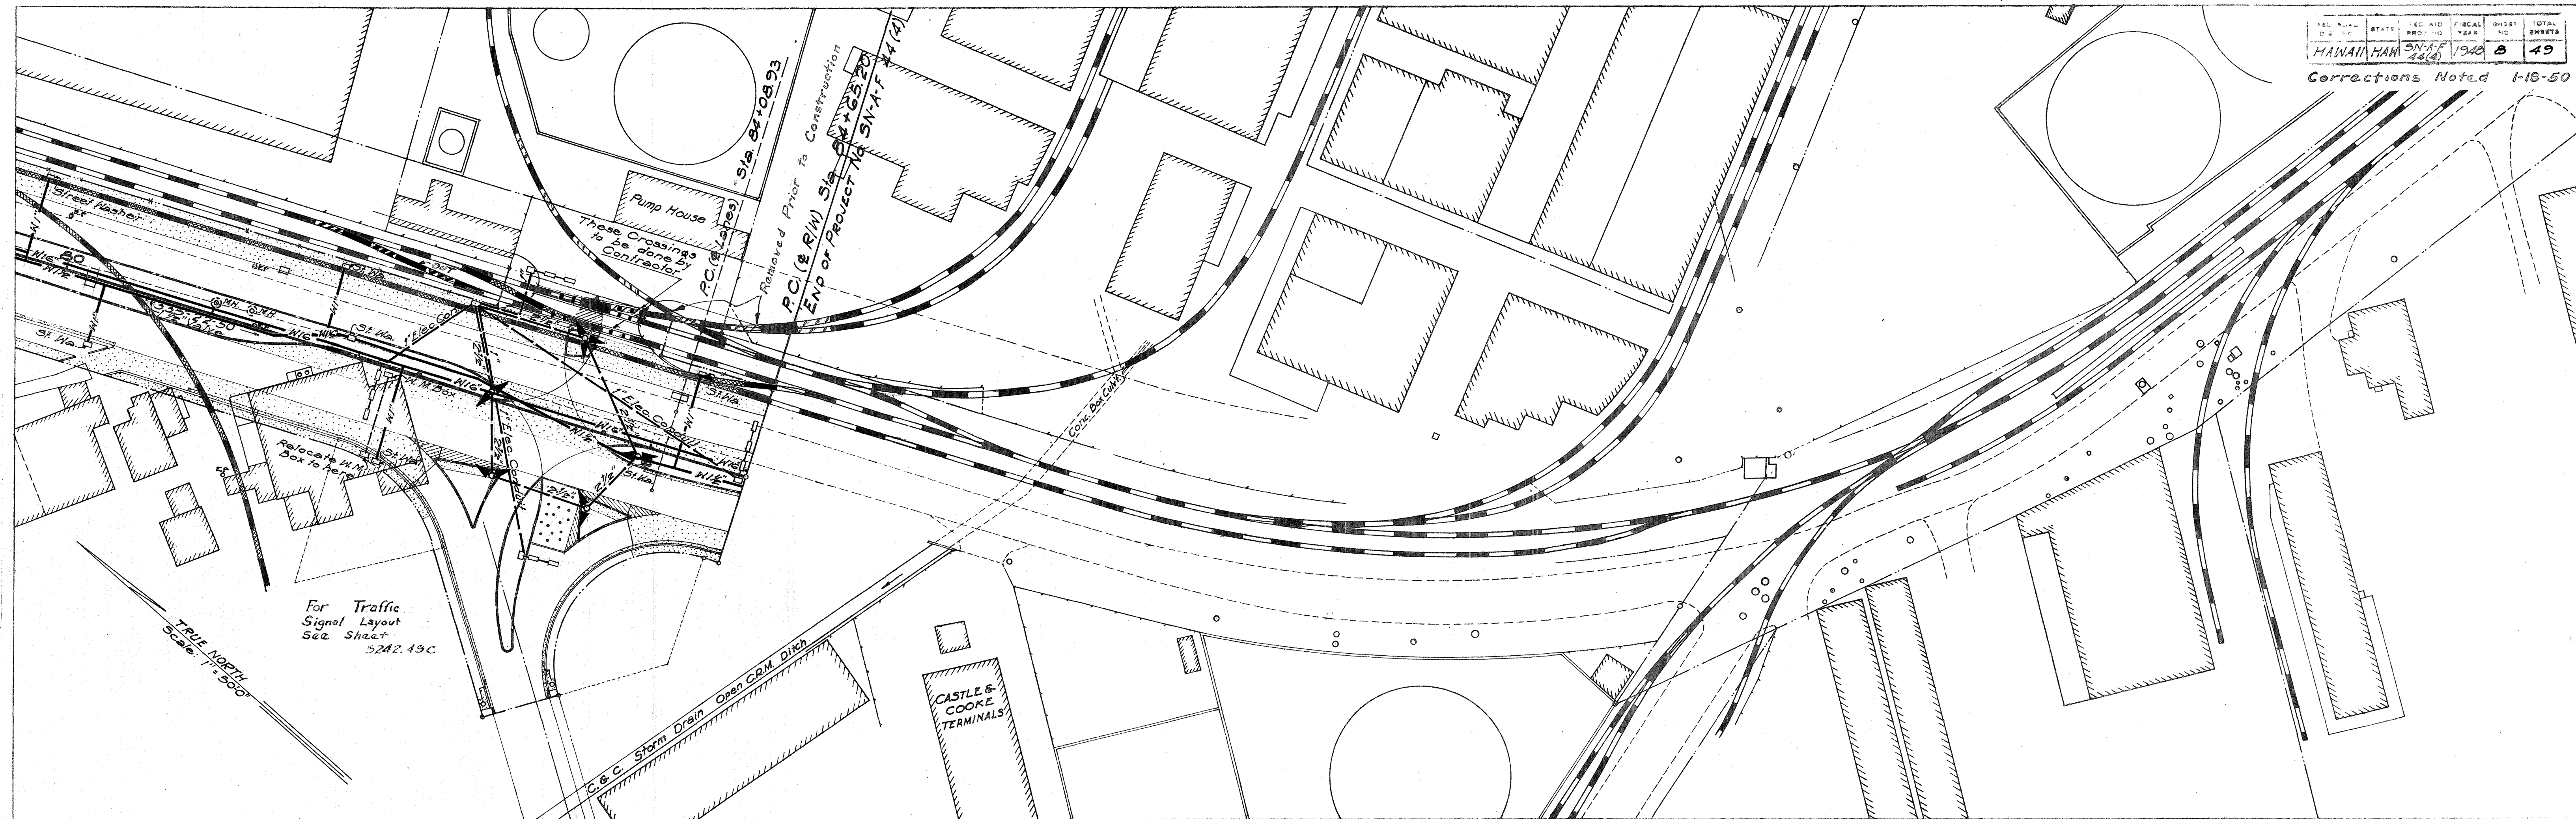

**LEGEND**

- Existing Tracks to Remain
- Existing Tracks to be Removed
- Existing Tracks to be Adjusted
- Relocated Tracks

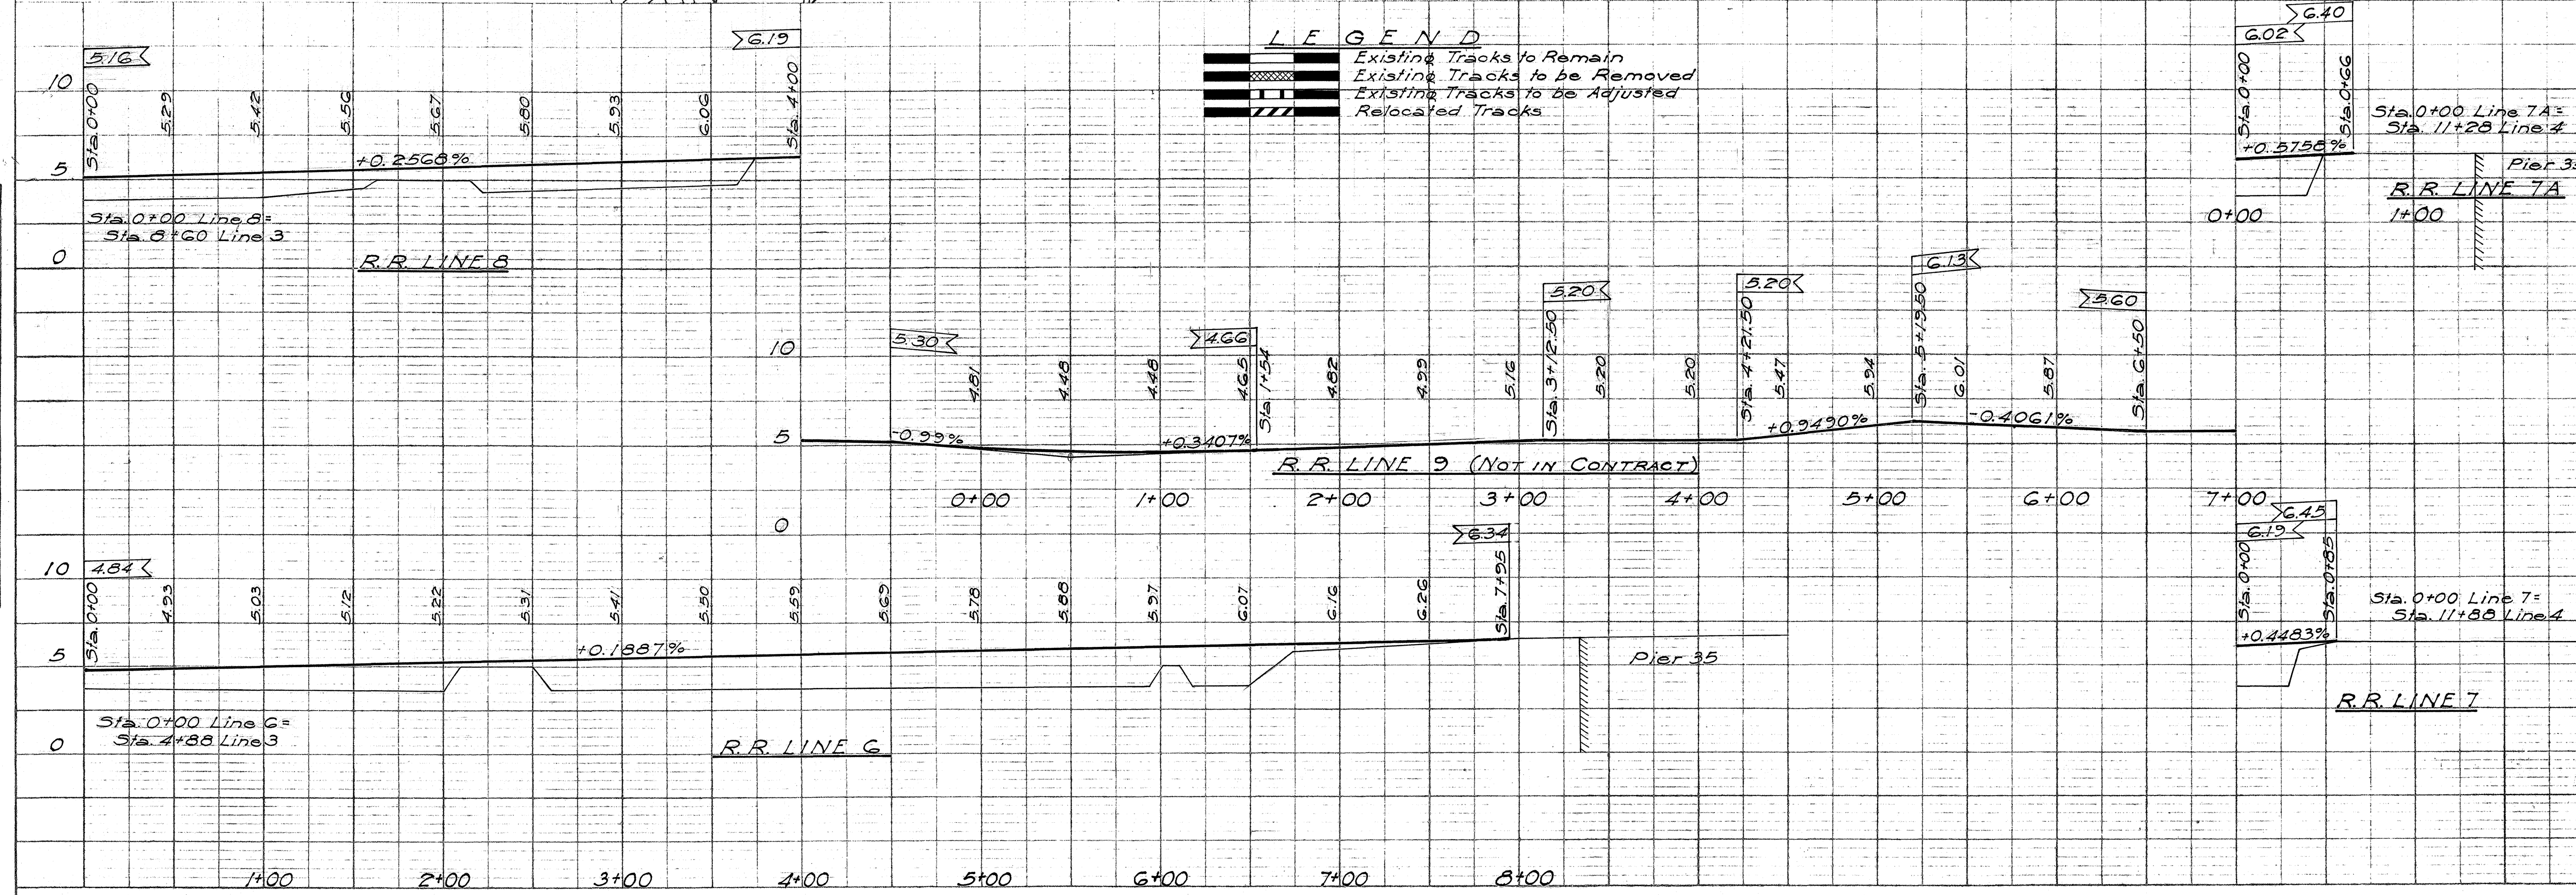

TERRITORIAL HIGHWAY DEPARTMENT  
 TERRITORY OF HAWAII  
**LOCATION PLAN**  
**RAILROAD - WATER SYSTEM**  
**AND**  
**TRAFFIC SIGNAL CONDUITS**  
 PROJECT No. SN-A-F 44(4)  
 HONOLULU-PEARL HARBOR ROAD  
 March 1947