

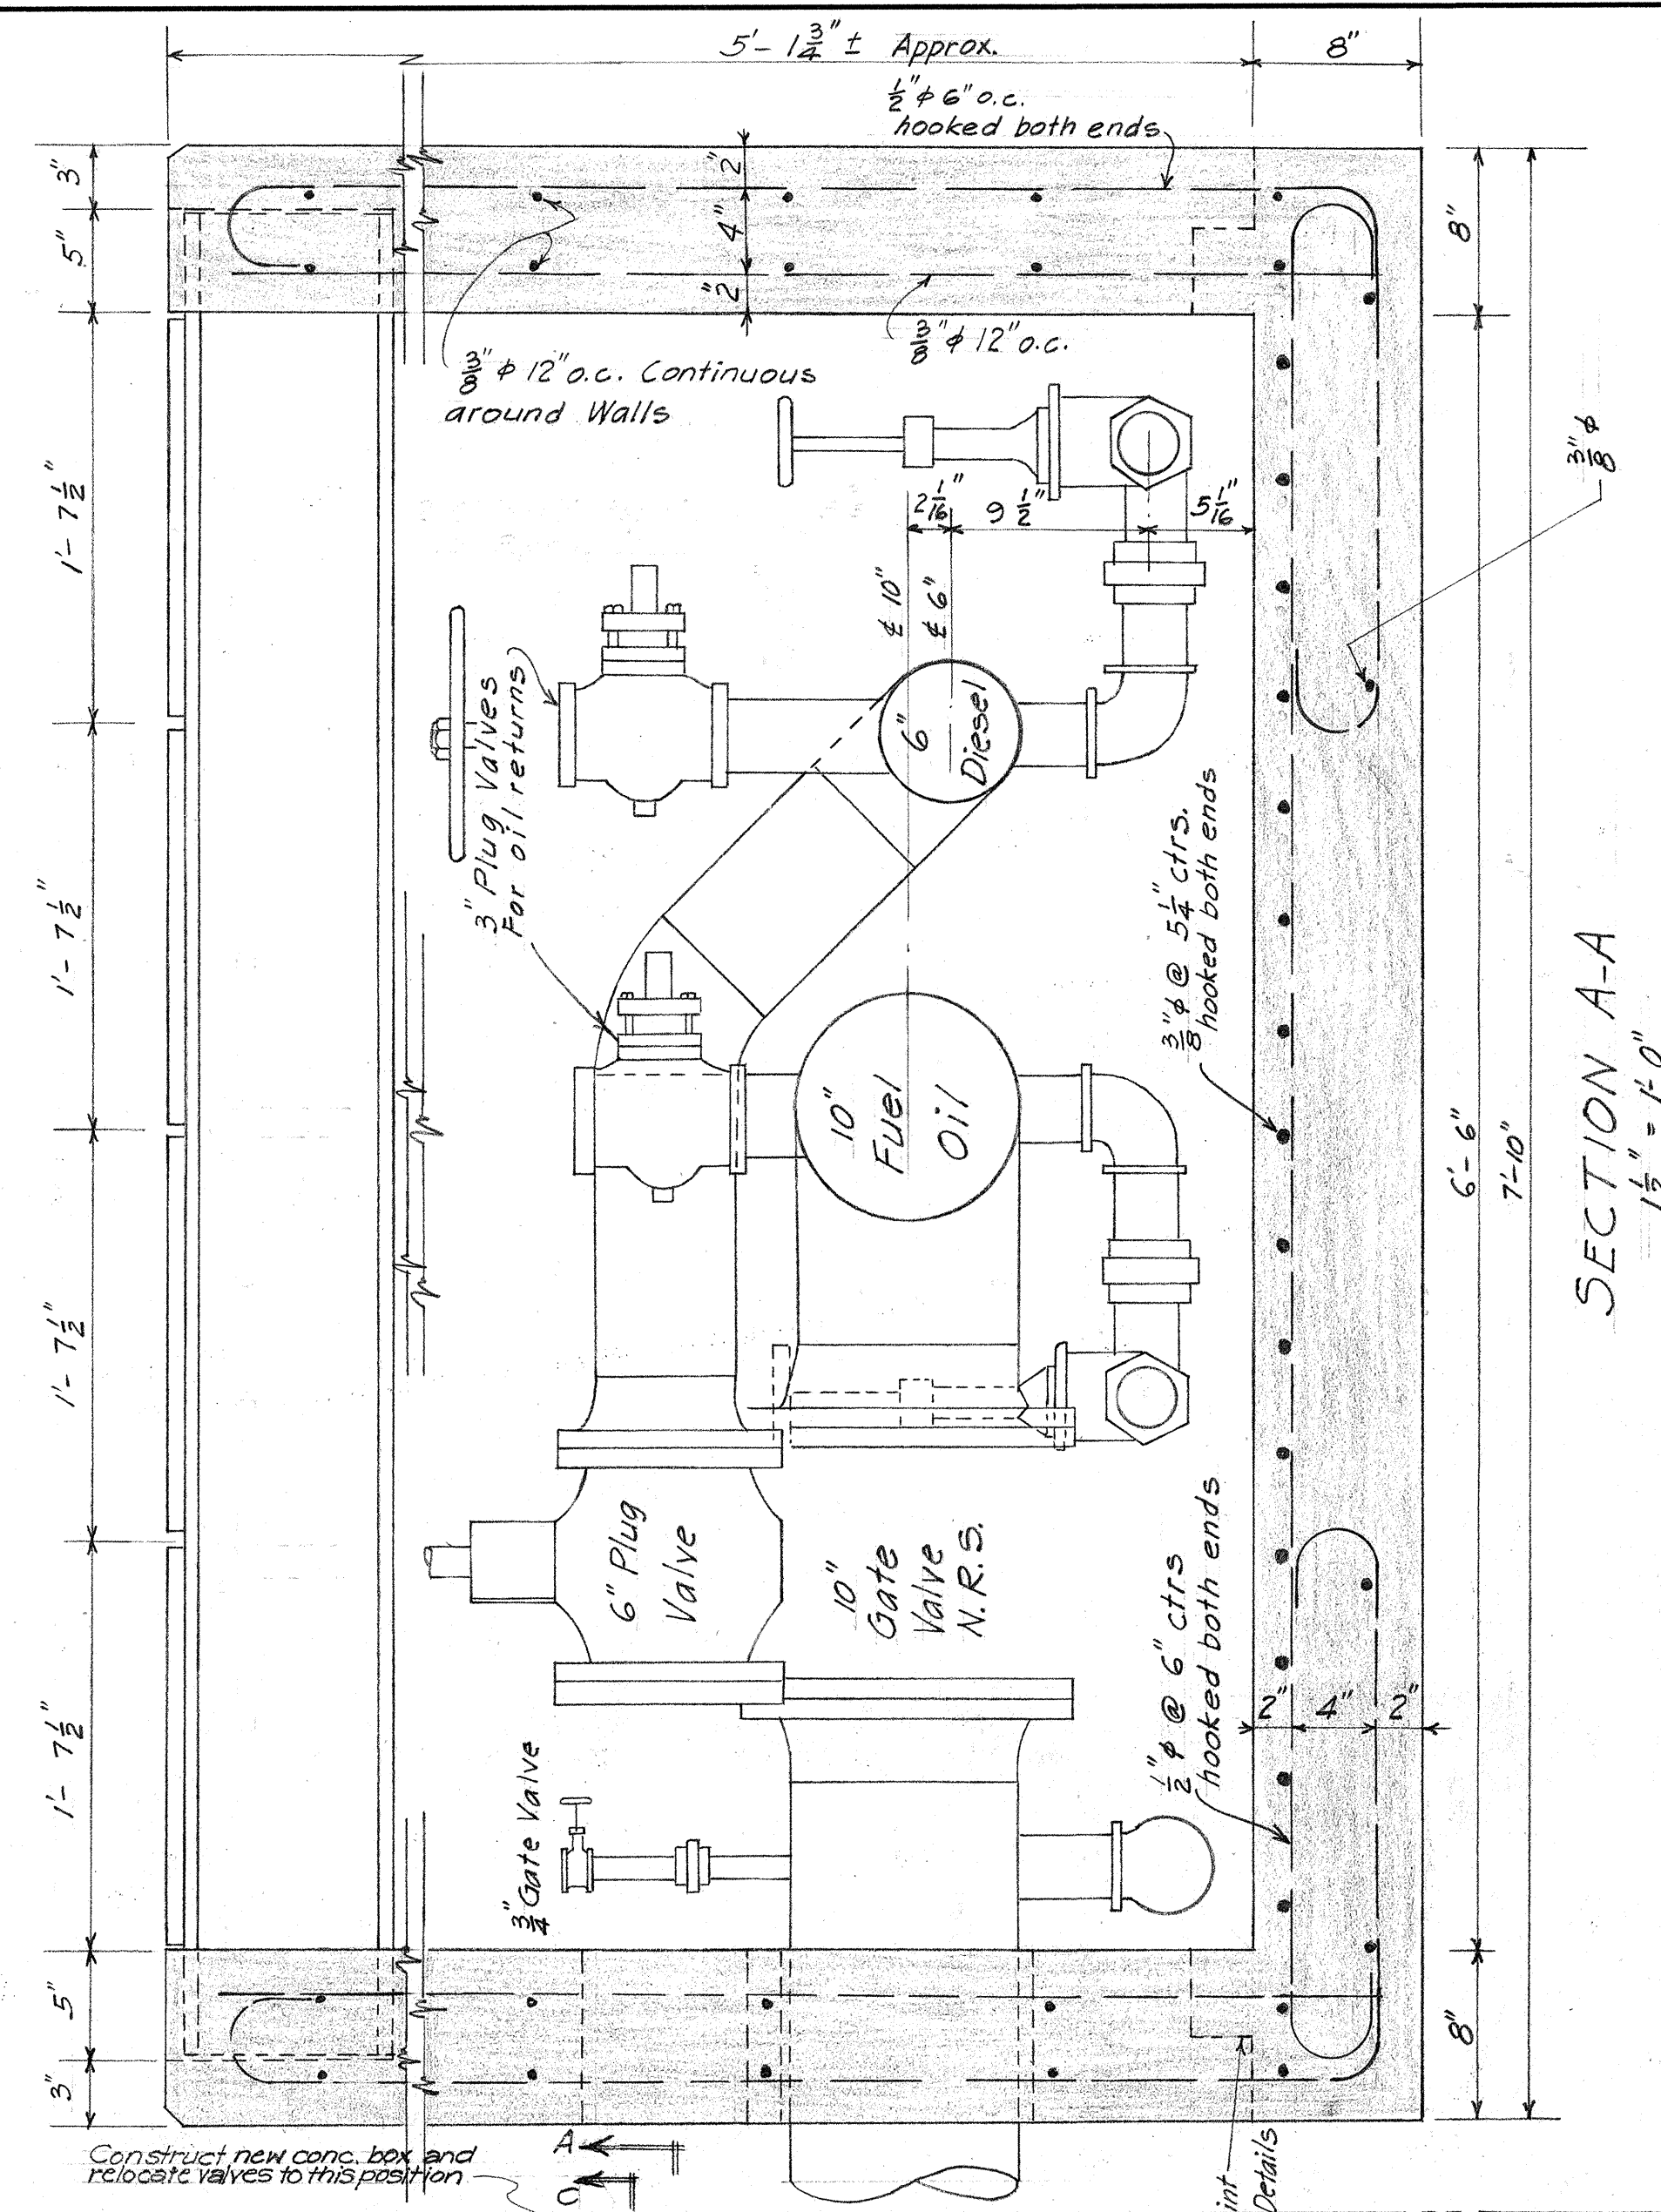


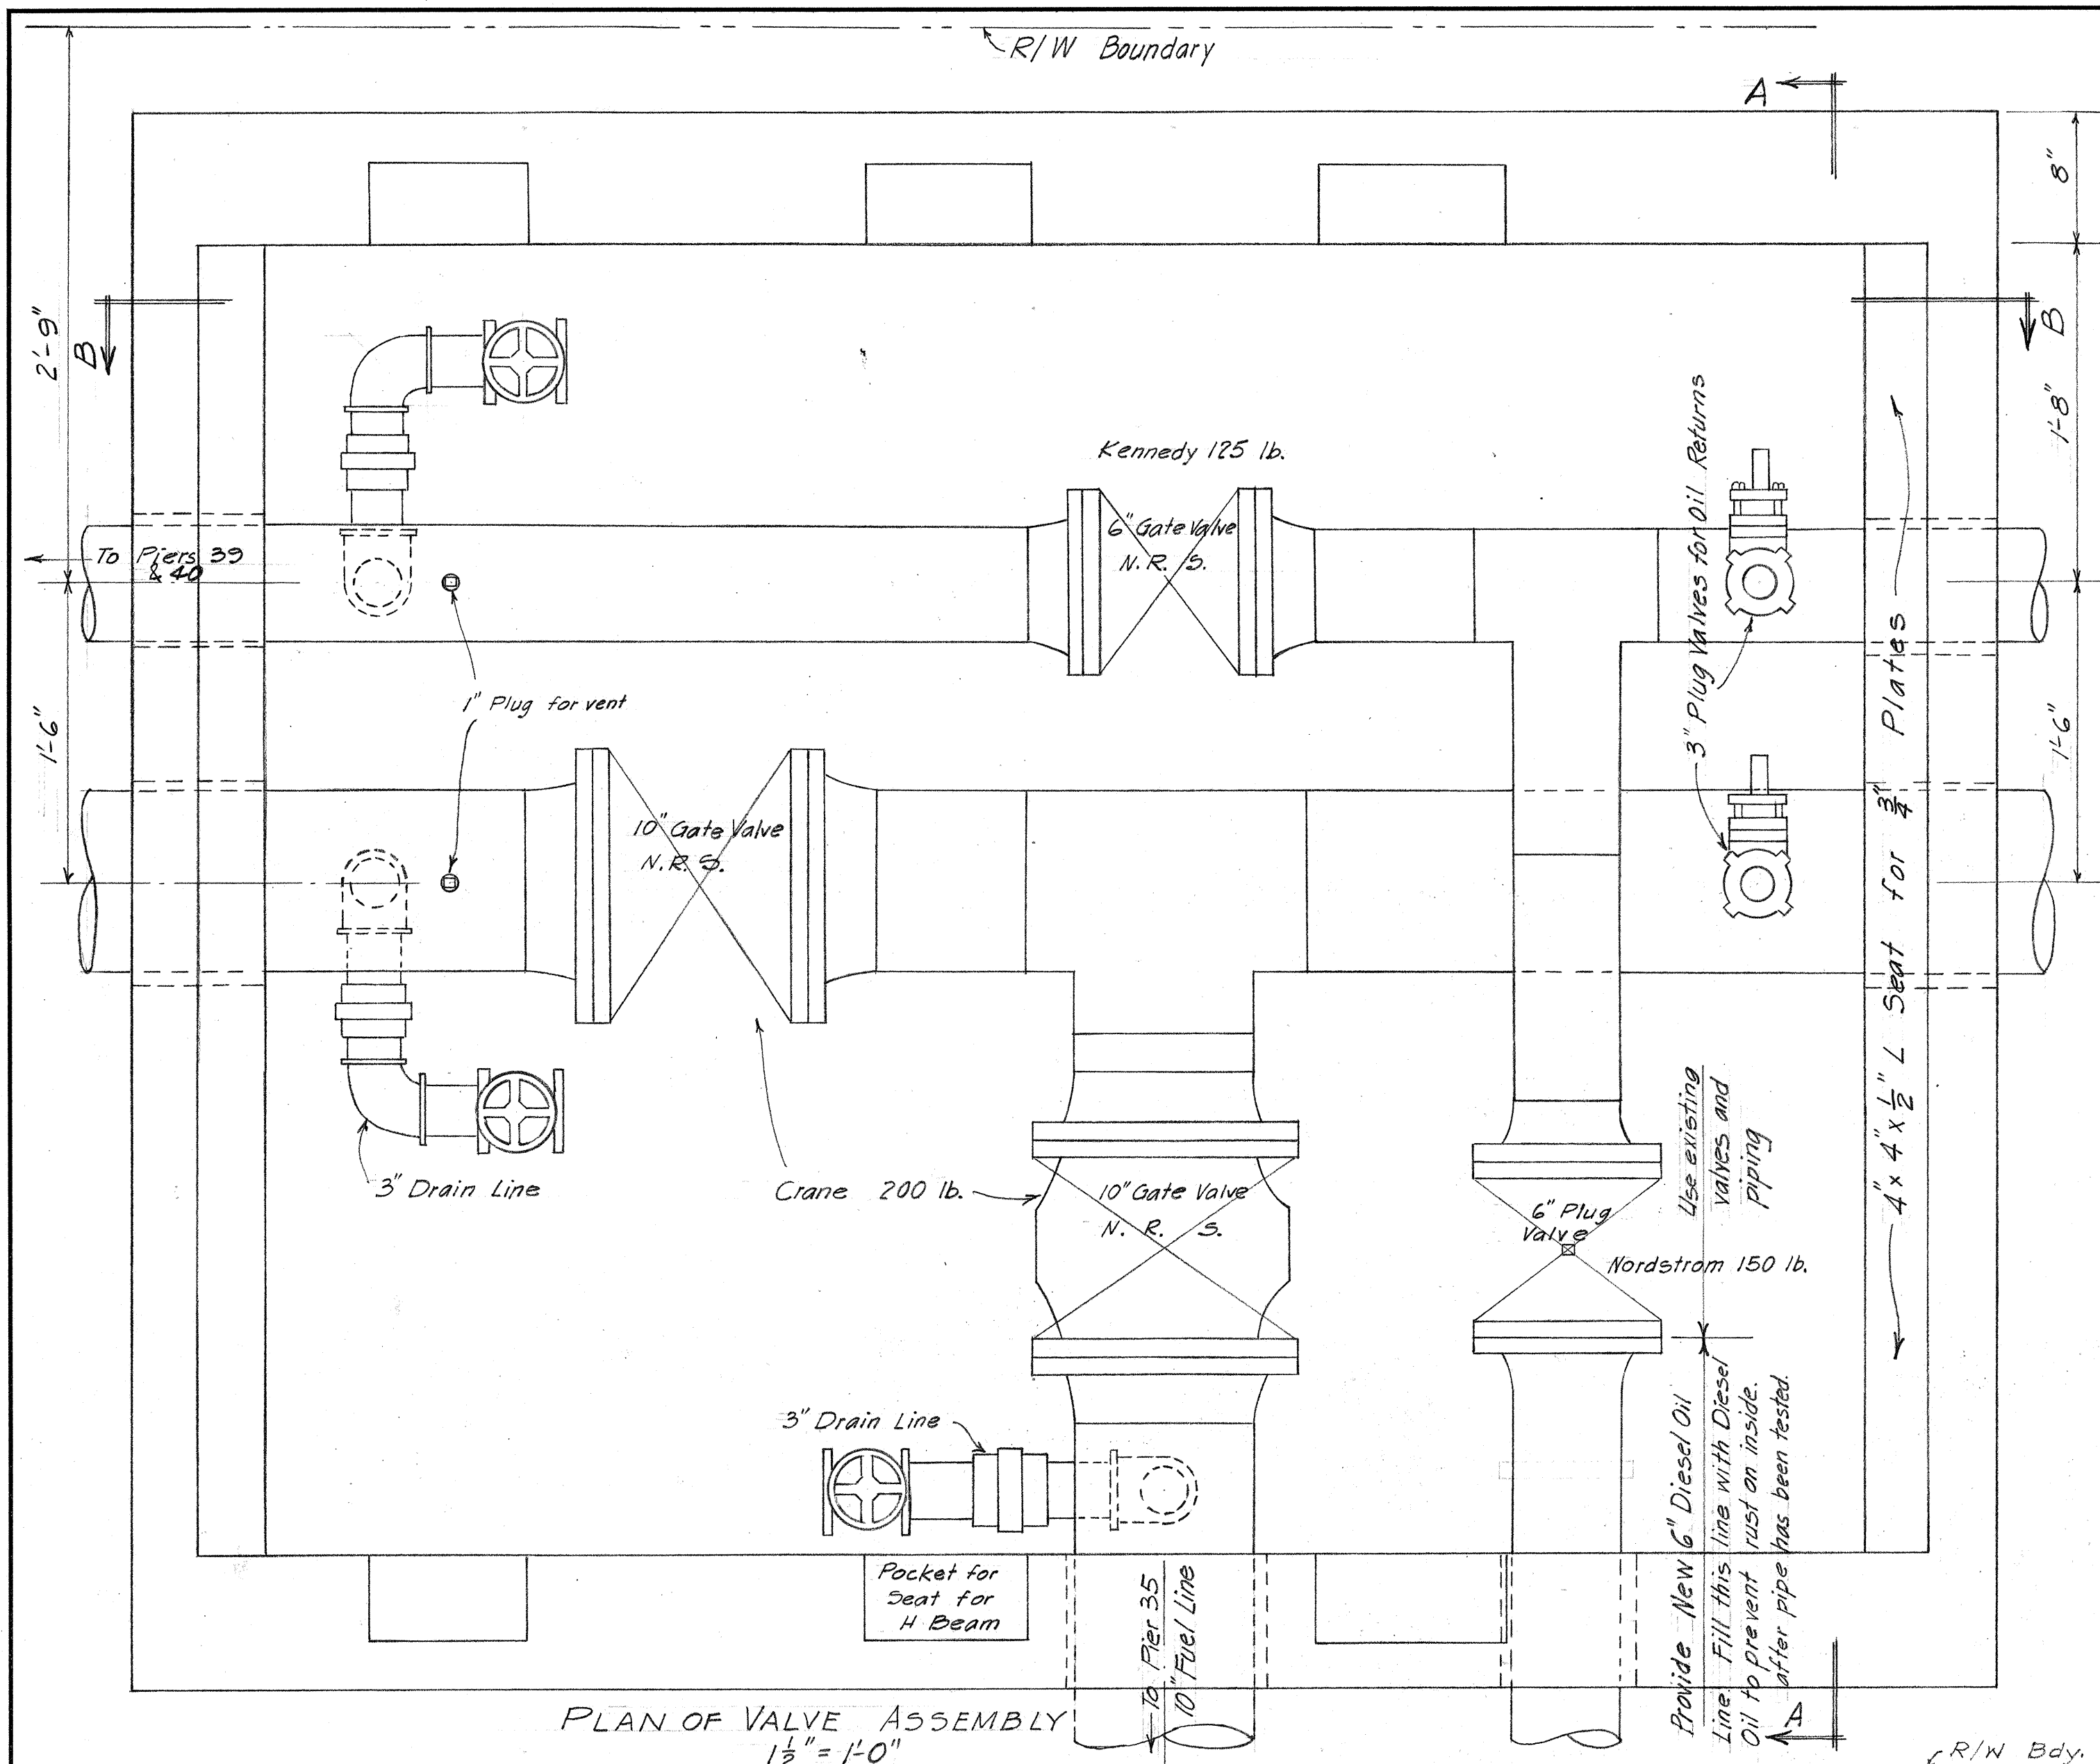

Corrections Noted 1-18-50

FED. ROAD DIST. NO.	STATE	FED. AID PROJ. NO.	FISCAL YEAR	SHEET NO.	TOTAL SHEETS
Hawaii	Haw.	SNAF-444	1948	24	49

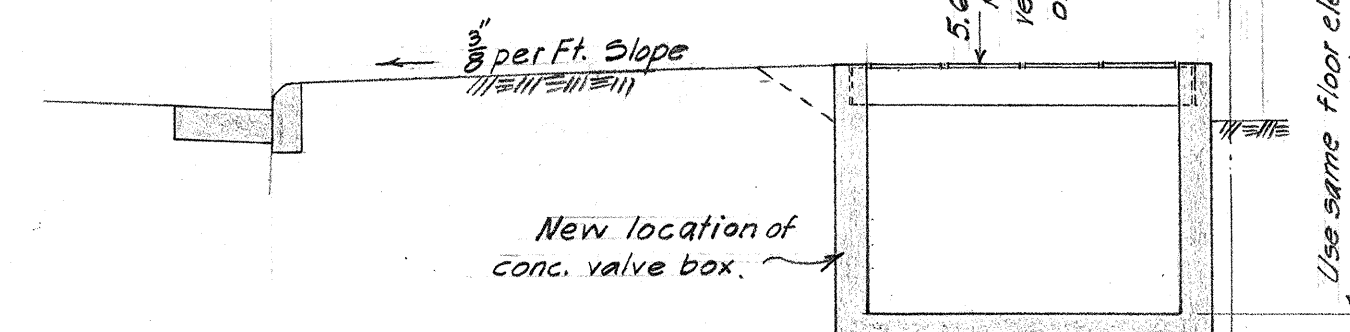



SECTION C-C
1/4" = 1'-0"

Note! The Contractor shall make necessary arrangement with The A.G.F. PAC. Utility Section U.S. Army for the most convenient time to close the 6" and 10" fuel oil lines.

The work involved in relocating the lines and valve box to their new positions will be paid for as a unit except the items of Class A-1 Concrete and Reinforcing Steel which will be paid for by their appropriate items.

The existing H beam sections and plate cover shall be reused.

Present pipe is spiral welded pipe with beveled ends ready for welding. Flanges are steel welding neck flanges. Gaskets shall be Corrugated Copper and Asbestos fitting inside the bolt circle.

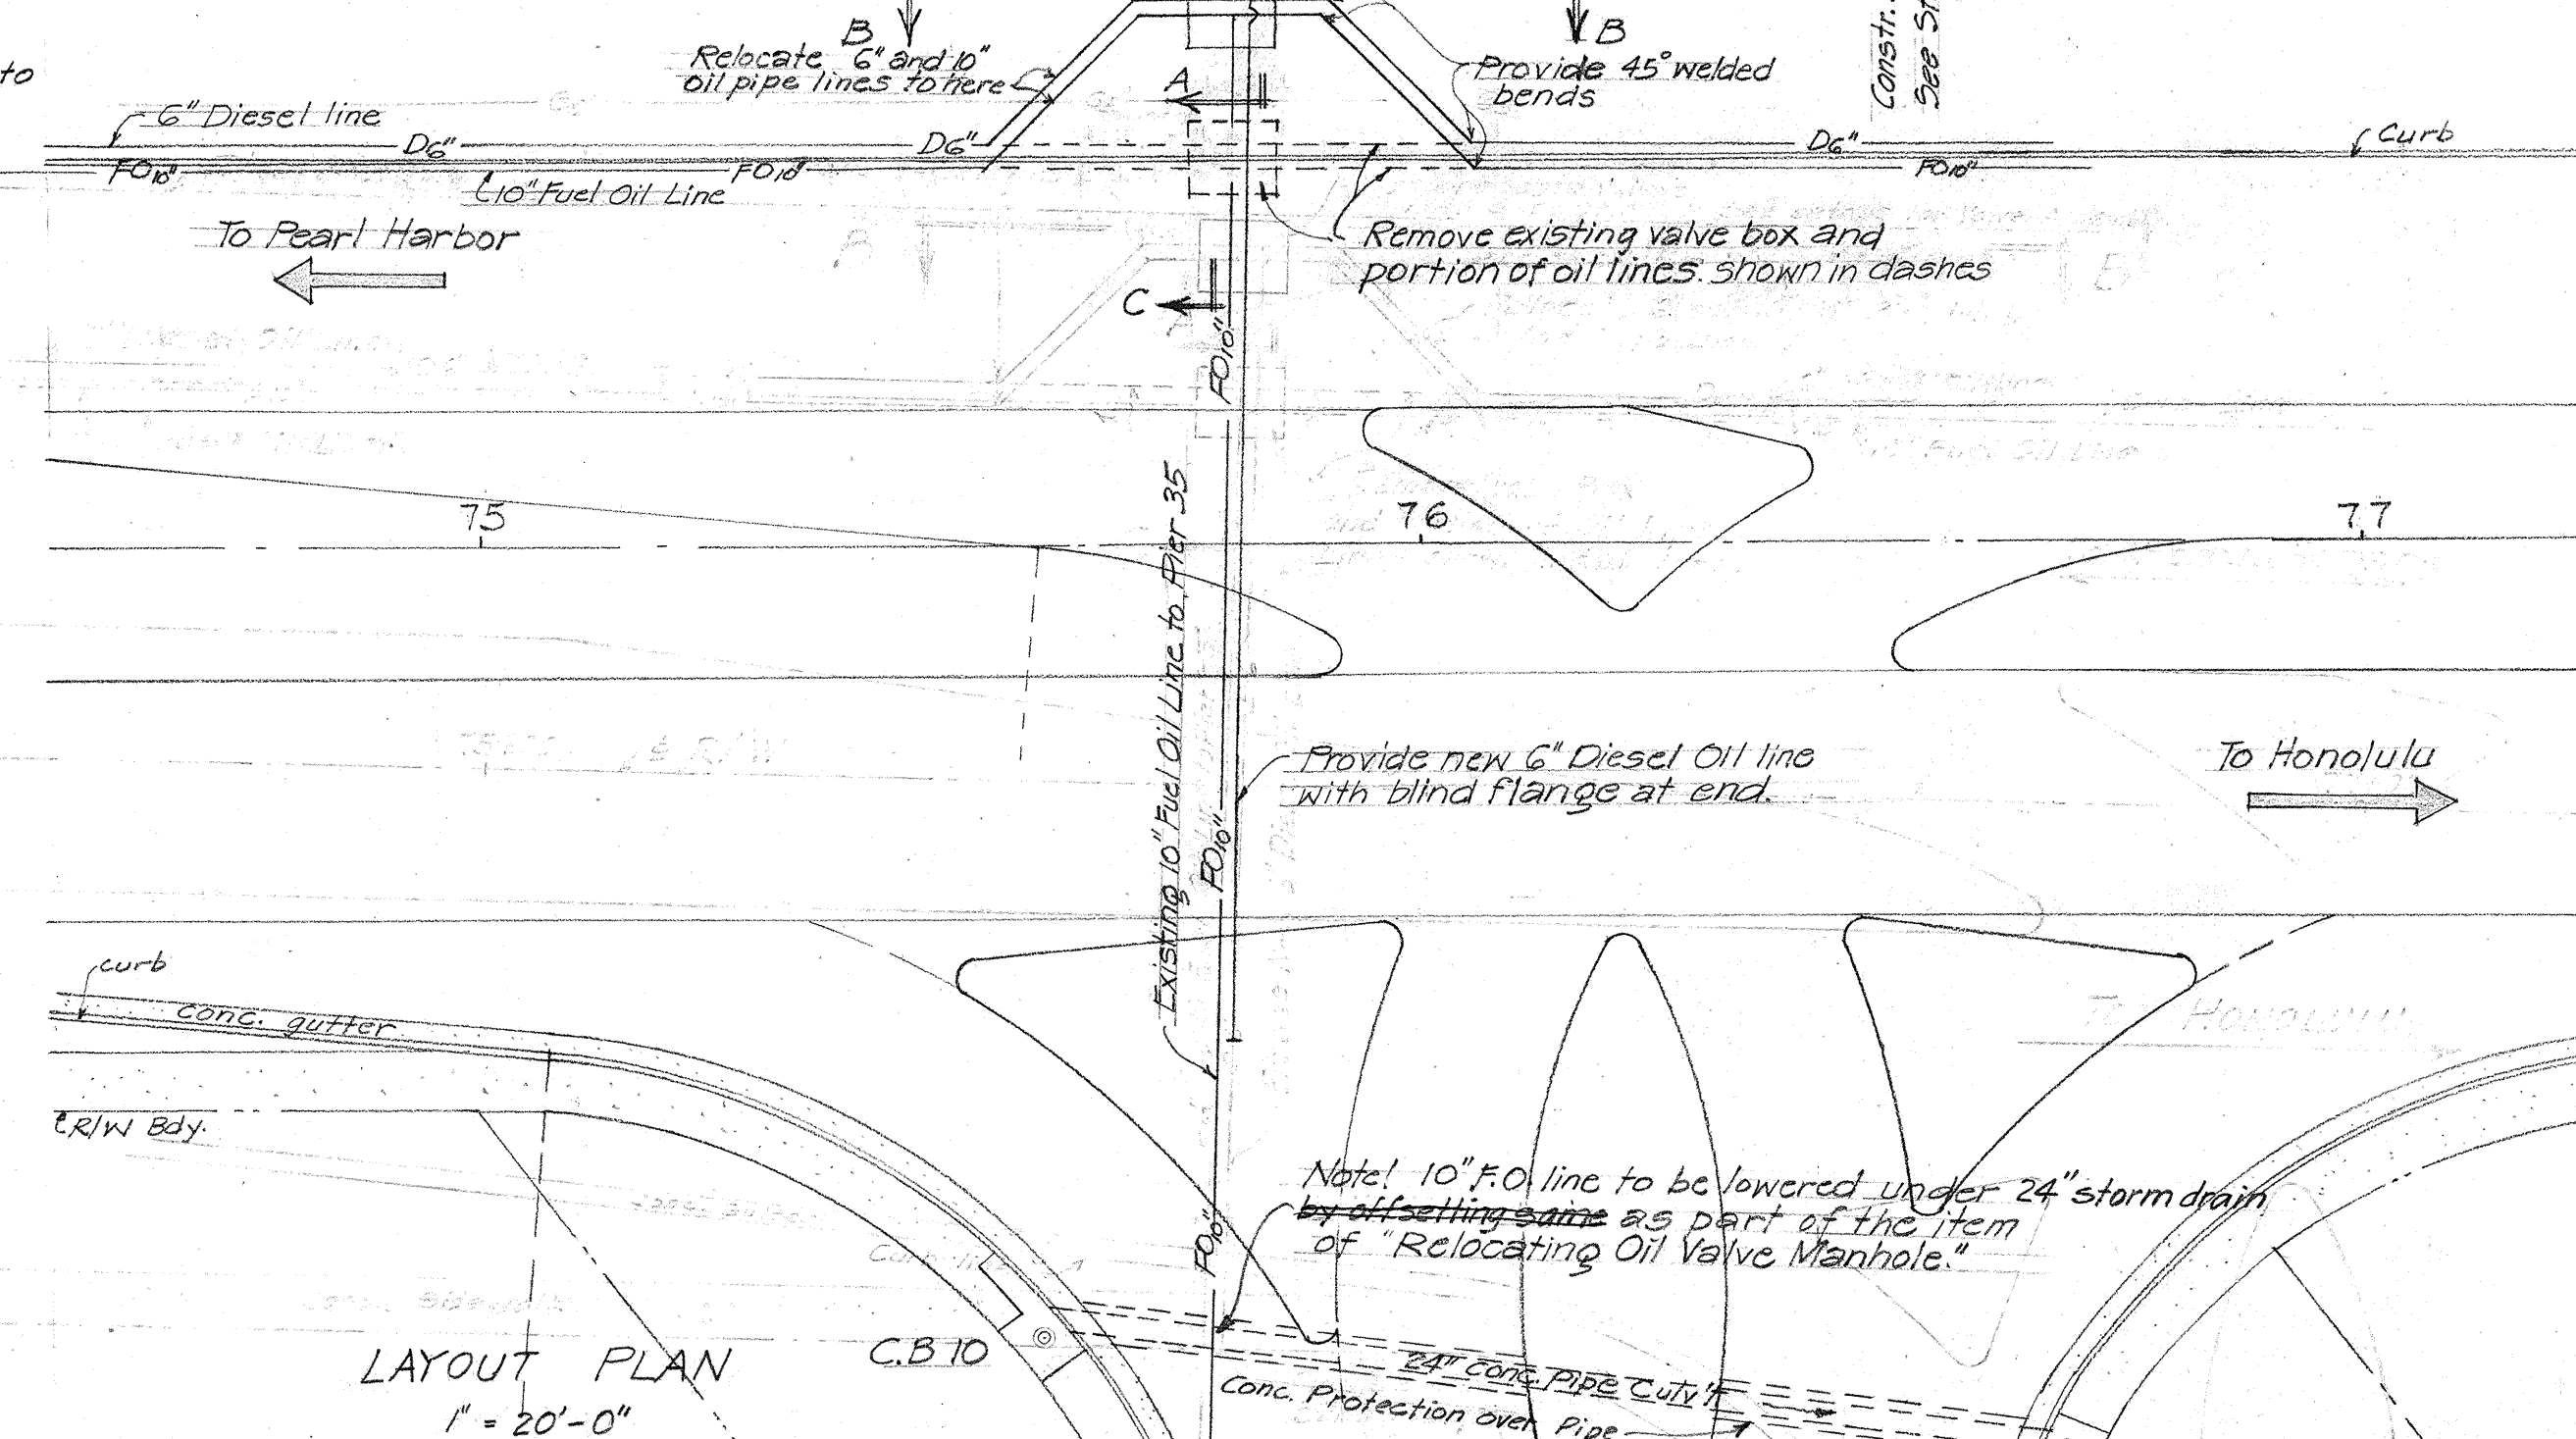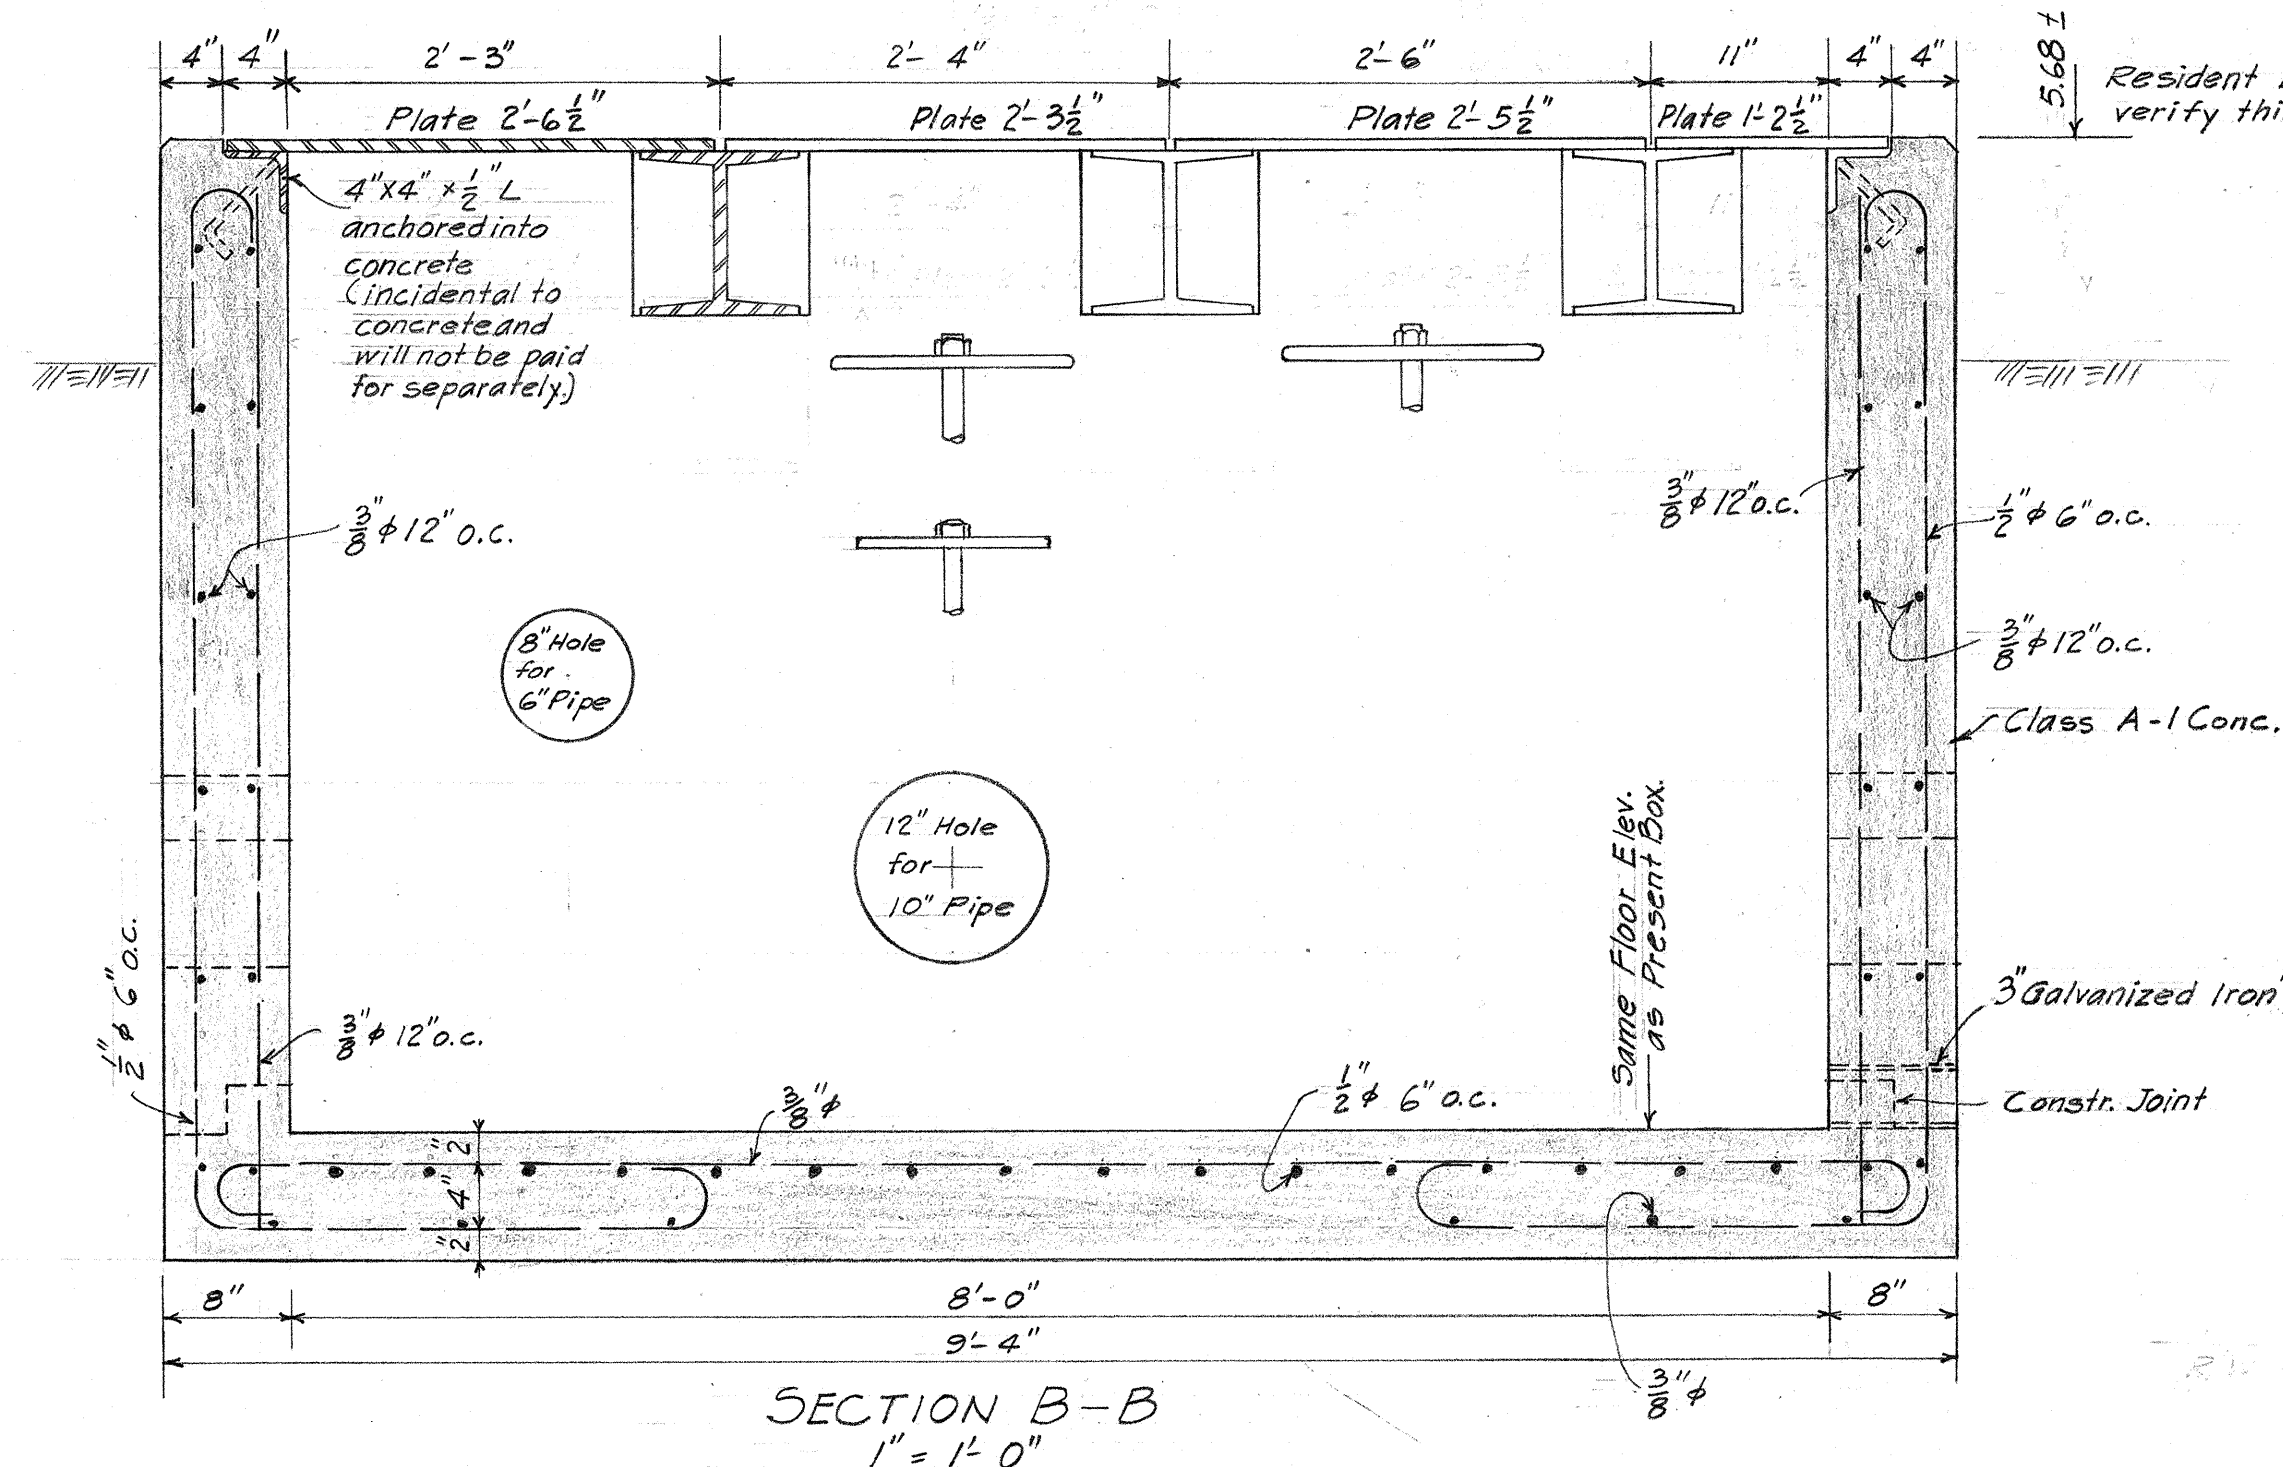

ESTIMATED QUANTITIES

Class A-1 Conc. other than in Bridges 5.70 cu. yds.
Reinforcing Steel other than in Bridges 787 lbs.

TERRITORIAL HIGHWAY DEPARTMENT
TERRITORY OF HAWAII
RELOCATING OIL VALVE MANHOLE
FOR THE 6" & 10" FUEL OIL LINES
STA. 75+80 ±
HONOLULU PEARL HARBOR RD. SNAF-44-(4)
February, 1947

SHEET No. OF SHEETS

5242.24

Correction 11-18-47

DESIGNED BY	DATE
DRAWN BY	
CHECKED BY	
NOTED BY	
QUANTITIES CHECKED BY	
No.	