



Corrections Noted 1-18-50


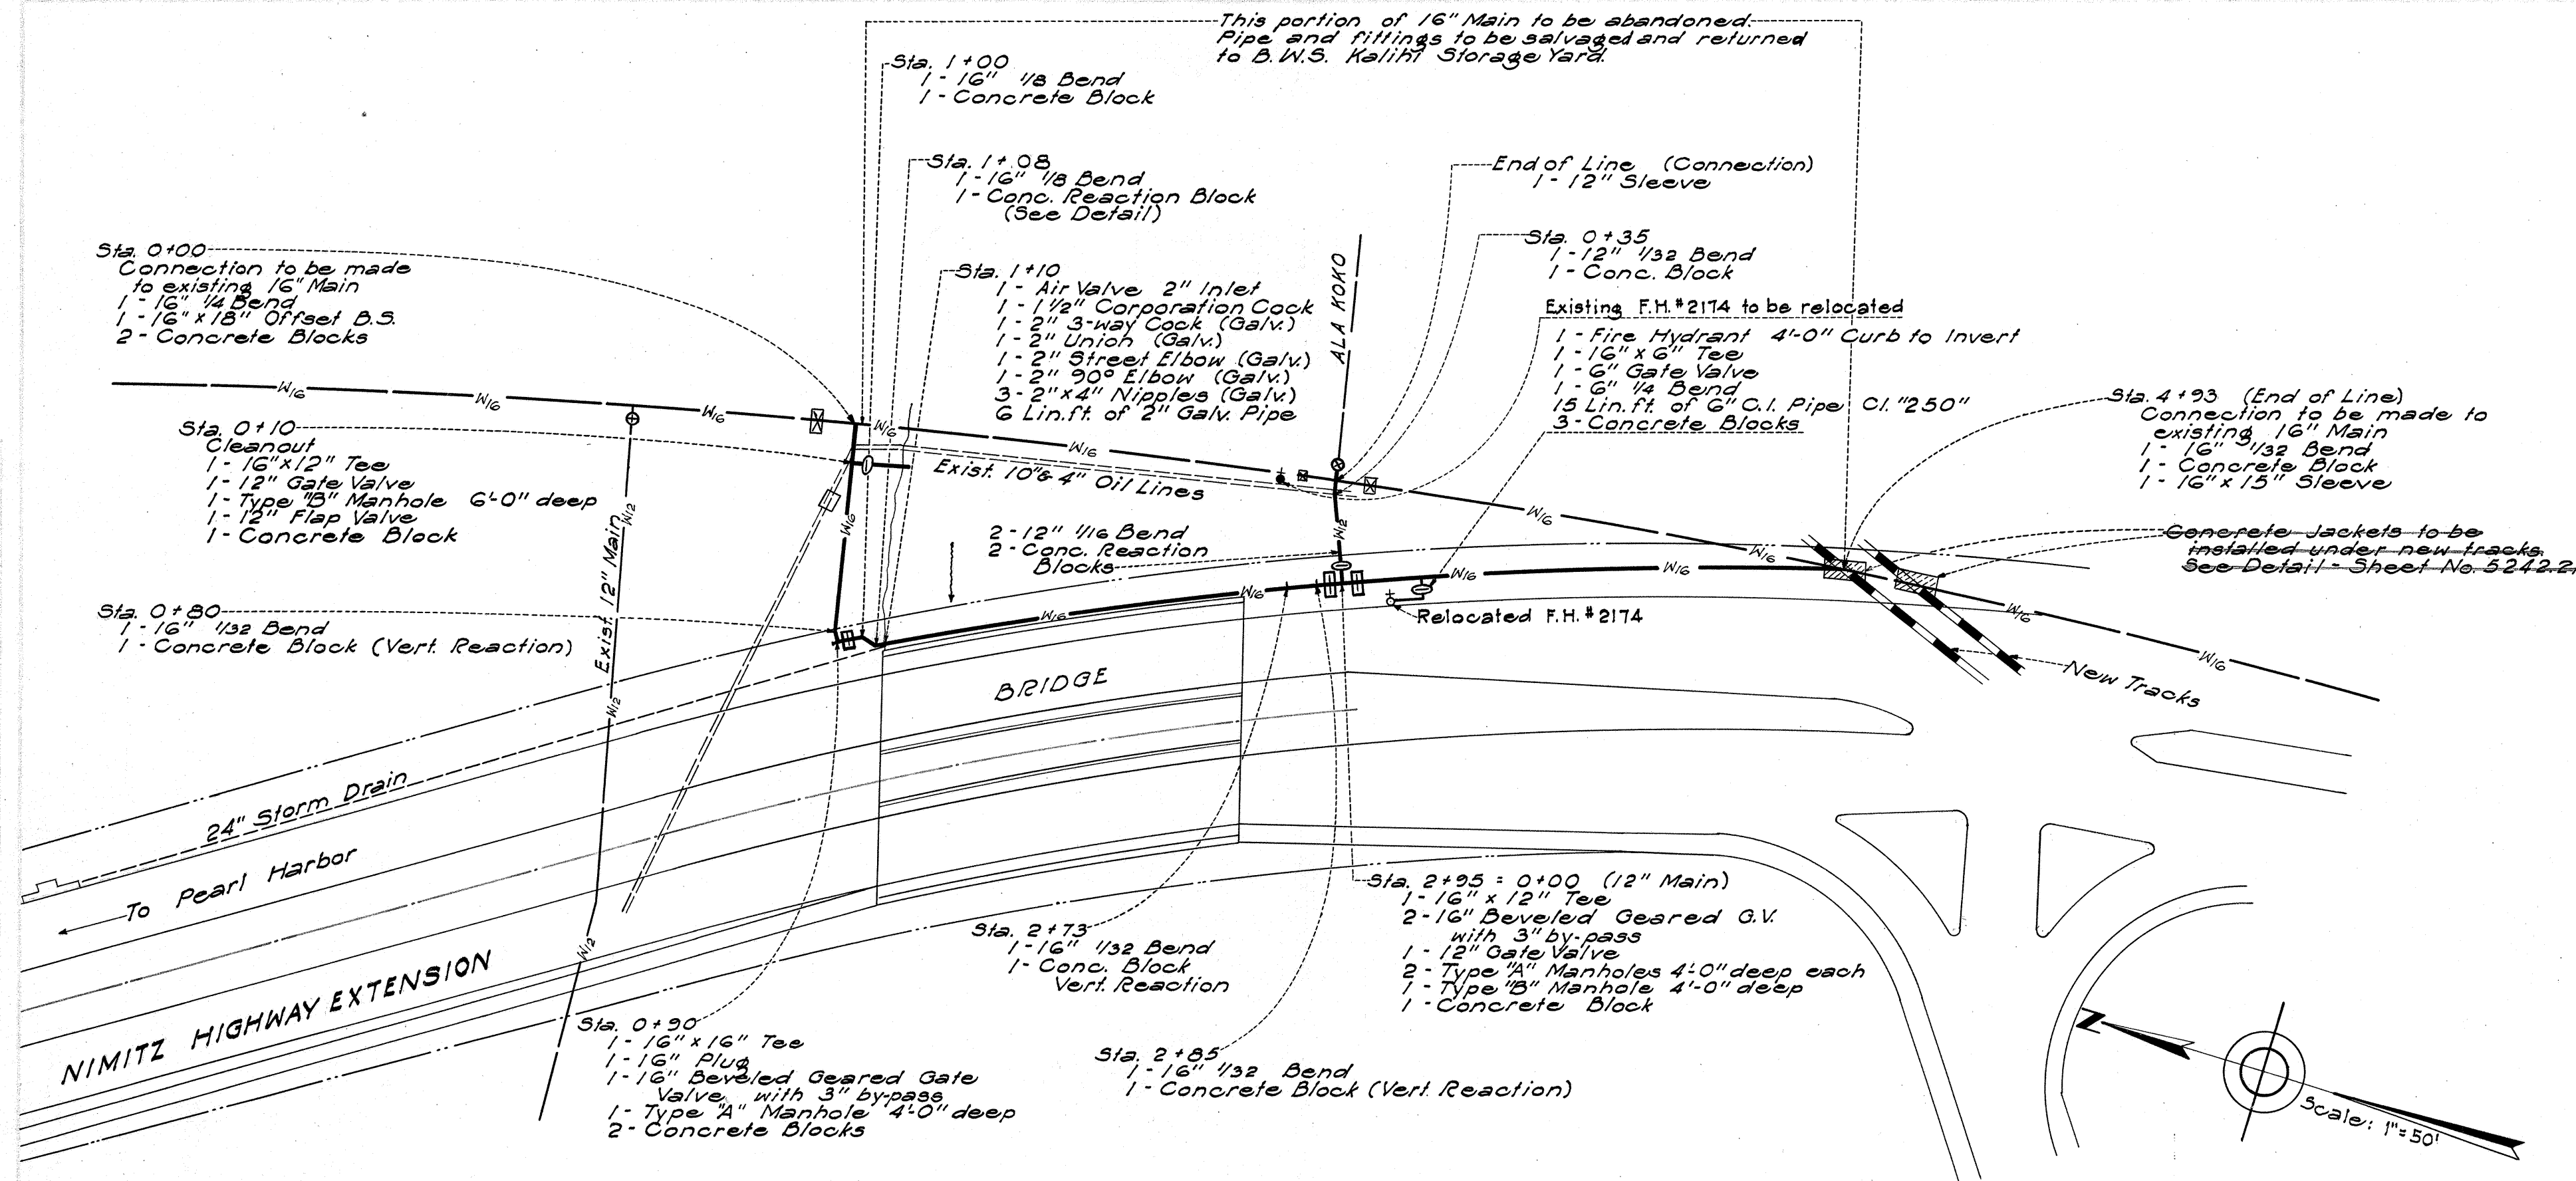


NOTE: All C.I. fittings are all bell unless otherwise noted.

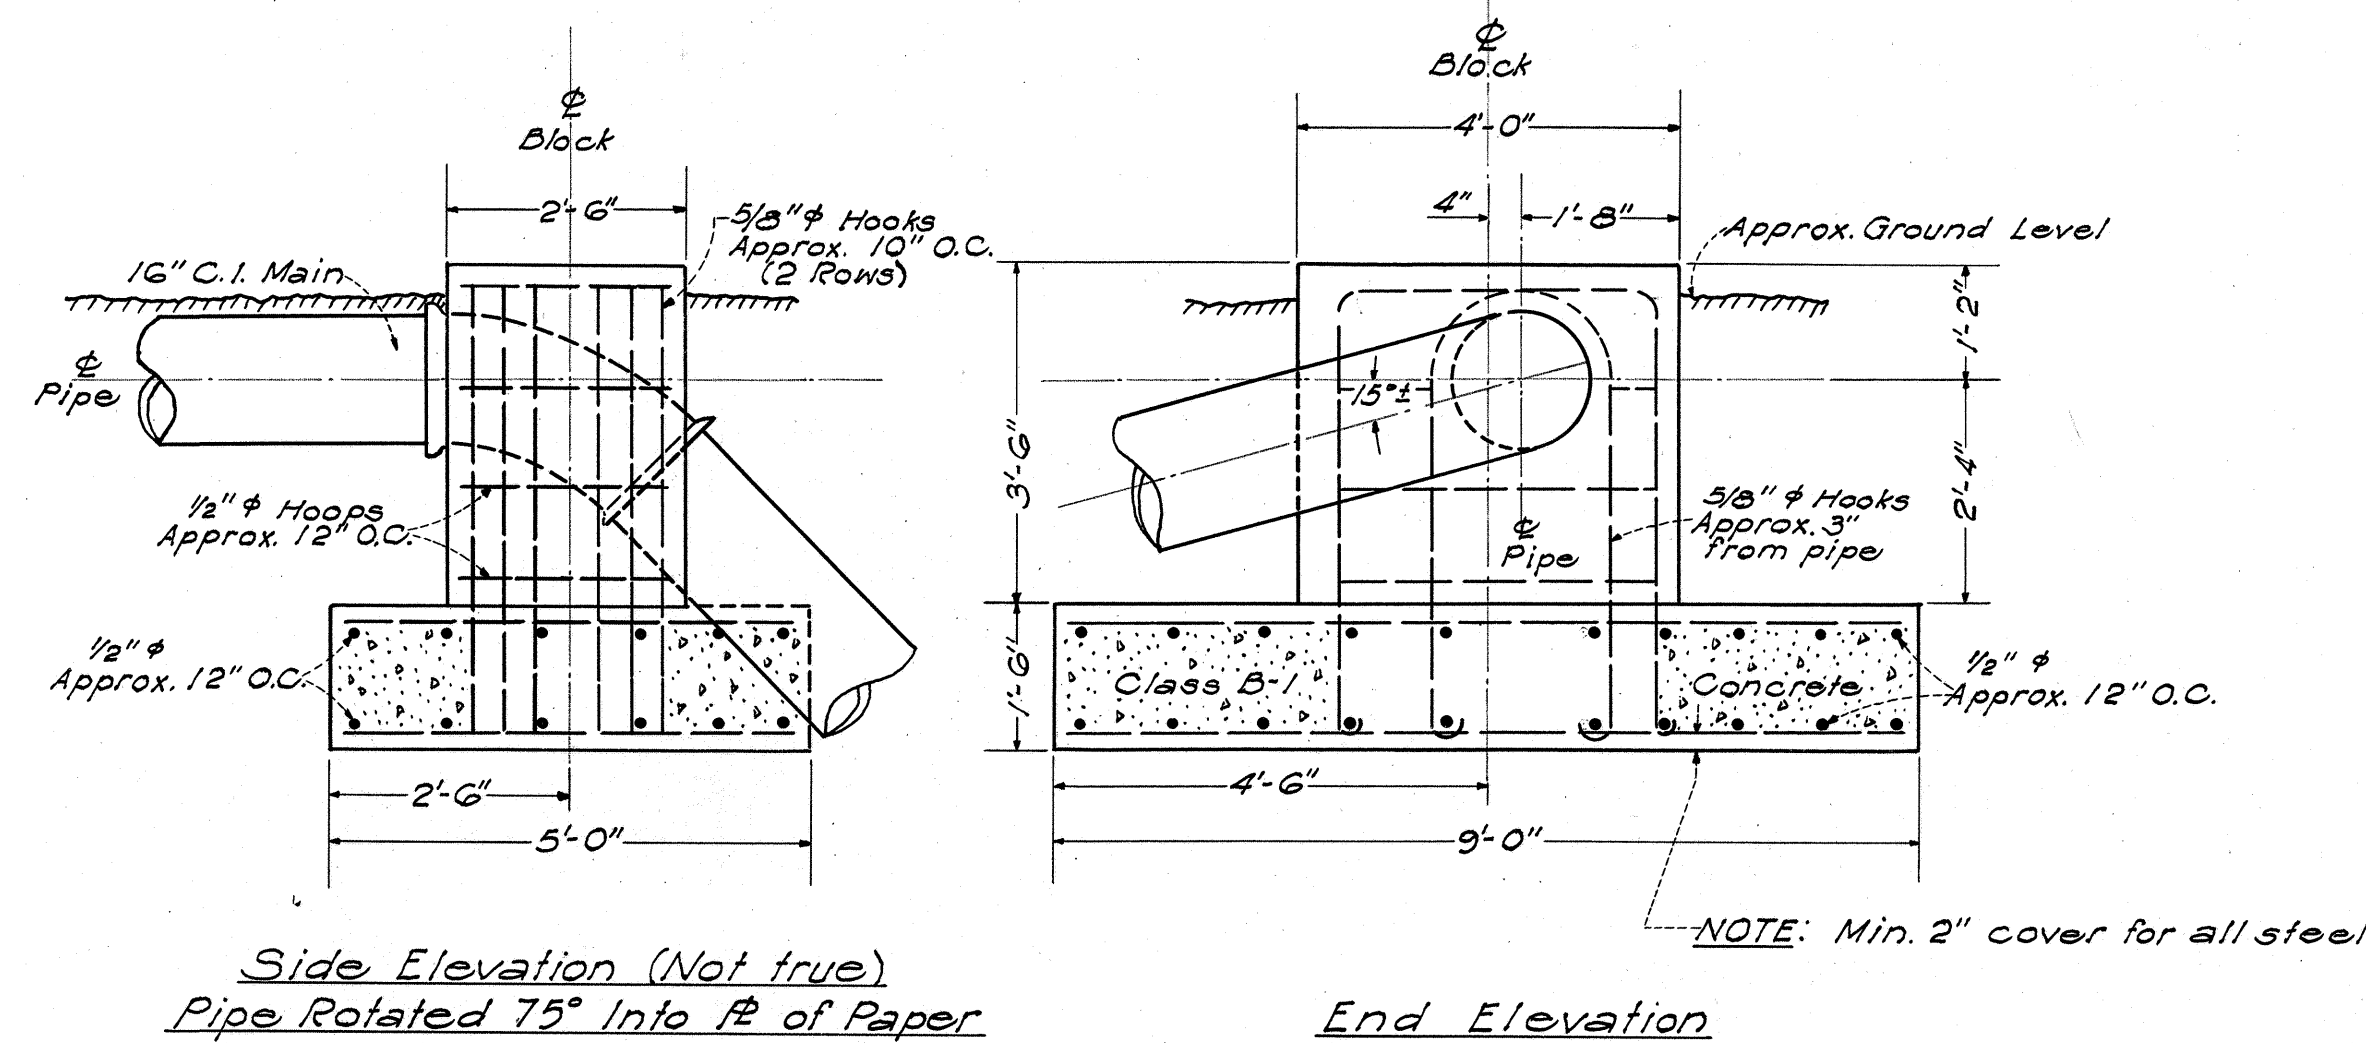

DETAIL OF BLOCK AT STA. 1+08
SCALE: 1/2" = 1'-0"

16" C.I. WATER MAIN CLASS "250", FITTINGS CLASS "D"

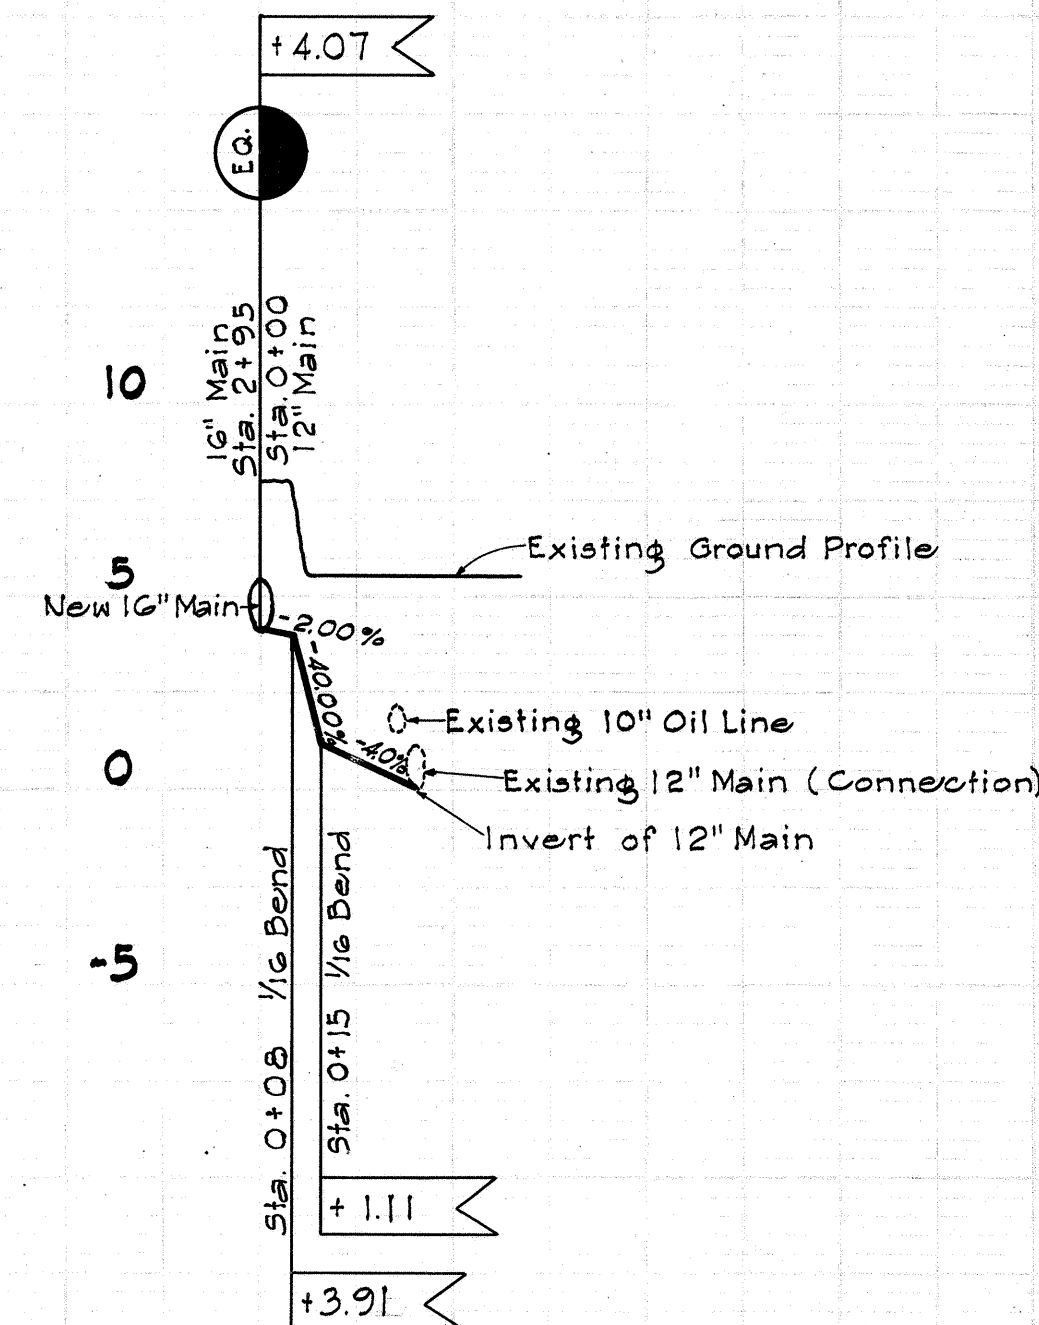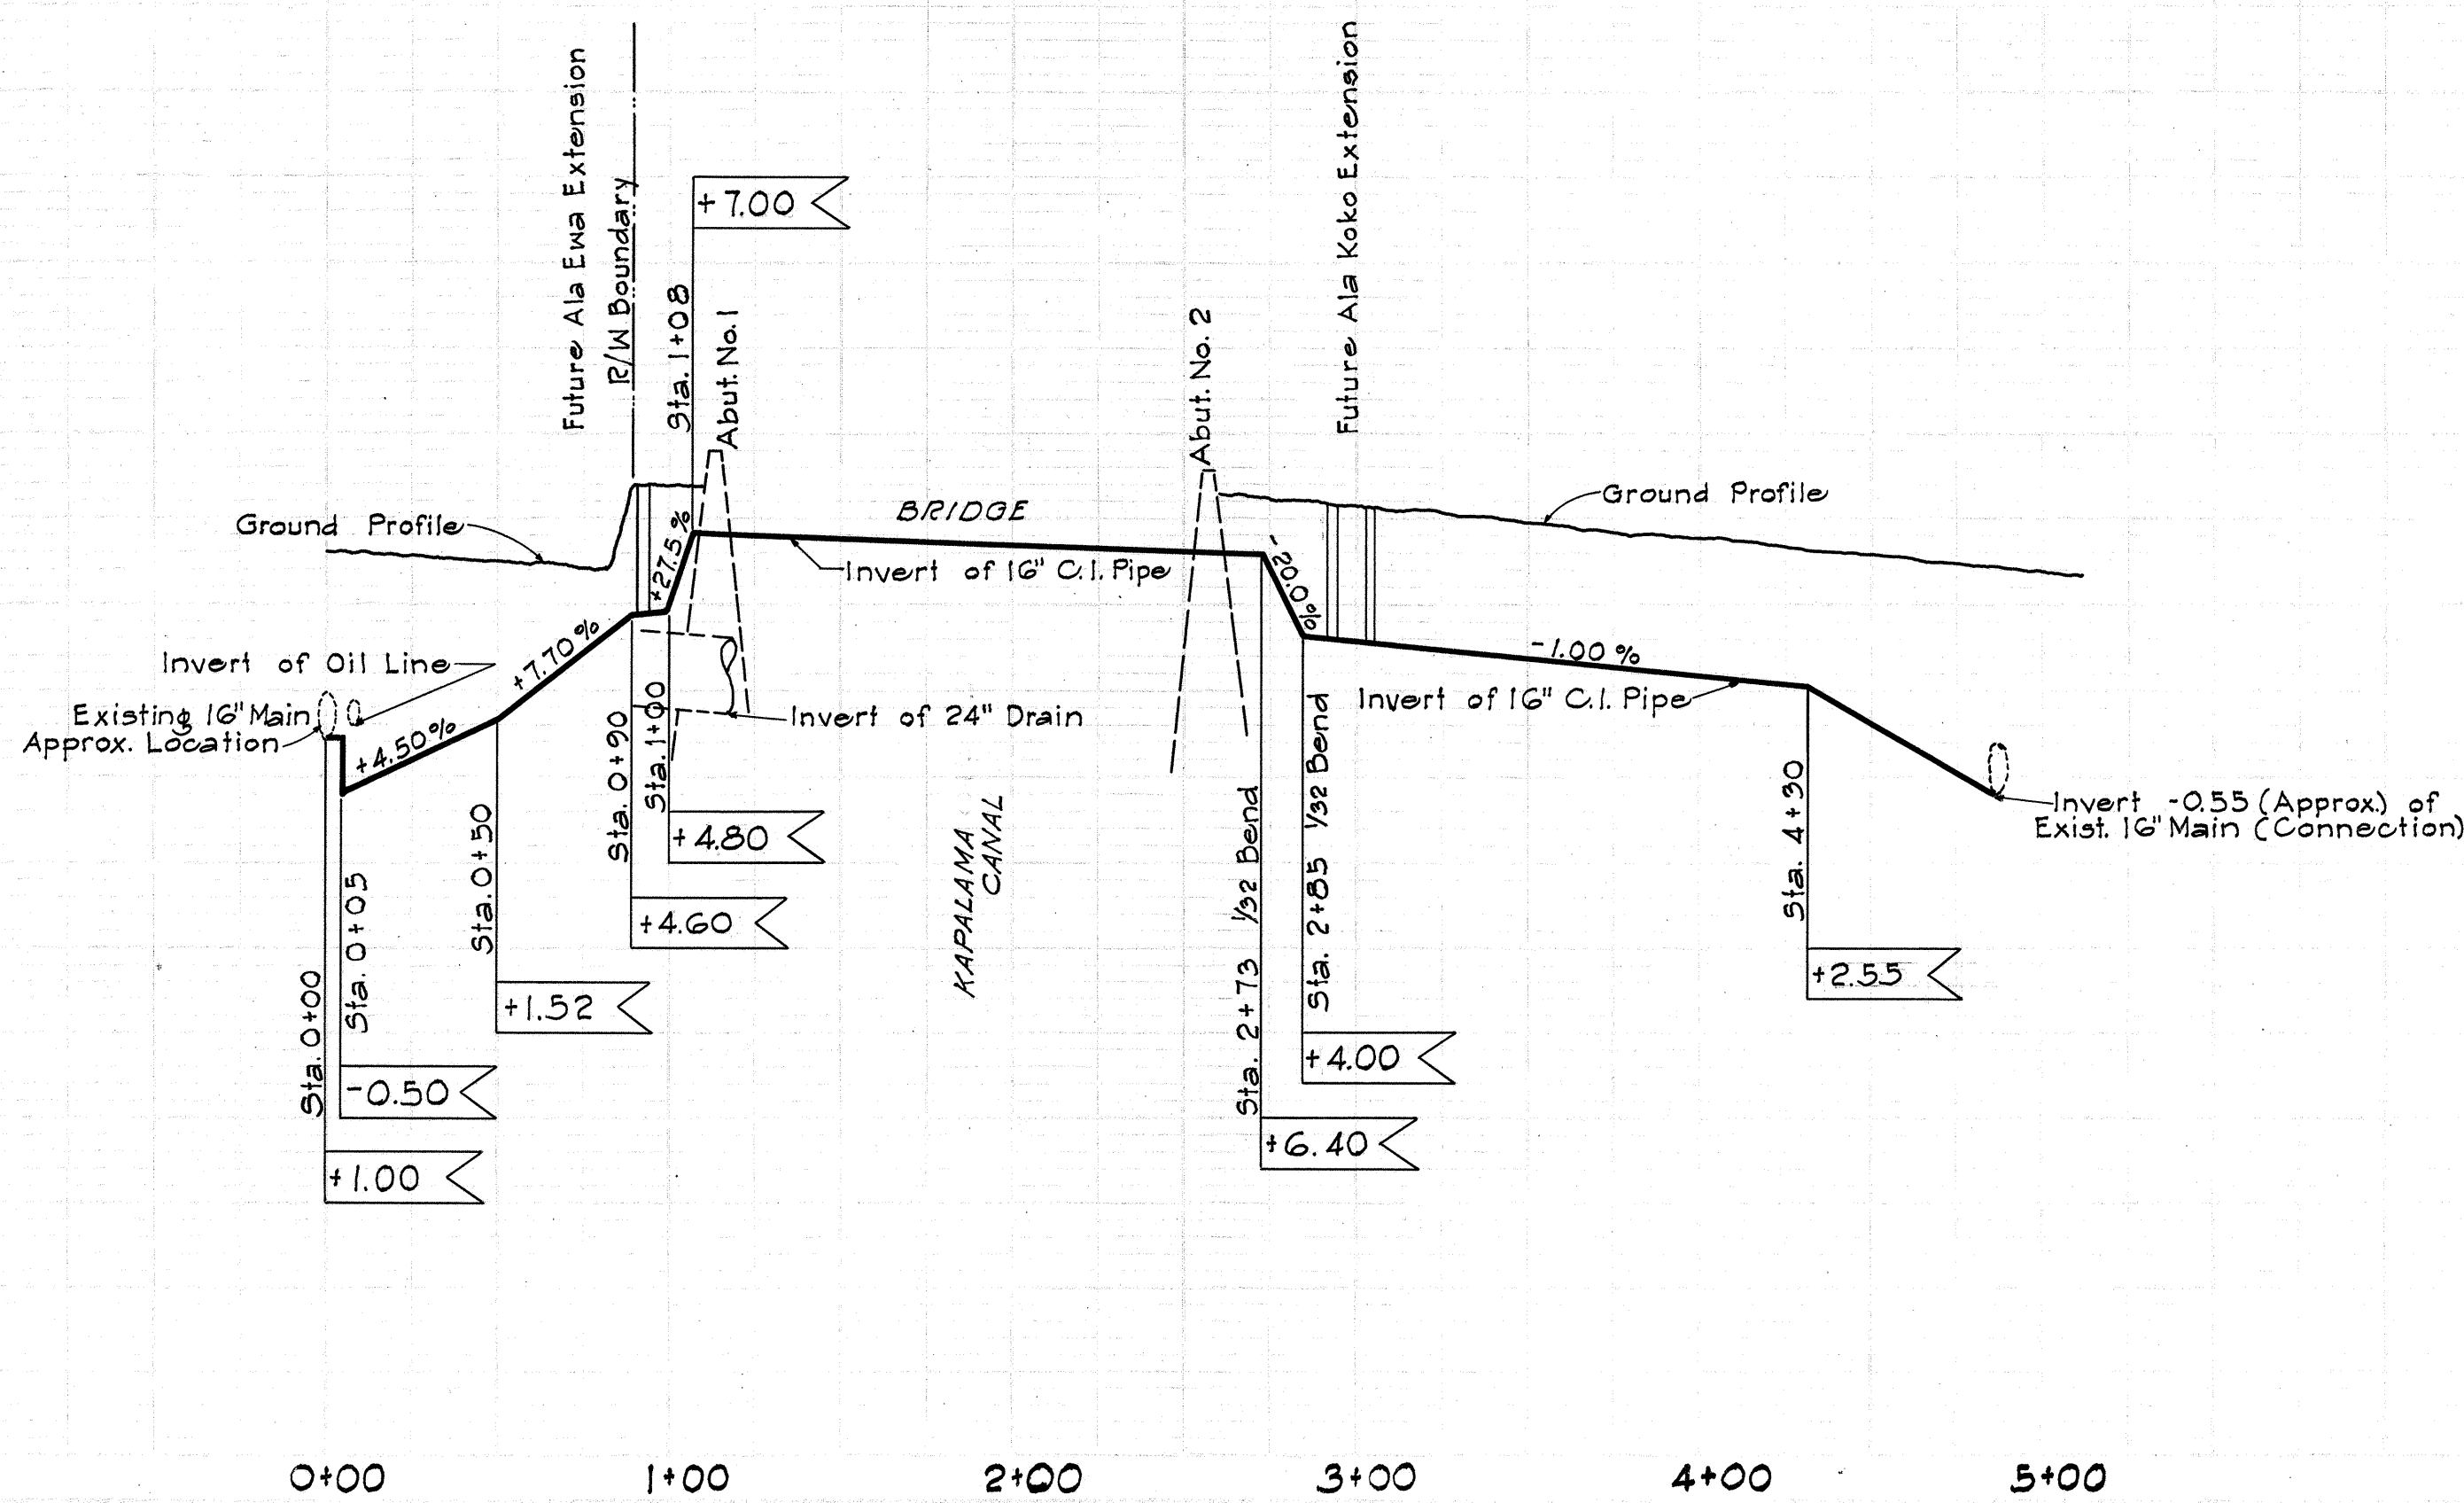

PROFILE OF 12" C.I. MAIN CL "250"
ALA KOKO EXTENSION

NOTE: These plans were prepared in the office of the Board of Water Supply, City & County of Honolulu.

TERRITORIAL HIGHWAY DEPARTMENT
TERRITORY OF HAWAII
RELOCATION OF 16" C.I. WATER MAIN & APPURTENANCES
Honolulu-Pearl Harbor Road
Project No. SN-A-F 44 (4)
Scale: As noted. April, 1948