

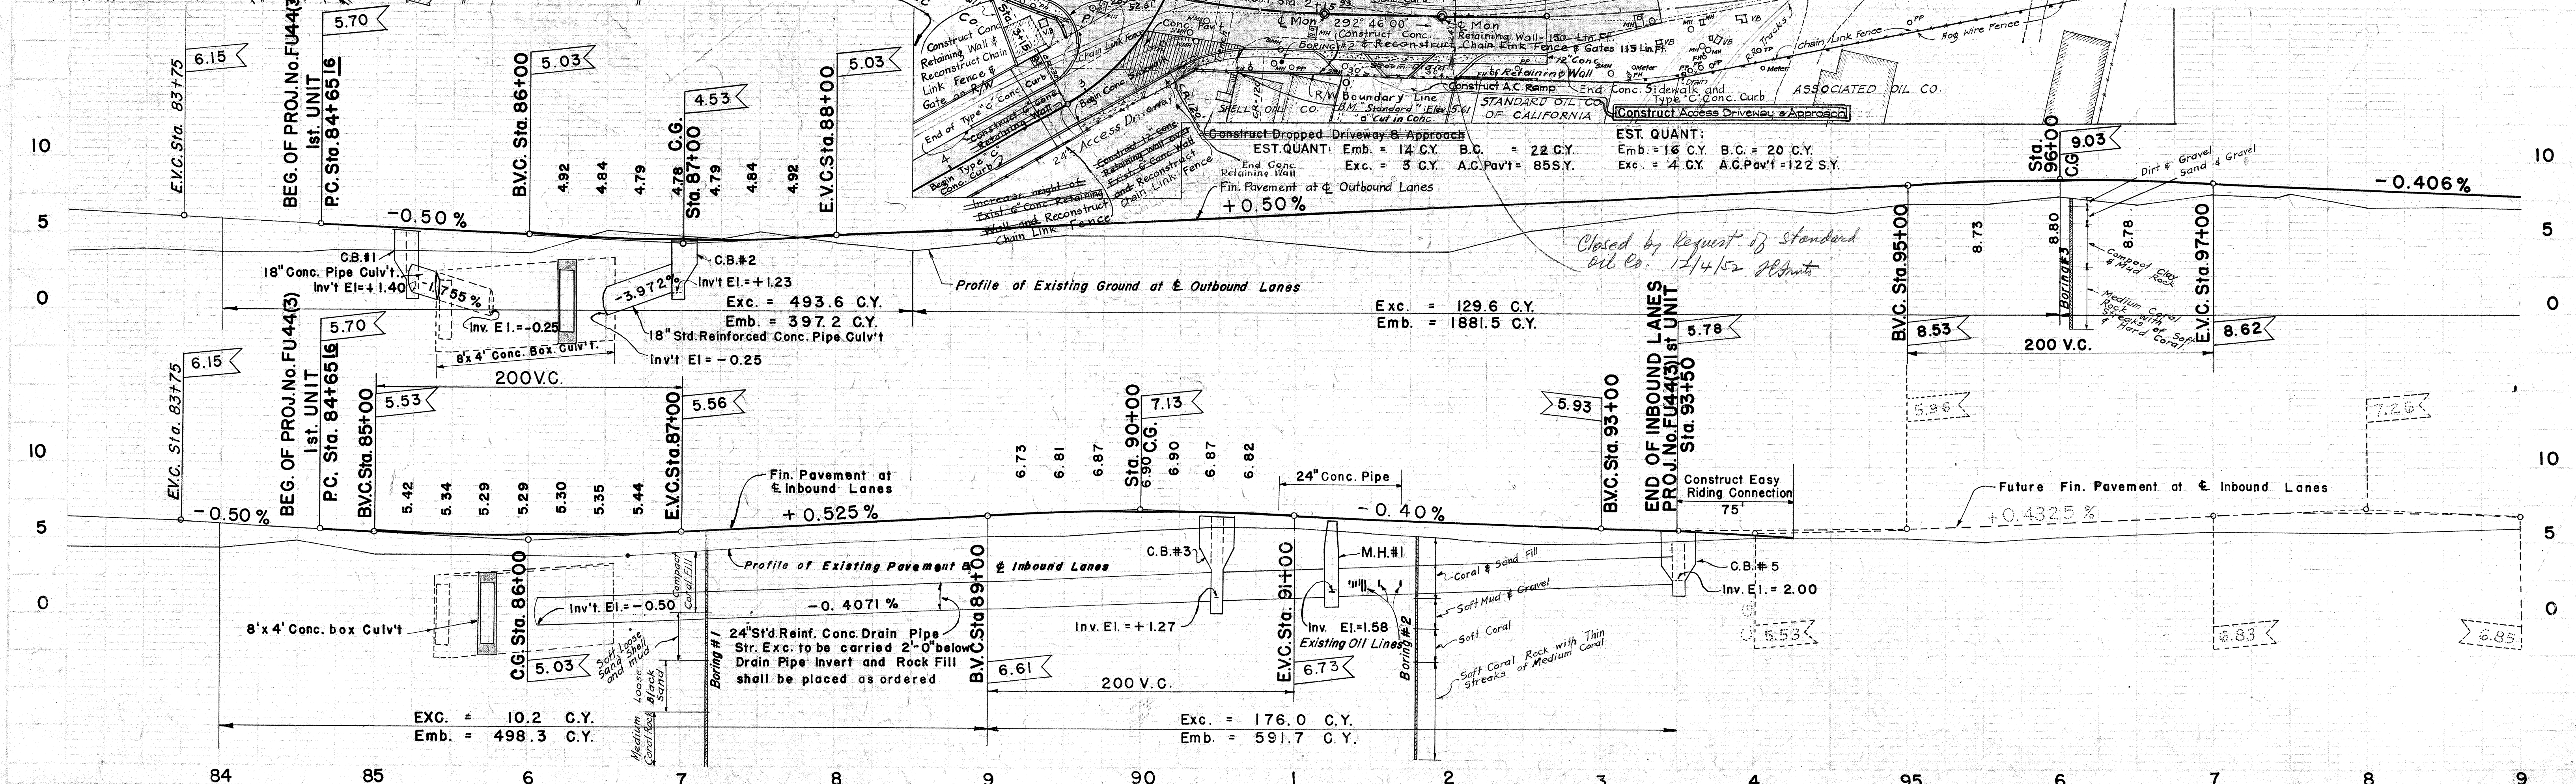
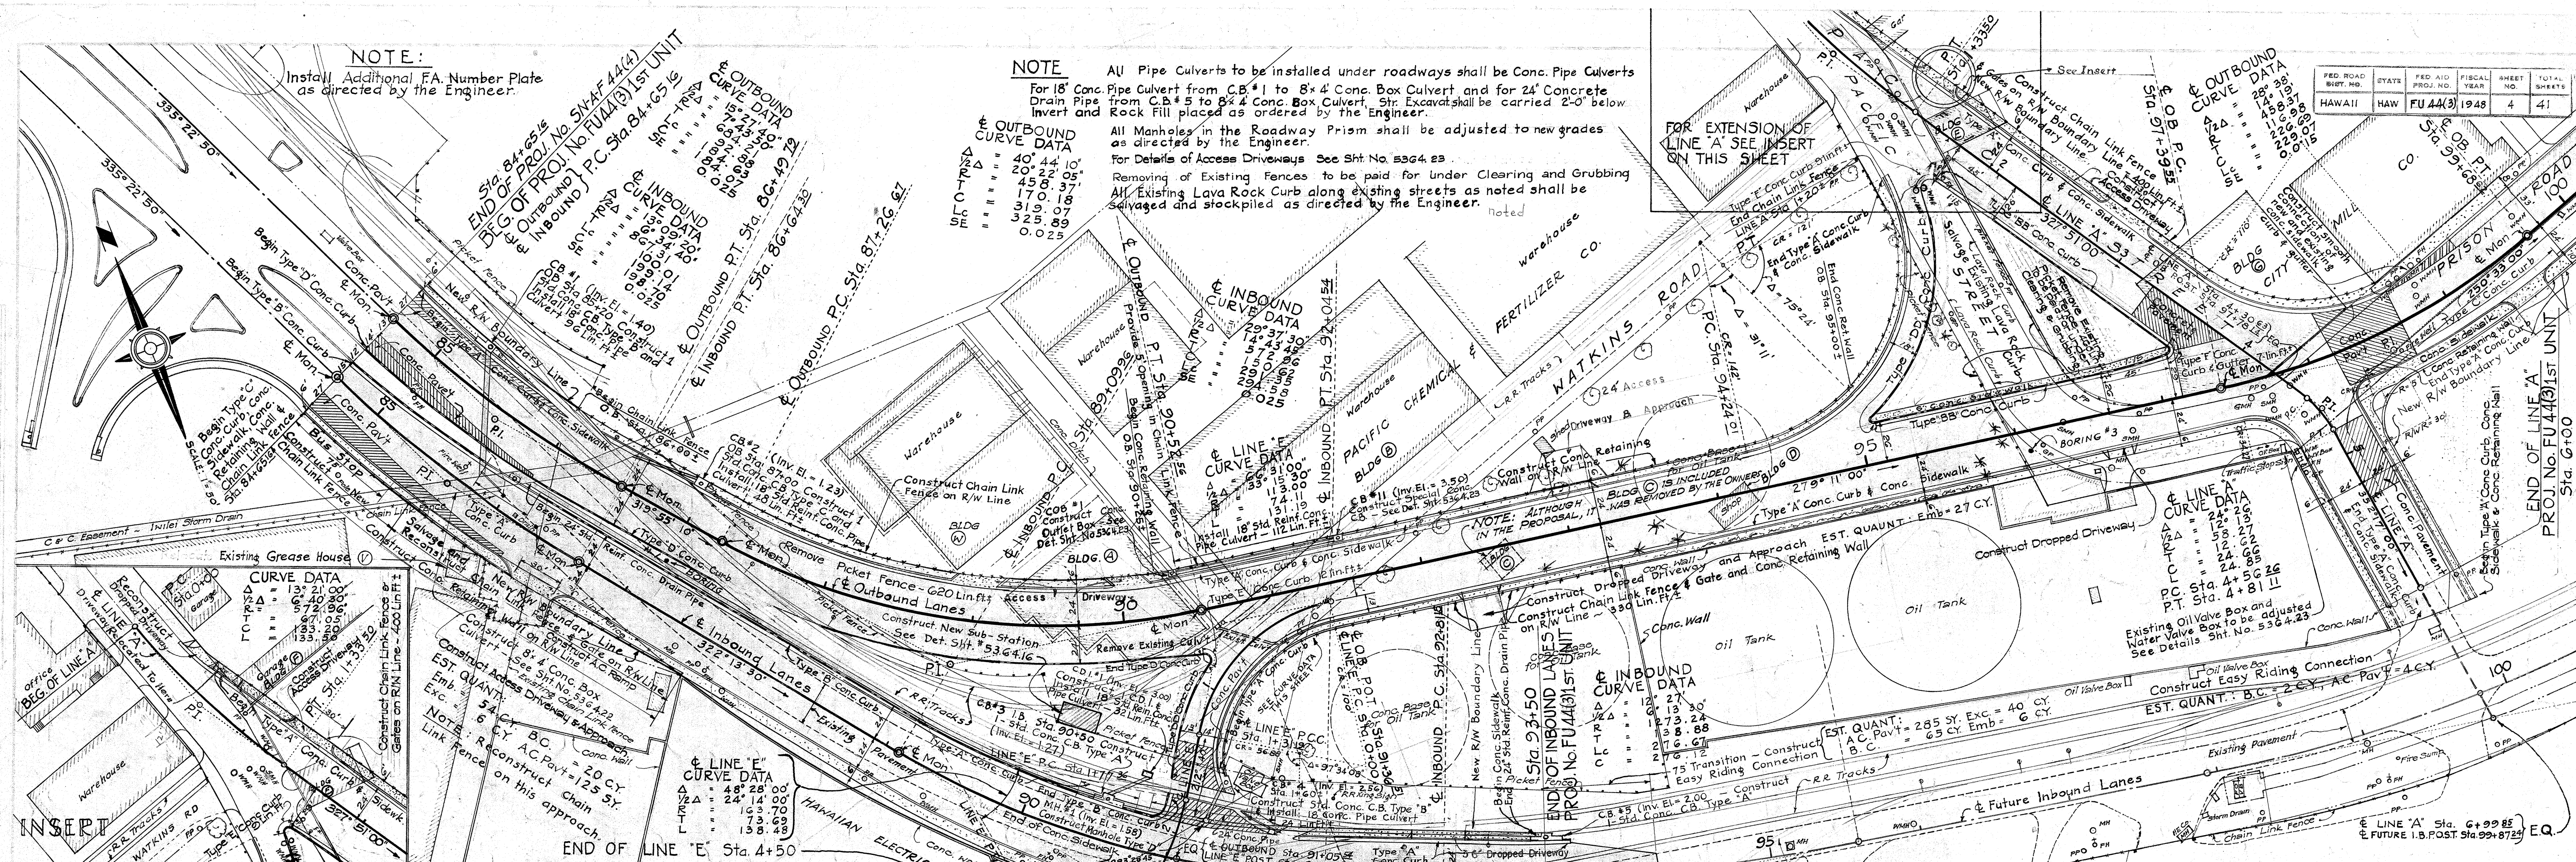
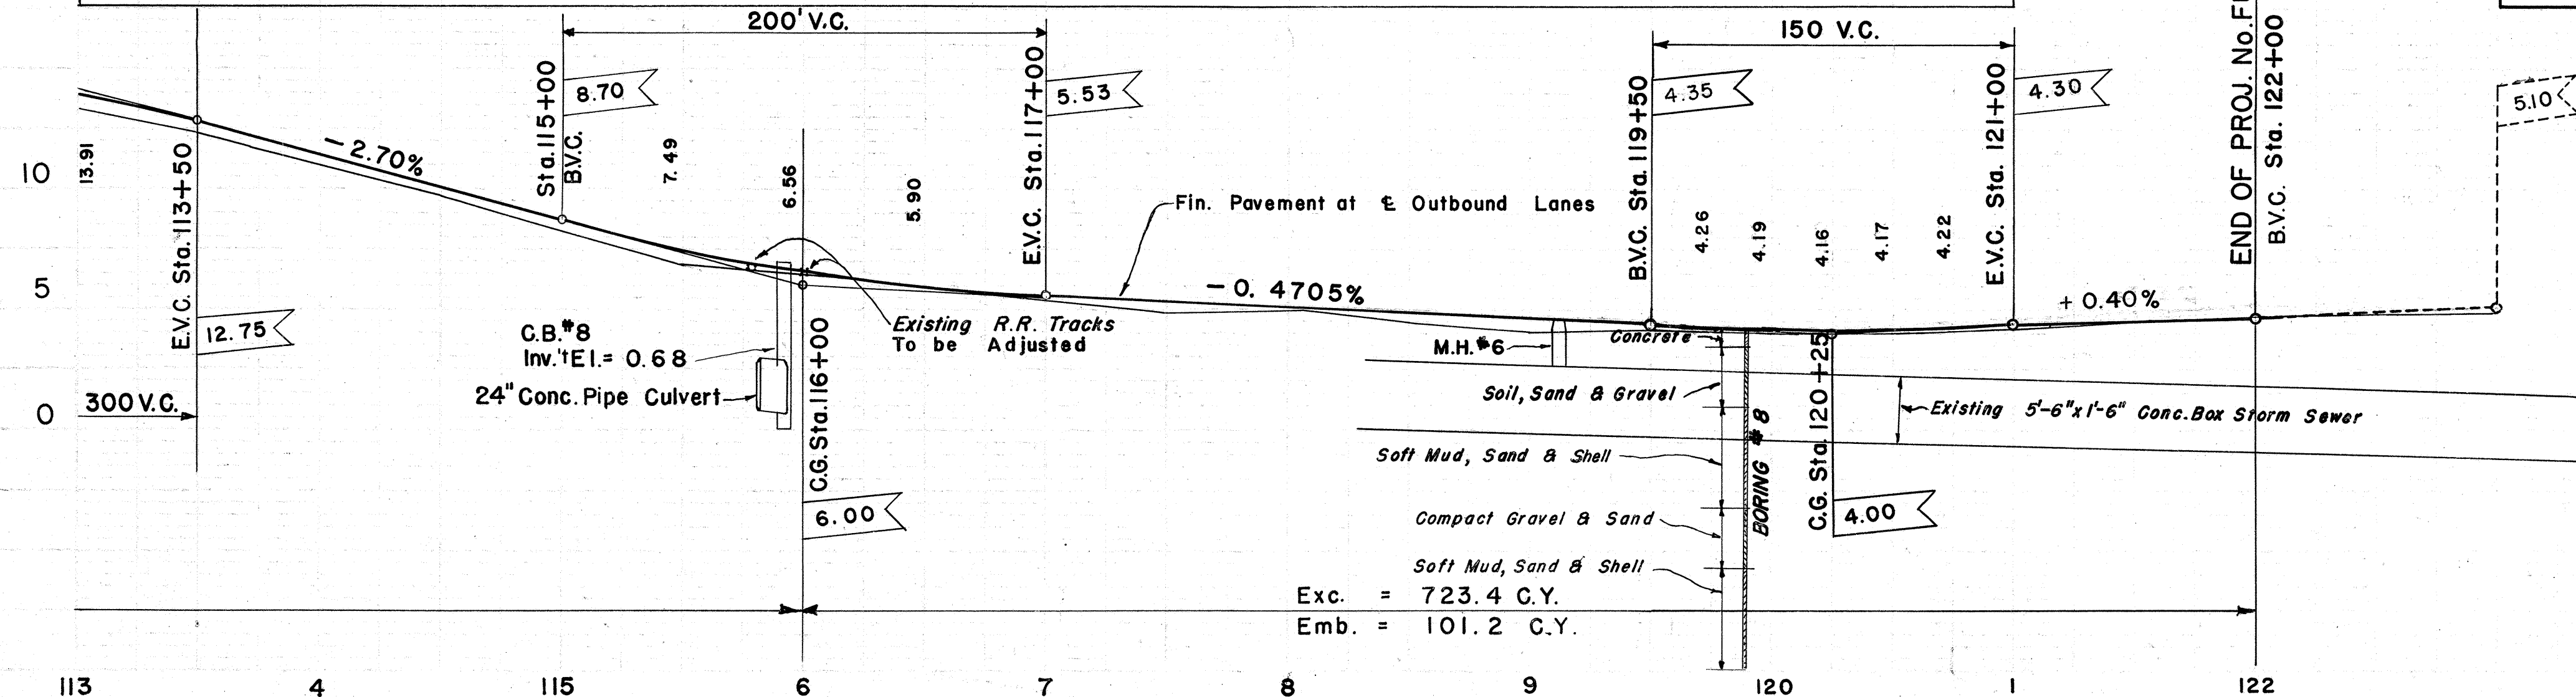
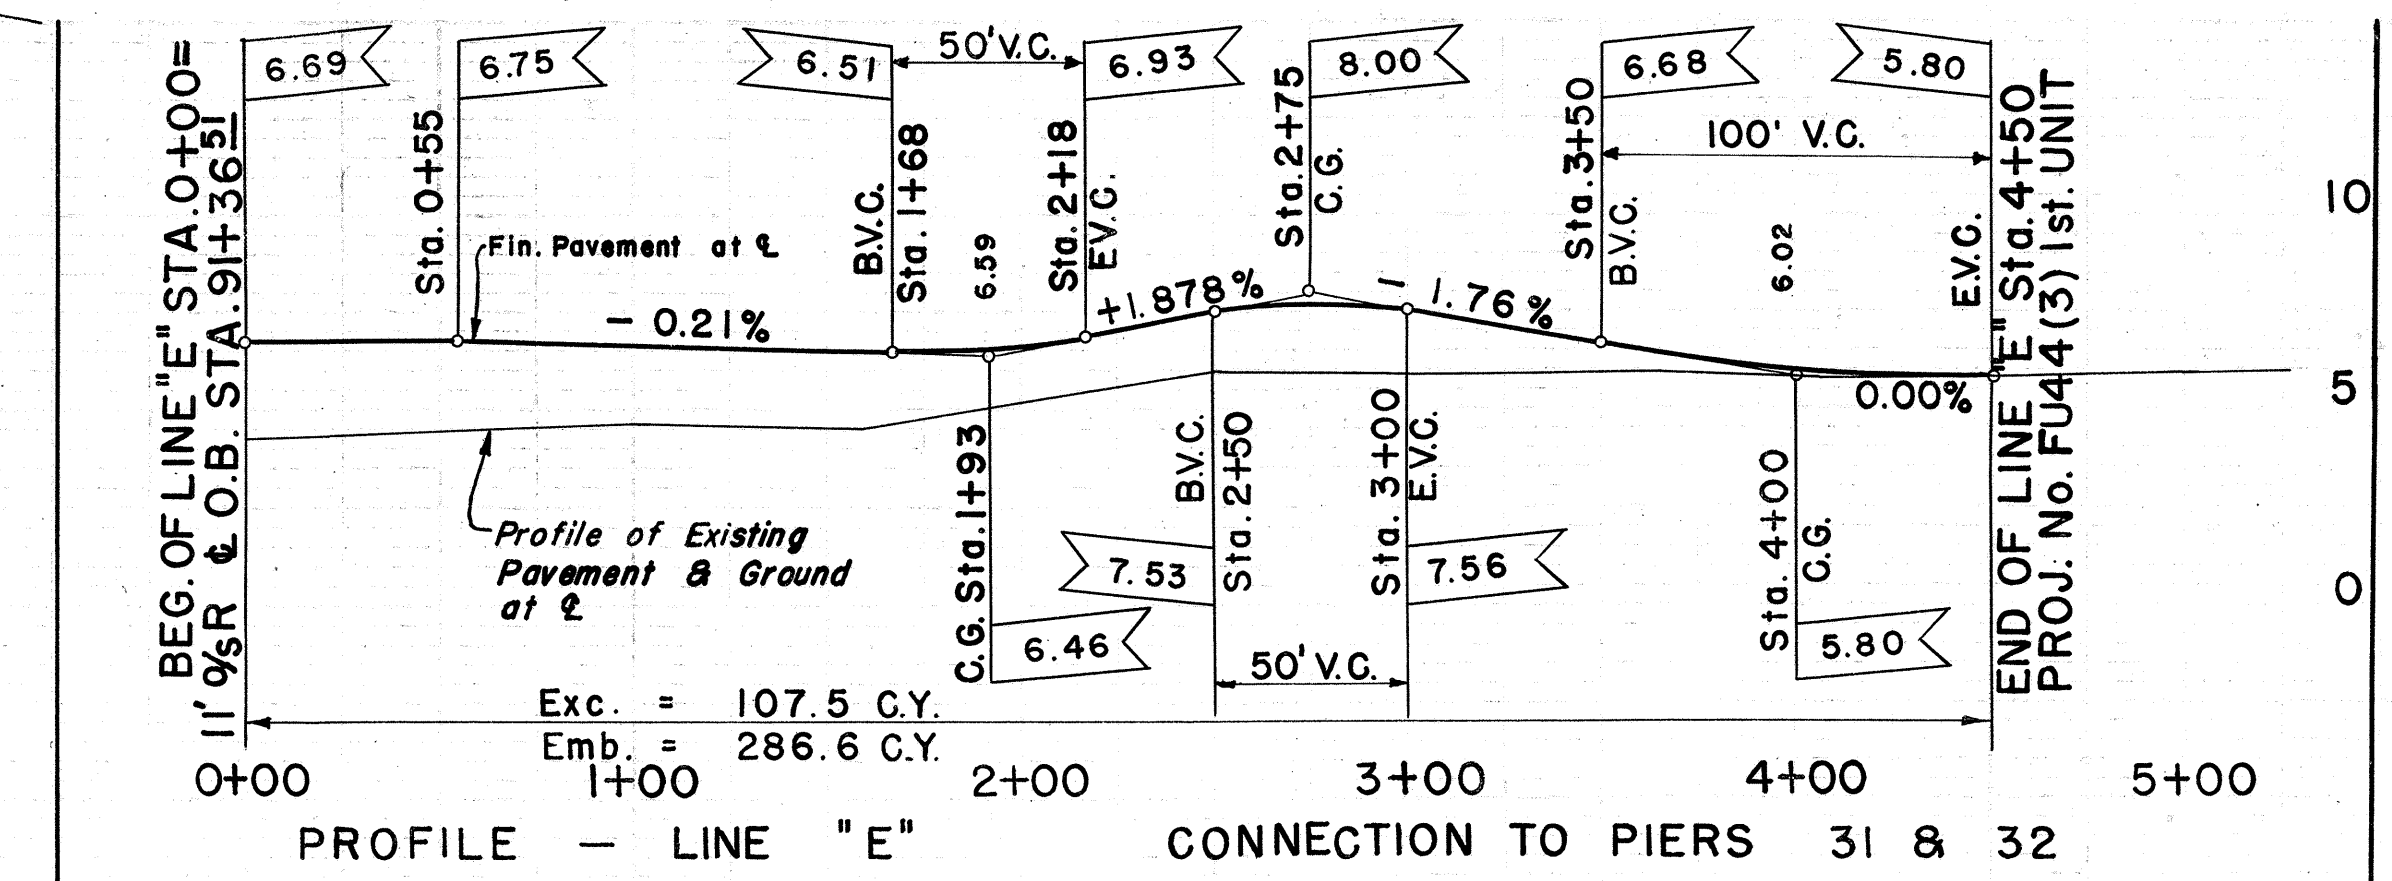


NOTE:
Install Additional F.A. Number Plate as directed by the Engineer.

NOTE
AU Pipe Culverts to be installed under roadways shall be Conc. Pipe Culverts for 18" Conc. Pipe Culvert from C.B.#1 to 8'x4' Conc. Box Culvert and for 24" Concrete Drain Pipe from C.B.#5 to 8'x4' Conc. Box Culvert. Str. Excavation shall be carried 2'-0" below Invert and Rock Fill placed as ordered by the Engineer.
All Manholes in the Roadway Prism shall be adjusted to new grades as directed by the Engineer.
For Details of Access Driveways See Sht. No. 5364.23
Removing of Existing Fences to be paid for under Clearing and Grubbing
All Existing Lava Rock Curb along existing streets as noted shall be salvaged and stockpiled as directed by the Engineer.

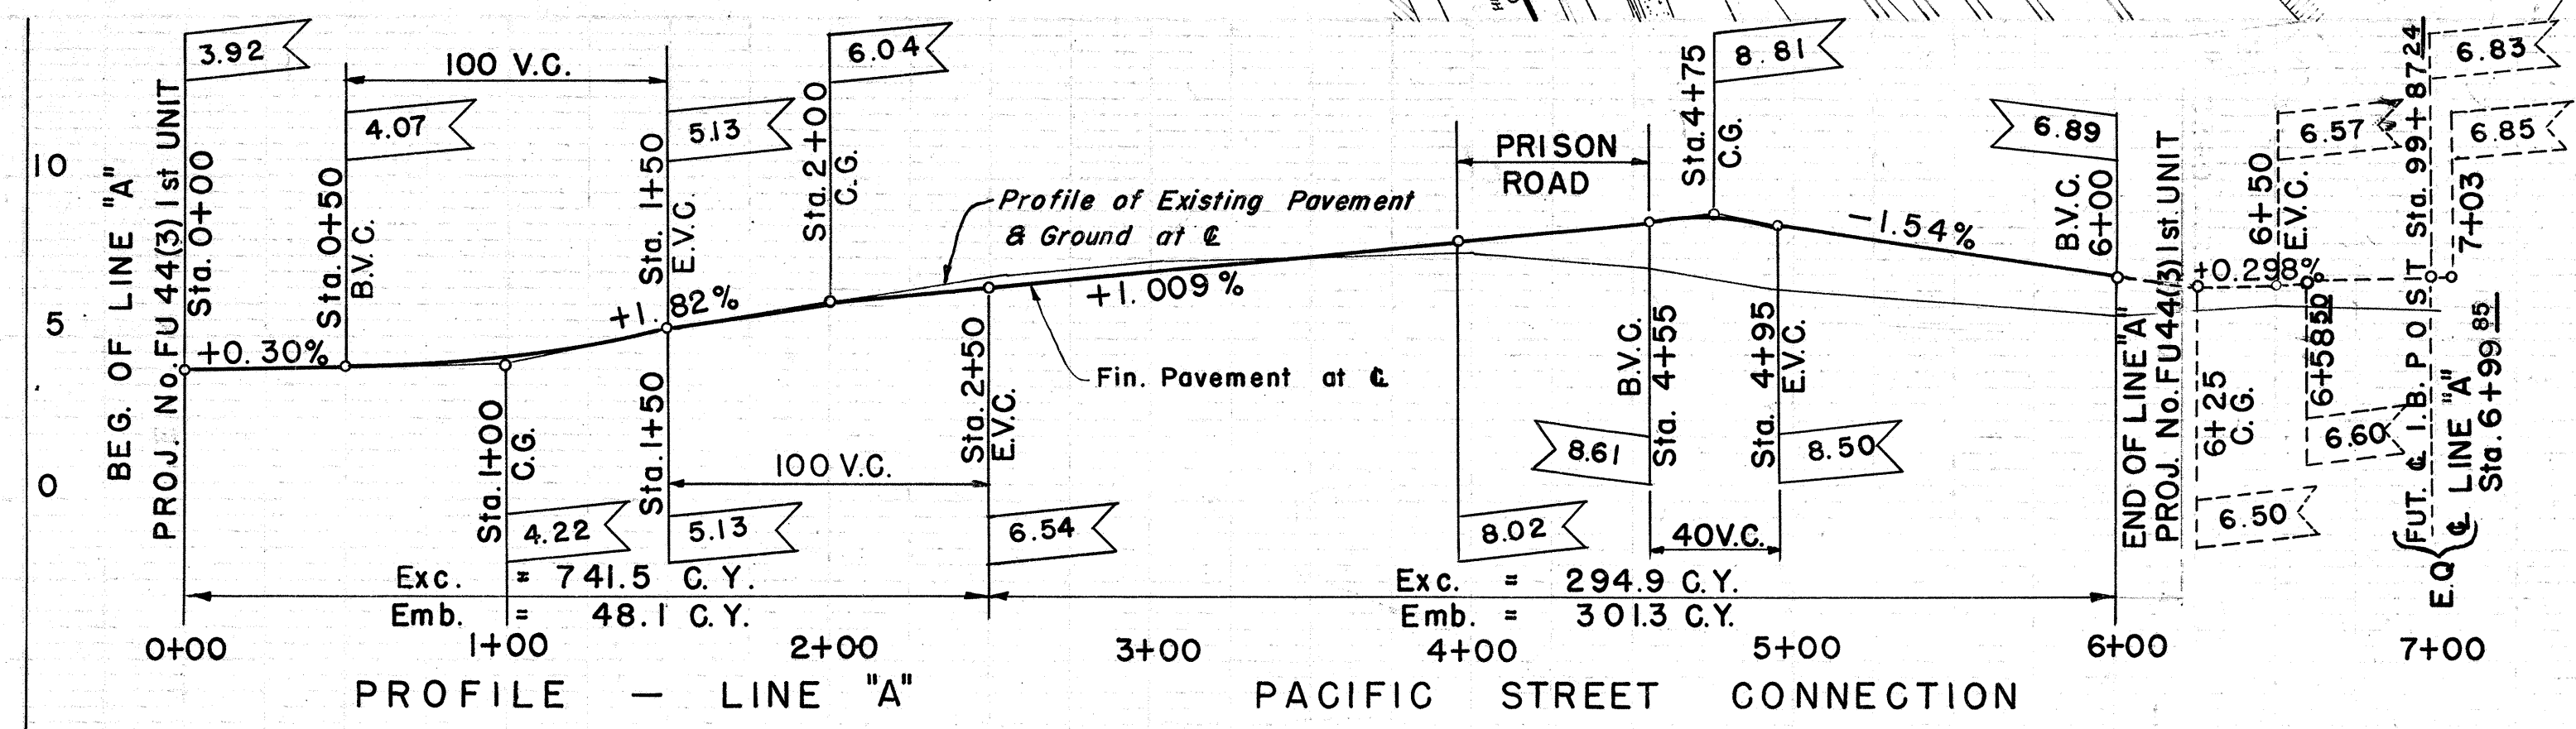

FED. ROAD DIST. NO.	STATE	FED. AID PROJ. NO.	FISCAL YEAR	SHEET NO.	TOTAL SHEETS
HAWAII	HAW	FU 44(3)	1948	6	41

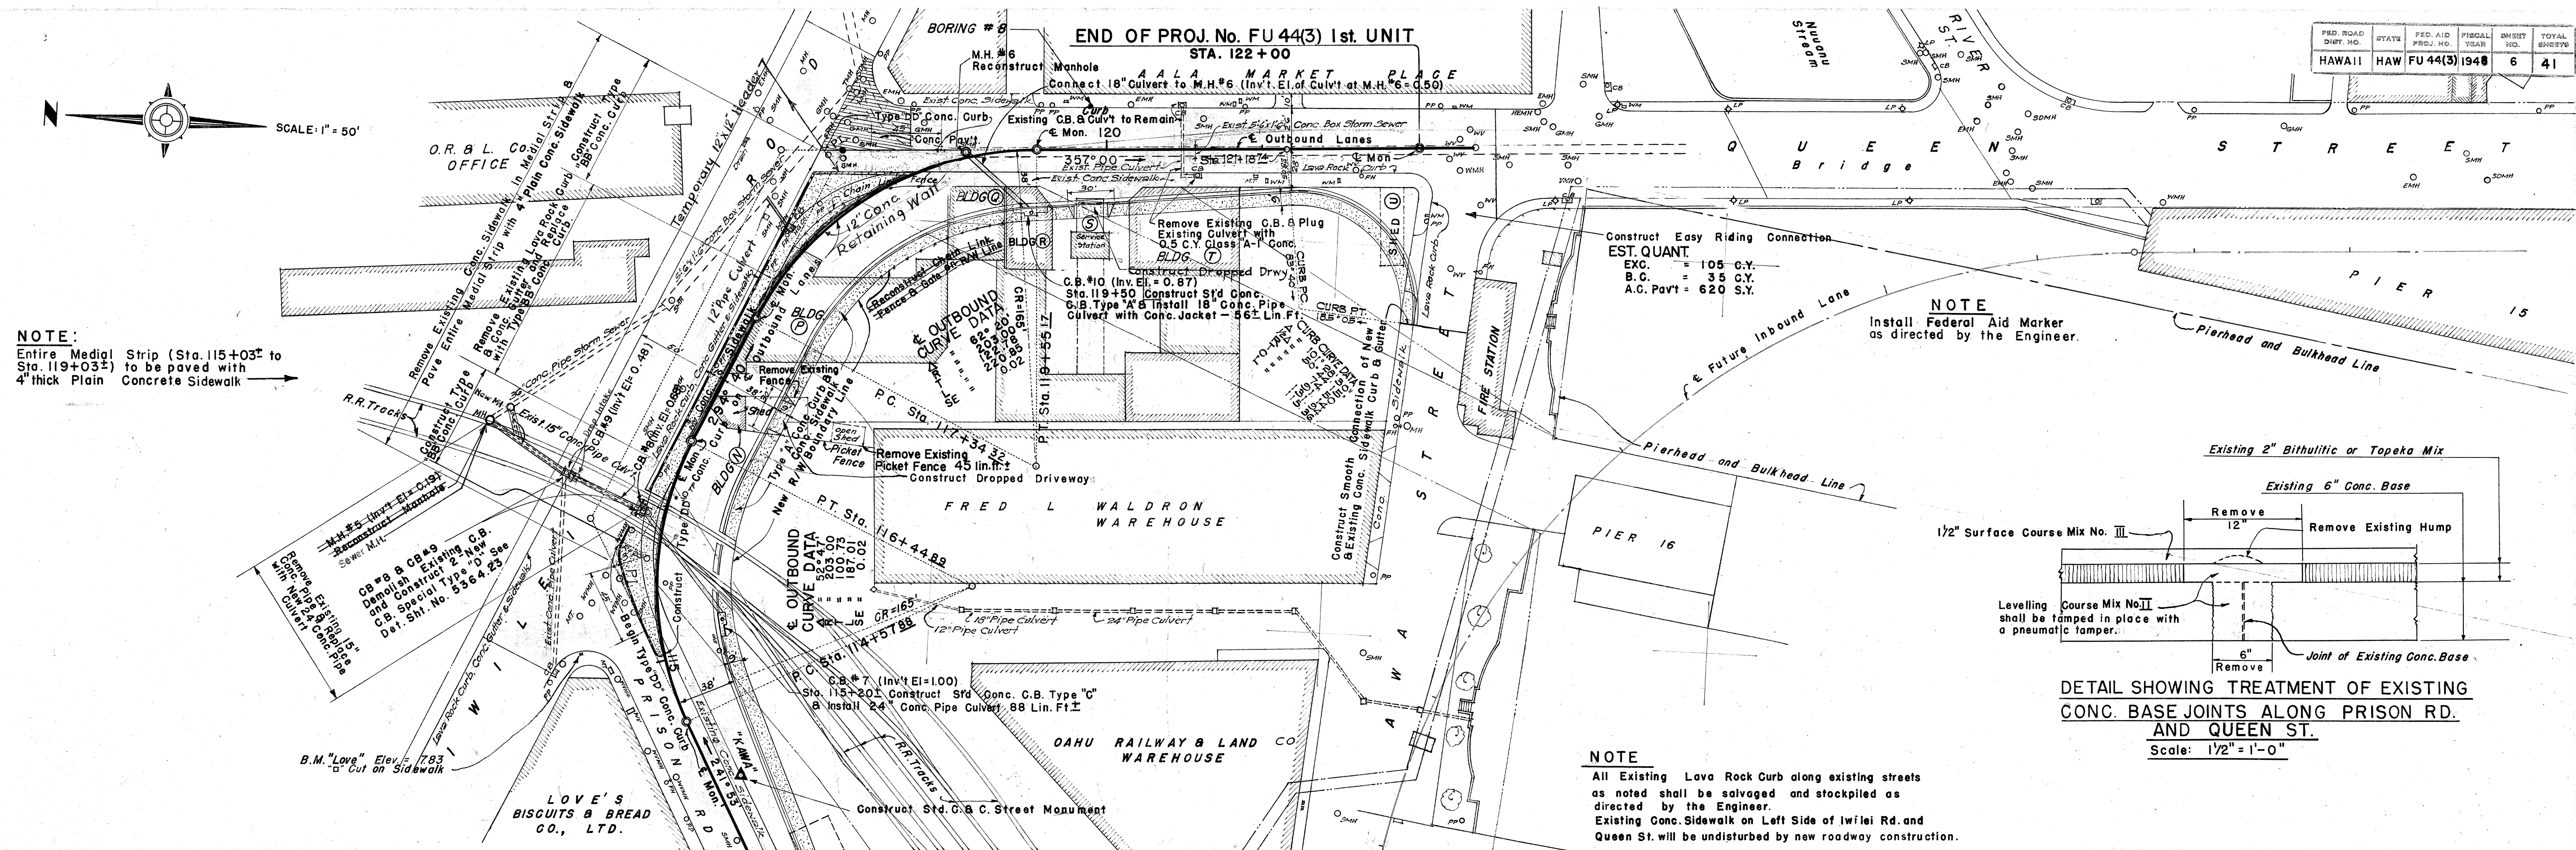

5 3 6 4 . 6