

INDEX TO DRAWINGS	
SHEET No.	DESCRIPTION
1	Title Sheet
2-3	Typical Sections
4-6	Plan & Profile
7-9	Utilities
10-12	R.R. Tracks and Traffic Signs
13	Detail of Intersection
14-15	Highway Lighting System
16-17	Sub-Station
18-20	Traffic Signal System
21	R. R. Crossings
22	8'x4' Box Culvert
23	Fire Hydrant, Manhole, Special Catch Basins, etc.
24	Types "C" and "W" Manholes
25-28	Standard Details
29-34	Kapalama Relief Sewer
35-41	Cross Sections


CONVENTIONAL SIGNS	
Centerline	125
Boundary Lines	or
Fences (Named)	
Existing Roadways	
Circular Culvert	
Box Culvert	
Bridge	
Telephone Pole	T.P.
Electric Power Pole	E.P.P.
Water Main	W ₂ (W ₄ , 8, 12, Etc.)
Storm Drain	SD ₁₂ (SD ₁₈ , 24, Etc.)
Concrete Drop Intake	C.D.I.
Standard Catch Basin	S.C.B.
Standard Manhole	M.H.S.
Sewer Manhole	S.S. S ₁₂
Telephone Manhole	T.M.H.
Fire Hydrant	F.H.
Tree (Large, named)	Mango, Coco
Railroad	

TERRITORY OF HAWAII
TERRITORIAL HIGHWAY DEPARTMENT
HONOLULU, OAHU, T. H.


PLANS OF HONOLULU PEARL HARBOR ROAD IWILEI SECTION

FEDERAL AID PROJECT NO. FU 44 (3) 1st UNIT
DISTRICT OF HONOLULU
ISLAND OF OAHU

SCALES	
PLAN	1 INCH = 50 FEET
PROFILE	HOR. 1 INCH = 50 FEET VER. 1 INCH = 5 FEET
CROSS SECTIONS	HOR. 1 INCH = 10 FEET VER. 1 INCH = 5 FEET

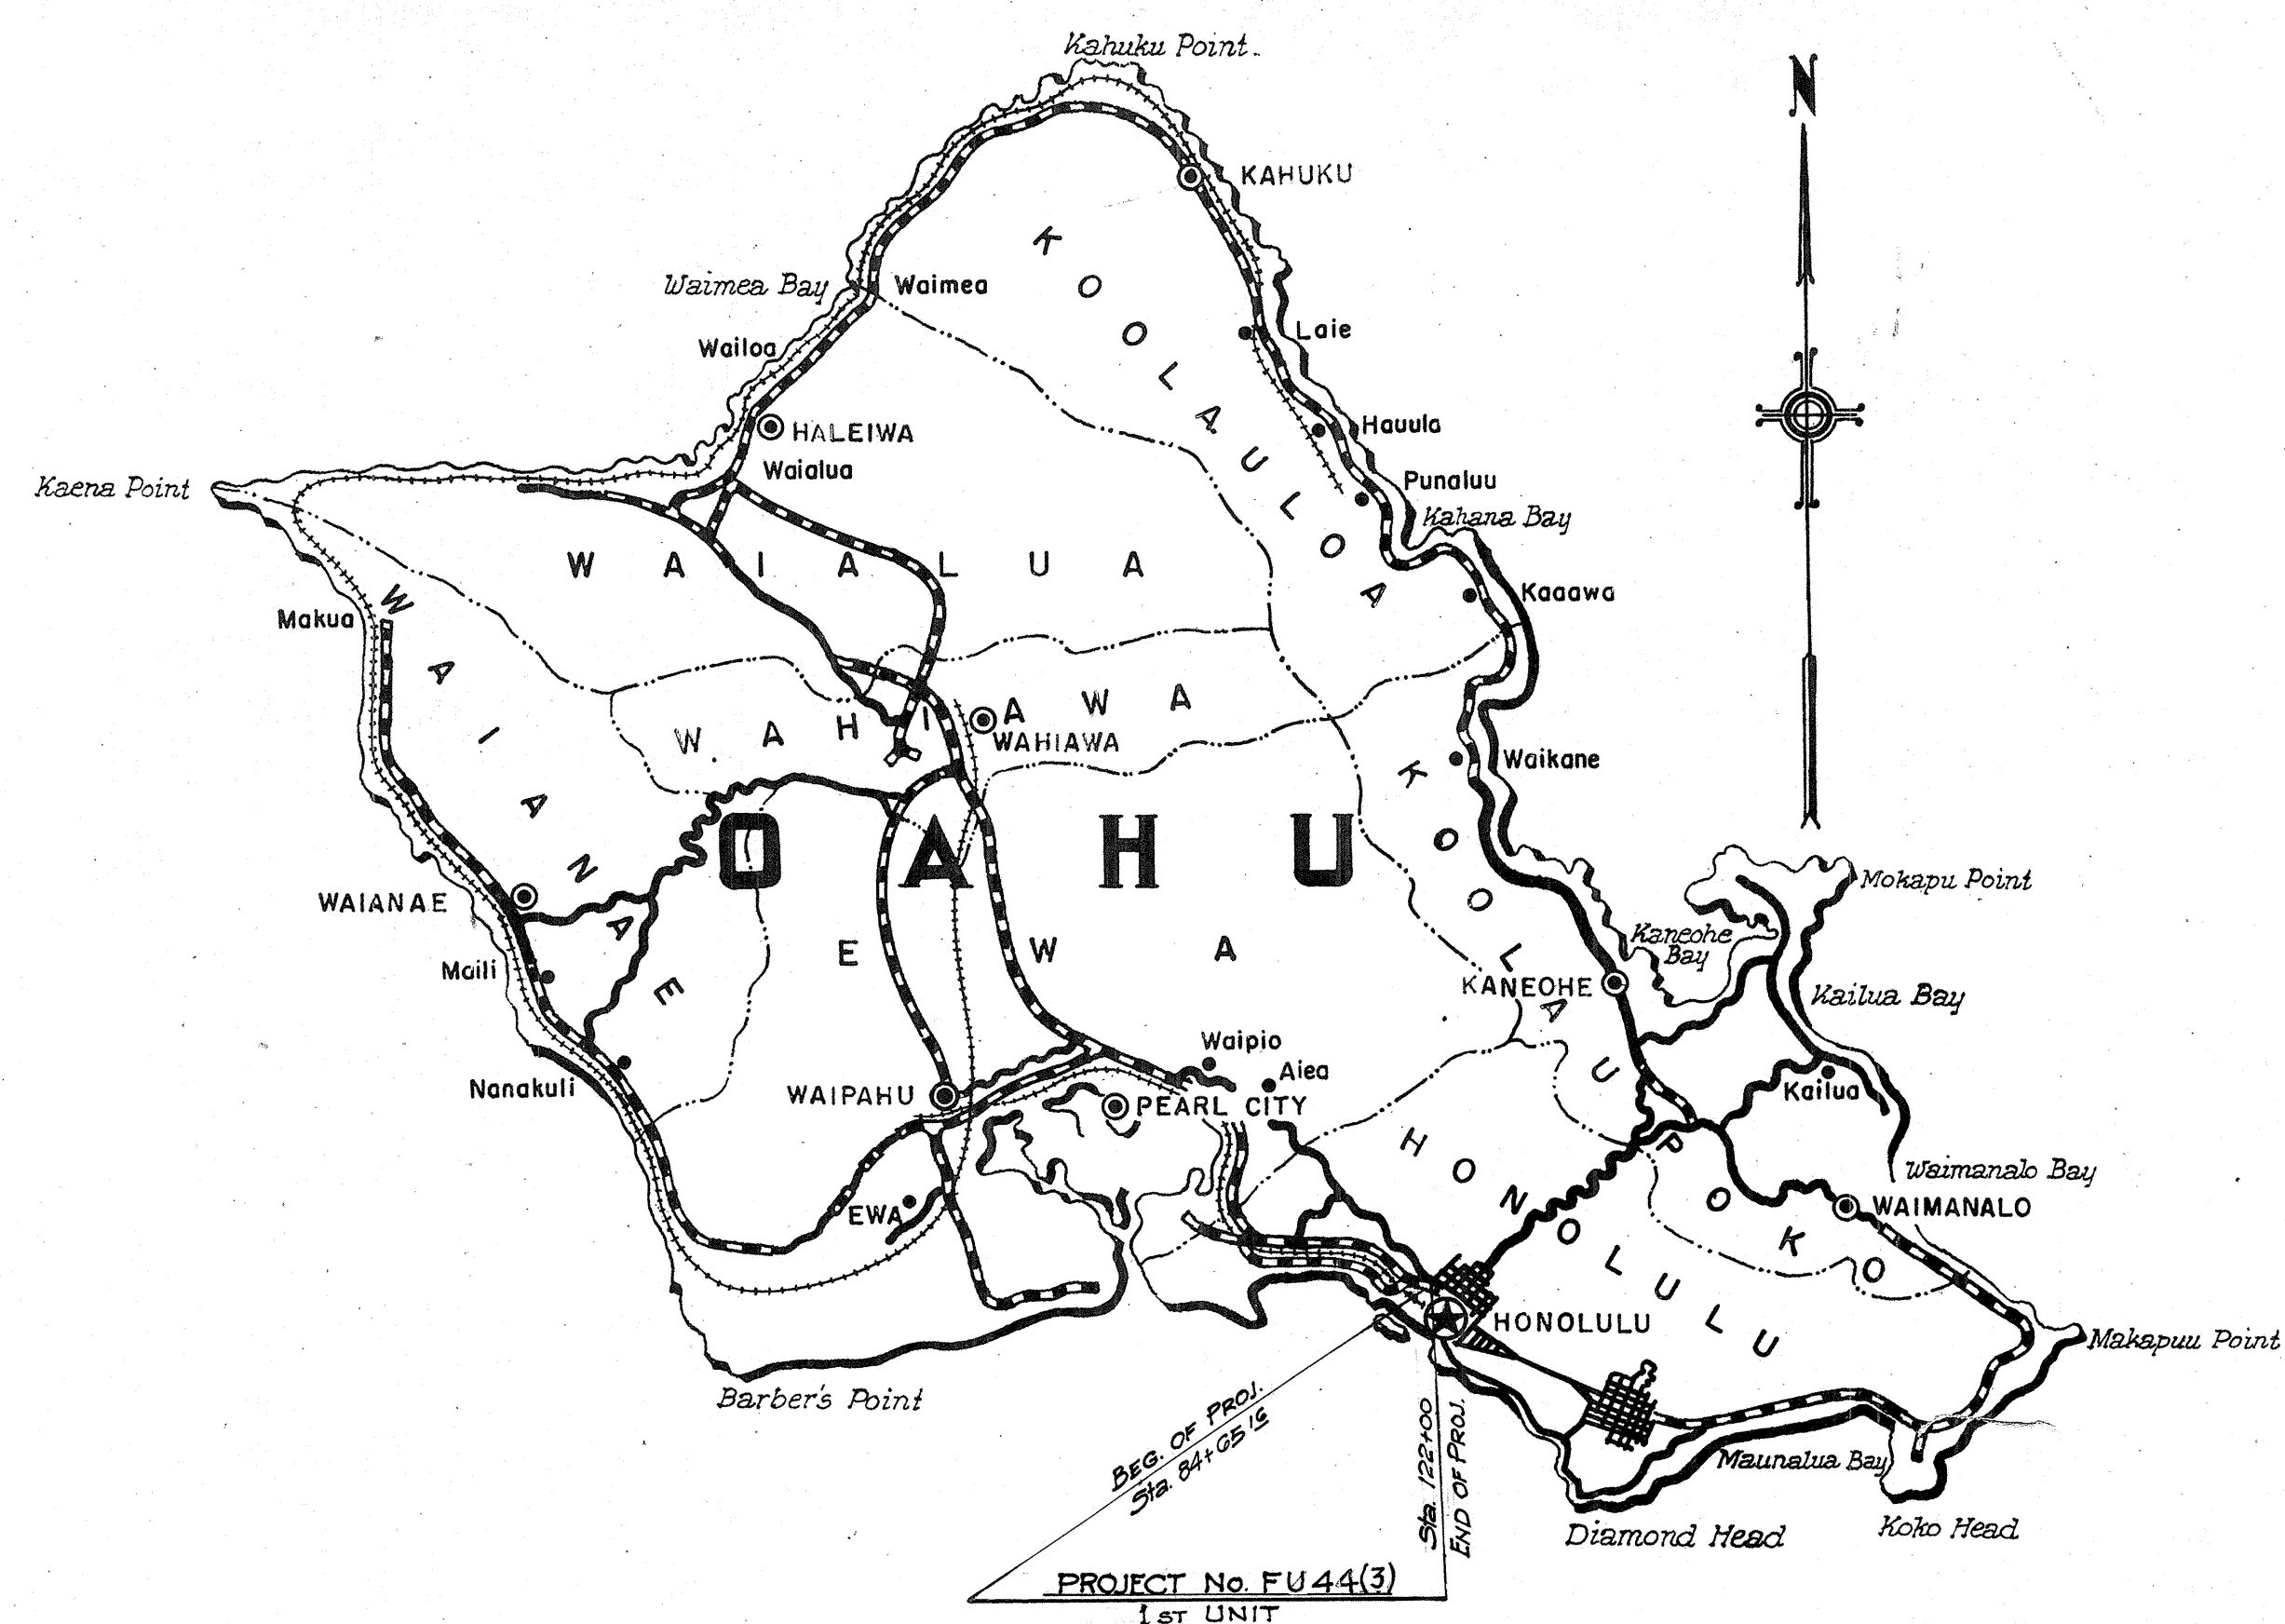

Federal Aid Projects Previously Constructed Or Under Construction

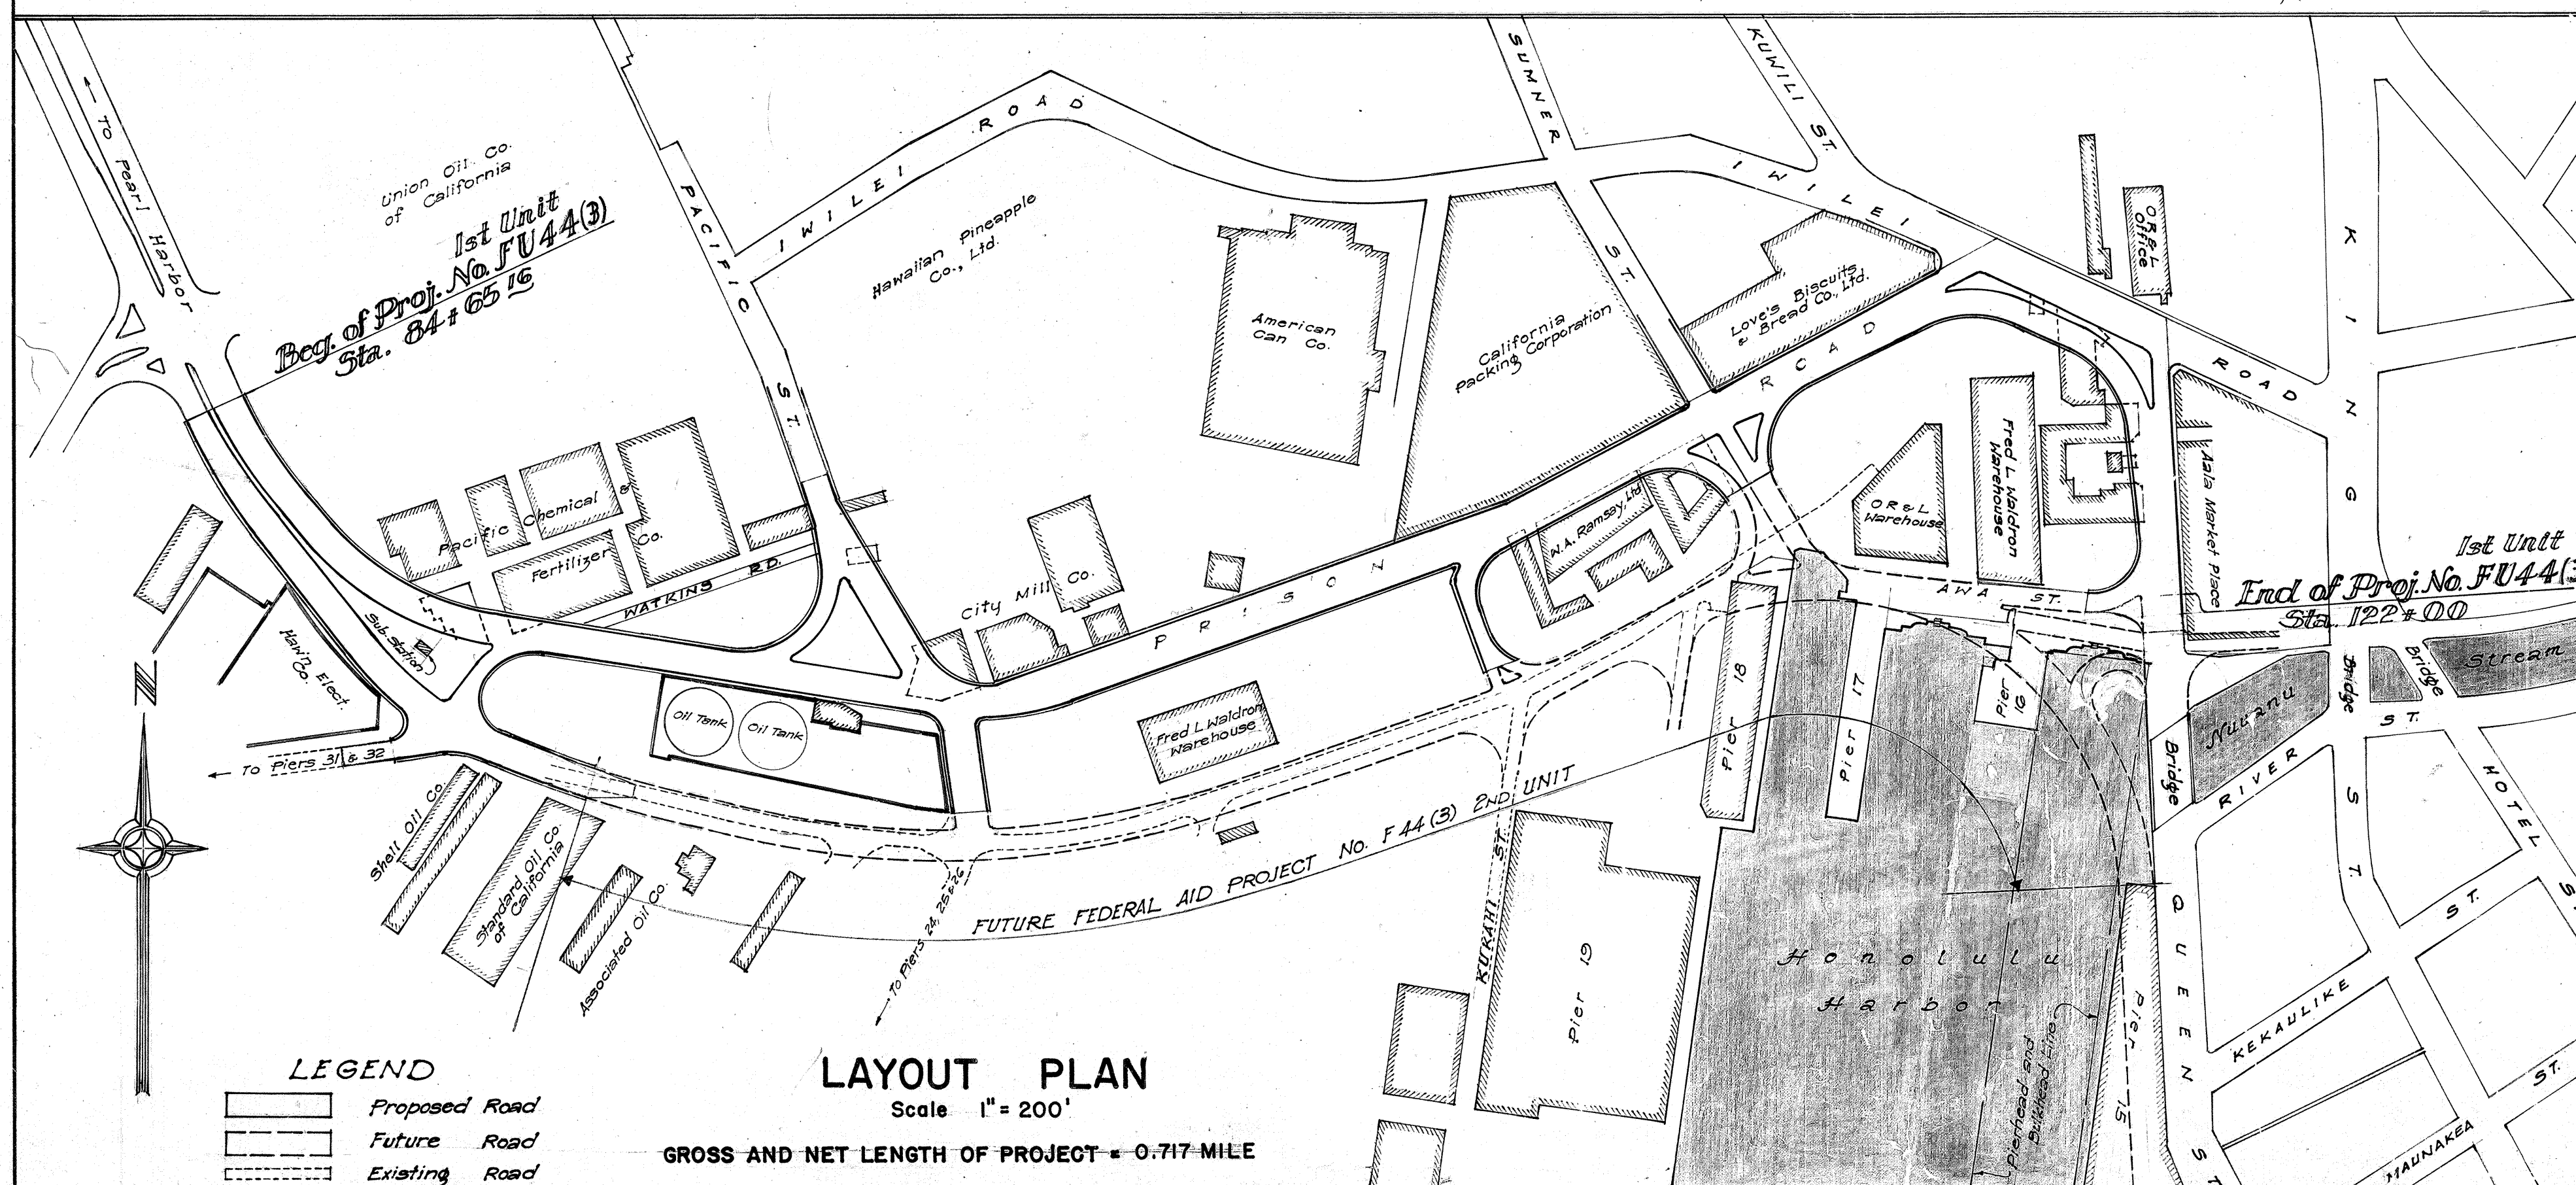

DATE	
SURVEY PLOTTED BY	
PLAN	
TRACED BY	
NOTE BOOK	
QUANTITIES CHECKED BY	
No.	

Note: All changes made during construction have been noted on these tracings and checked by:

Project Completed Aug 9, 1950

M. E. Williams
PROJECT ENGINEER
Date Aug 24, 1950

APPROVED DATE MAY 24, 1949
TERRITORIAL HIGHWAY ENGINEER

RECOMMENDED FOR APPROVAL	DATE
DISTRICT ENGINEER PUBLIC ROADS ADMINISTRATION FEDERAL WORKS AGENCY	
APPROVED	DATE
DIVISION ENGINEER PUBLIC ROADS ADMINISTRATION FEDERAL WORKS AGENCY	