


INDEX TO DRAWINGS	
SHEET NO.	DESCRIPTION
1	Title Sheet
2-3	Location of Borings


CONVENTIONAL SIGNS	
Centerline	125
Boundary Lines	or
Fences (Named)	
Existing Roadways	
Circular Culvert	
Box Culvert	
Bridge	
Telephone Pole	T.P.
Electric Power Pole	
Water Main	W ₂ W ₂ (W ₄ , 8, 12, Etc.)
Storm Drain	SD ₁₂ SD ₁₂ (SD ₁₈ , 24, Etc.)
Concrete Drop Intake	C.D.I.
Standard Catch Basin	S.C.B.
Standard Manhole	M.H.S.
Sewer Manhole	S.S. S.S. (S ₁₂)
Telephone Manhole	T.M.H.
Fire Hydrant	F.H.
Tree (Large, named)	Mango Coco
Railroad	

TERRITORY OF HAWAII
TERRITORIAL HIGHWAY DEPARTMENT
HONOLULU, OAHU, T. H.

PLANS FOR
SUB-STRATA INVESTIGATION
HONOLULU PEARL HARBOR ROAD
QUEEN STREET SECTION
PORTION OF
FEDERAL AID PROJECT NO. SN(PE) FAP 44A(I)
DISTRICT OF HONOLULU
ISLAND OF OAHU

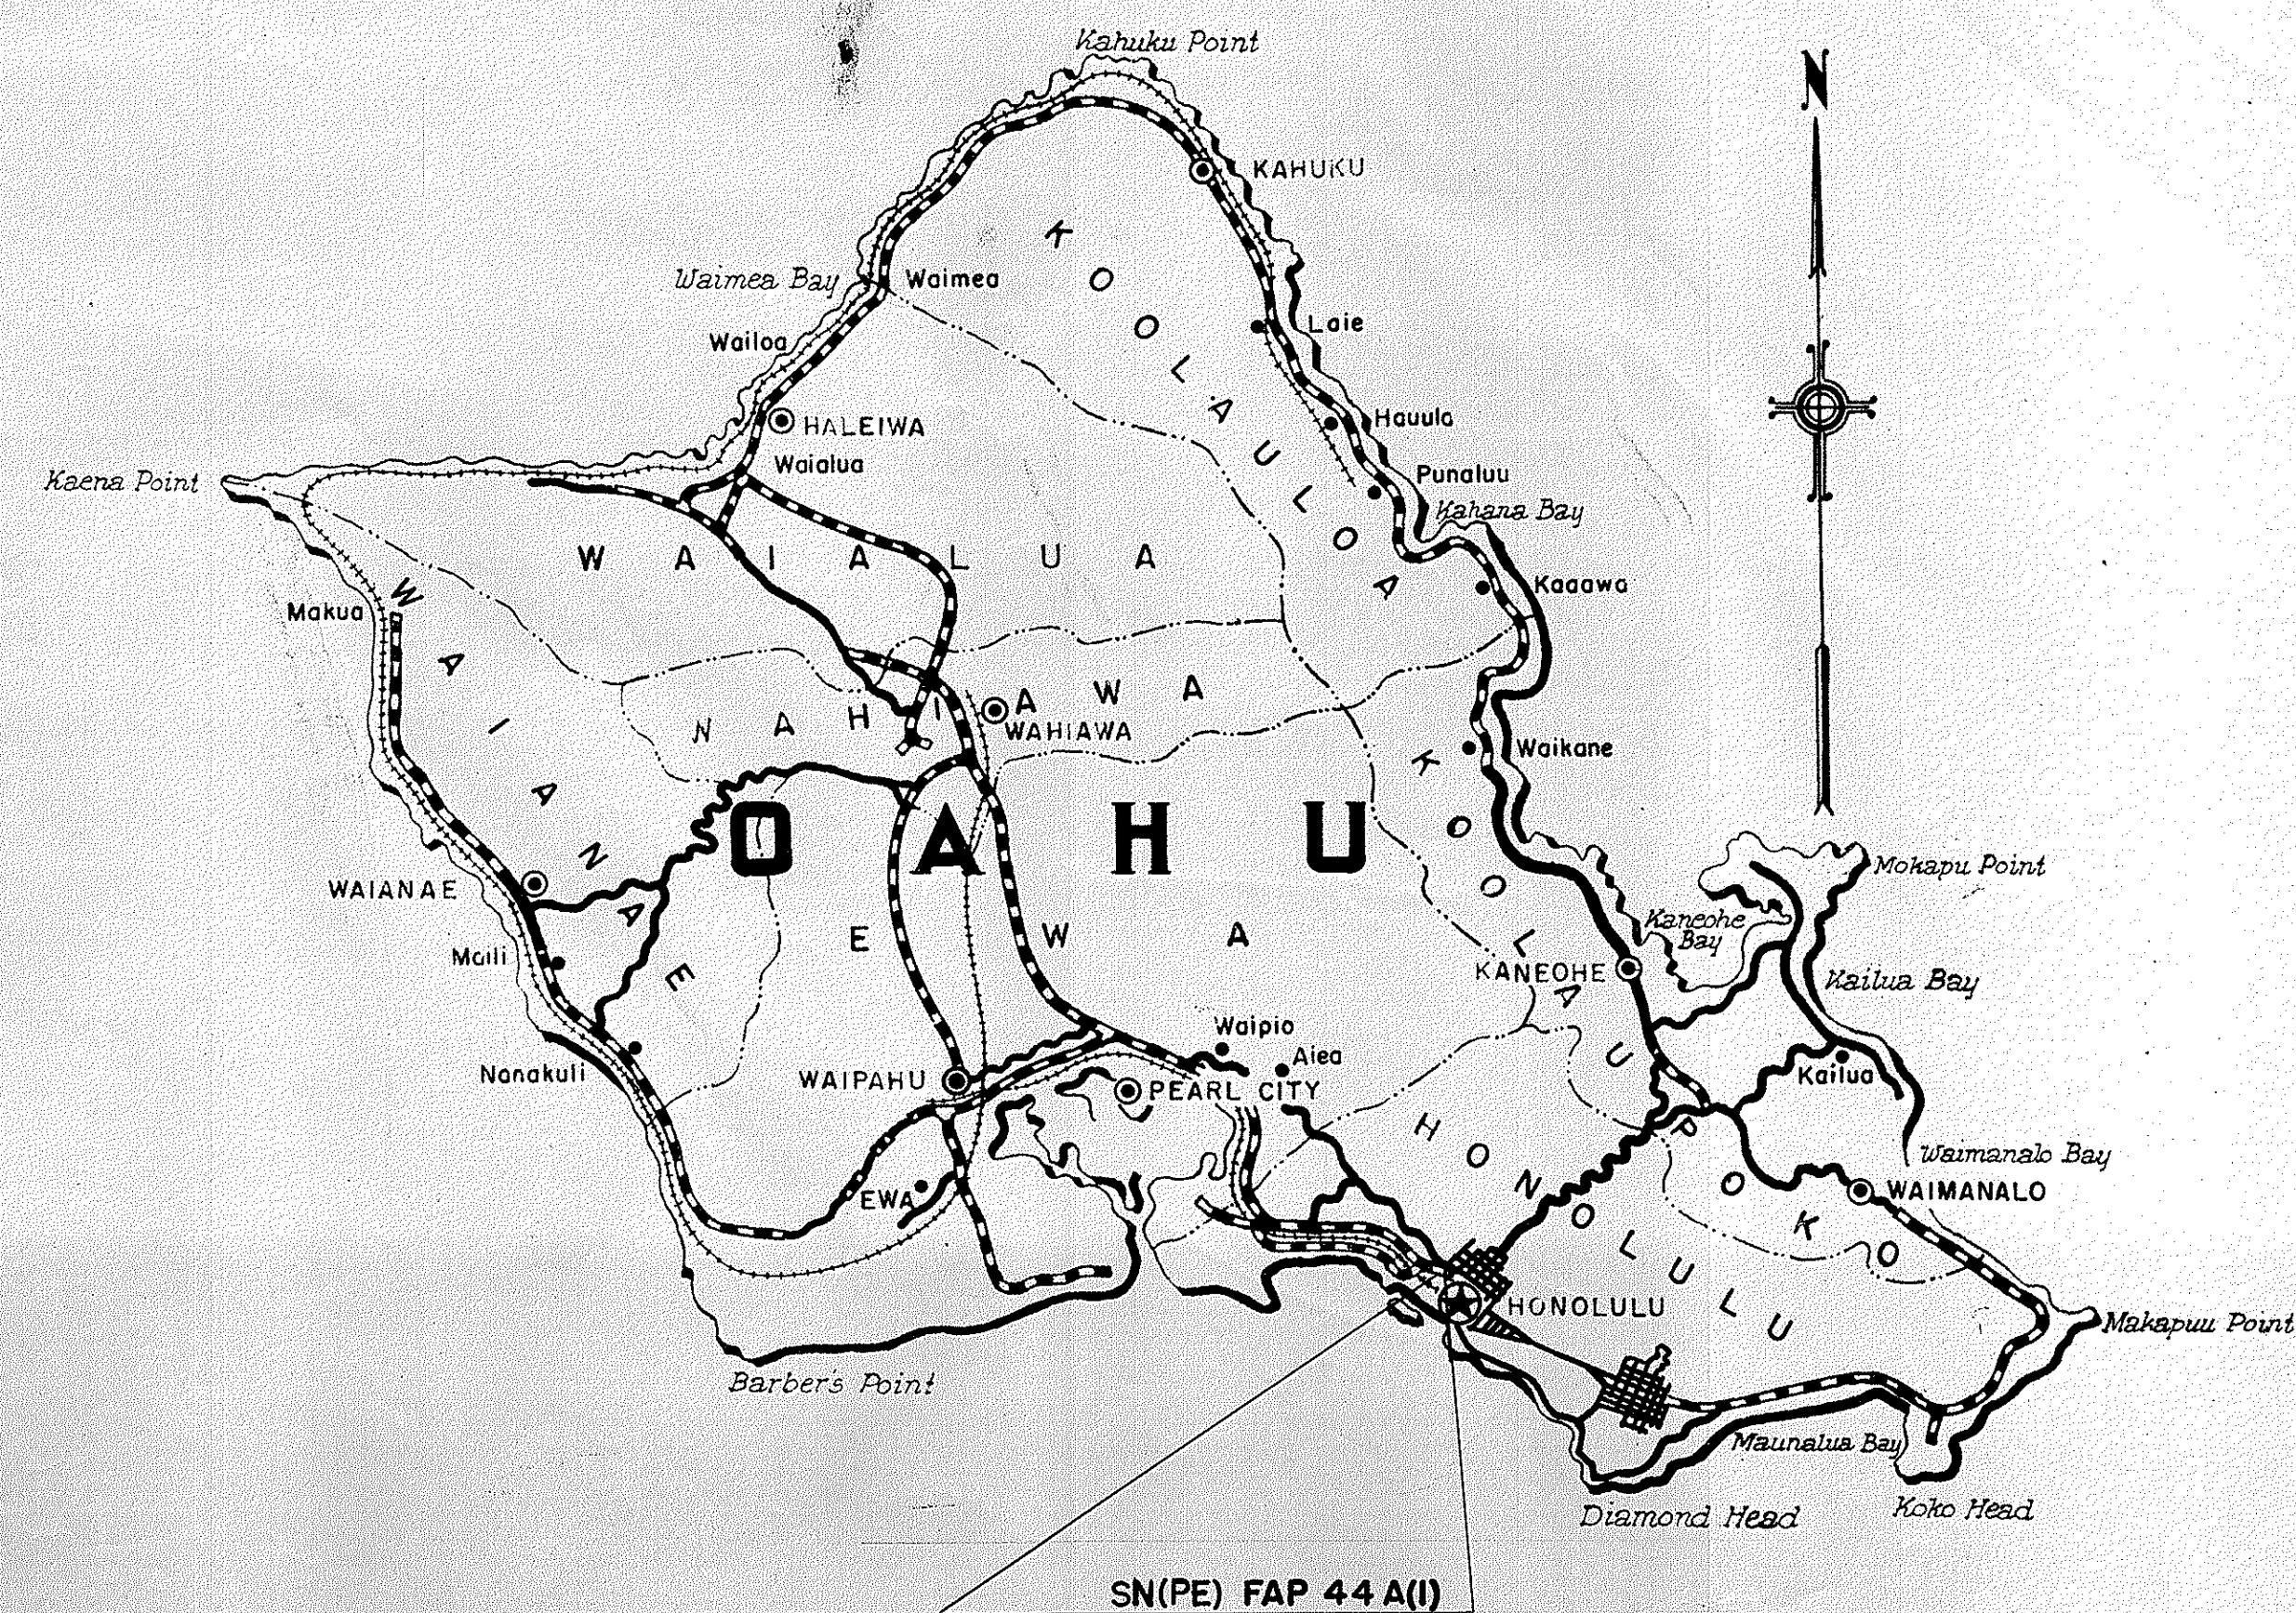

Federal Aid Projects Previously Constructed Or Under Construction

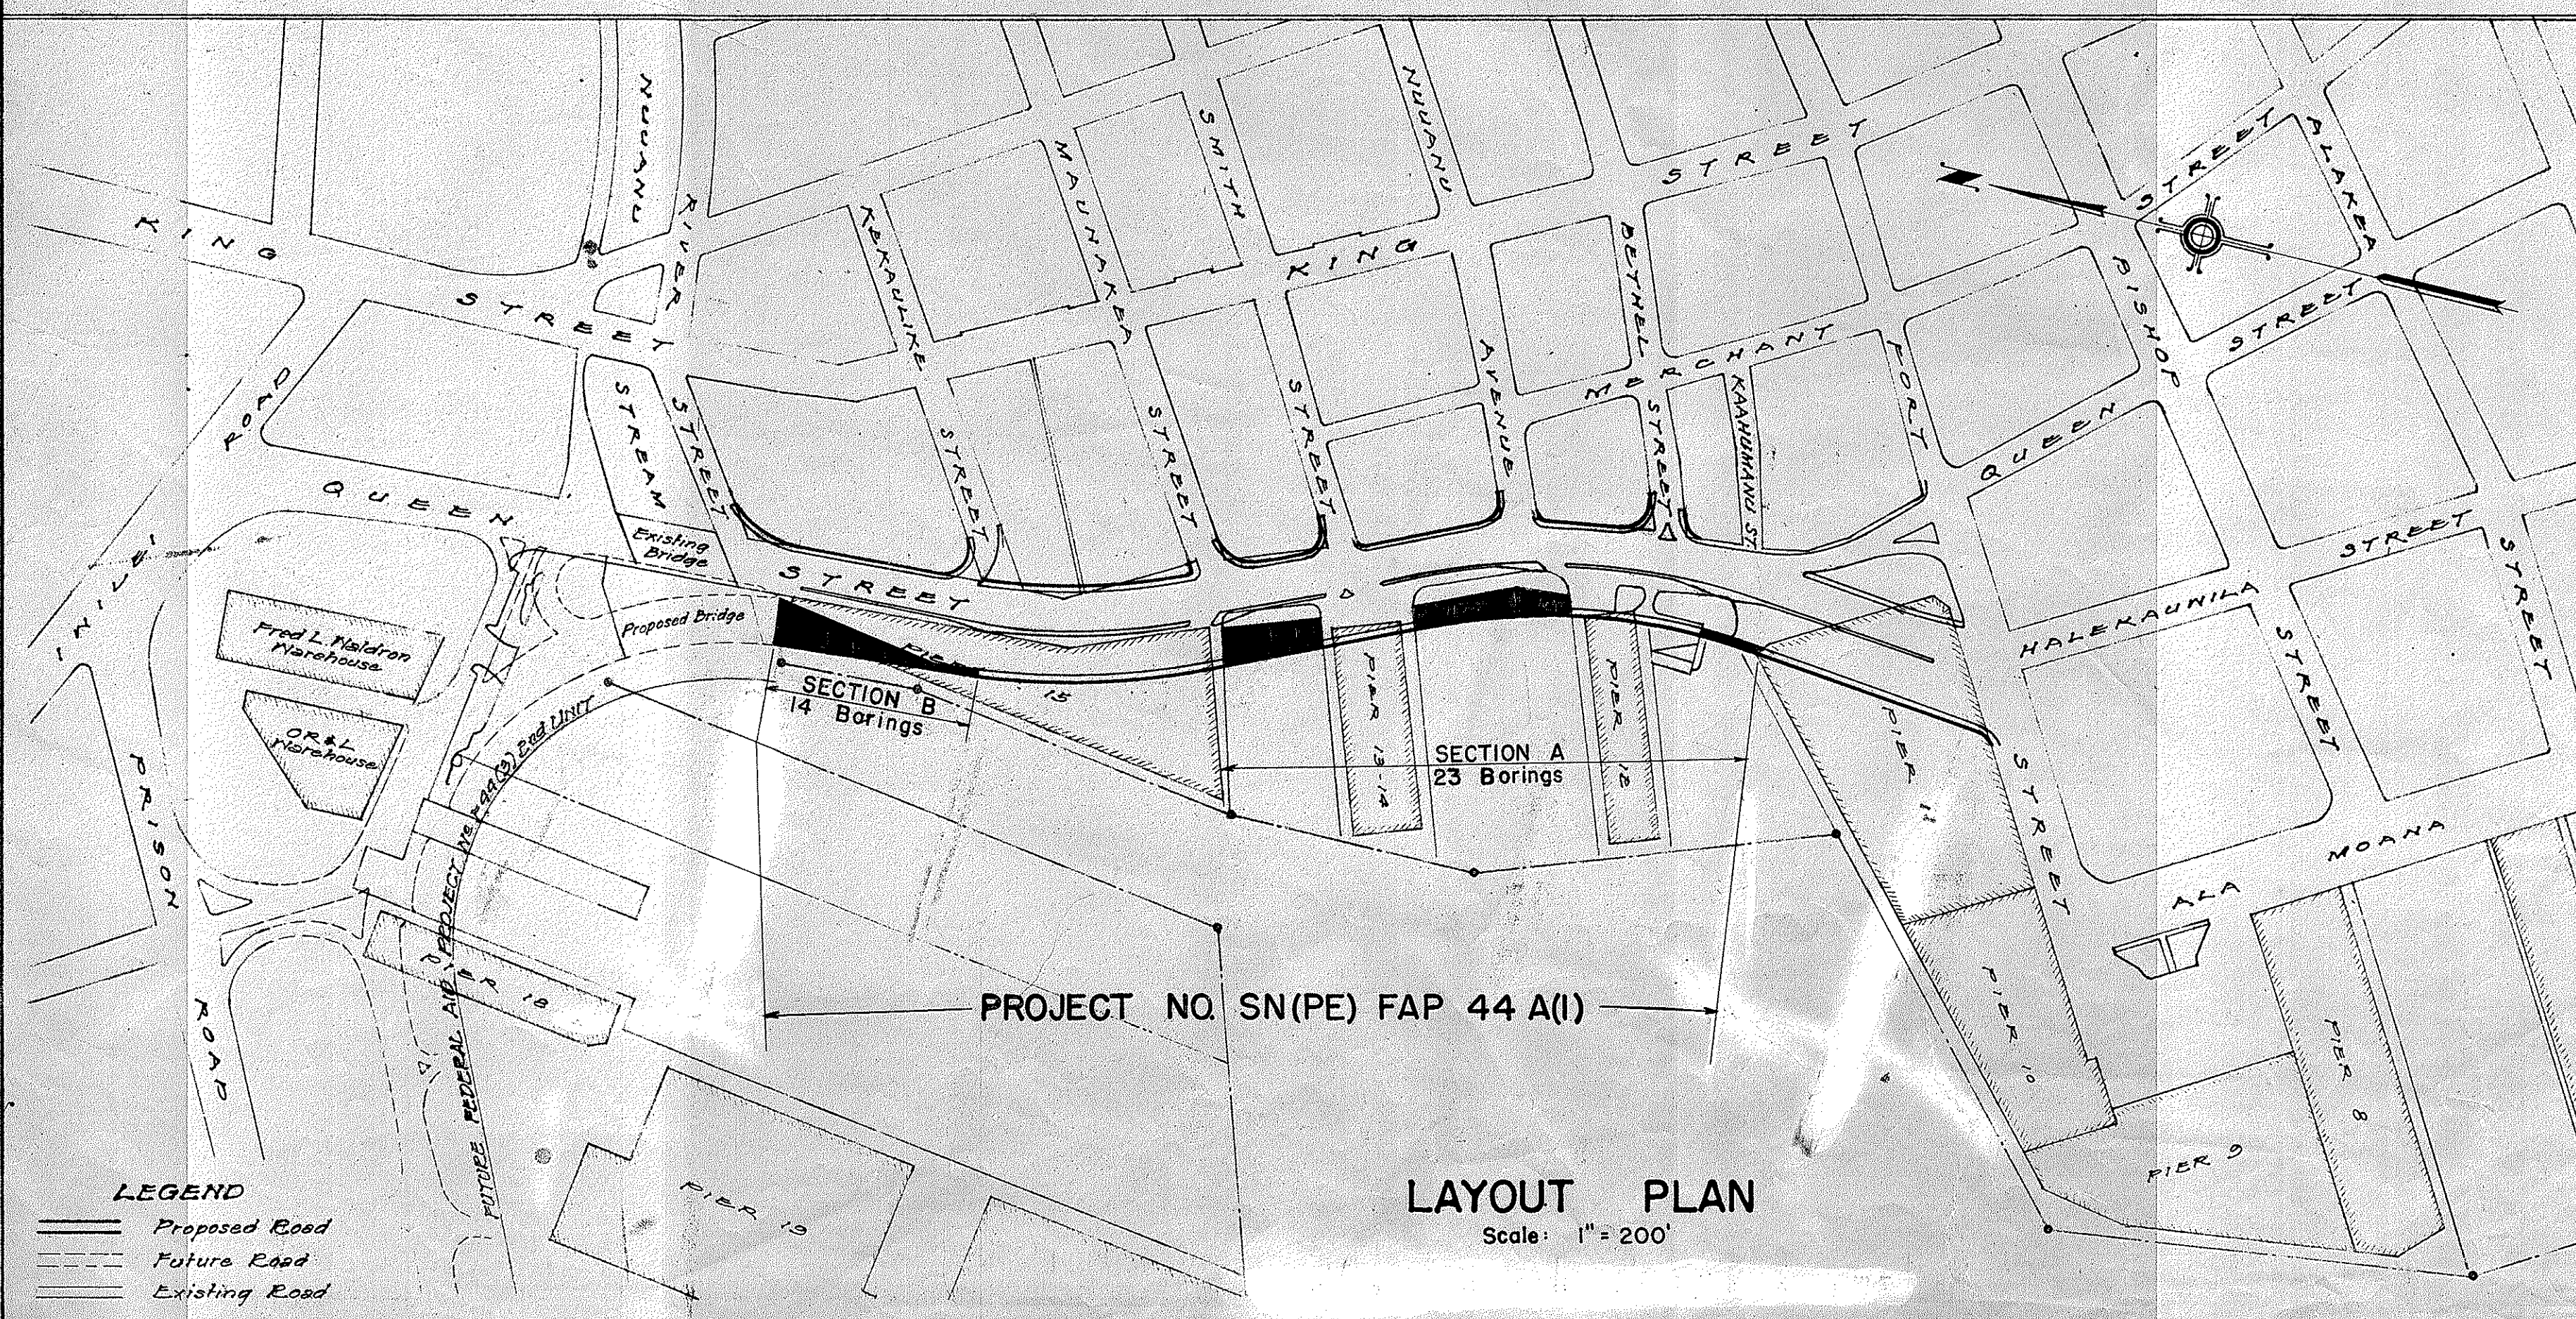

"As-Drilled" holes are shown in red in the original tracing. A log of each hole drilled is shown in sheets 5459.3A, 5459.3B & 5459.3C.

L.C. Pinto
Proj. Engineer
6/15/50

RECOMMENDED FOR APPROVAL DATE

DISTRICT ENGINEER
PUBLIC ROADS ADMINISTRATION
FEDERAL WORKS AGENCY

APPROVED DATE

DIVISION ENGINEER
PUBLIC ROADS ADMINISTRATION
FEDERAL WORKS AGENCY

APPROVED DATE January 24, 1950
Territorial Highway Engineer

5459.1