

FED. ROAD DIST. NO.	STATE	FED. AID PROJ. NO.	FISCAL YEAR	SHEET NO.	TOTAL SHEETS
HAWAII	HAW	FU44(5) UNIT 2	1950	7	75



SURVEY NOTED BY	DATE
DESIGNED BY	
DRAWN BY	
NOTED BY	
QUANTITIES CHECKED BY	
NOTE BOOK	
NO.	


TERRITORIAL HIGHWAY DEPARTMENT
 TERRITORY OF HAWAII
 DETAIL PLAN OF ROADWAY
 HONOLULU - PEARL HARBOR ROAD
 QUEEN STREET SECTION
 PROJECT NO. FU44(5)
 Scale: 1 in. = 20 ft. Mar. 1950

SHEET No 2 OF 4 SHEETS

5483.7



FED. ROAD DIST. NO.	STATE	FED. AID PROJ. NO.	FISCAL YEAR	SHEET NO.	TOTAL SHEETS
HAWAII	HAW	FU 44(5)	1950	9a	75

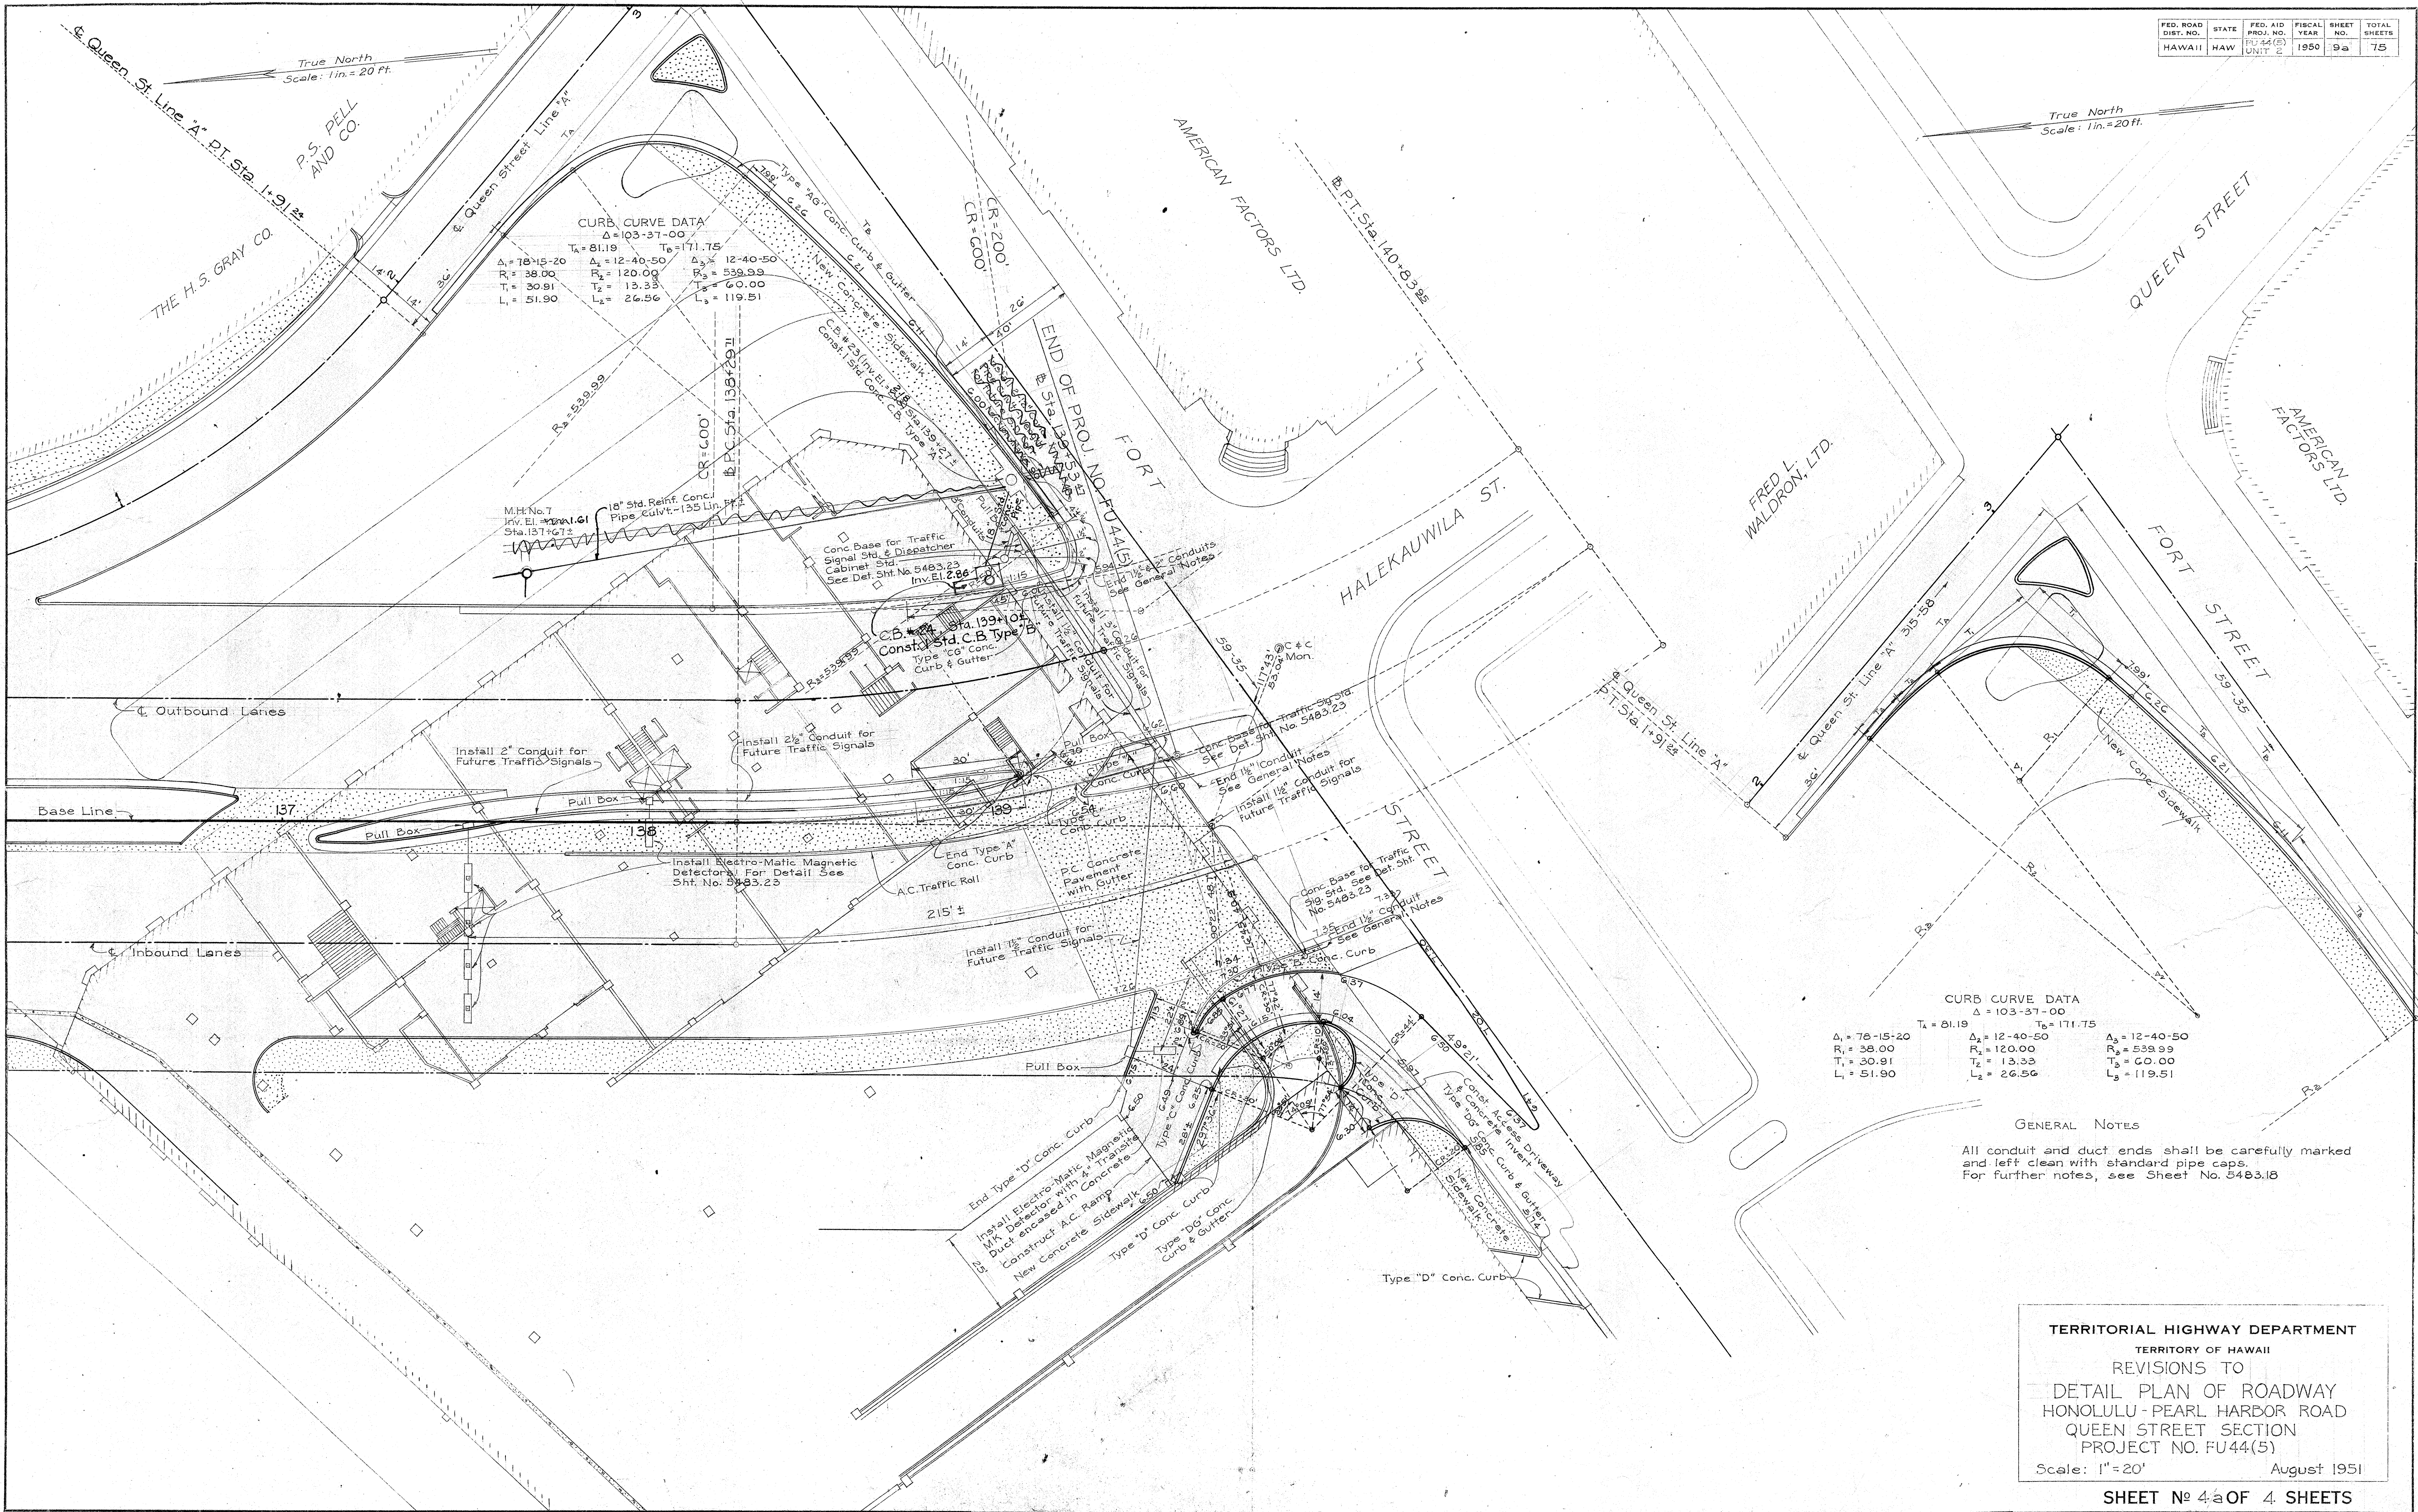

SURVEY PLOTTED BY	DATE
TRACED BY	
DRAWN BY	
CHECKED BY	
QUANTITIES CHECKED BY	
NOTE BOOK	
No.	

TERRITORIAL HIGHWAY DEPARTMENT
TERRITORY OF HAWAII
REVISIONS TO
DETAIL PLAN OF ROADWAY
HONOLULU - PEARL HARBOR ROAD
QUEEN STREET SECTION
PROJECT NO. FU44(5)
Scale: 1"=20' August 1951
SHEET No 4a OF 4 SHEETS

5483.9A