

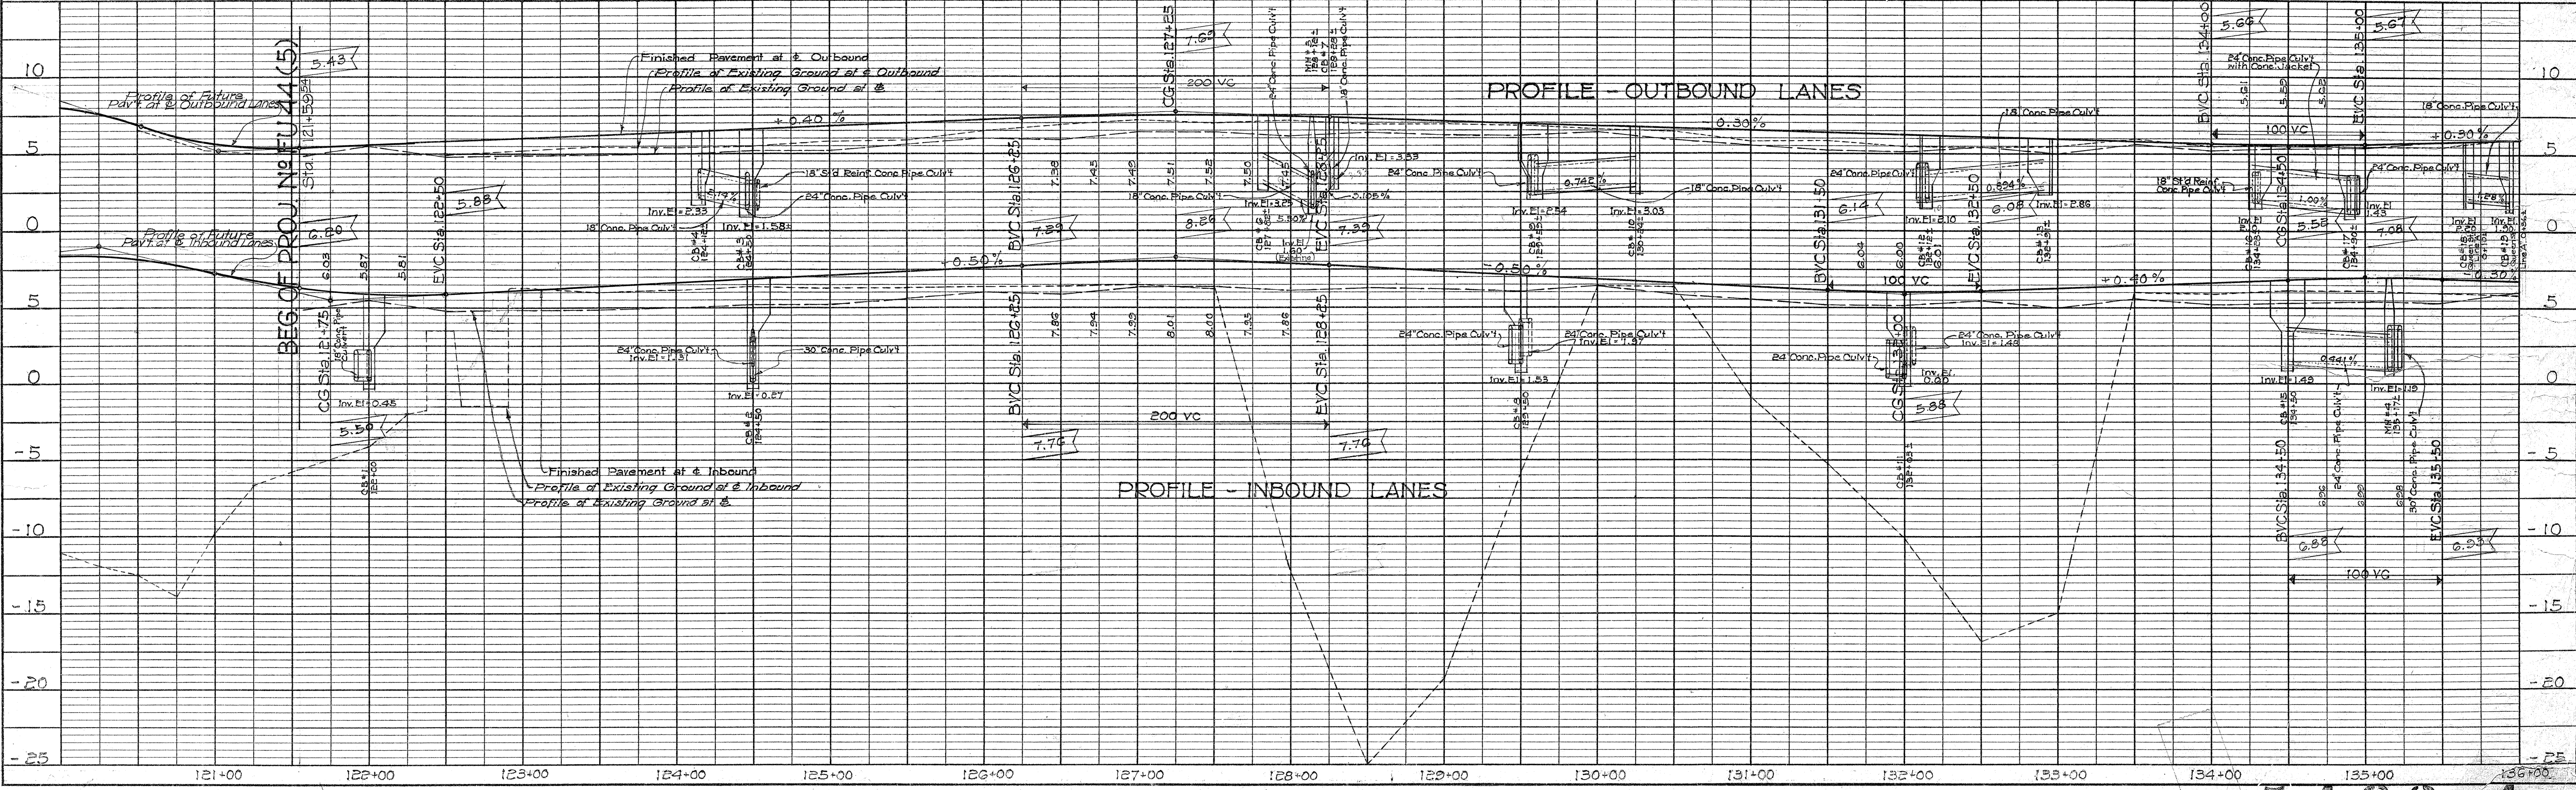


PLAN	DATE	BY
SURVEYED		
NOTE BOOK		
ALIGNED CHECKED		
RT. OF WAY CHECKED		
NO.		

PROFILE	DATE	BY
SURVEYED		
NOTE BOOK		
GRADES CHECKED		
B. M.3 NOTED		
STRUCTURE NOTING CHD.		
NO.		

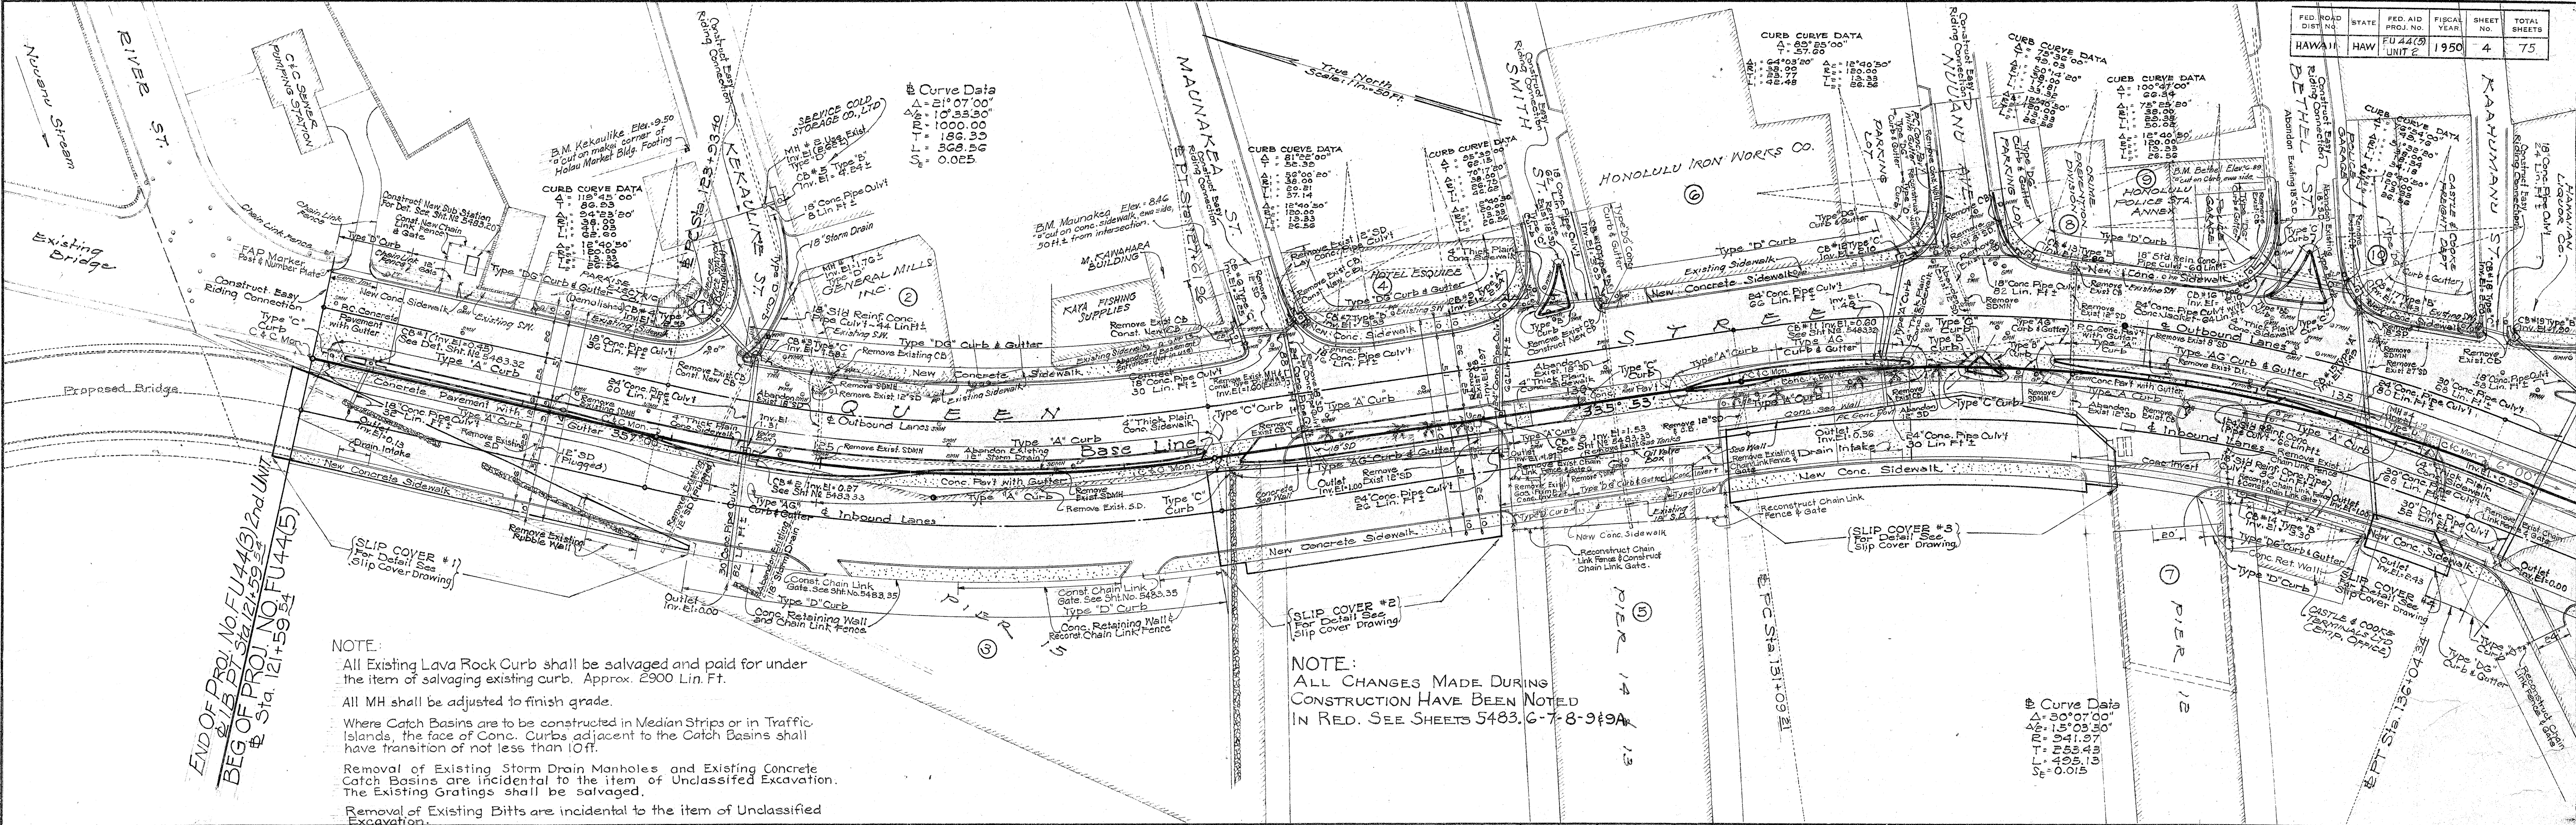

PLAN	SURVEYED	DATE
NO.	BY	
NOTE BOOK	PLOTTED	
NO.	ALIGNMENT CHECKED	
	BY	

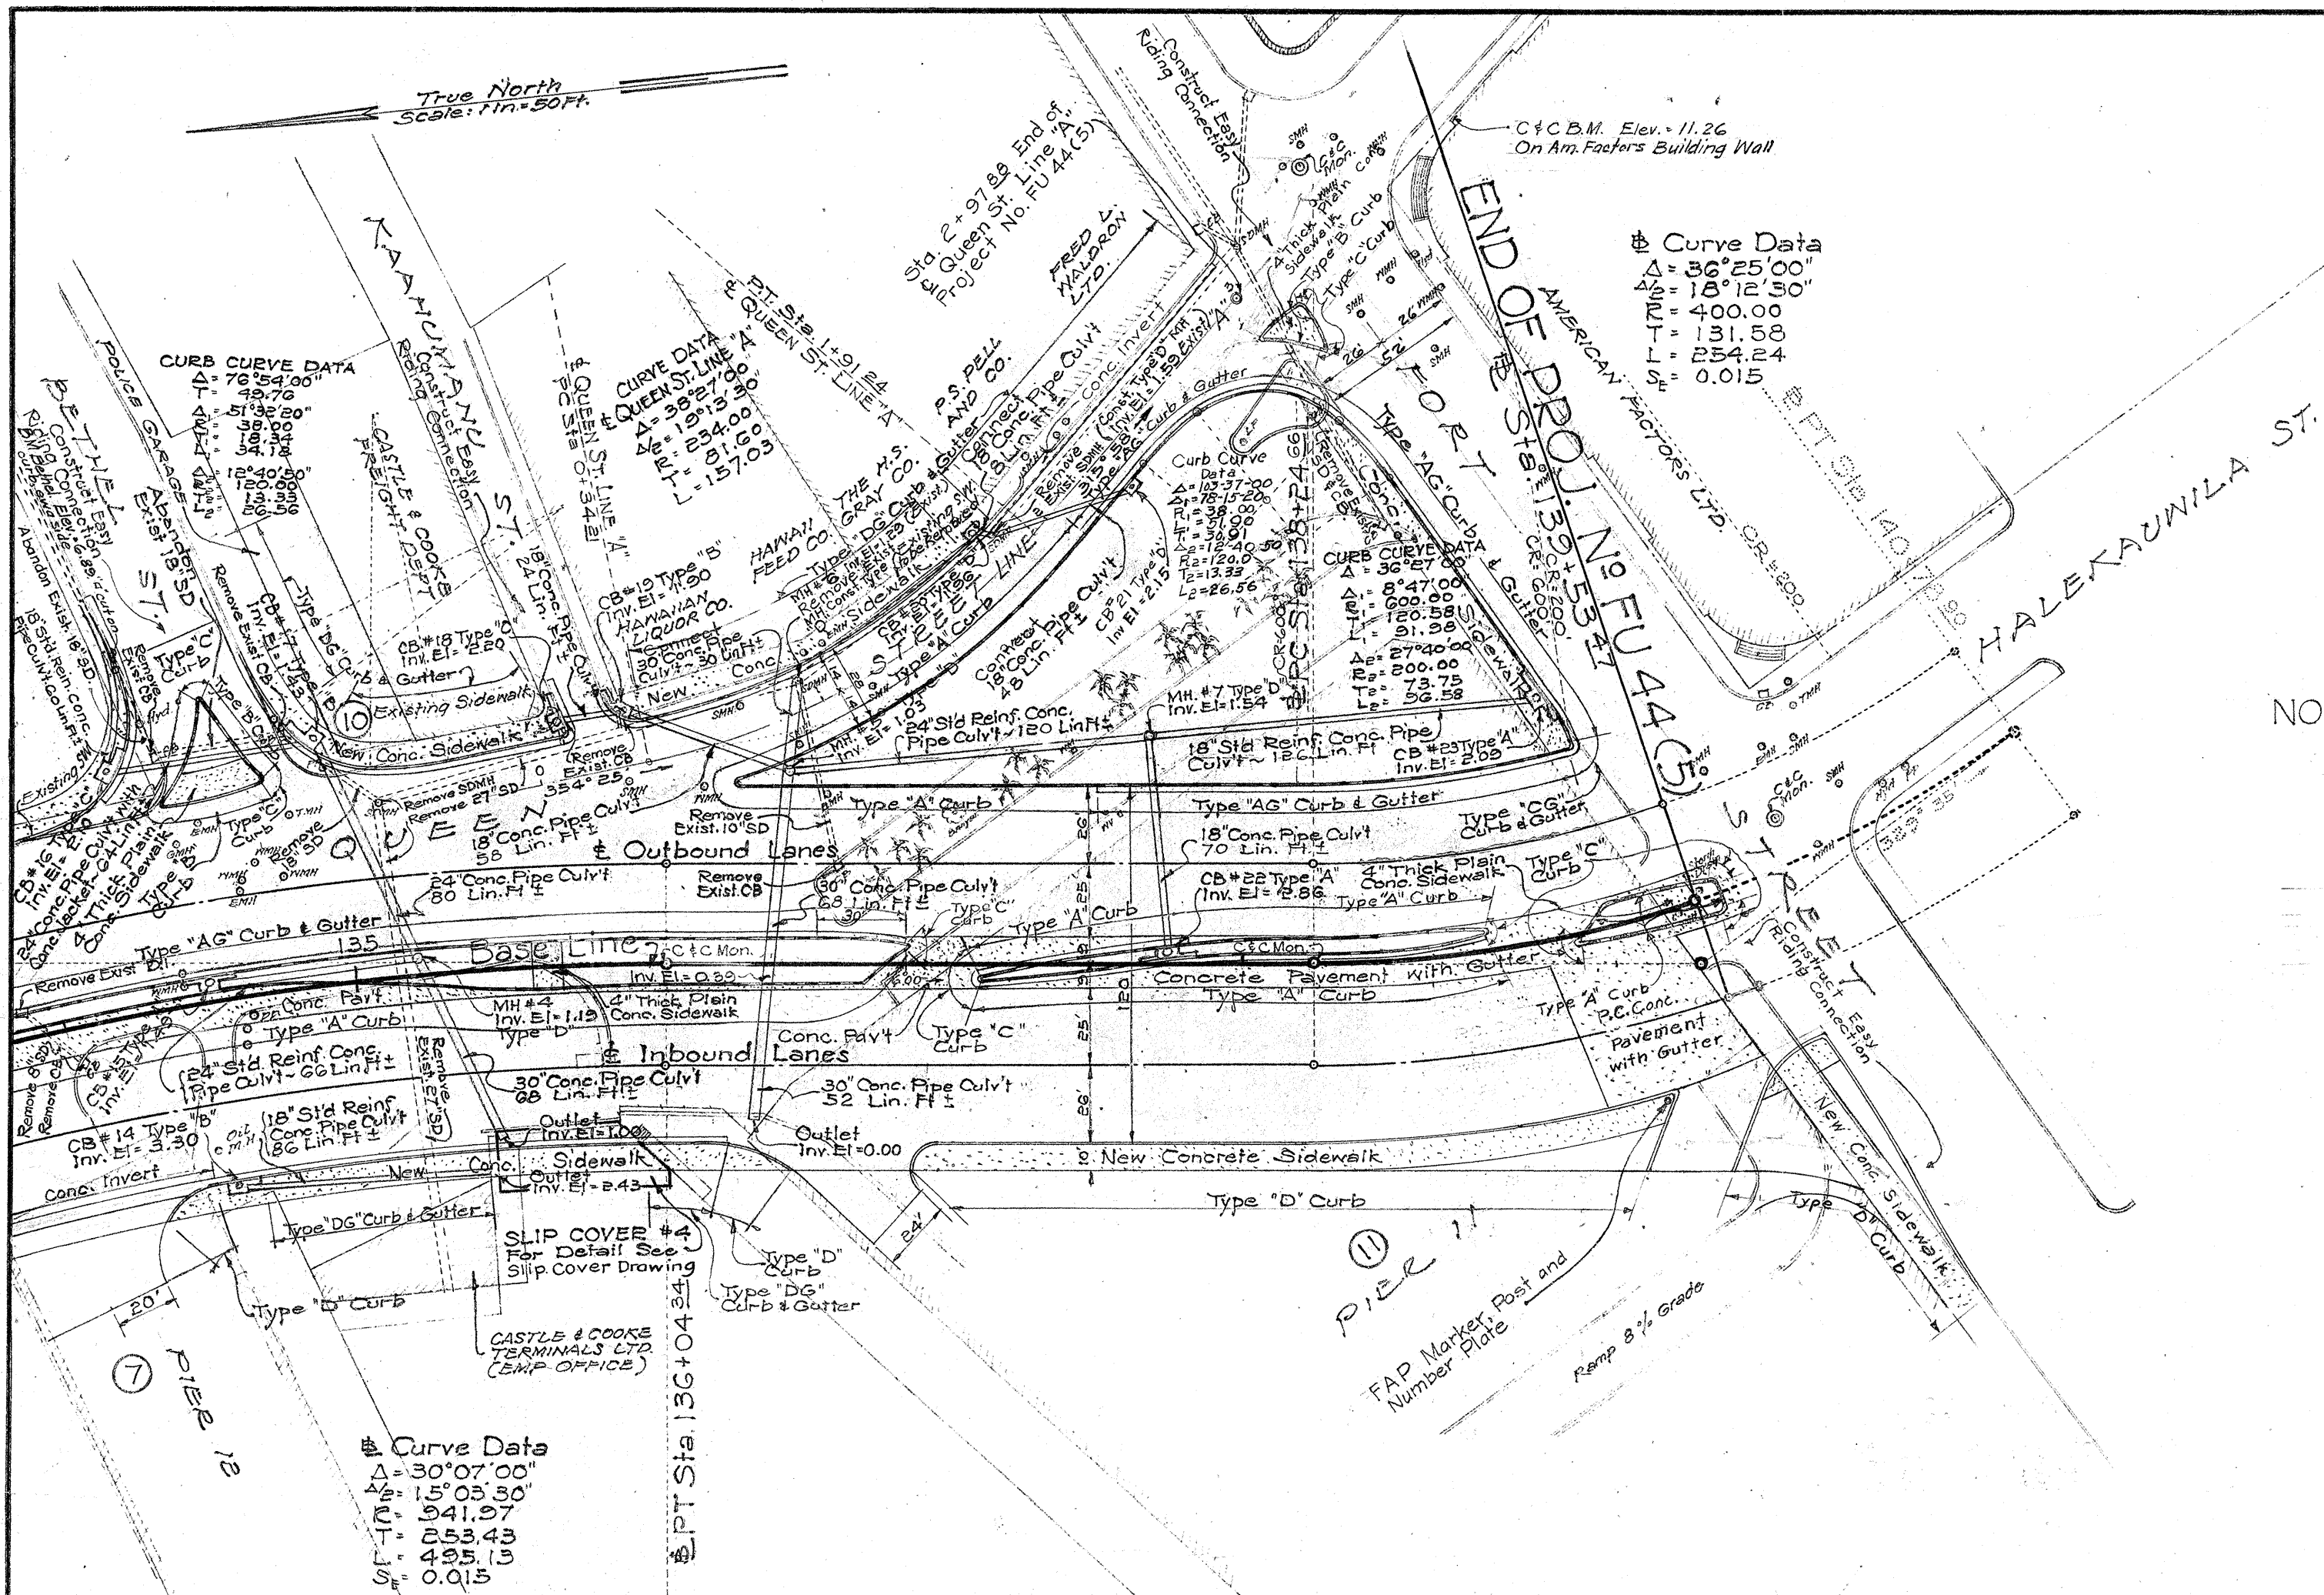

NOTE:

See Sht. No. 5483.9a for Details of Changes to Plan at Fort Street and Halekauwila Street. Revised August 1951.

ALL CHANGES MADE DURING CONSTRUCTION HAVE BEEN NOTED IN RED. SEE SHEETS 5483.8-9 & 9A

PROFILE	SURVEYED _____	BY _____	DATE _____
	PLOTTED _____		
NOTE BOOK	GRADES CHECKED _____		
	B. M'S NOTED _____		
NO. _____	STRUCTURE NOTATIONS CH'KD. _____		

