

INDEX TO DRAWINGS	
SHEET NO.	DESCRIPTION
1	Title Sheet
2 - 3	Typical Sections
4 - 5	Plan and Profile
6 - 9	Detail Plan of Roadway
10 - 11	Plan of Water System
12 - 13	Utilities
14 - 17	Oil Lines
18 - 20	Highway Lighting System
21 - 23	Traffic Signal System
24 - 26	Traffic Signs and Pavement Markings
27 - 31	Landscape Plans and Sprinkler System
32 - 33	Special Catch Basin and Type "D" Manhole
34 -	Adjustment of Entrances
35 -	Estimated Quantities of Structures
36 -	Location of Waste Area
37 - 40	Standard Details
41 - 48	Cross Sections
49 - 75	Slip Covers

CONVENTIONAL SIGNS	
Centerline	125
Boundary Lines	or
Fences (Named)	
Existing Roadways	
Circular Culvert	
Box Culvert	
Bridge	
Telephone Pole	
Electric Power Pole	
Water Main	W ₂ W ₂ (W ₄ , 8, 12, Etc.)
Storm Drain	SD ₁₂ SD ₁₂ (SD ₁₈ , 24, Etc.)
Concrete Drop Intake	C.D.I.
Standard Catch Basin	S.C.B.
Standard Manhole	M.H.S.
Sewer Manhole	S.S. S.S. (S ₁₂ S ₁₂)
Telephone Manhole	T.M.H.
Fire Hydrant	F.H.
Tree (Large, named)	Mano Coco
Railroad	

TERRITORY OF HAWAII
TERRITORIAL HIGHWAY DEPARTMENT
HONOLULU, OAHU, T. H.


PLANS OF HONOLULU PEARL HARBOR ROAD QUEEN STREET SECTION

FEDERAL AID URBAN PROJECT NO.FU 44(5) UNIT 2

DISTRICT OF HONOLULU
ISLAND OF OAHU

SCALES


PLAN	1 INCH = 50 FEET
PROFILE	HOR. 1 INCH = 50 FEET VER. 1 INCH = 5 FEET
CROSS SECTIONS	HOR. 1 INCH = 10 FEET VER. 1 INCH = 5 FEET

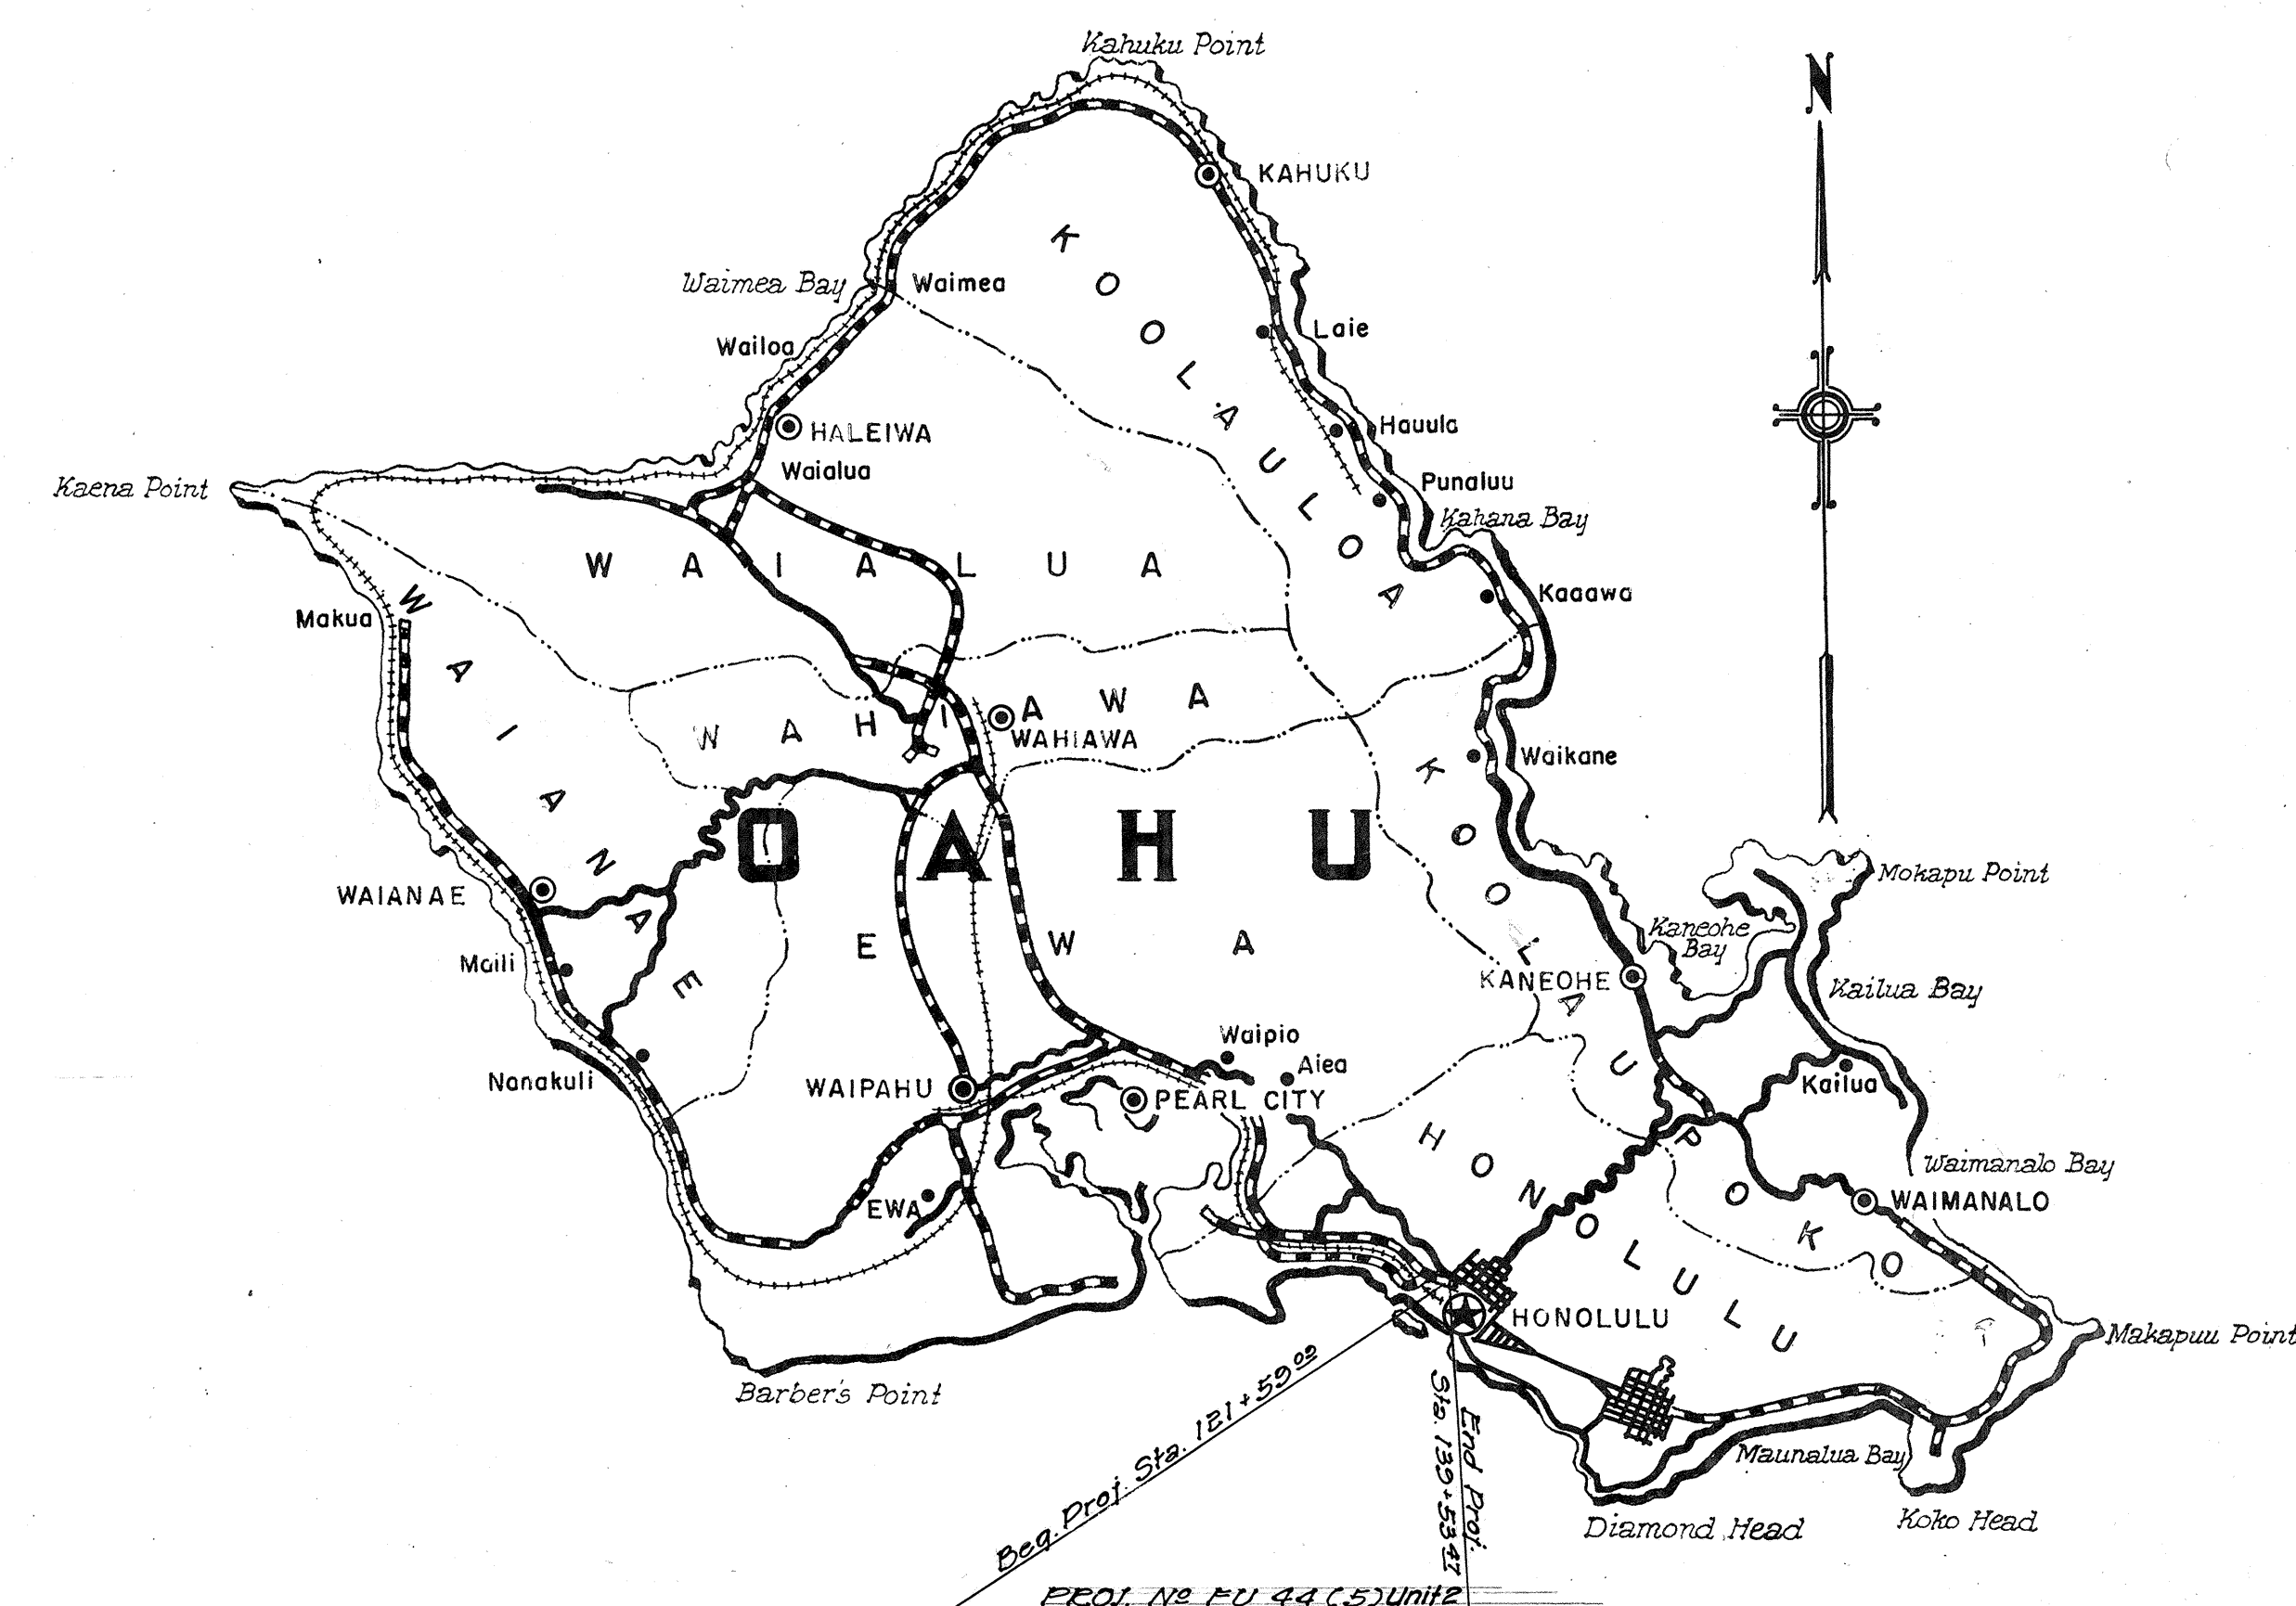

Federal Aid Projects Previously Constructed Or Under Construction

NOTE:
All changes made during construction
have been noted in RED in these plans
and checked by:

George T. Okamoto
Project Engineer
Date: 11-10-52

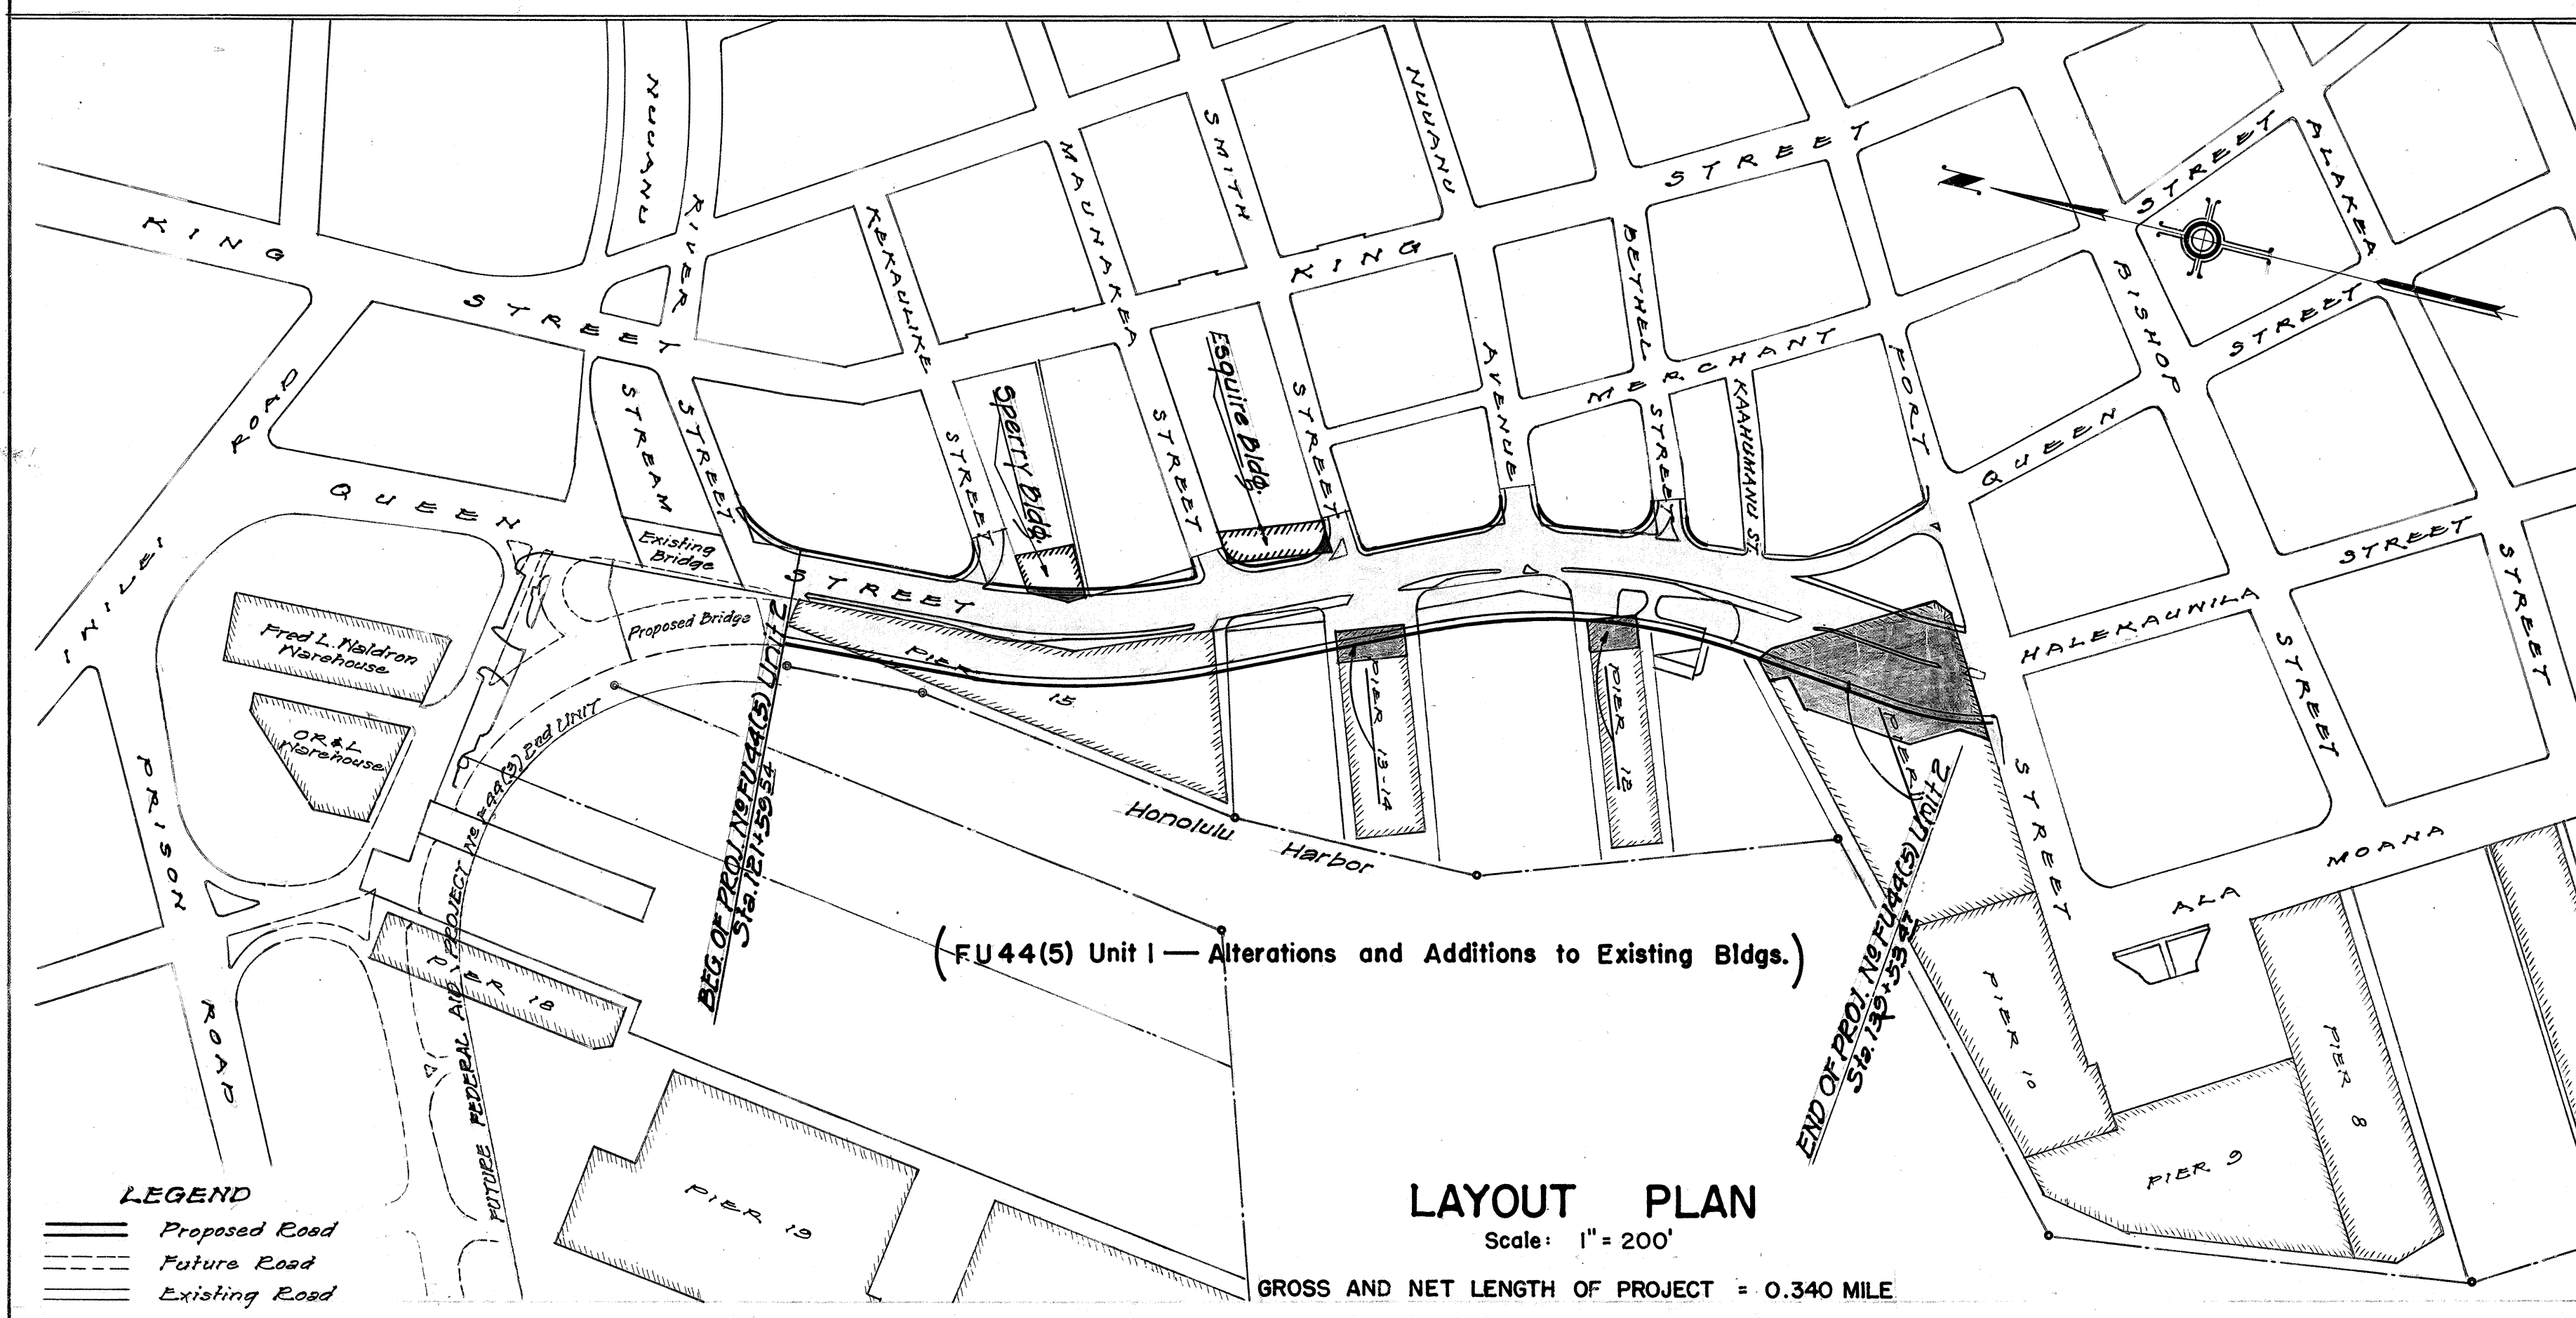

APPROVED
DATE July 24, 1950
TERRITORIAL HIGHWAY ENGINEER

DEPARTMENT OF COMMERCE
BUREAU OF PUBLIC ROADS
RECOMMENDED FOR APPROVAL:
DISTRICT ENGINEER
DATE
APPROVED:
DIVISION ENGINEER
DATE

5483.1