





FED. ROAD DIST. NO.	STATE	FED. AID PROJ. NO.	FISCAL YEAR	SHEET NO.	TOTAL SHEETS
HAWAII	HAW	FU44(5) UNIT 2	1950	13	75

PLAN	SURVEYED	DATE
NO.	BY	
NOTE BOOK	PLOTTED	
ALIGNMENT CHECKED	BY	
RT. OF WAY CHECKED	BY	

PROFILE	SURVEYED	DATE
NO.	BY	
GRADES CHECKED	BY	
STRUCTURE NOTATIONS CHECKED	BY	

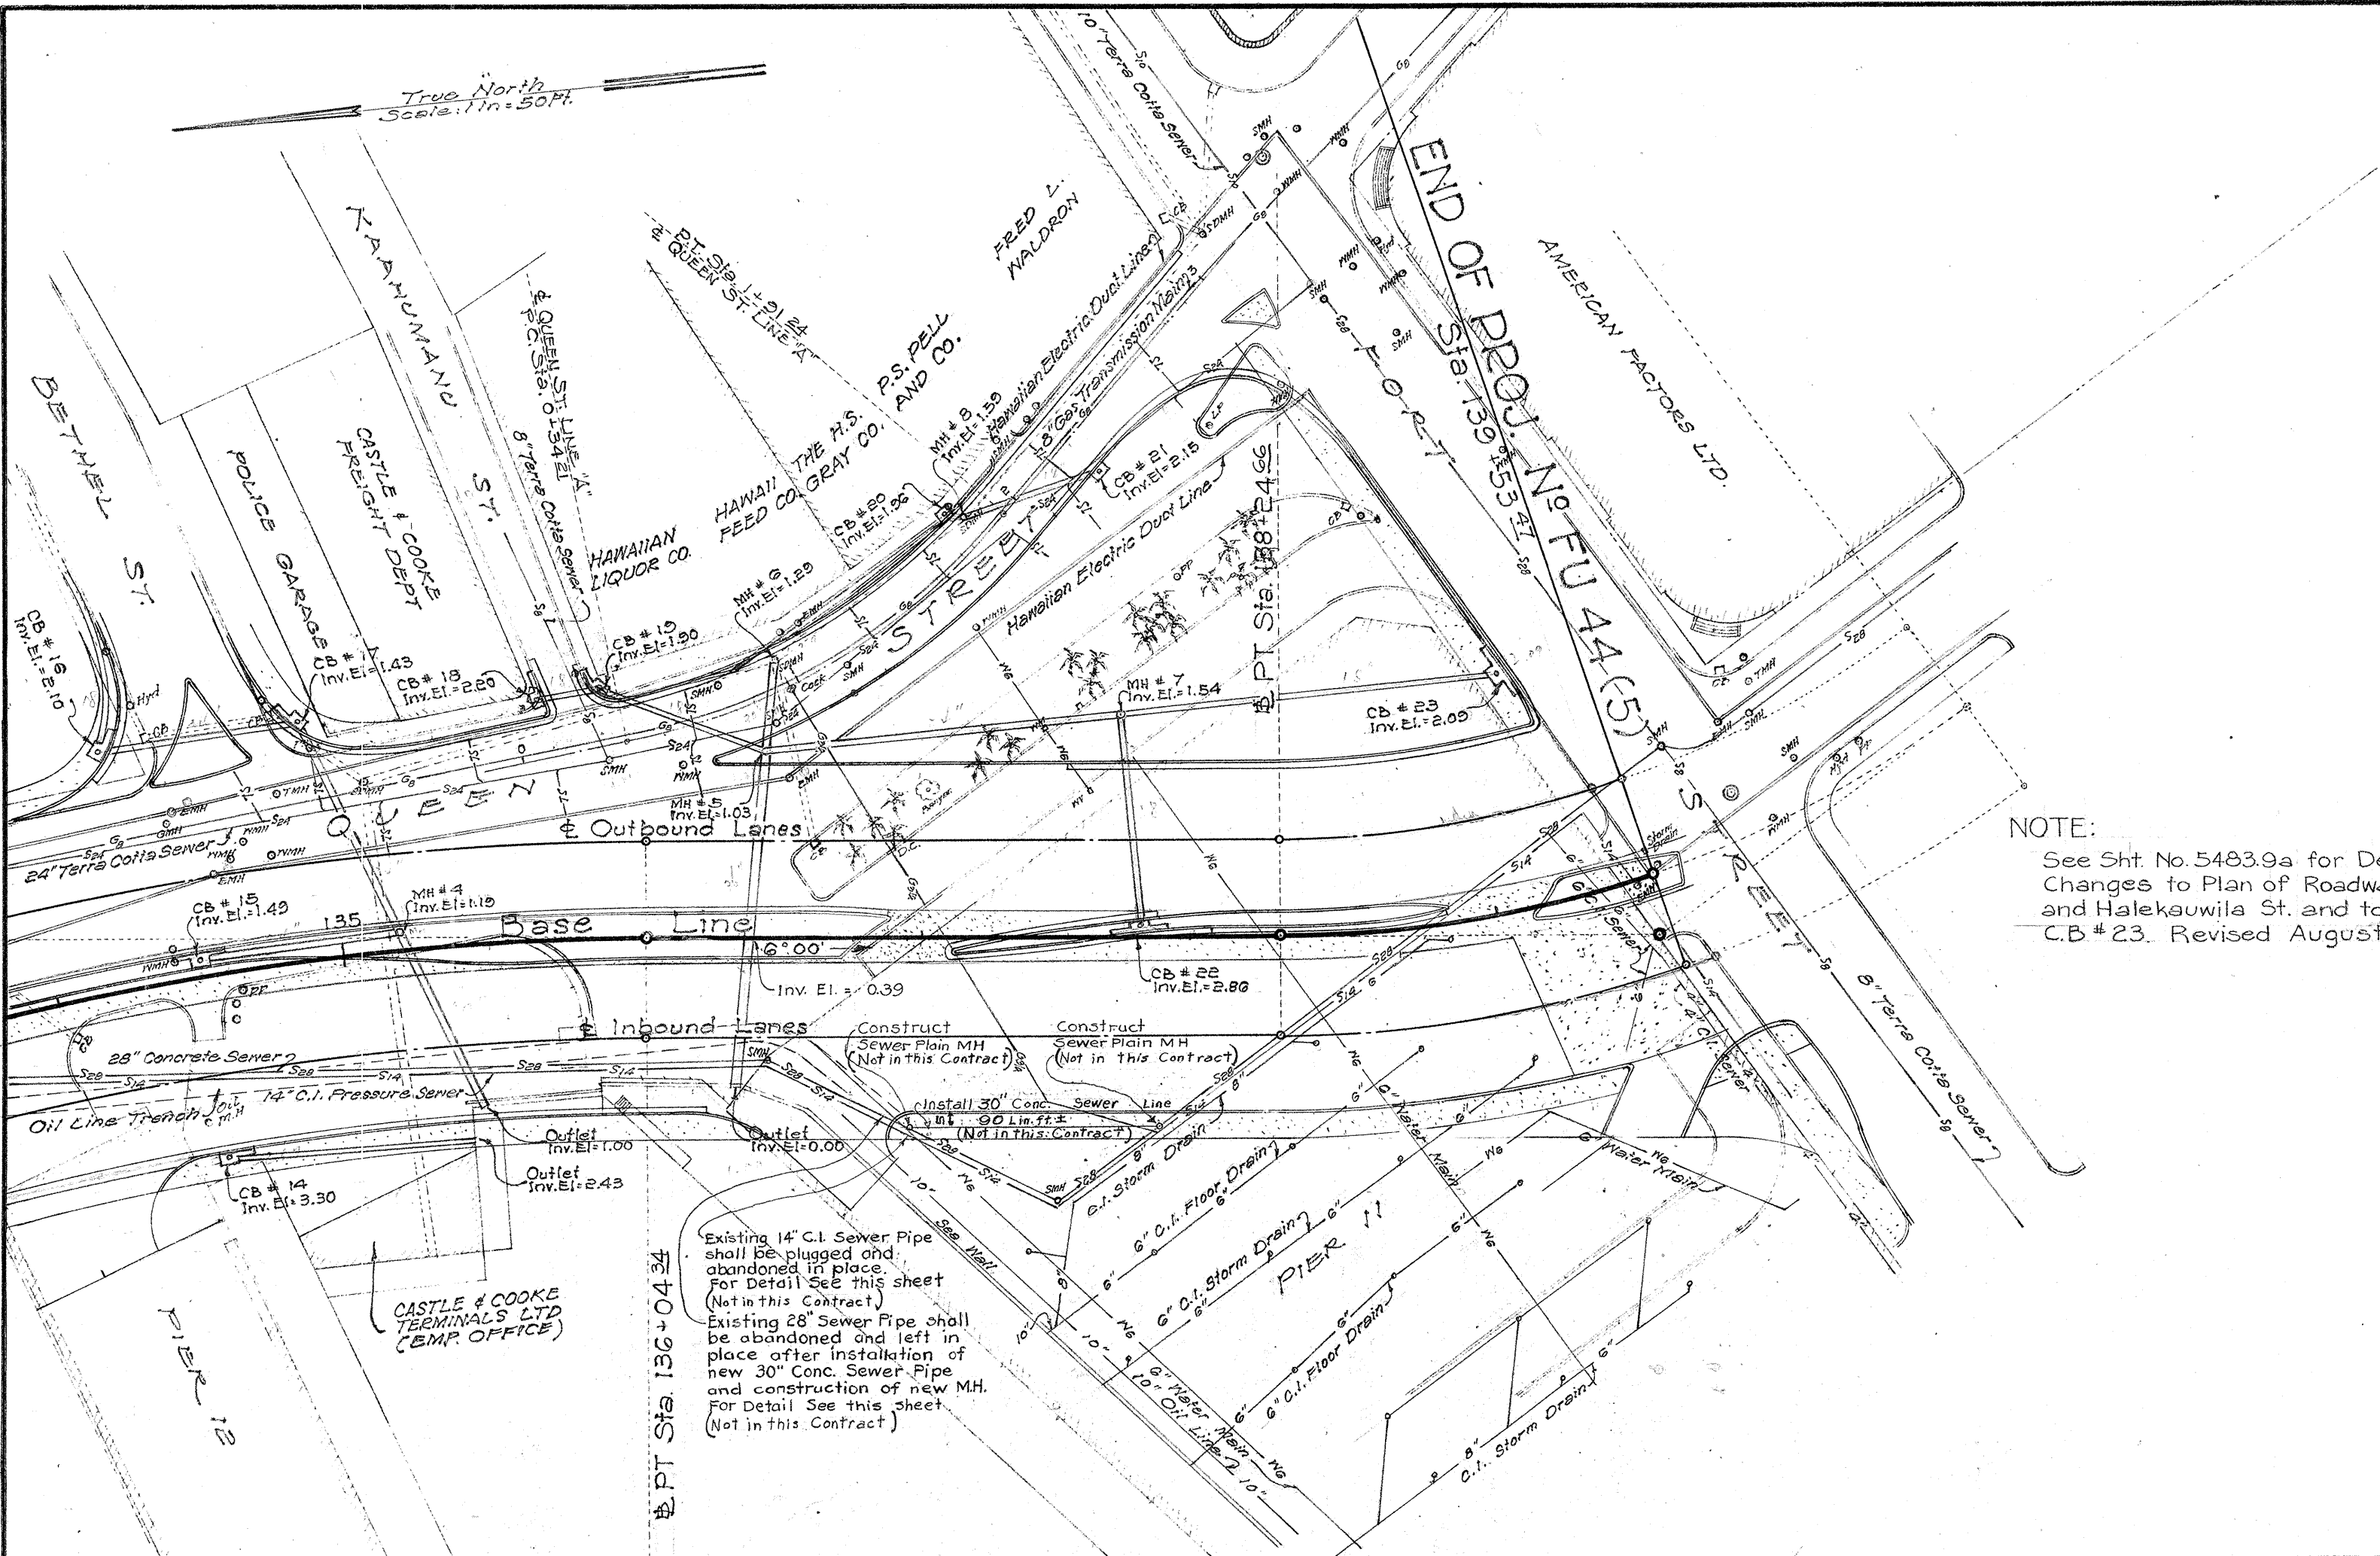

NOTE:
See Sht. No. 5483.9a for Details of Changes to Plan of Roadway at Fort St. and Halekauwila St. and to Layout of C.B.#23. Revised August 1951.

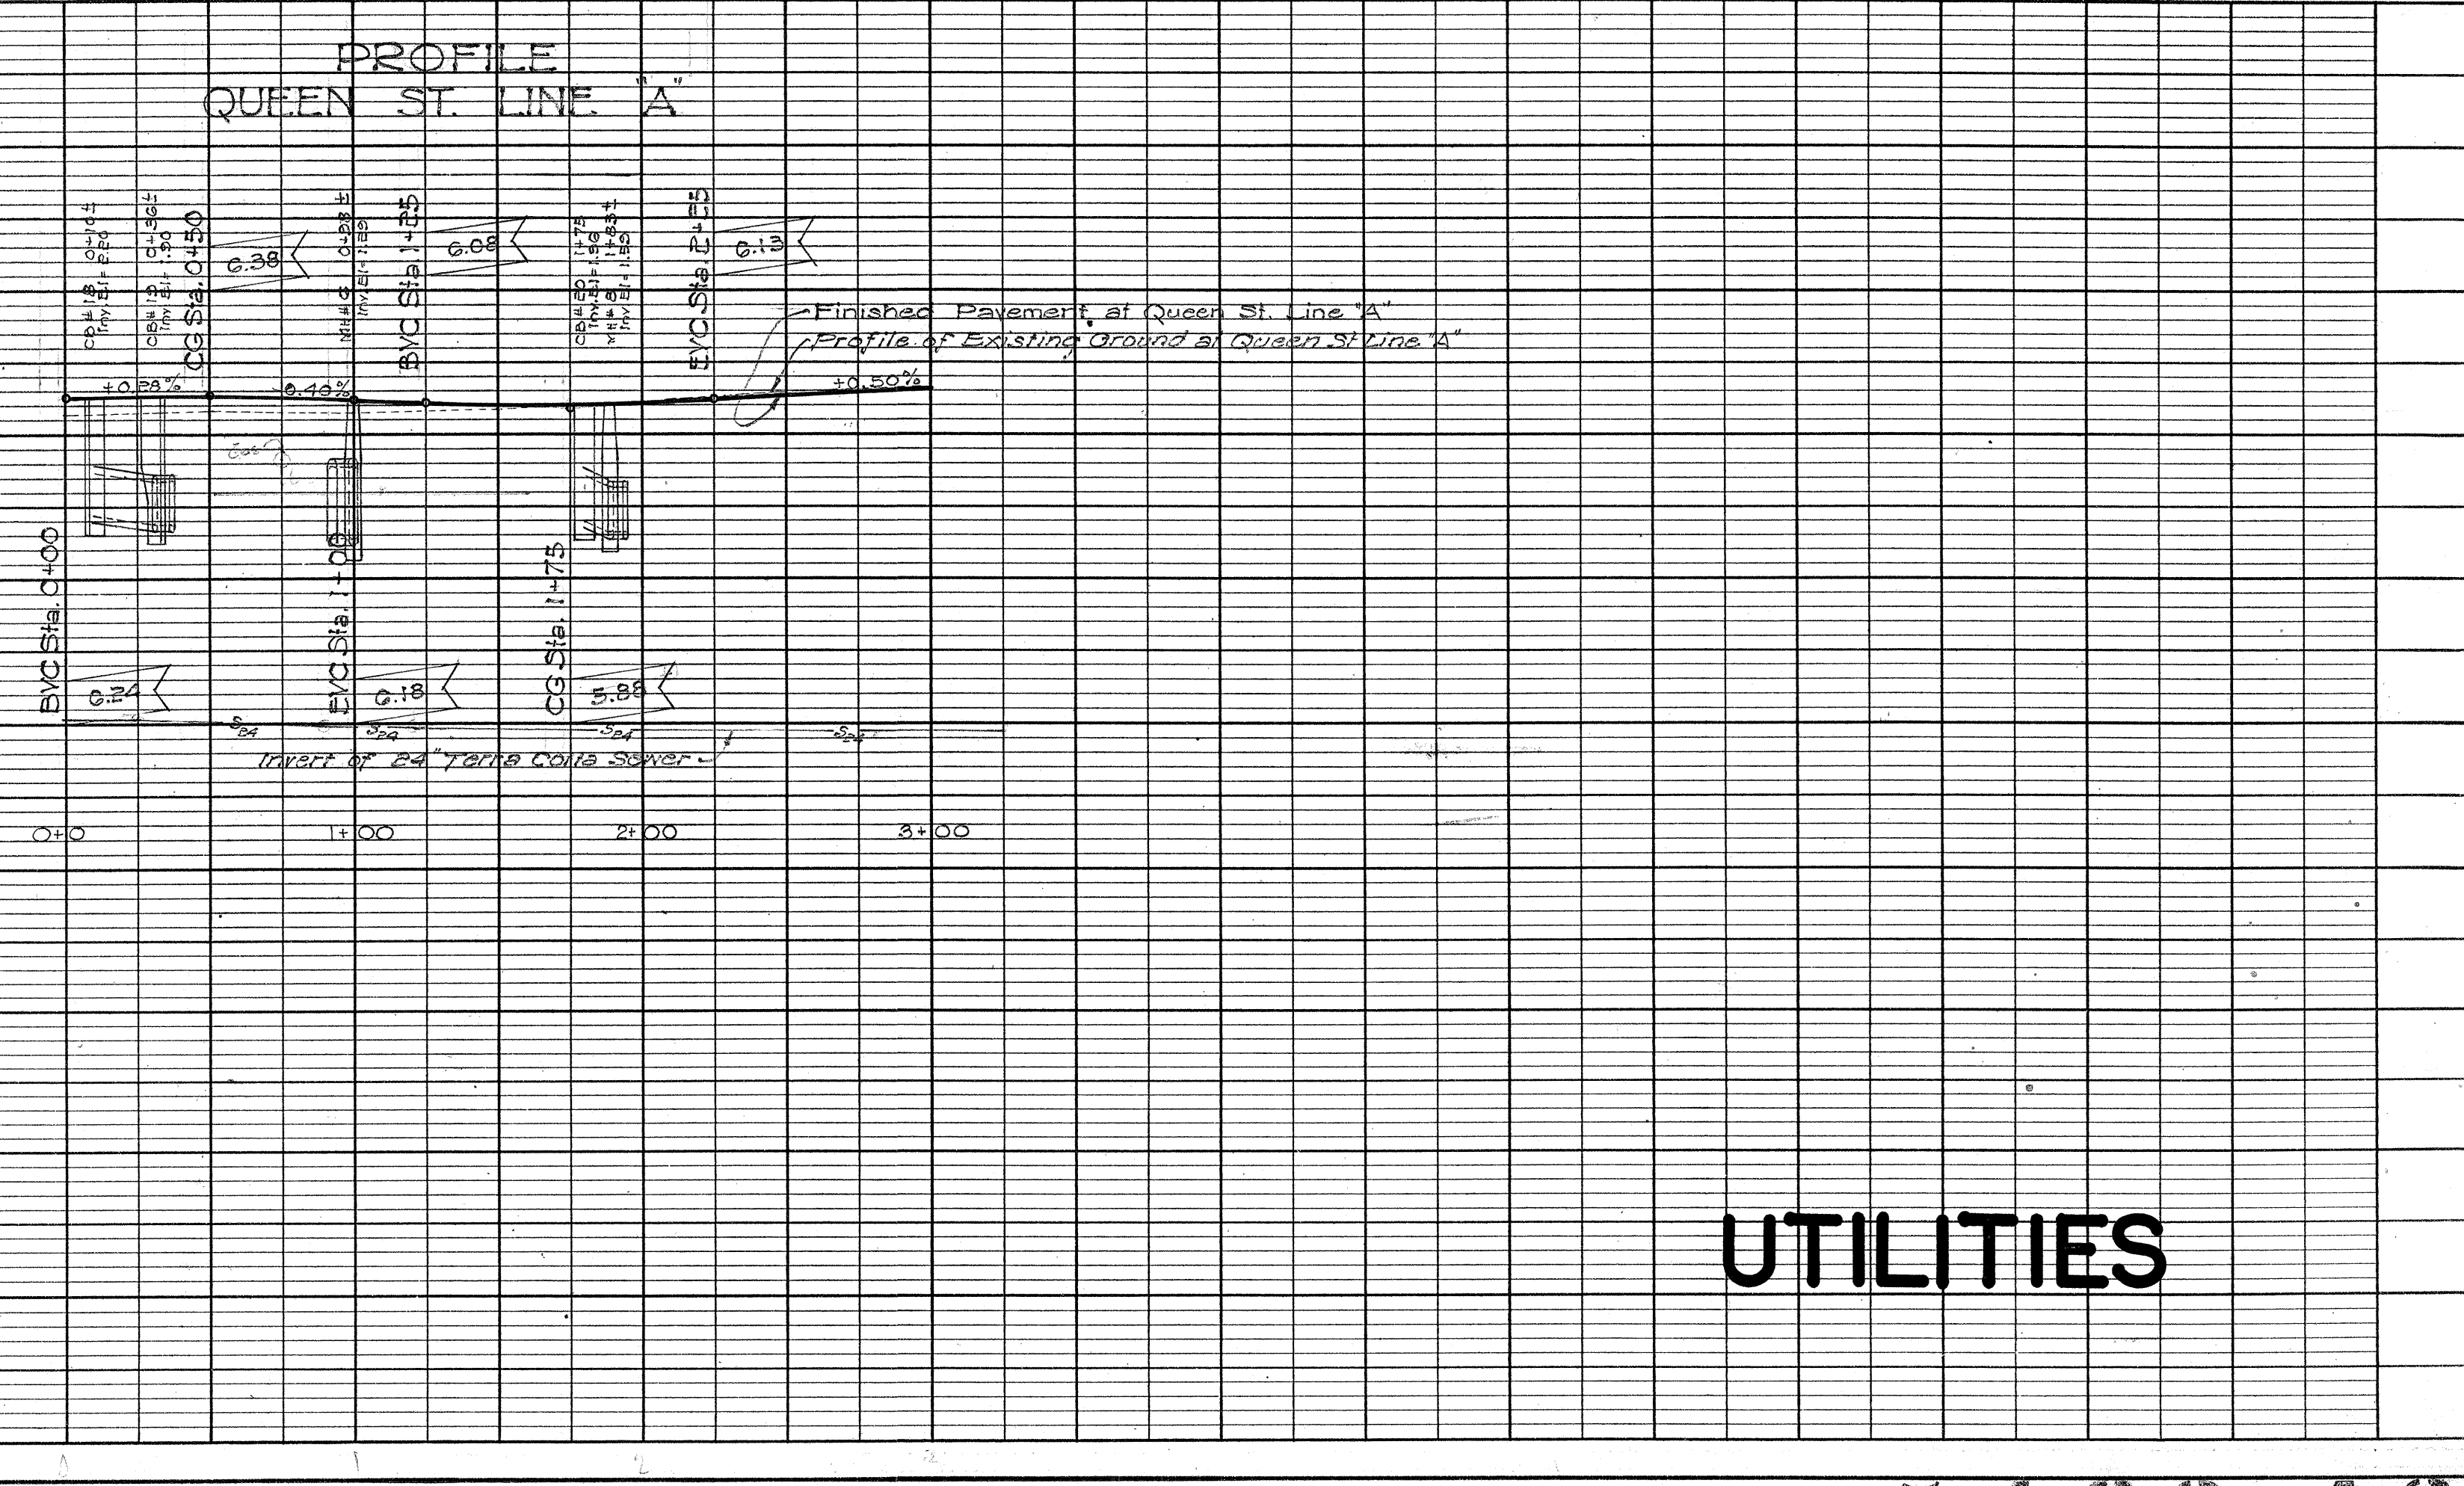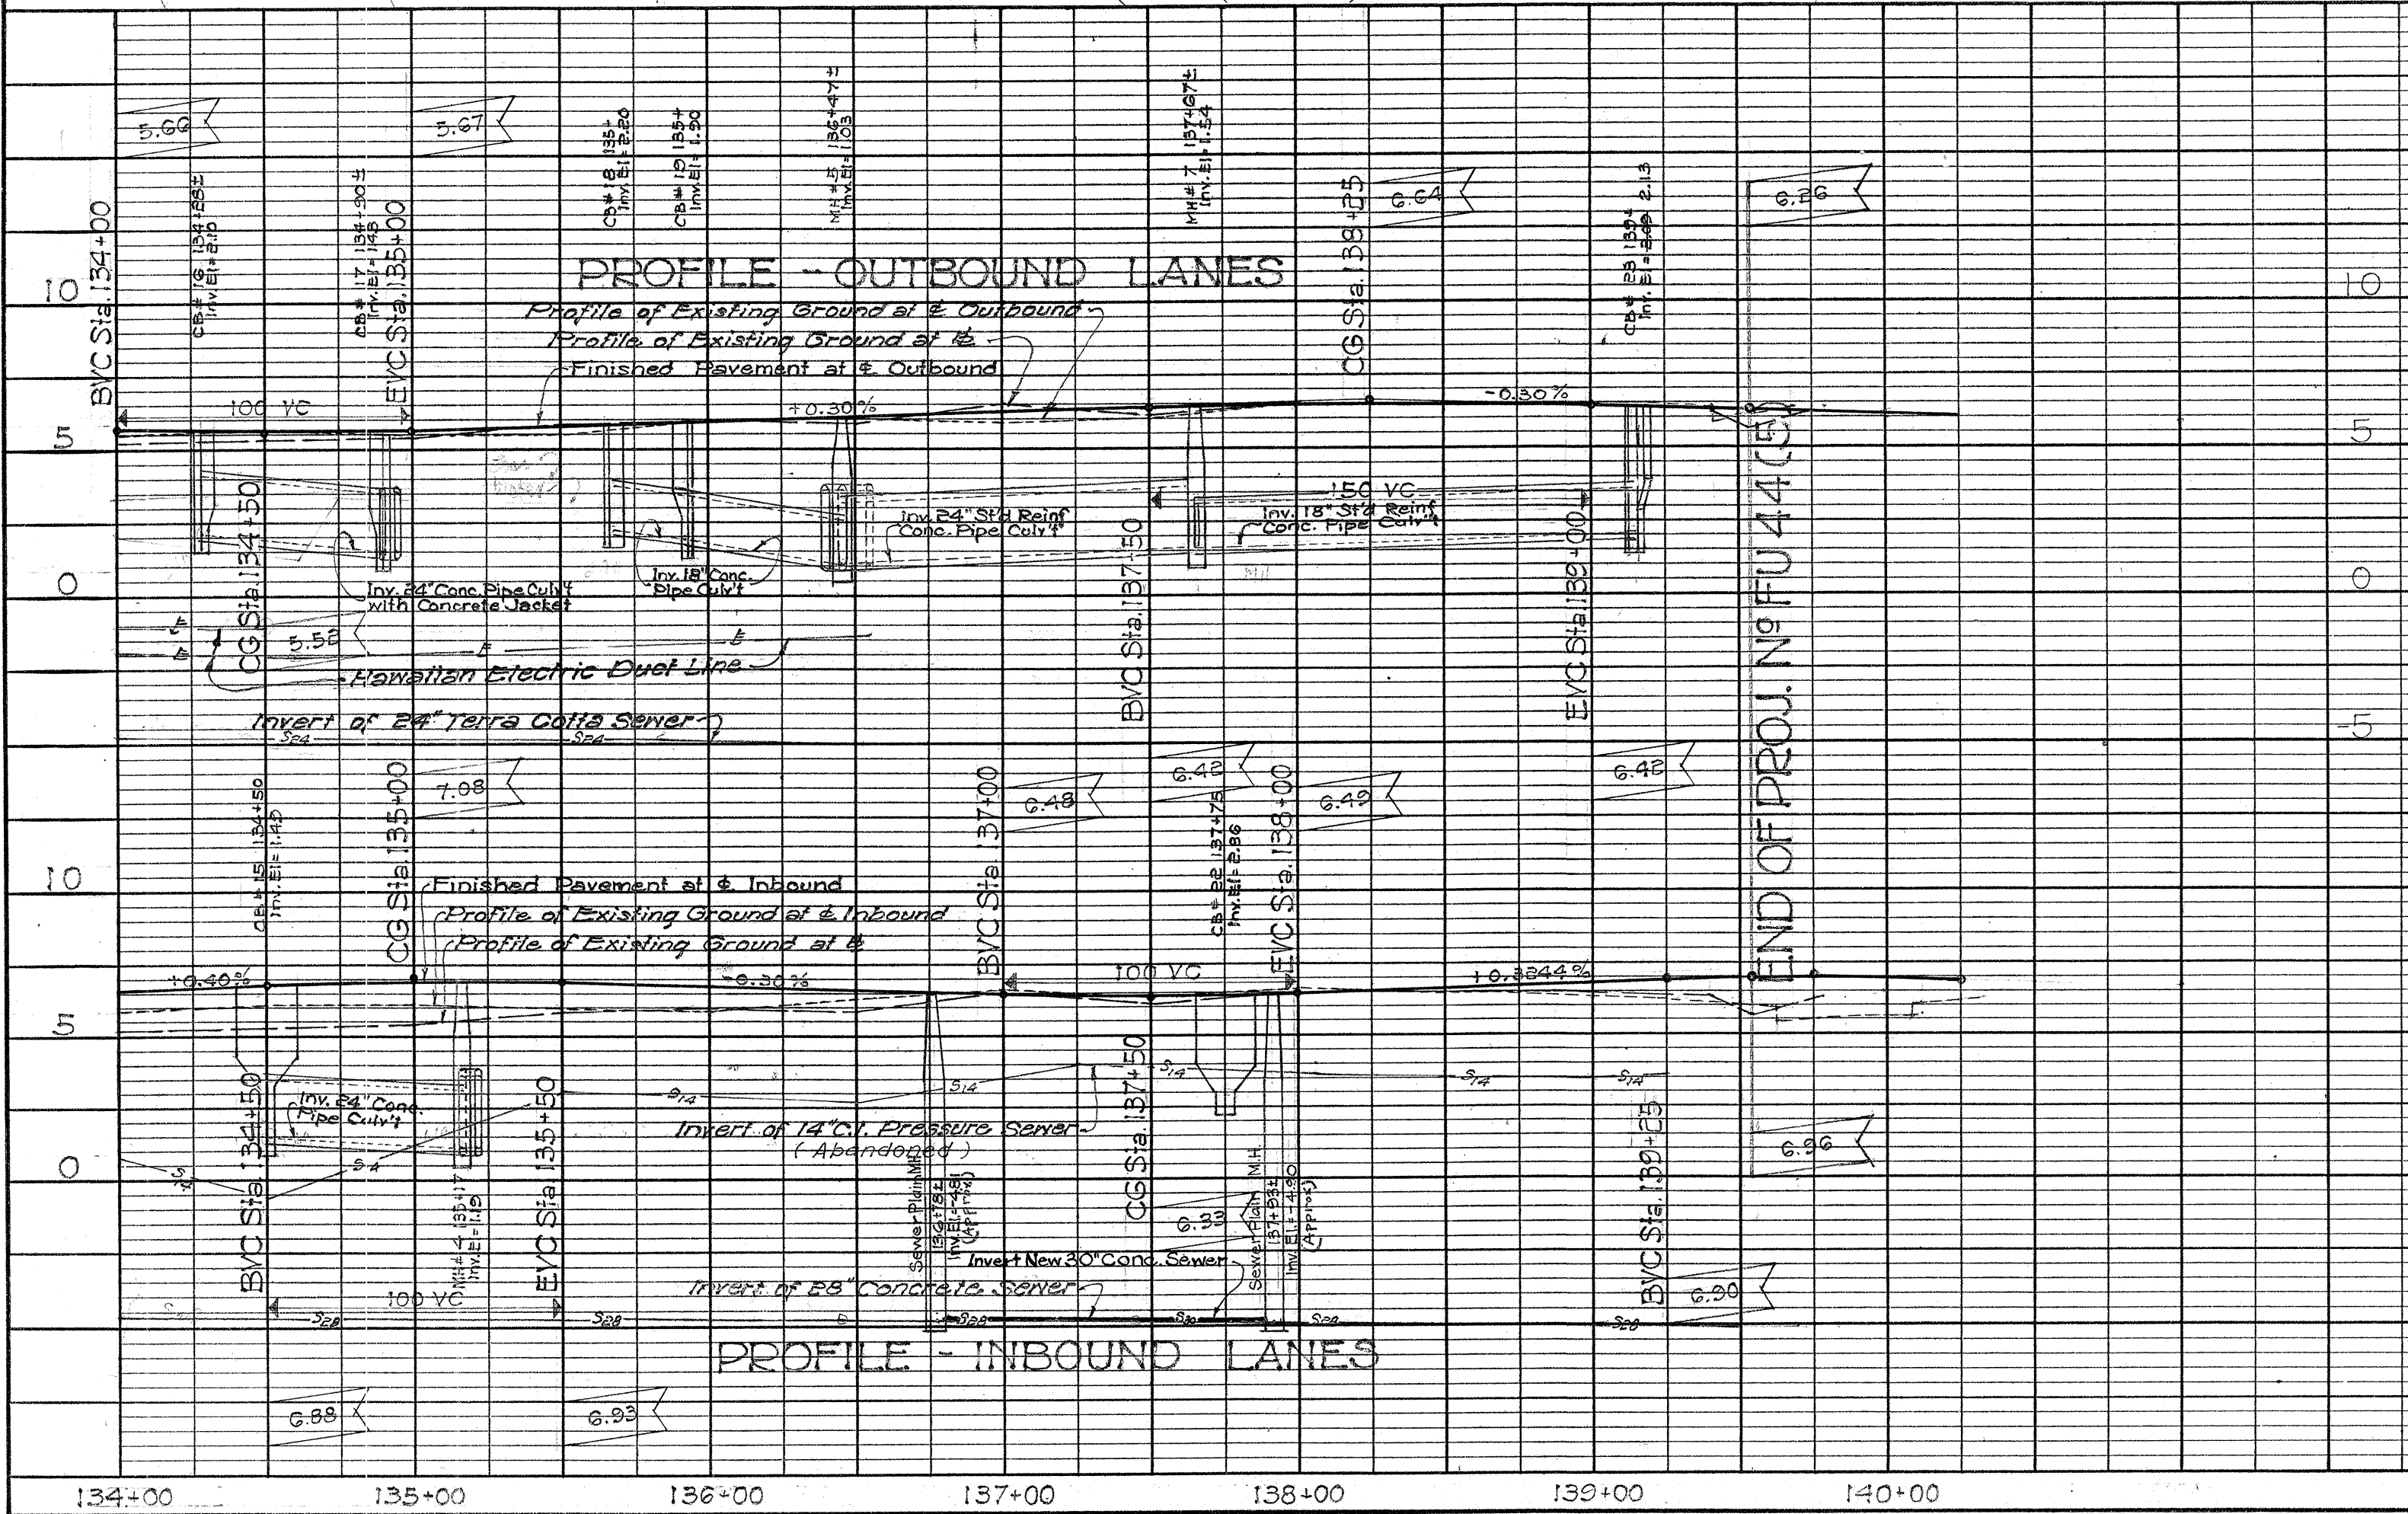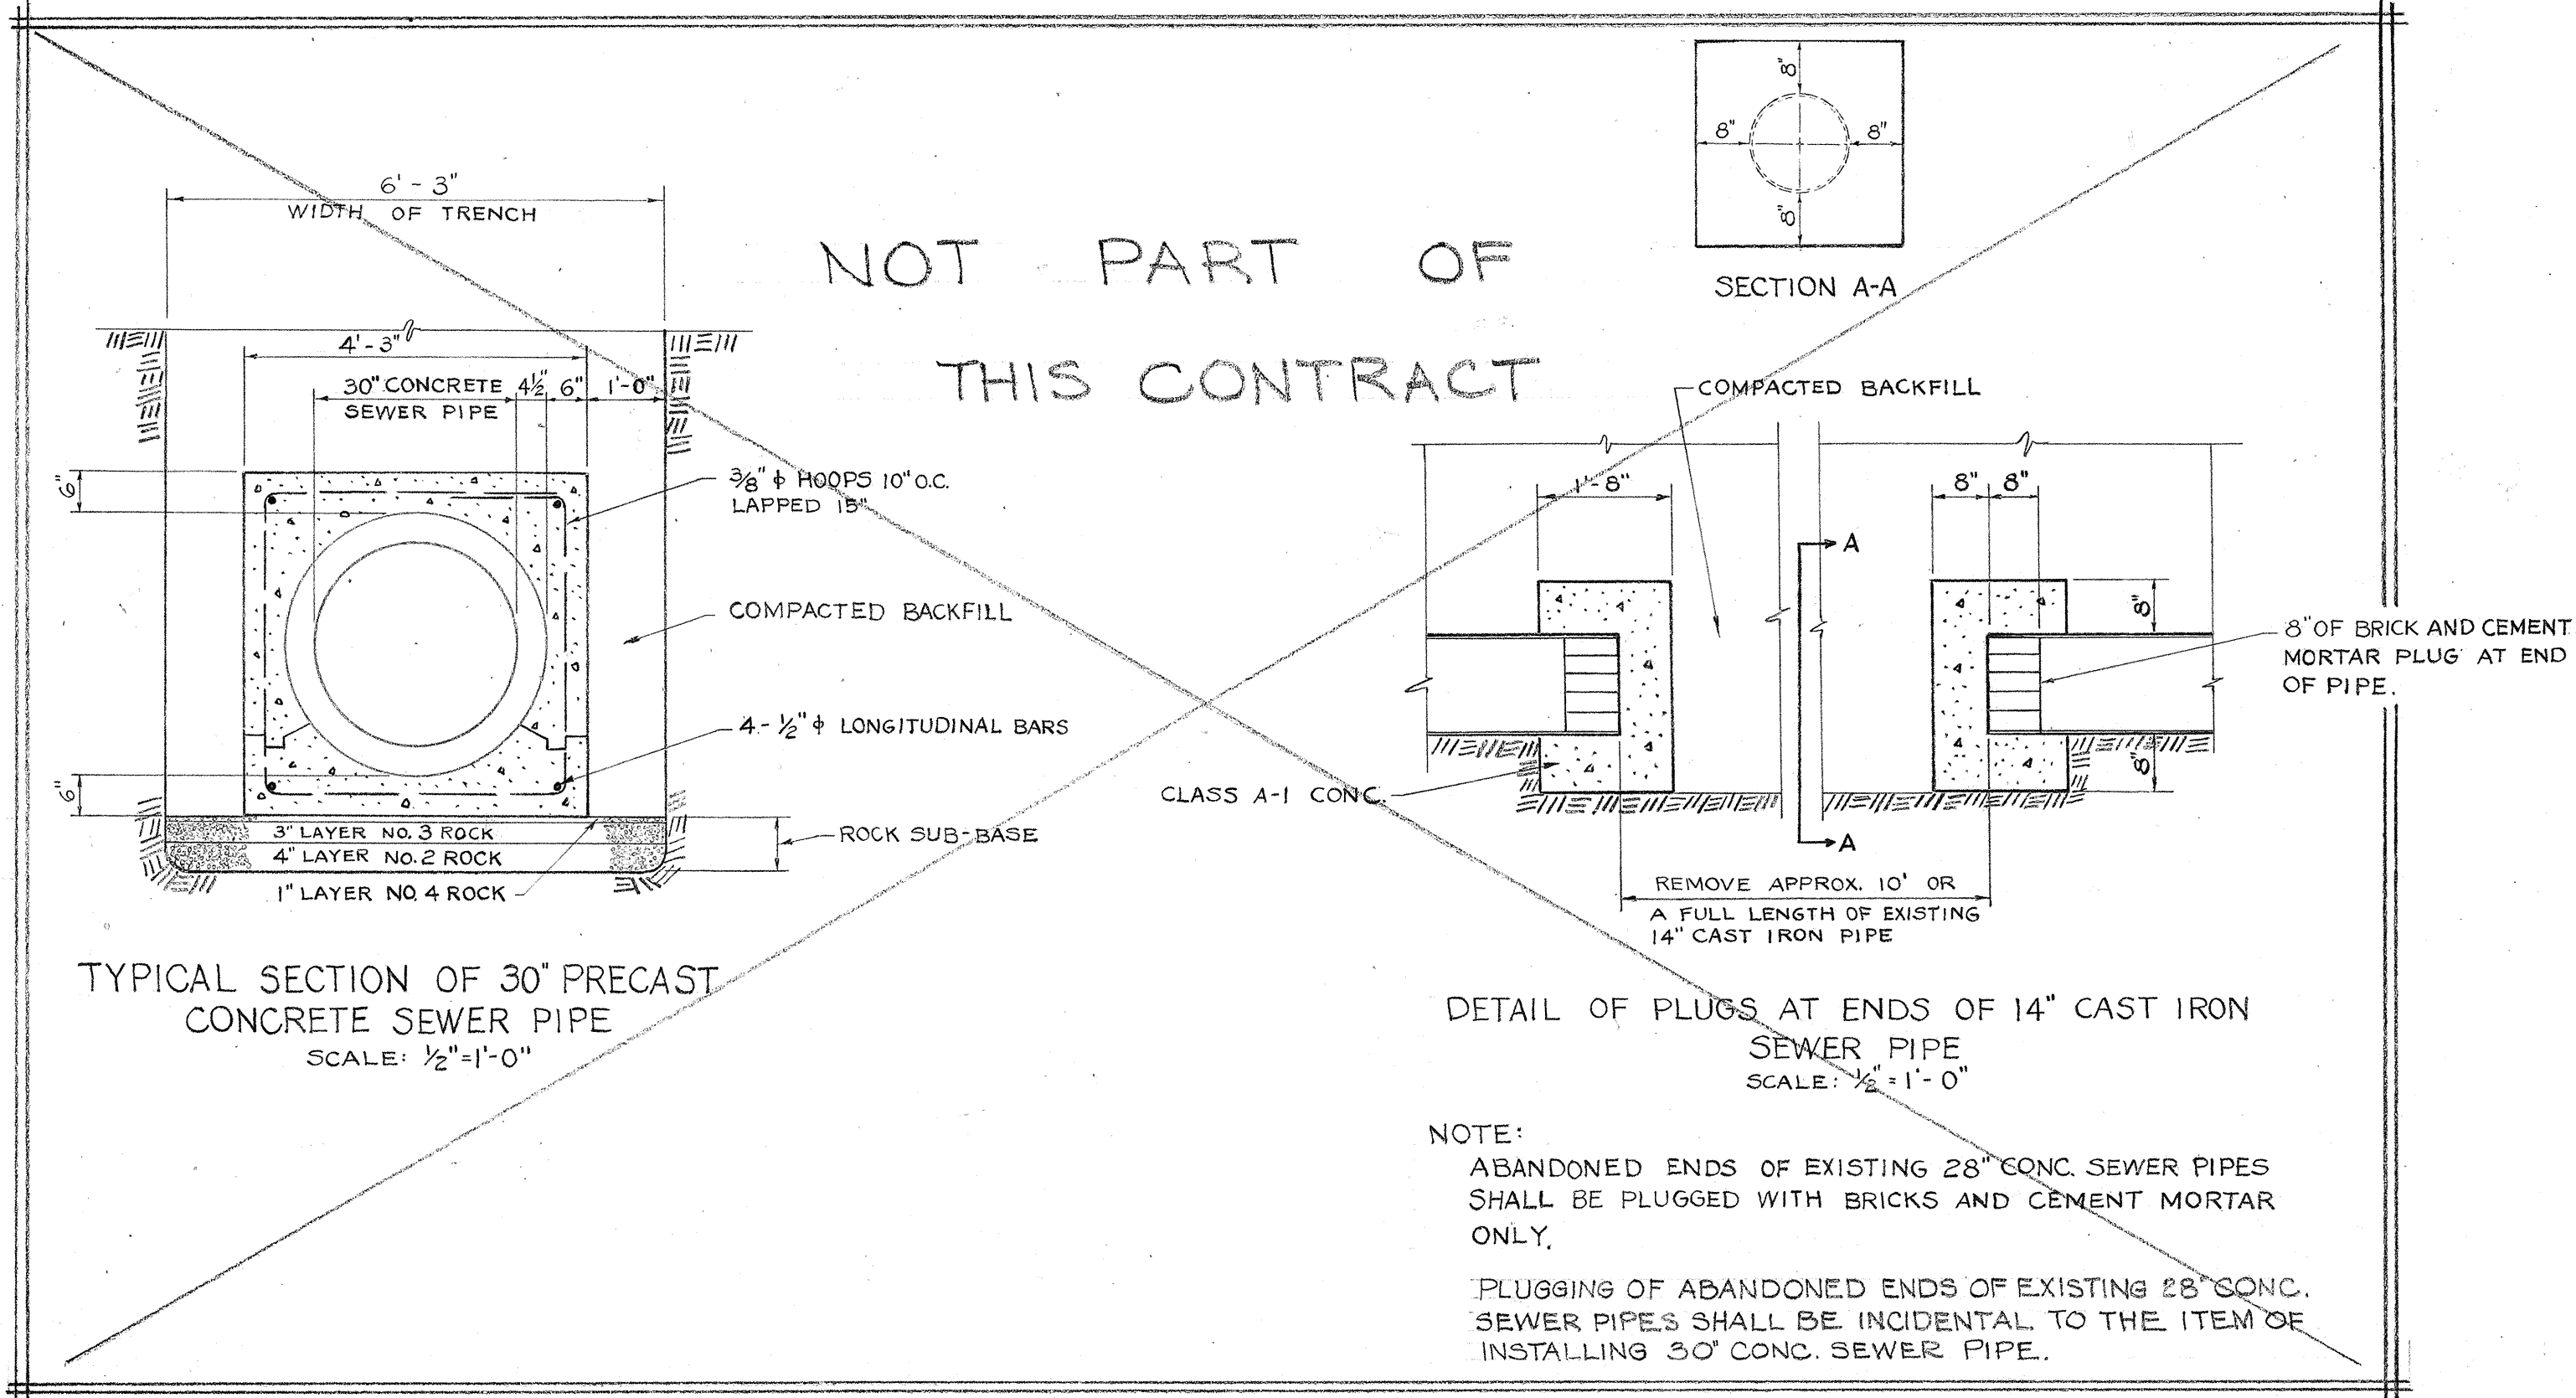

UTILITIES