


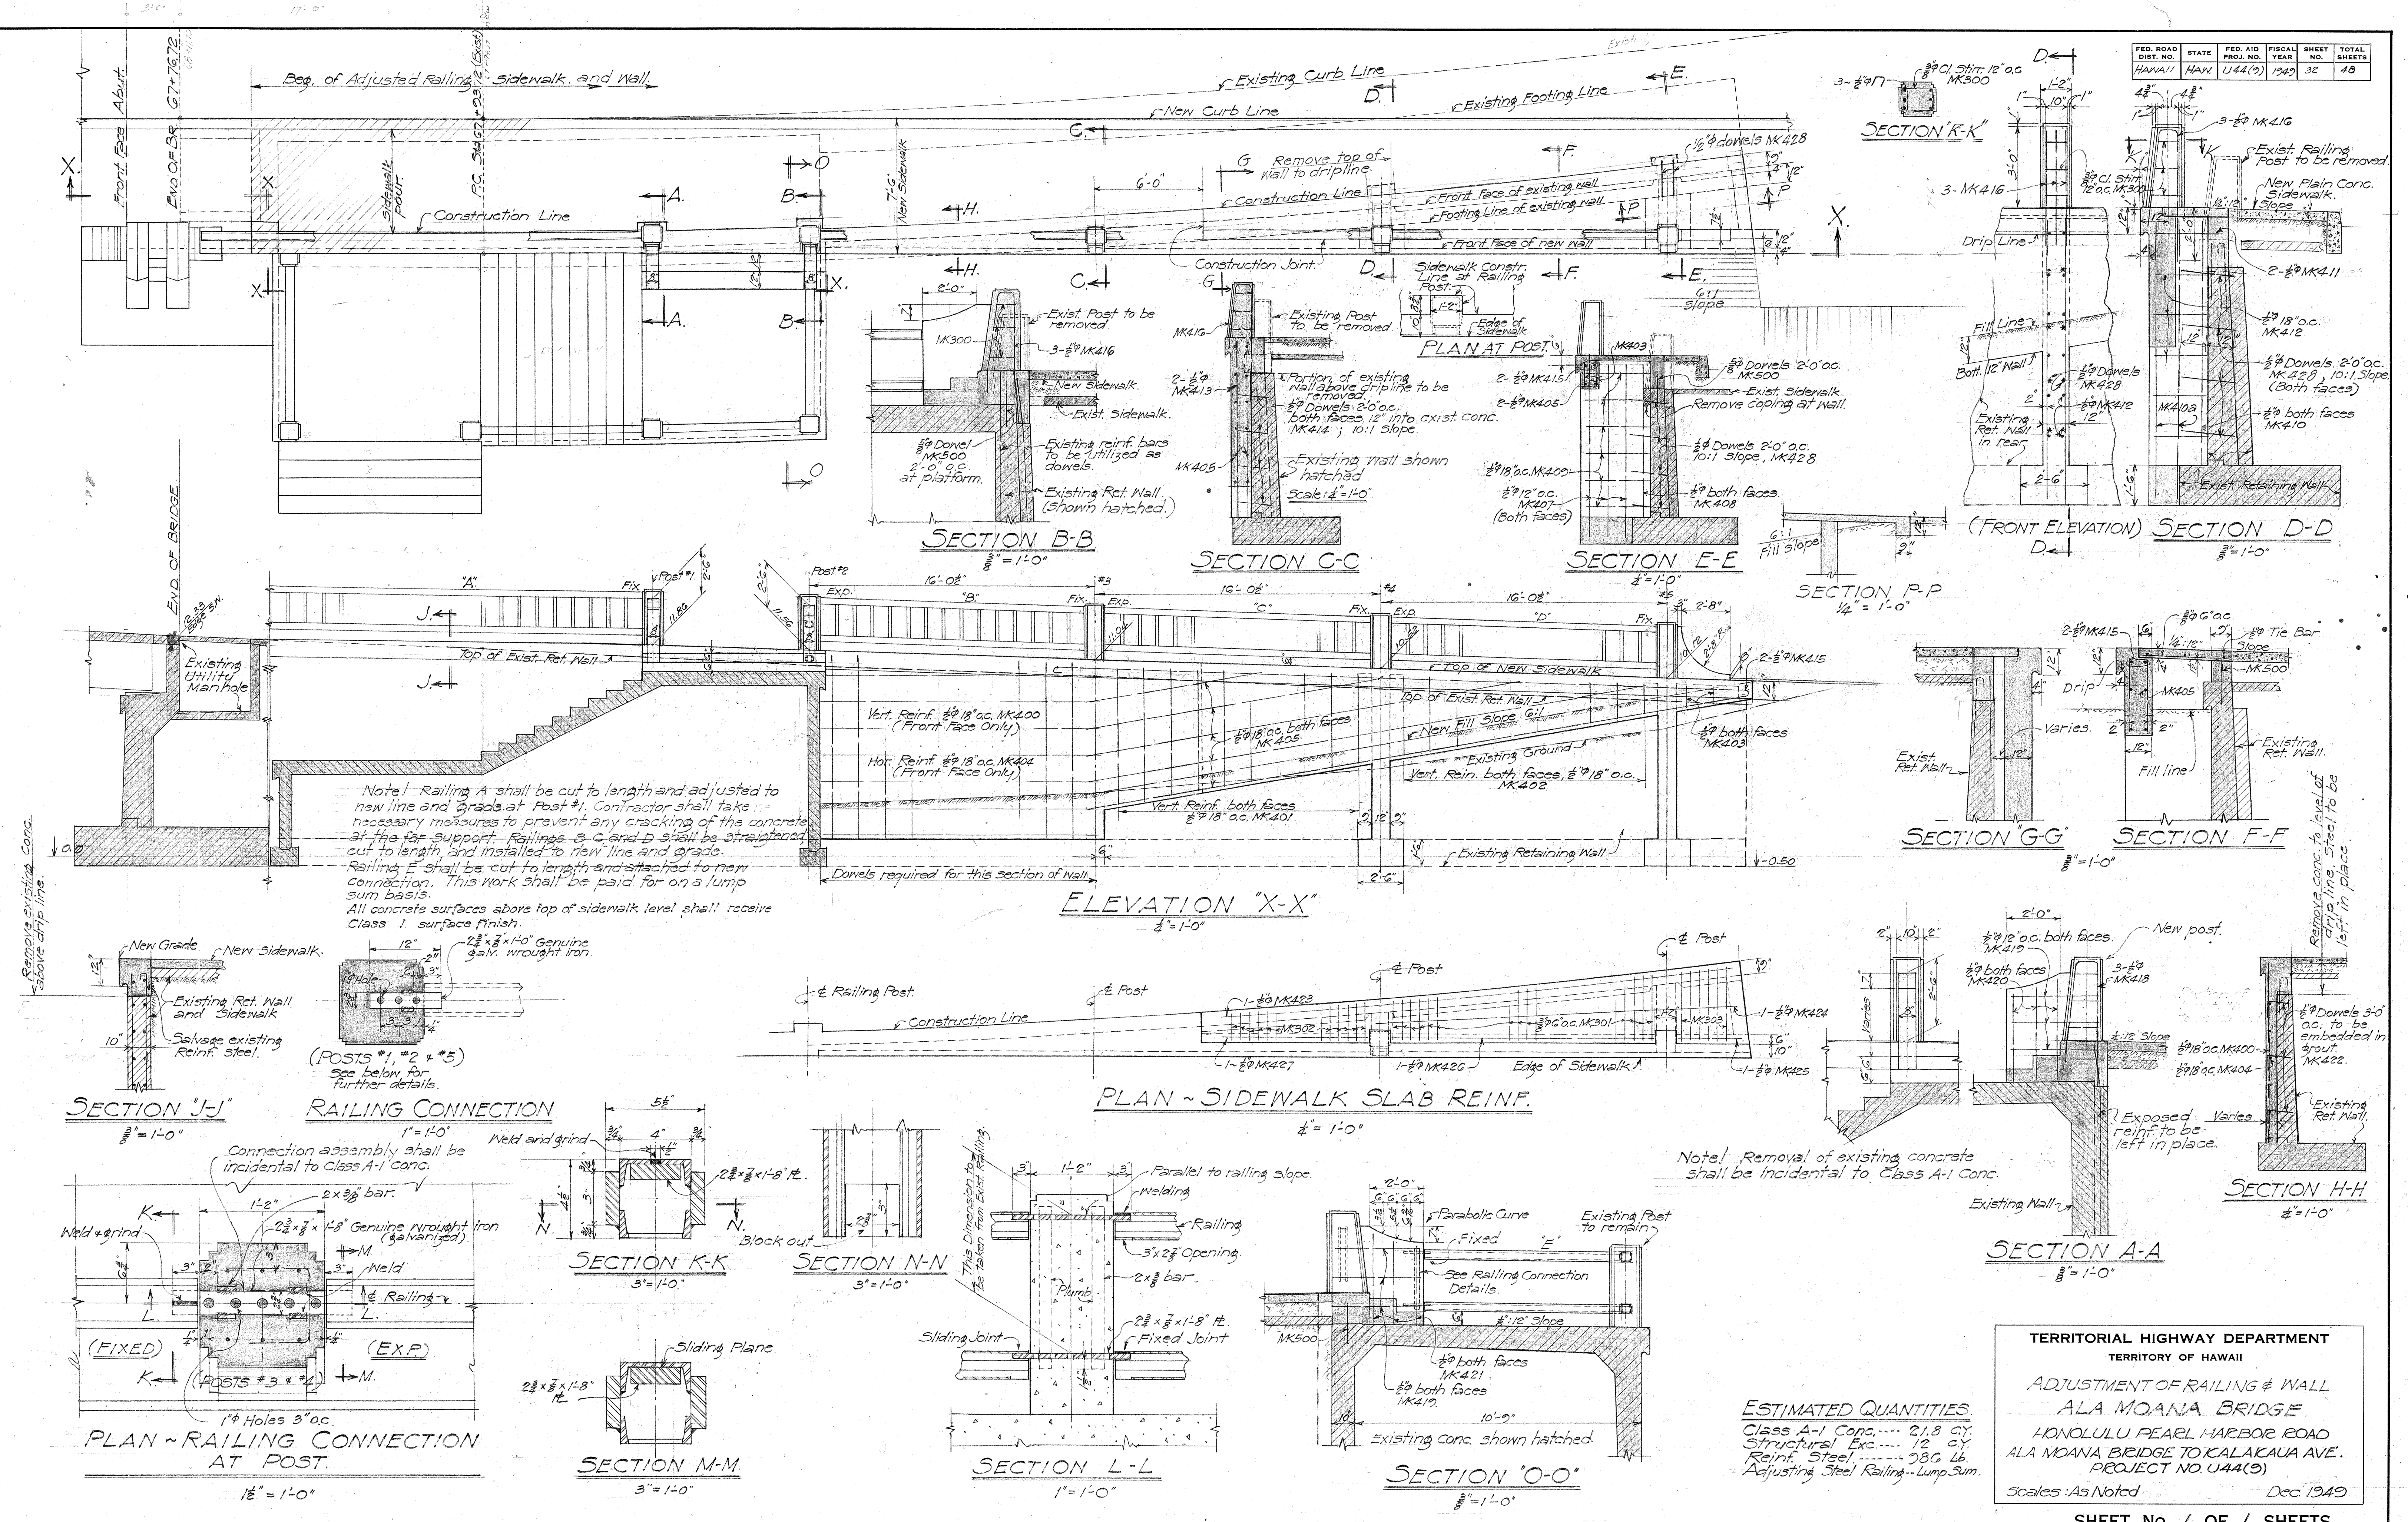

SHEET NO. 7 OF 7 SHEETS

5420.32

5420.32