


FED. ROAD DIST. NO.	STATE	FED. AID PROJ. NO.	FISCAL YEAR	SHEET NO.	TOTAL SHEETS
HAWAII	HAW.	U44(9)	1949	8	48

DATE	DESIGNED BY	ORIGINAL PLAN
	DRAWN BY	NO.
	CHECKED BY	
	QUANTITIES CHECKED BY	
	NOTE BOOK	
	CHECKED BY	

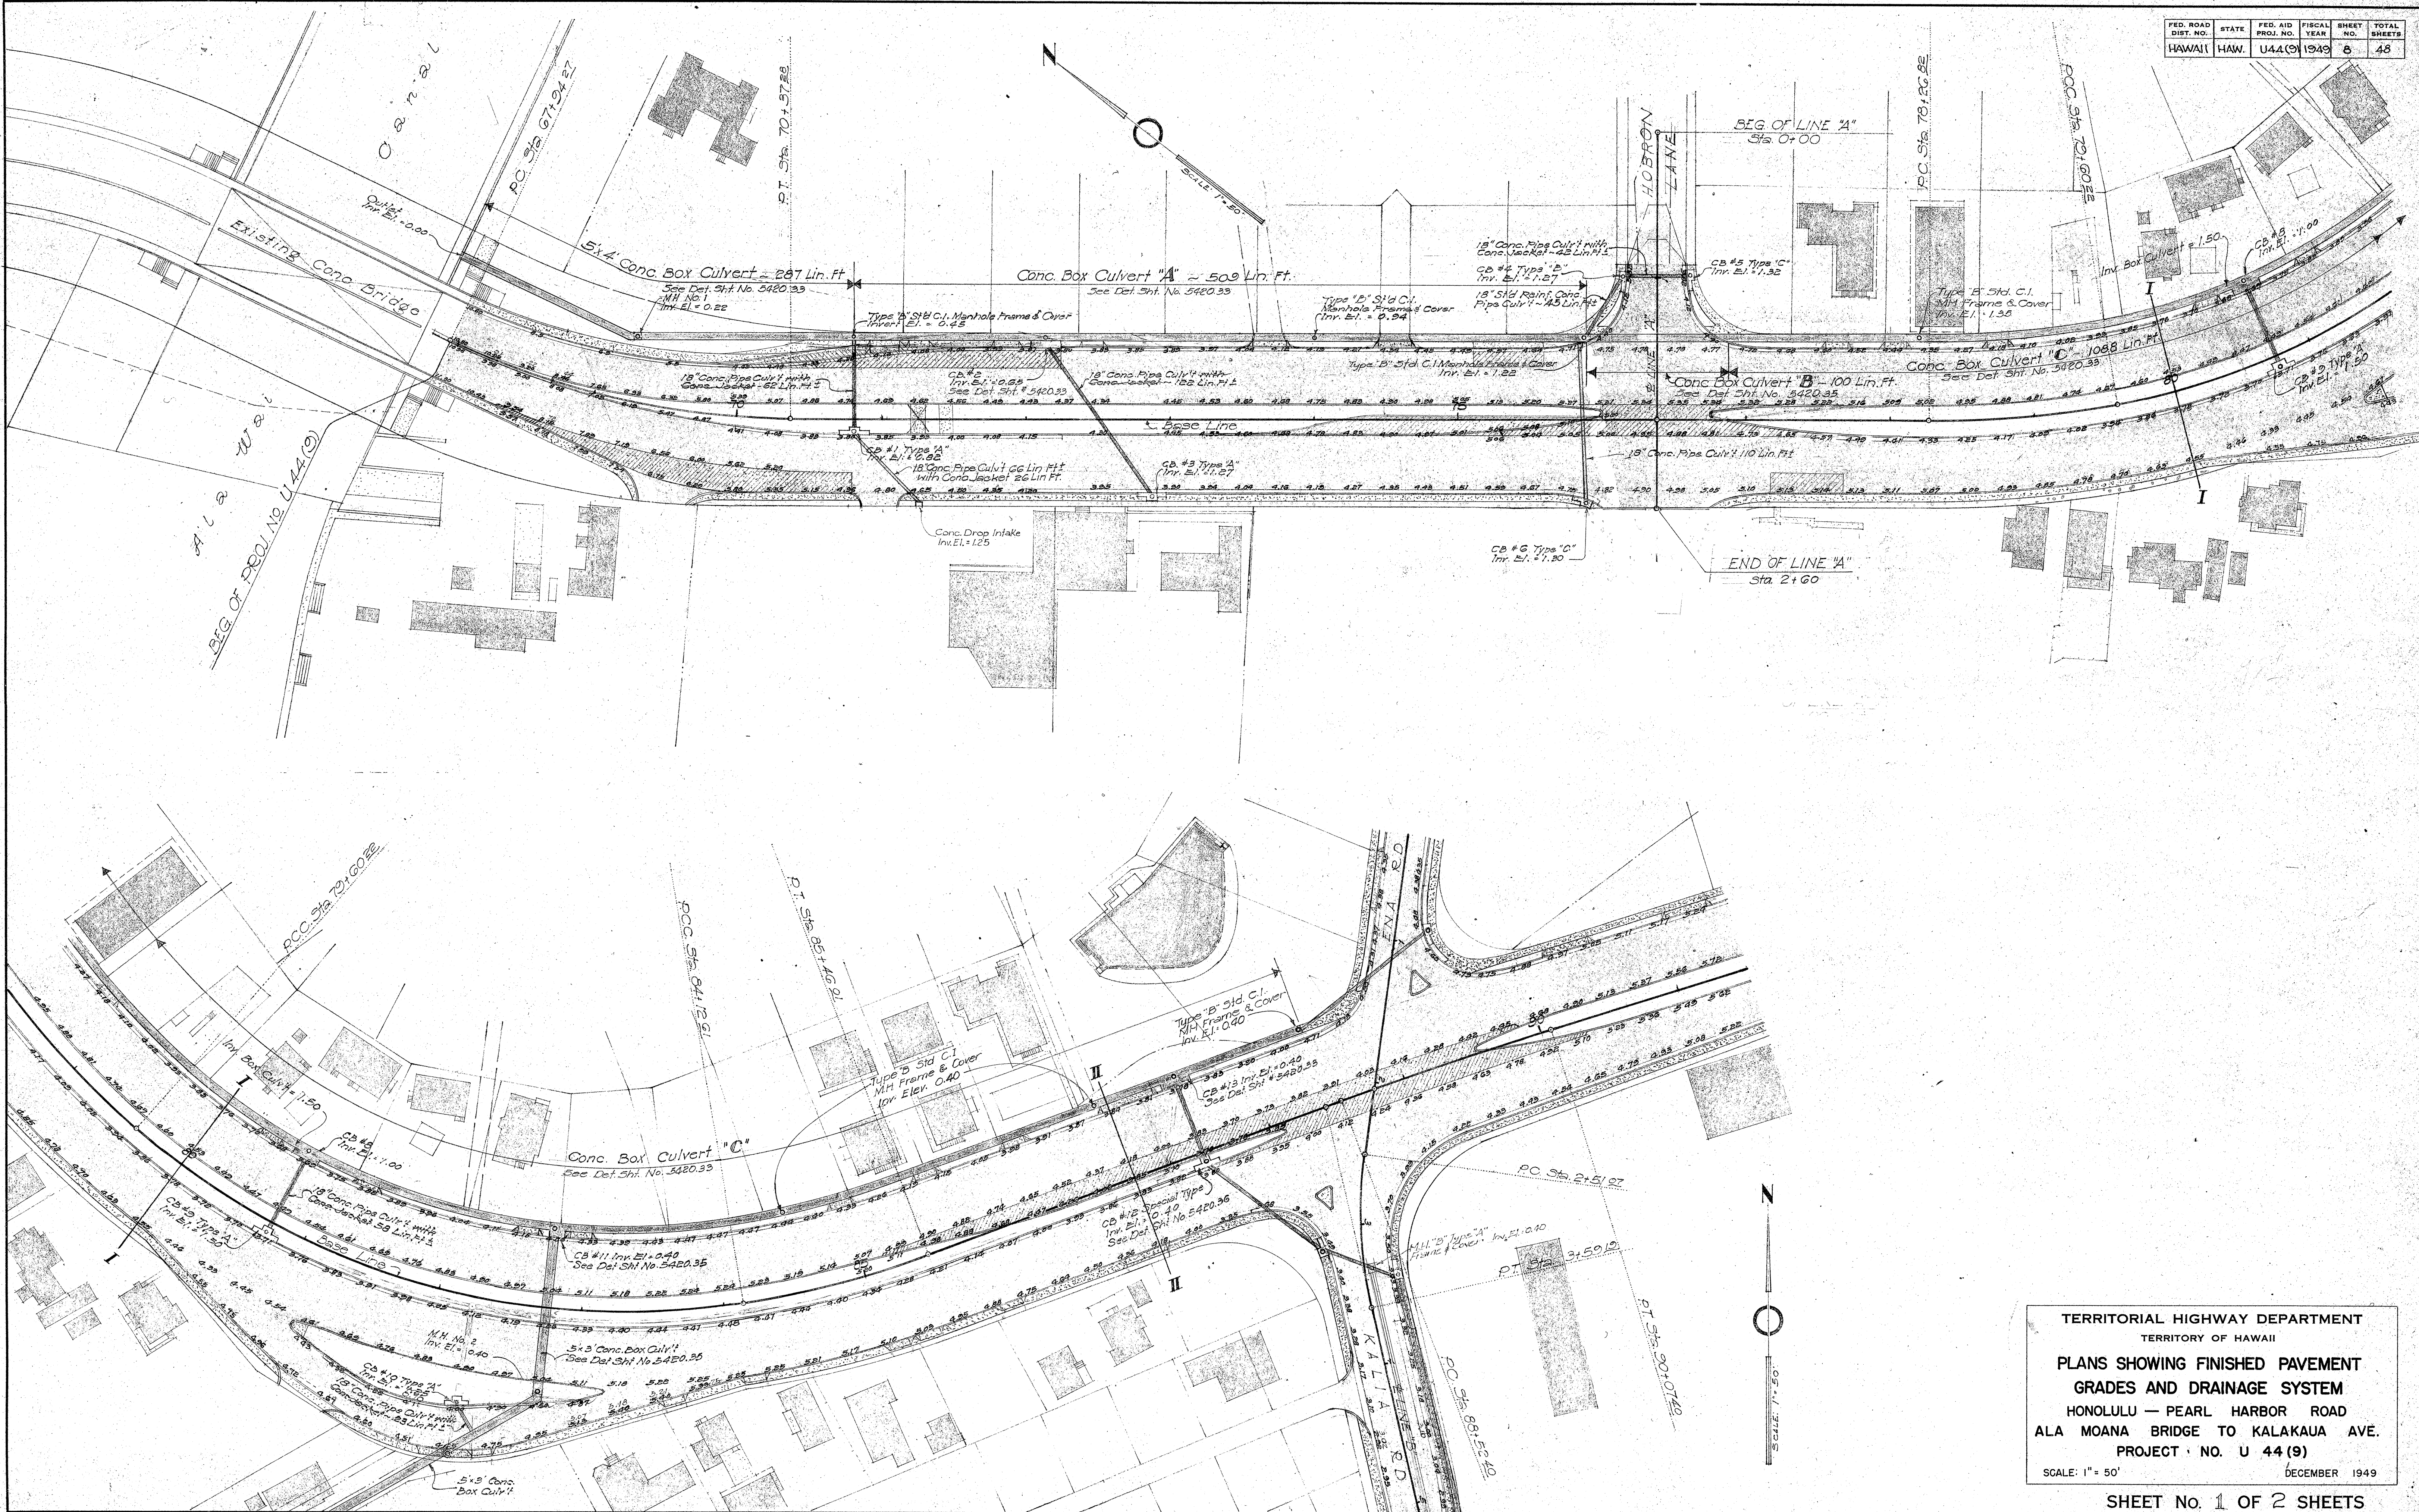


TERRITORIAL HIGHWAY DEPARTMENT
TERRITORY OF HAWAII
PLANS SHOWING FINISHED PAVEMENT
GRADES AND DRAINAGE SYSTEM
HONOLULU - PEARL HARBOR ROAD
ALA MOANA BRIDGE TO KALAKAUA AVE.
PROJECT NO. U 44 (9)

SCALE: 1" = 50' DECEMBER 1949

SHEET No. 1 OF 2 SHEETS

5420.8

FED. ROAD DIST. NO.	STATE	FED. AID PROJ. NO.	FISCAL YEAR	SHEET NO.	TOTAL SHEET
HAWAII	HAW.	U44(9)	1949	9	48

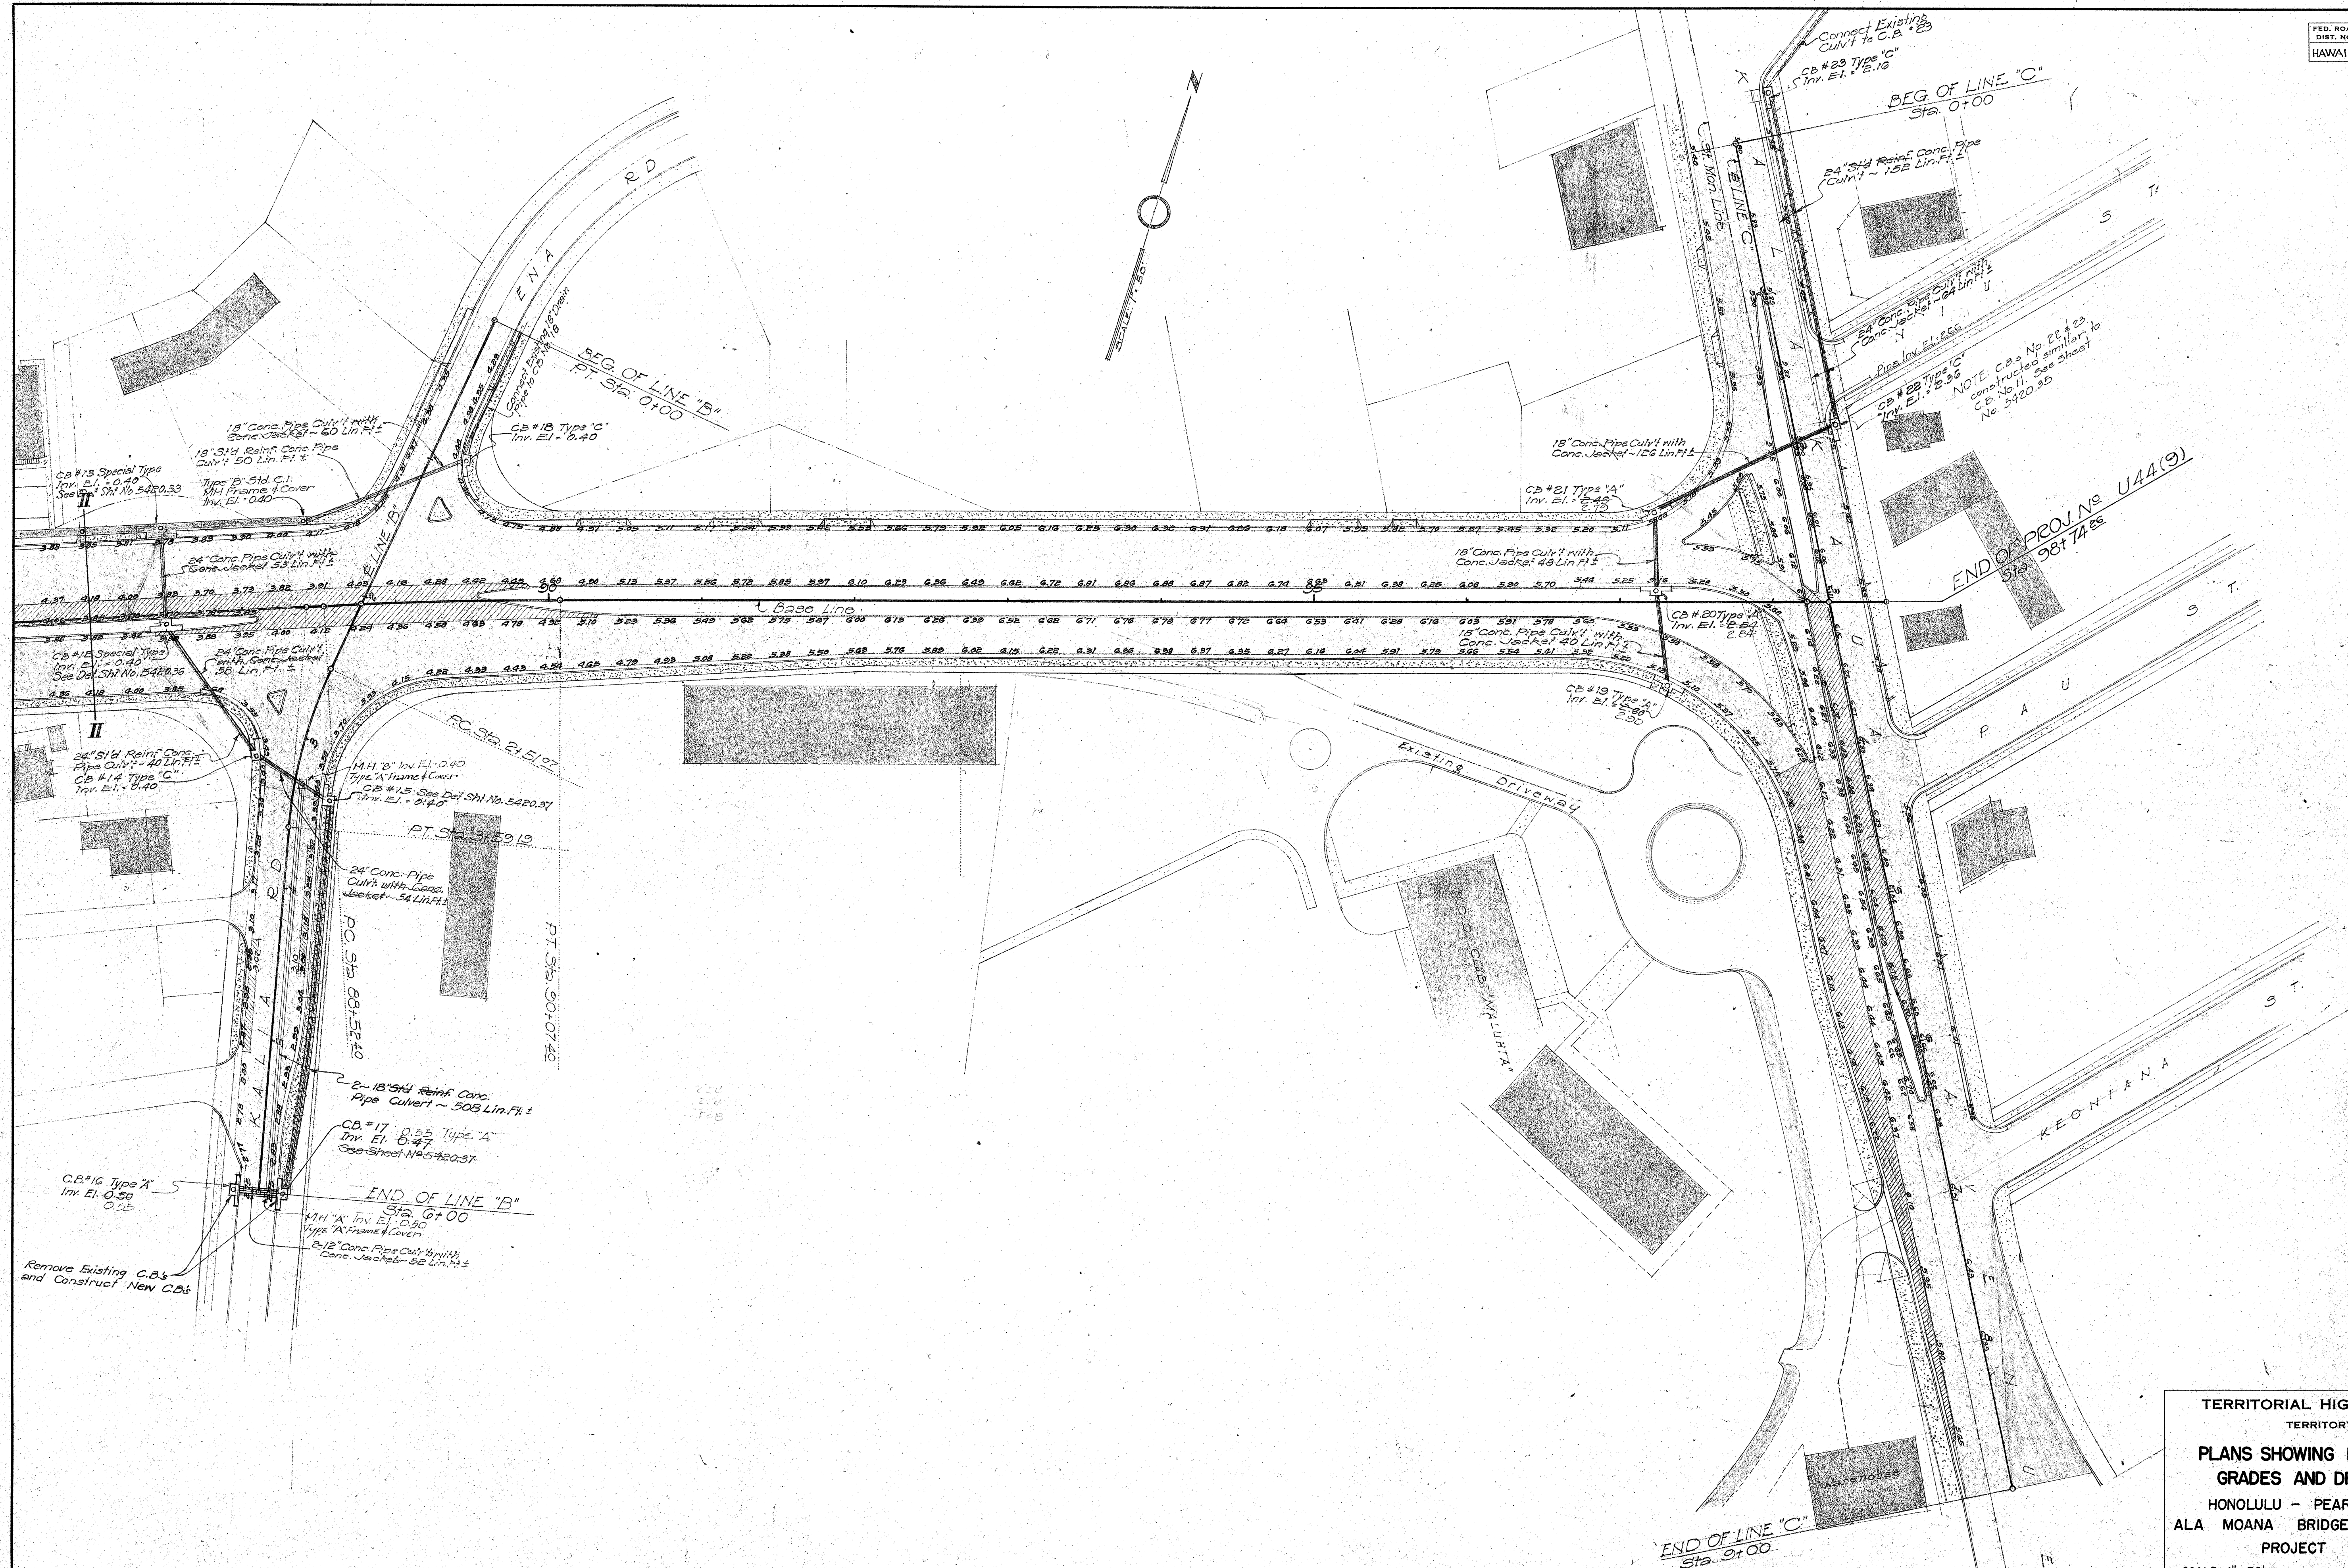

TERRITORIAL HIGHWAY DEPARTMENT
TERRITORY OF HAWAII

PLANS SHOWING FINISHED PAVEMENT GRADES AND DRAINAGE SYSTEM

HONOLULU - PEARL HARBOR ROAD
ALA MOANA BRIDGE TO KALAKAUA AVE.
PROJECT NO. U-44(9)

SCALE 1" = 50' DECEMBER 1949

SHEET No. 2 OF 2 SHEETS