
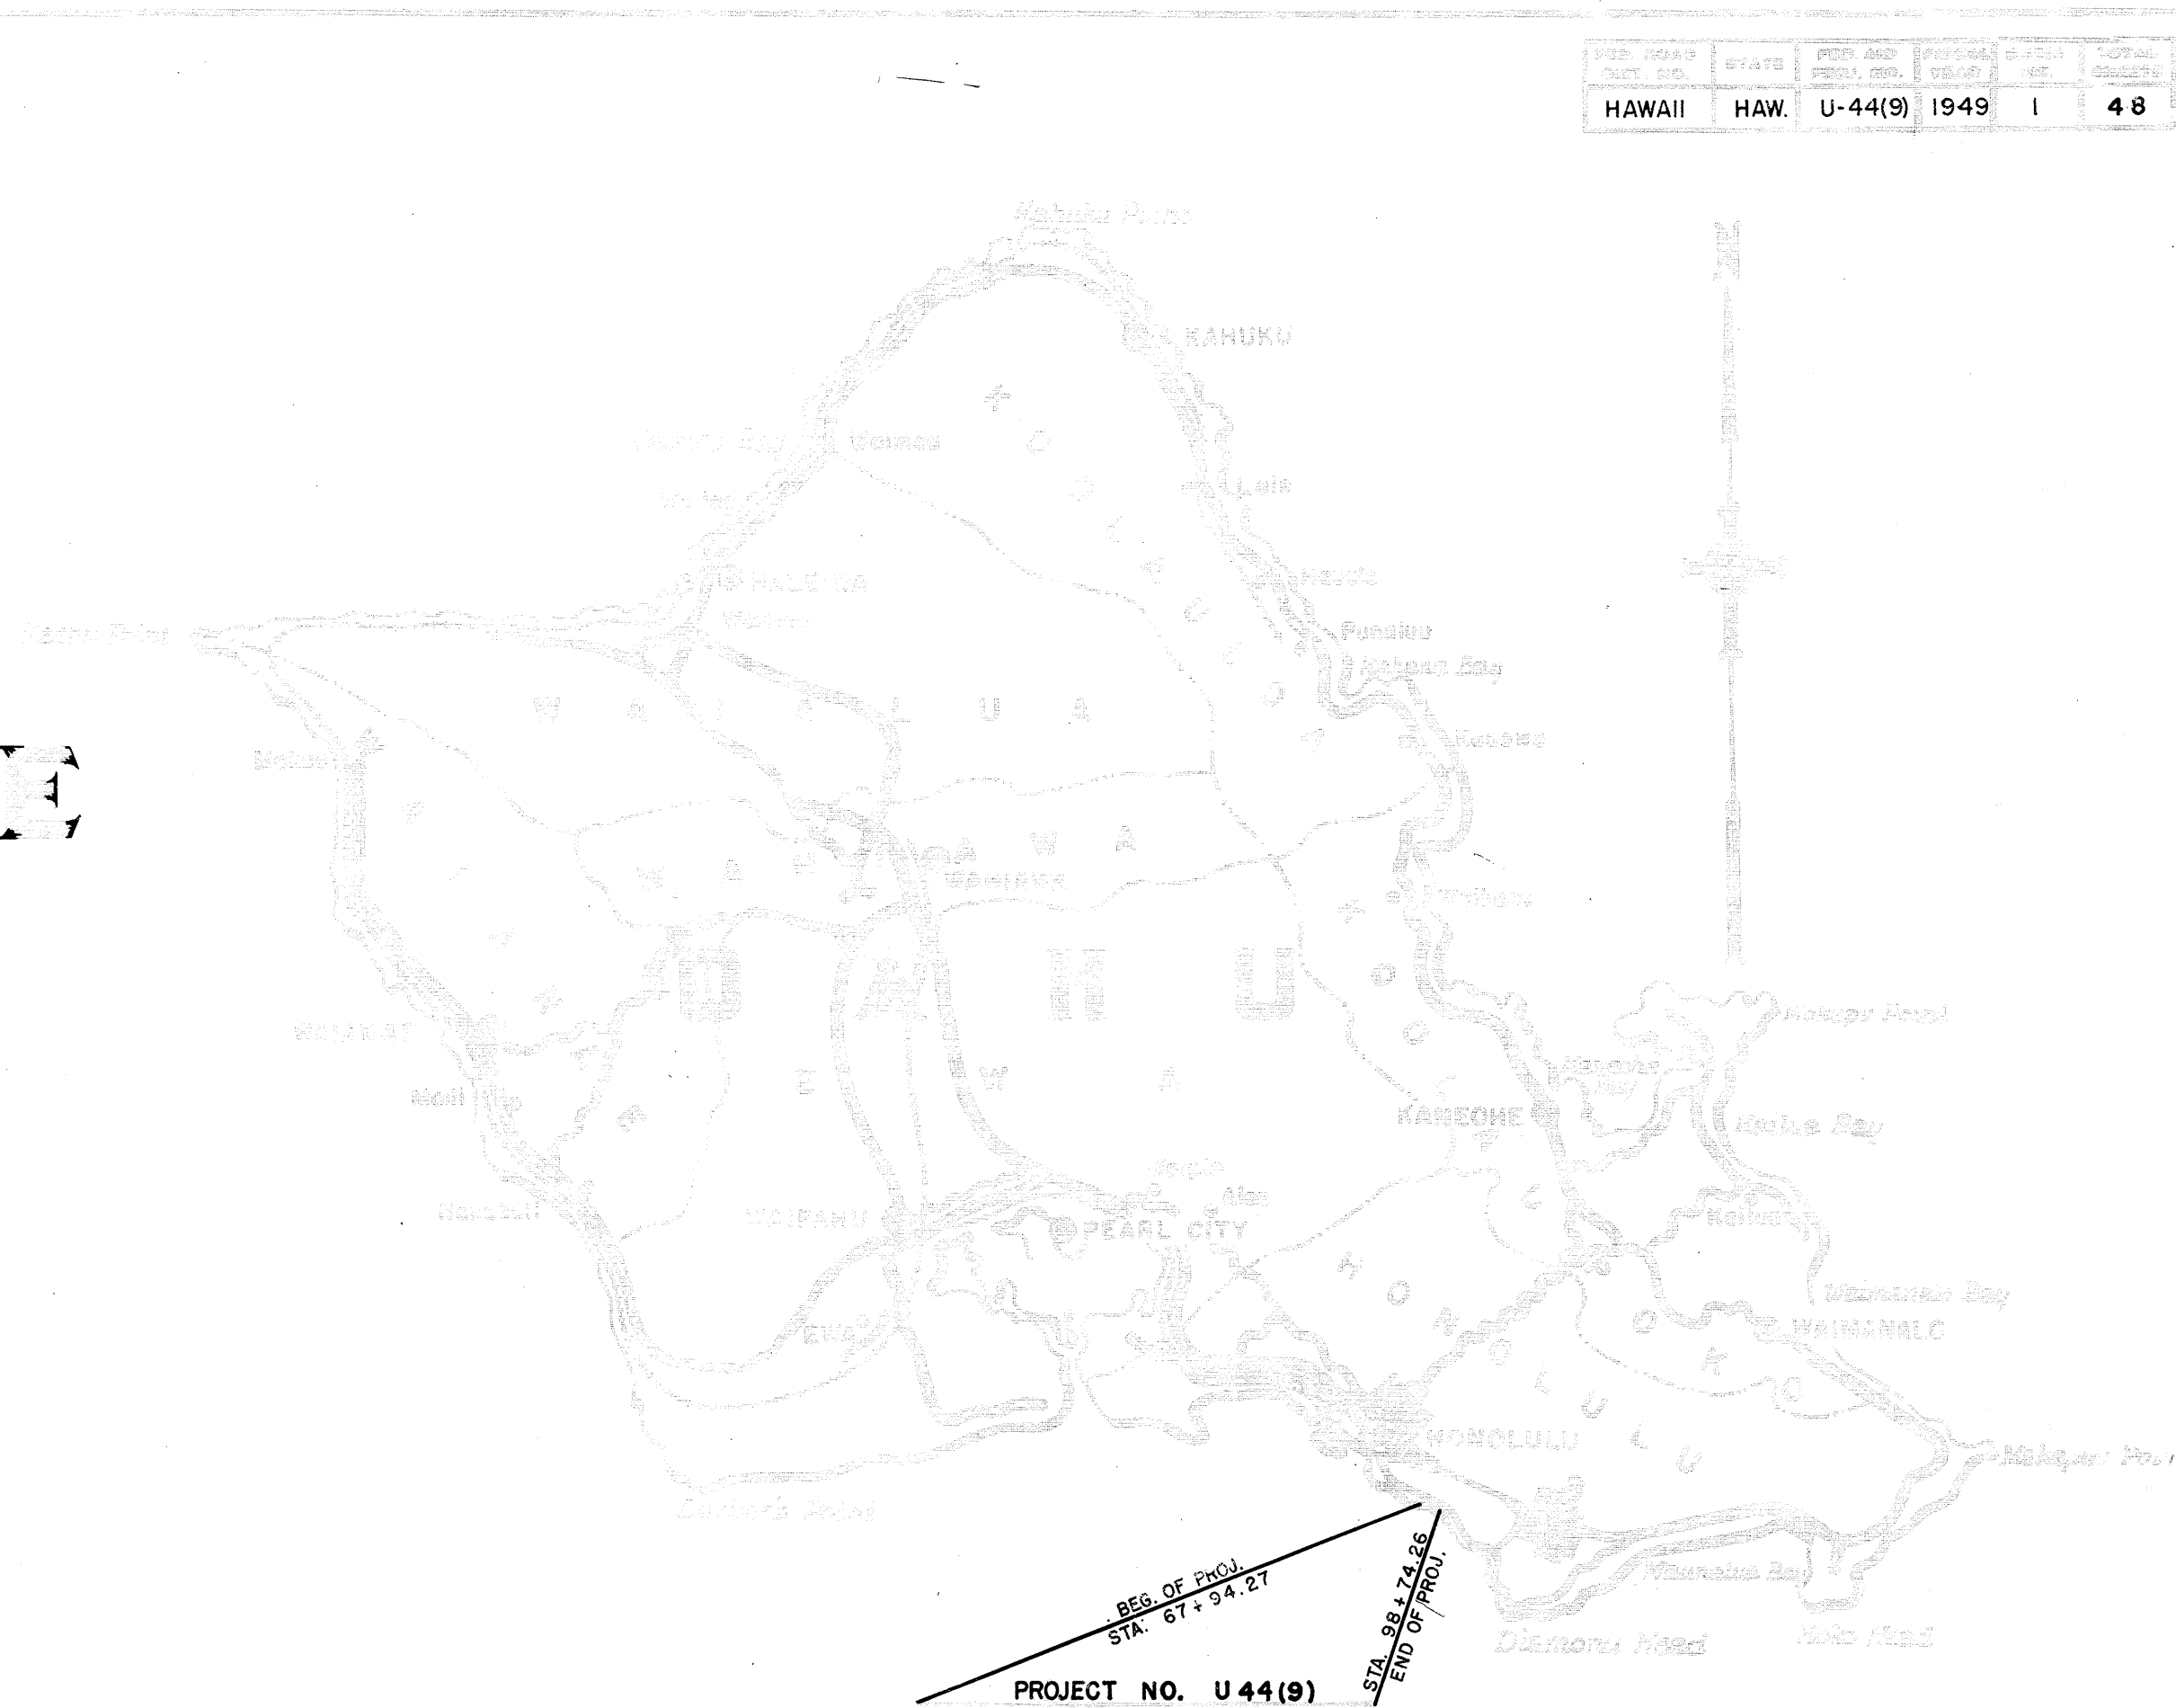


INDEX TO DRAWINGS	
SHEET NO.	DESCRIPTION
1	Title Sheet
2-3	Typical Sections
4-7	Plan and Profile
8-9	Plan Showing Finished Pavement Grades
10-14	Detail Plan of Roadway and Intersections
15-17	Plan of Water System
18-20	Utilities
21-22	Highway Lighting System
23	Traffic Signal System
24-25	Traffic Signs and Pavement Markings
26-31	Landscape Plans & Sprinkler System
32	Adjustment of Rolling and Wall at Bridge
33-35	Details of Concrete Box Culverts & Catch Basins
36	Special Catch Basin & Chain Link Gates
37	Estimated Quantities Of Structures
38-41	Standard Details
42-48	Cross Sections

CONVENTIONAL SIGNS	
Right of Way	163
Boundary Lines	164
Fences (Homed)	165
Existing Roadways	166
Circular Culvert	167
Box Culvert	168
Bridge	169
Telephone Pole	170
Electric Power Pole	171
Water Main	172
Storm Drain	173
Concrete Drop Inlets	174
Concrete Catch Basin	175
Standard Manhole	176
Sewer Manhole	177
Telephone Manhole	178
Fire Hydrant	179
Tree (Large, named)	180
Reference	181

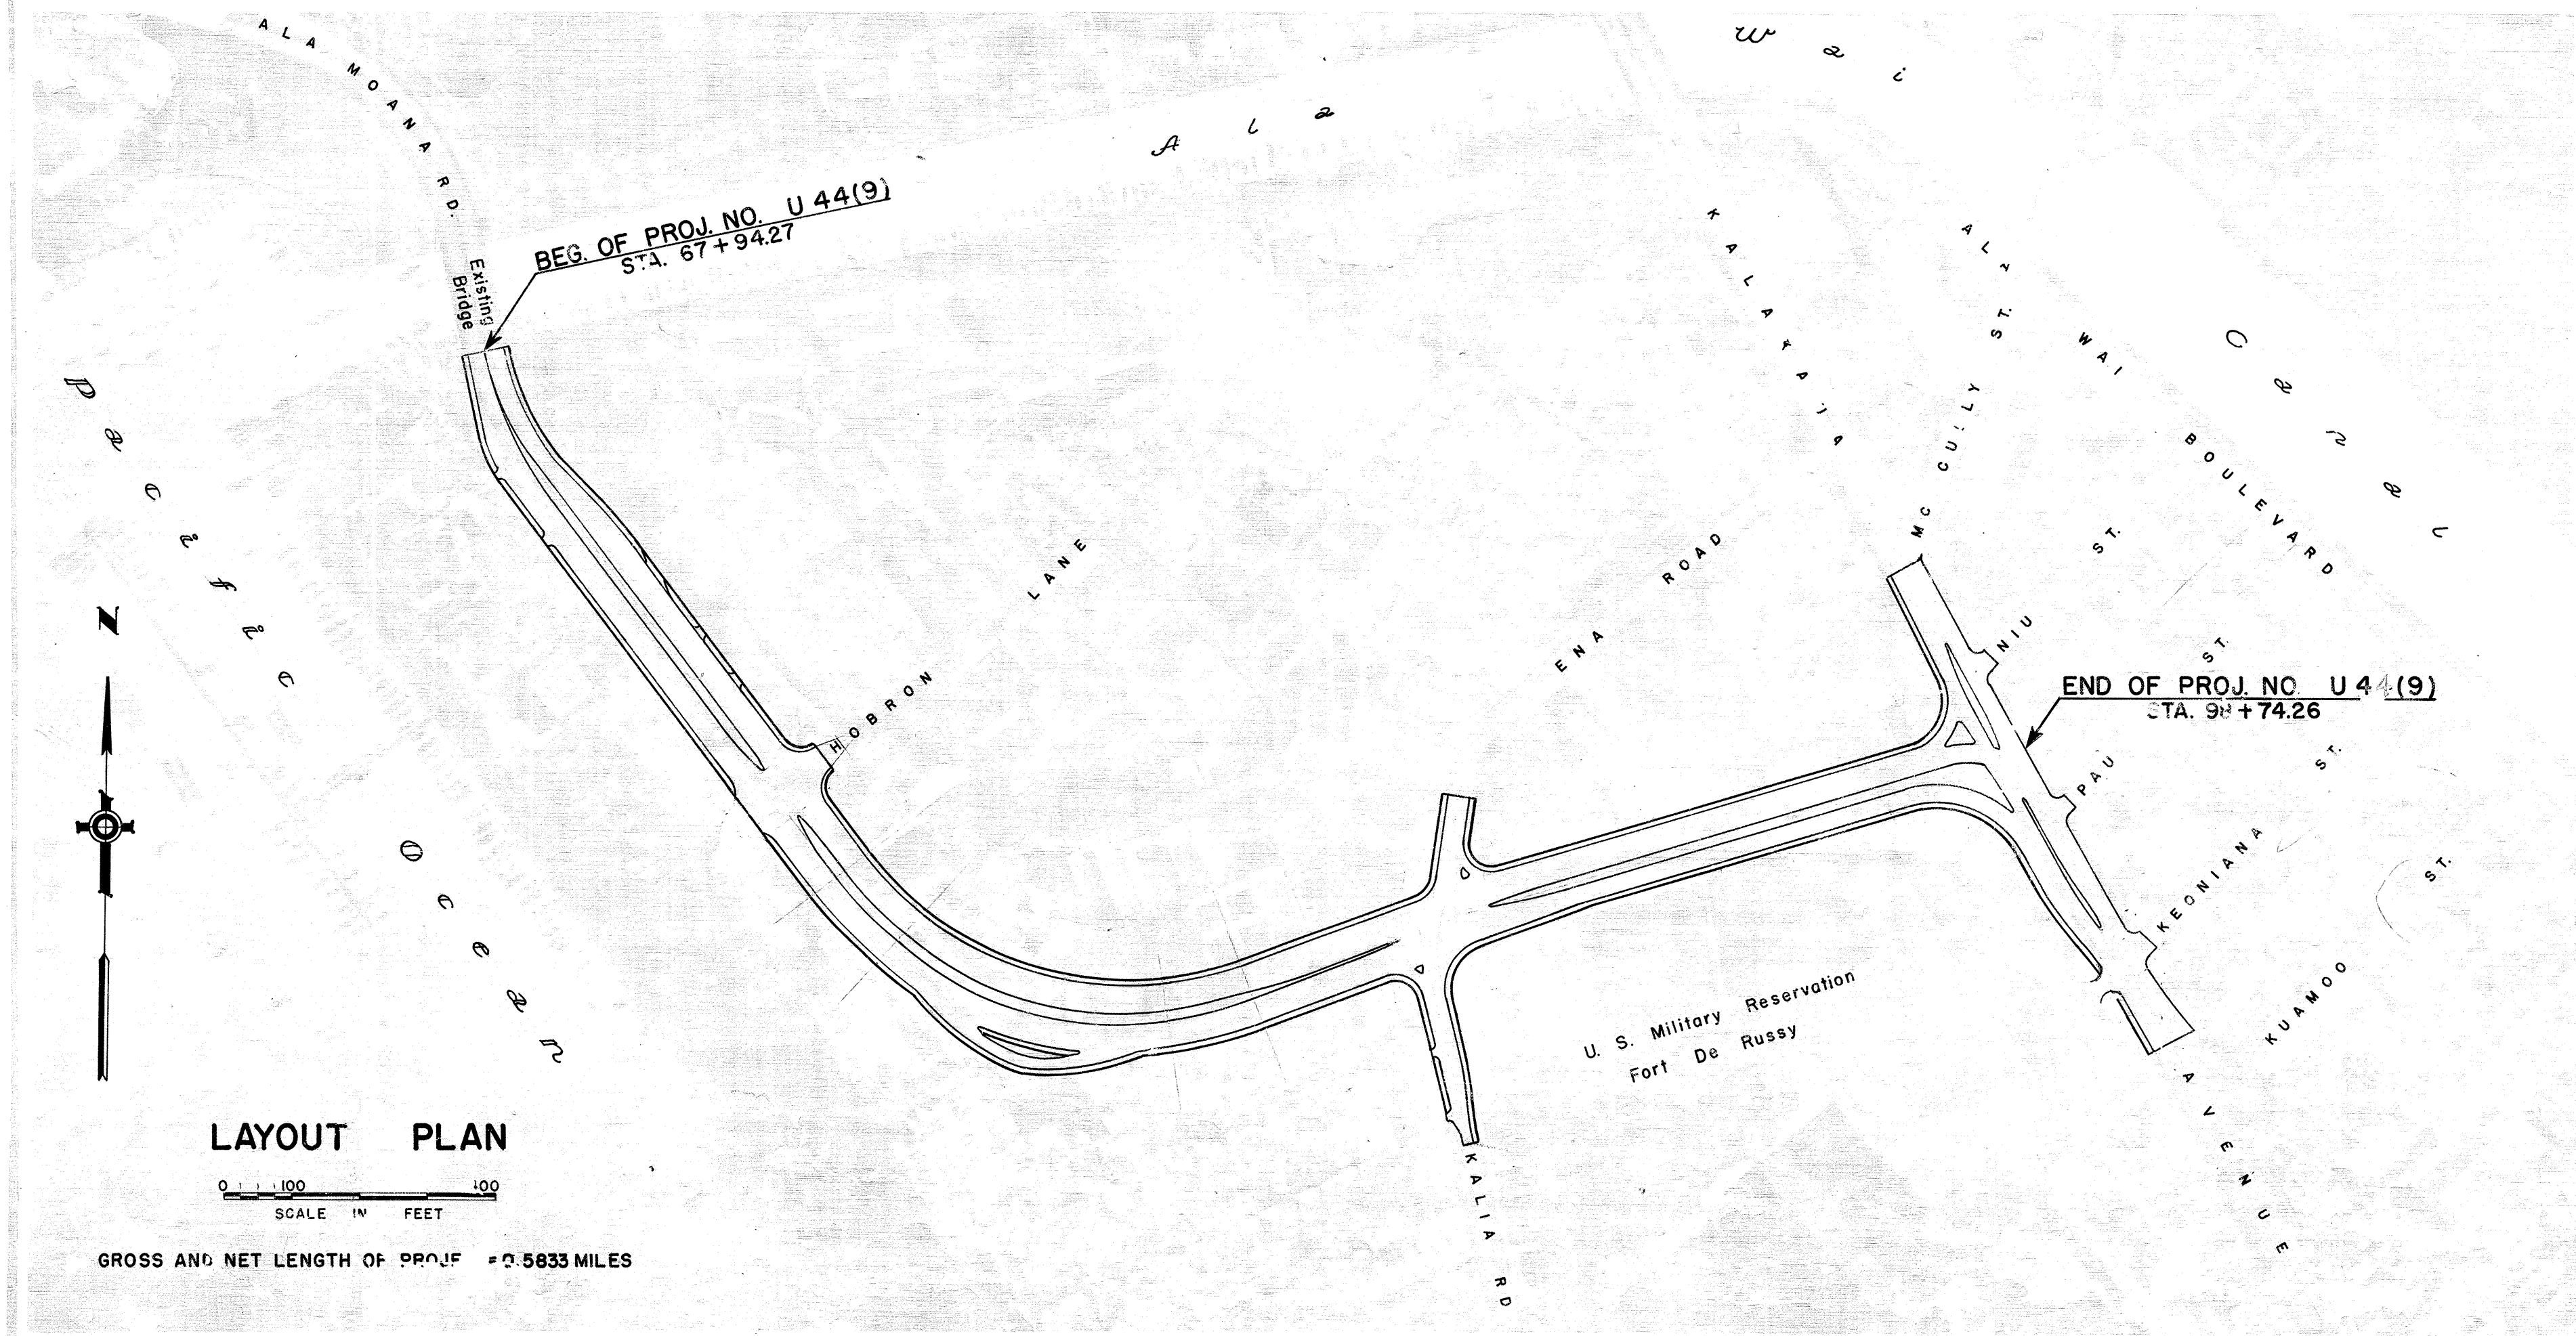

Federal Aid Projects Previously Constructed Or Under Construction

NOTE:
ALL CHANGES MADE DURING CONSTRUCTION
HAVE BEEN NOTED IN RED IN THESE TRACINGS
AND CHECKED BY

Chas. L. Schuster
RESIDENT ENGINEER
DATE Jan. 30, 1952

APPROVED
Ames
DISTRICT ENGINEER

DEPARTMENT OF COMMERCE BUREAU OF PUBLIC ROADS	
RECOMMENDED FOR APPROVAL:	
DISTRICT ENGINEER	DATE
DIVISION ENGINEER	DATE

5420.1