
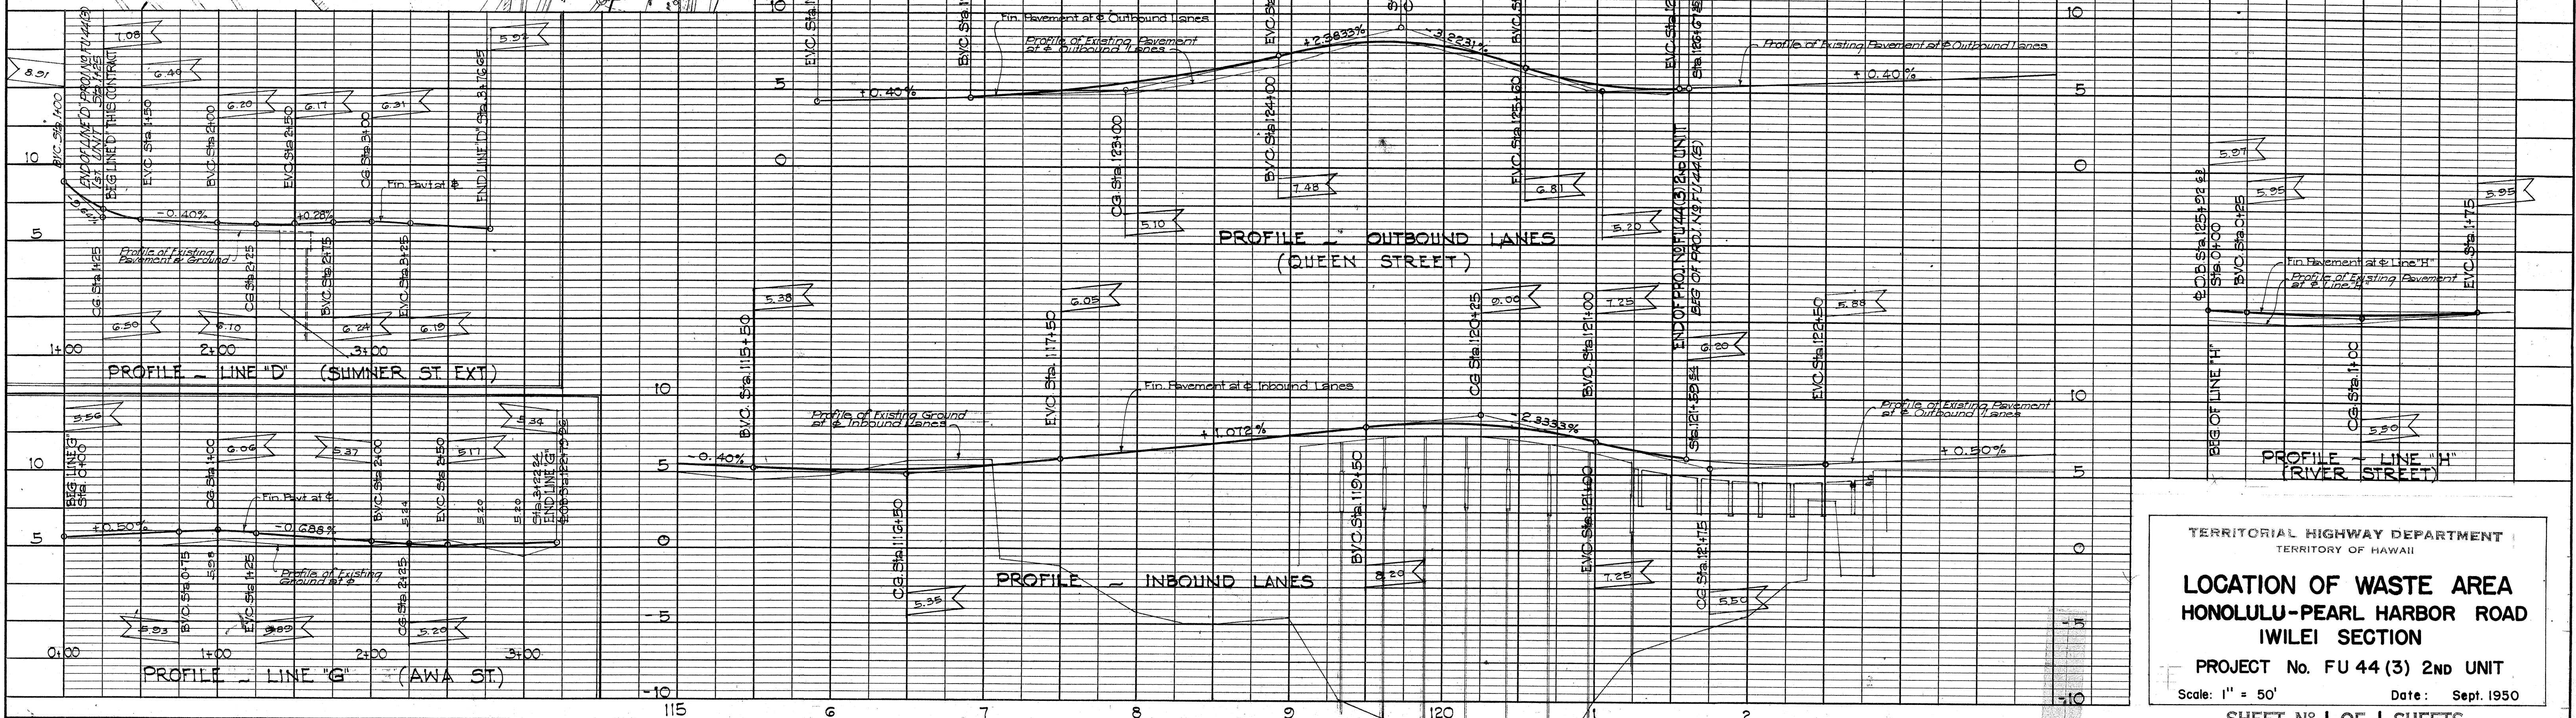


PLAN	SURVEYED	BY	DATE
NO.	PLOTTED		
	ALIGNMENT CHECKED		
	RT. OF WAY CHECKED		

PROFILE	SURVEYED	BY	DATE
NO.	PLOTTED		
	GRADES CHECKED		
	STRUCTURE NOTATIONS CHECKED		

FED. ROAD DIST. NO.	STATE	FED. AID PROJ. NO.	FISCAL YEAR	SHEET NO.	TOTAL SHEETS
HAWAII	HAW	FU 44(3)	1950	7	114

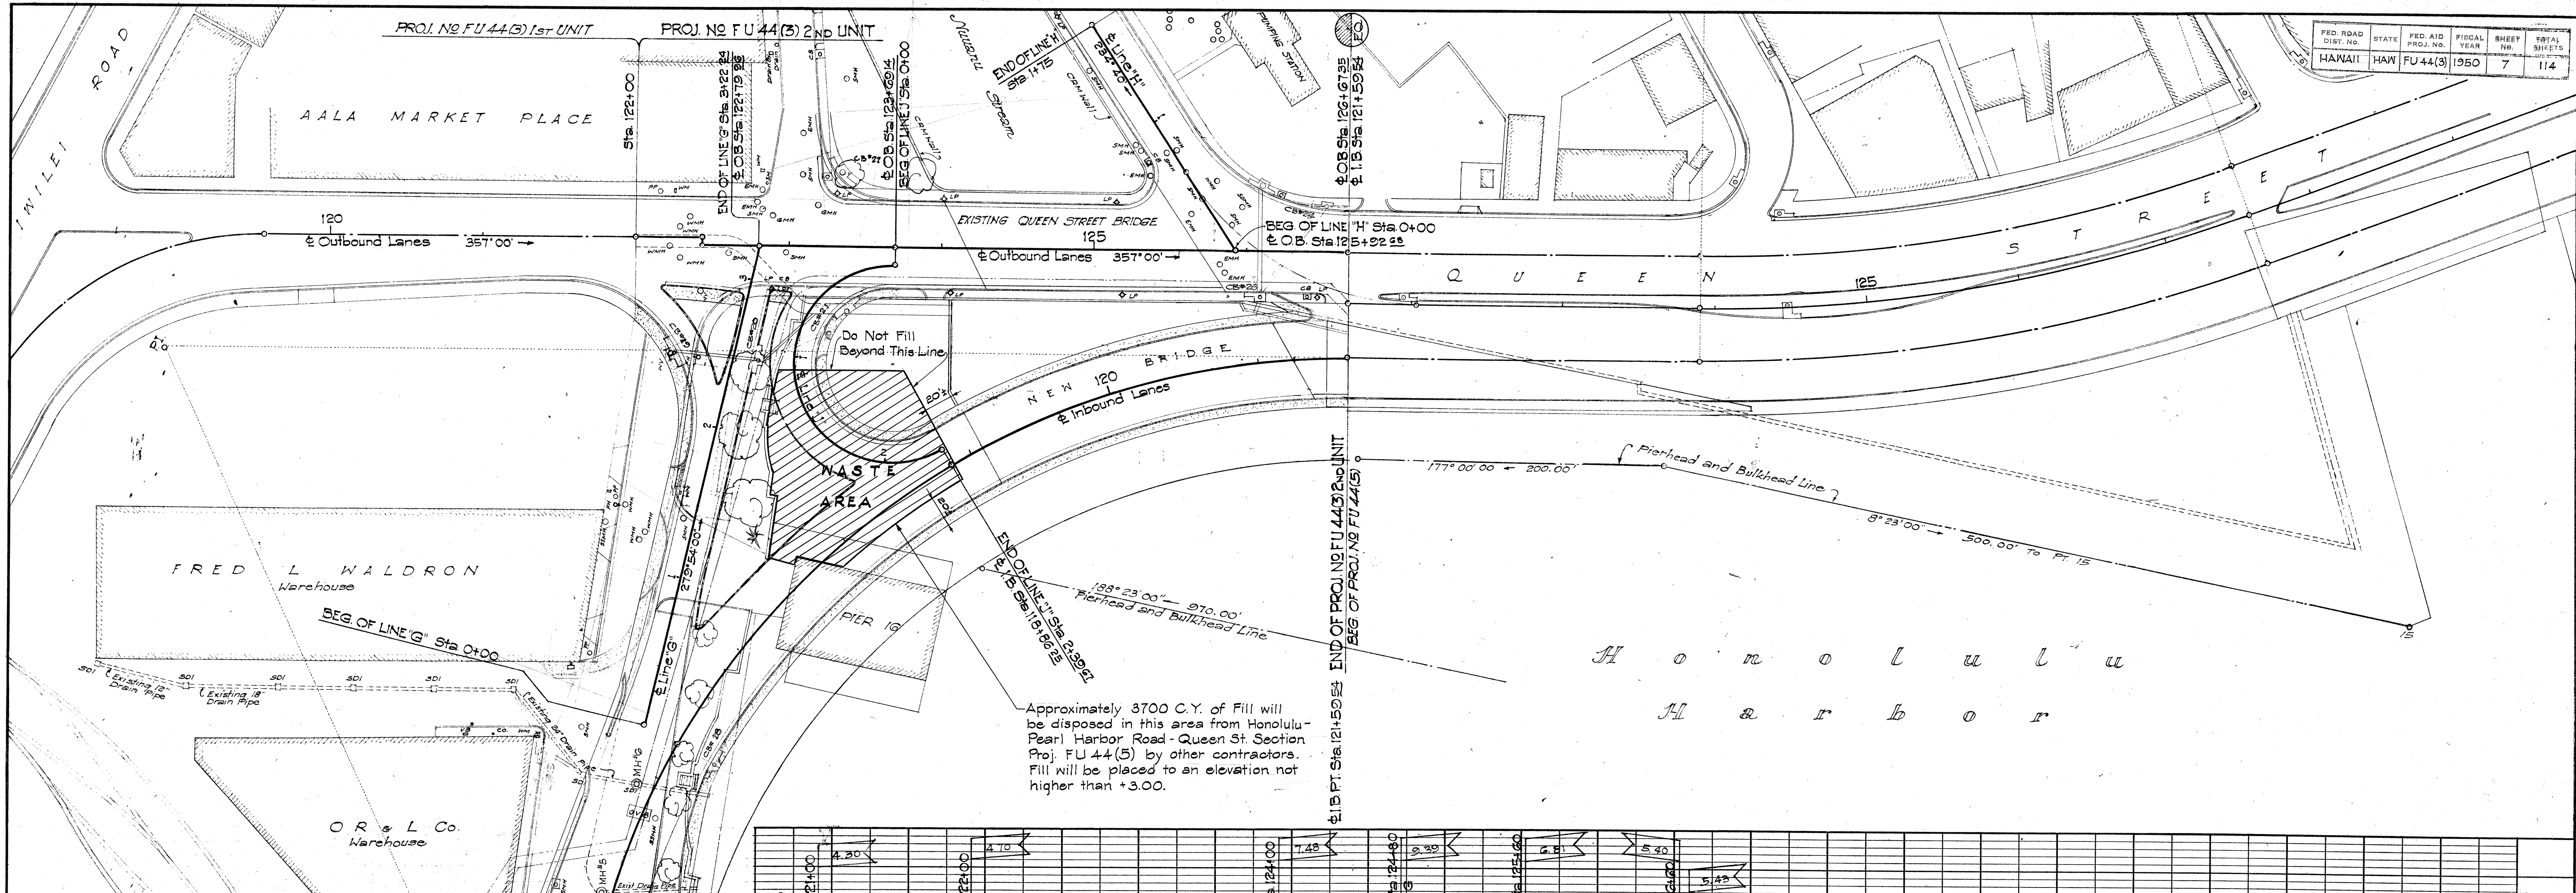

TERRITORIAL HIGHWAY DEPARTMENT
TERRITORY OF HAWAII

LOCATION OF WASTE AREA
HONOLULU-PEARL HARBOR ROAD
IWILEI SECTION

PROJECT No. FU 44(3) 2ND UNIT
Scale: 1" = 50' Date: Sept. 1950

SHEET N° 1 OF 1 SHEETS

5484.7