
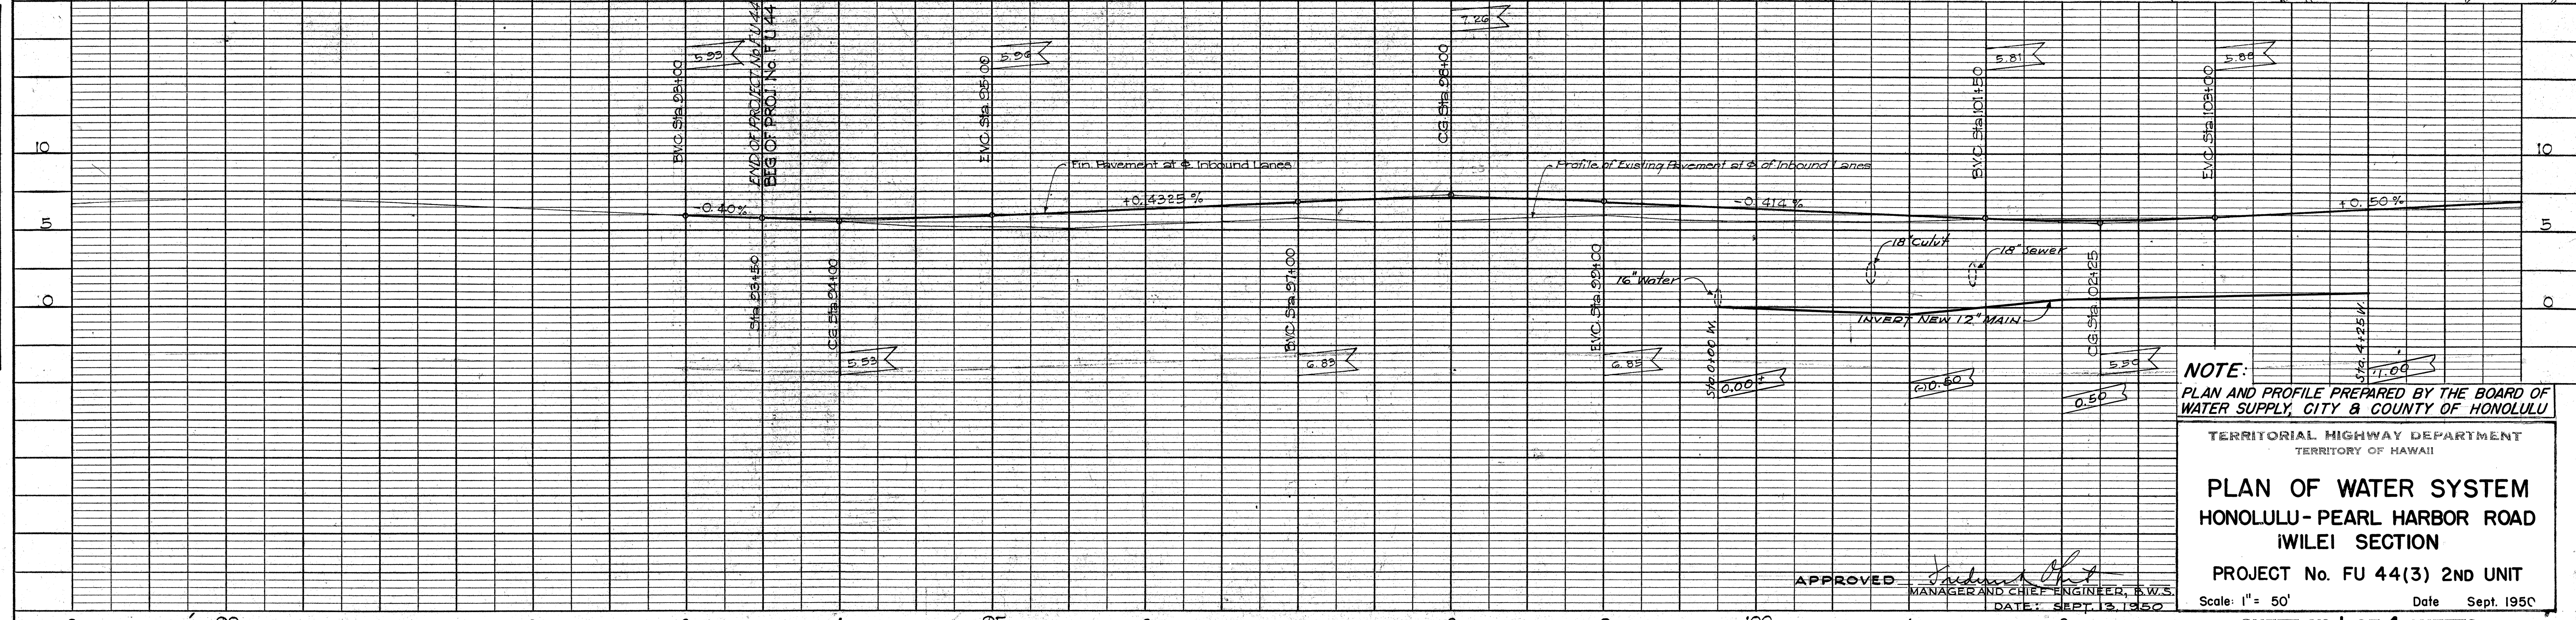


PLAN	DATE	BY
SURVEYED		
NOTED		
NOTE BOOK		
NO.		

PROFILE	DATE	BY
SURVEYED		
NOTED		
NOTE BOOK		
NO.		

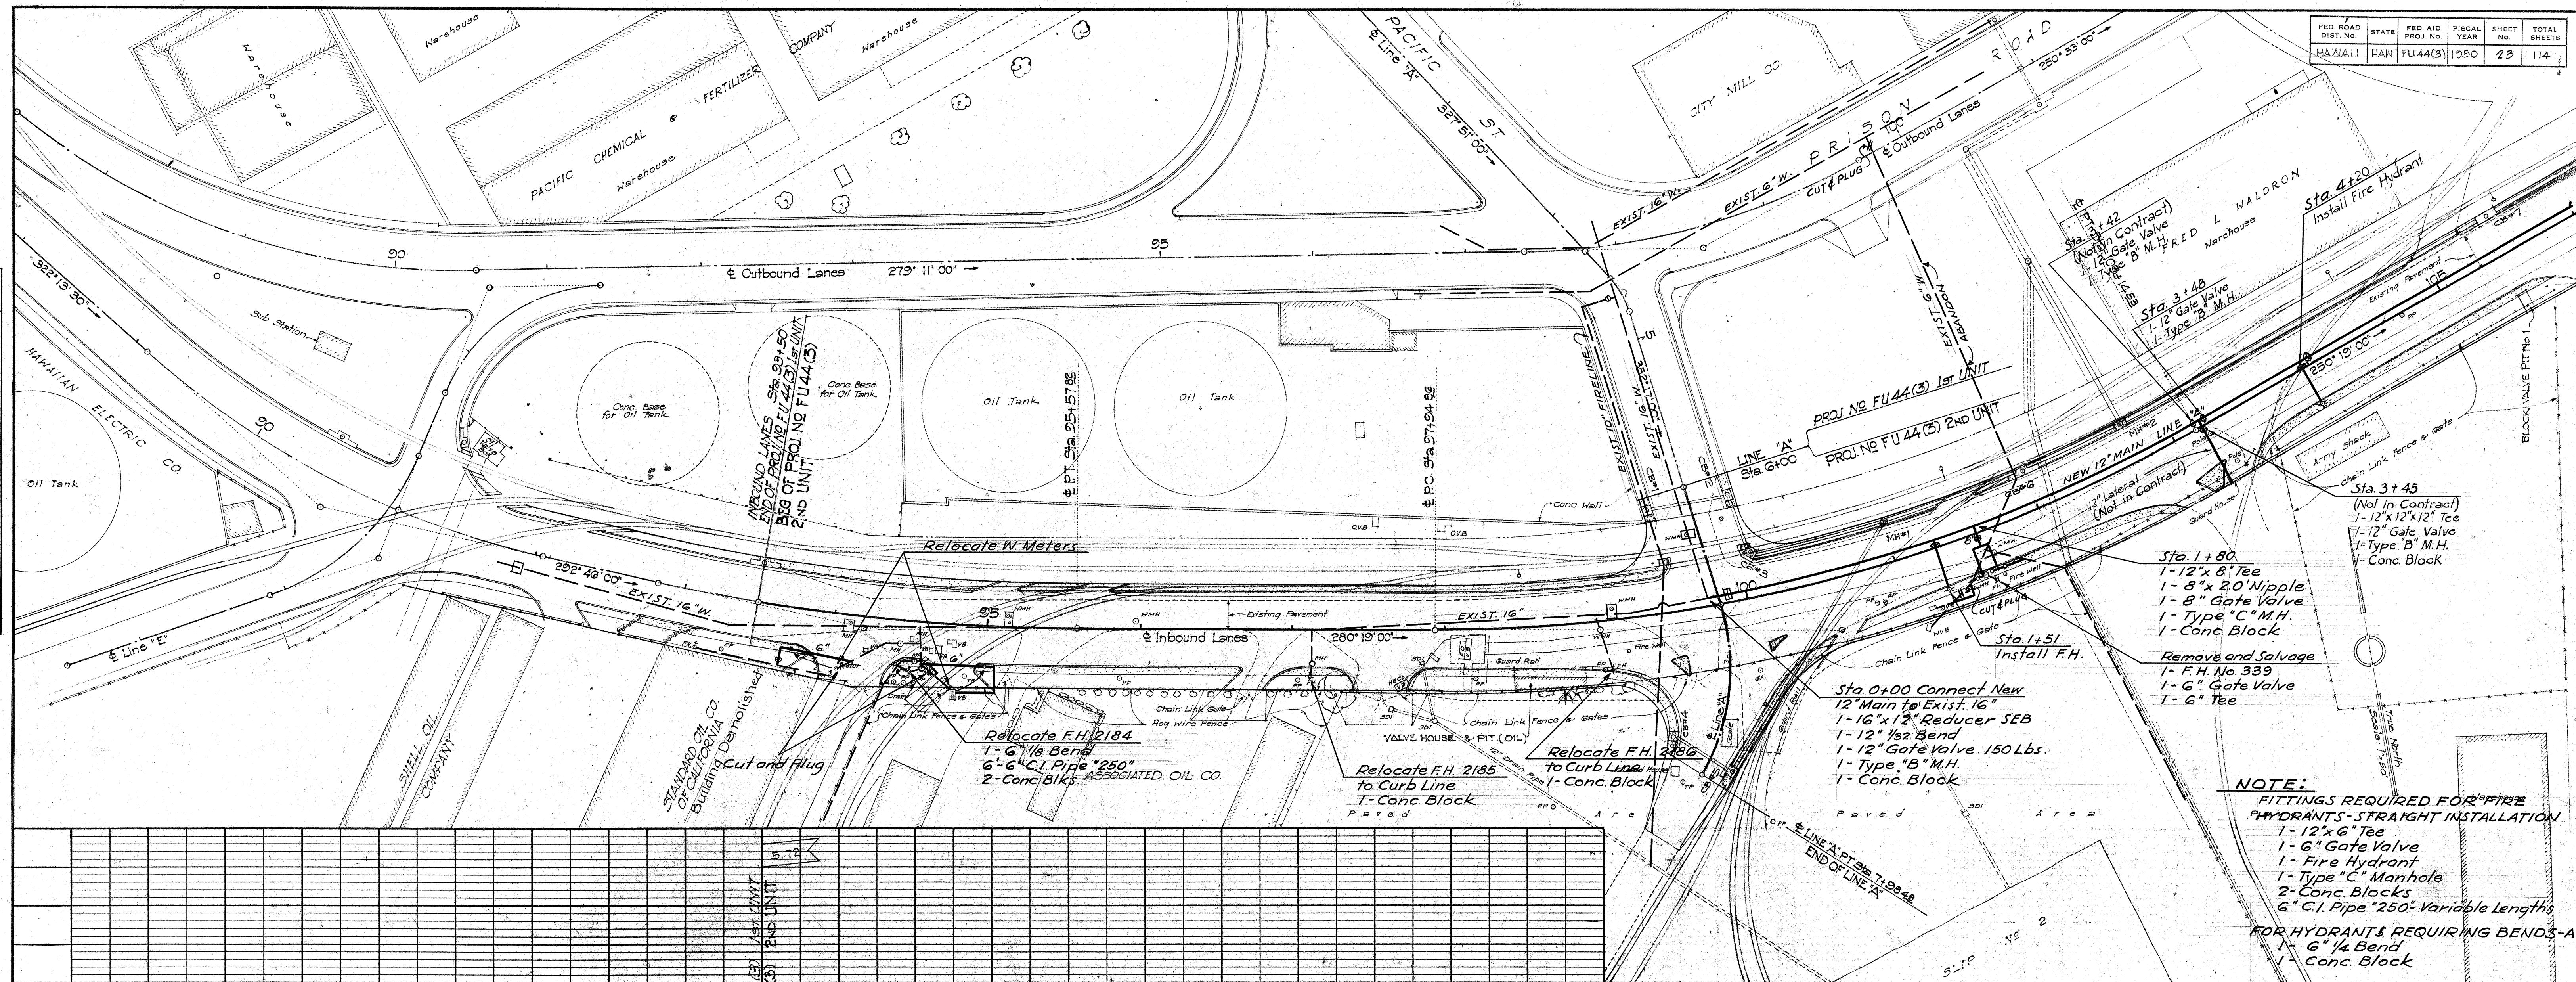

NOTE:
 PLAN AND PROFILE PREPARED BY THE BOARD OF
 WATER SUPPLY, CITY & COUNTY OF HONOLULU

TERRITORIAL HIGHWAY DEPARTMENT
 TERRITORY OF HAWAII

**PLAN OF WATER SYSTEM
 HONOLULU-PEARL HARBOR ROAD
 IWILEI SECTION**

PROJECT No. FU 44(3) 2ND UNIT

Scale: 1" = 50' Date: Sept. 1950

APPROVED: *[Signature]*
 MANAGER AND CHIEF ENGINEER, B.W.S.
 DATE: Sept. 13, 1950

5484.23

PLAN	DATE	BY
SURVEYED		
NOTE BOOK		
ALIGNMENT CHECKED		
RT. OF WAY CHECKED		
NO.		

PROFILE	DATE	BY
SURVEYED		
GRADES CHECKED		
STRUCTURE NOTATIONS CH'VD.		
NO.		

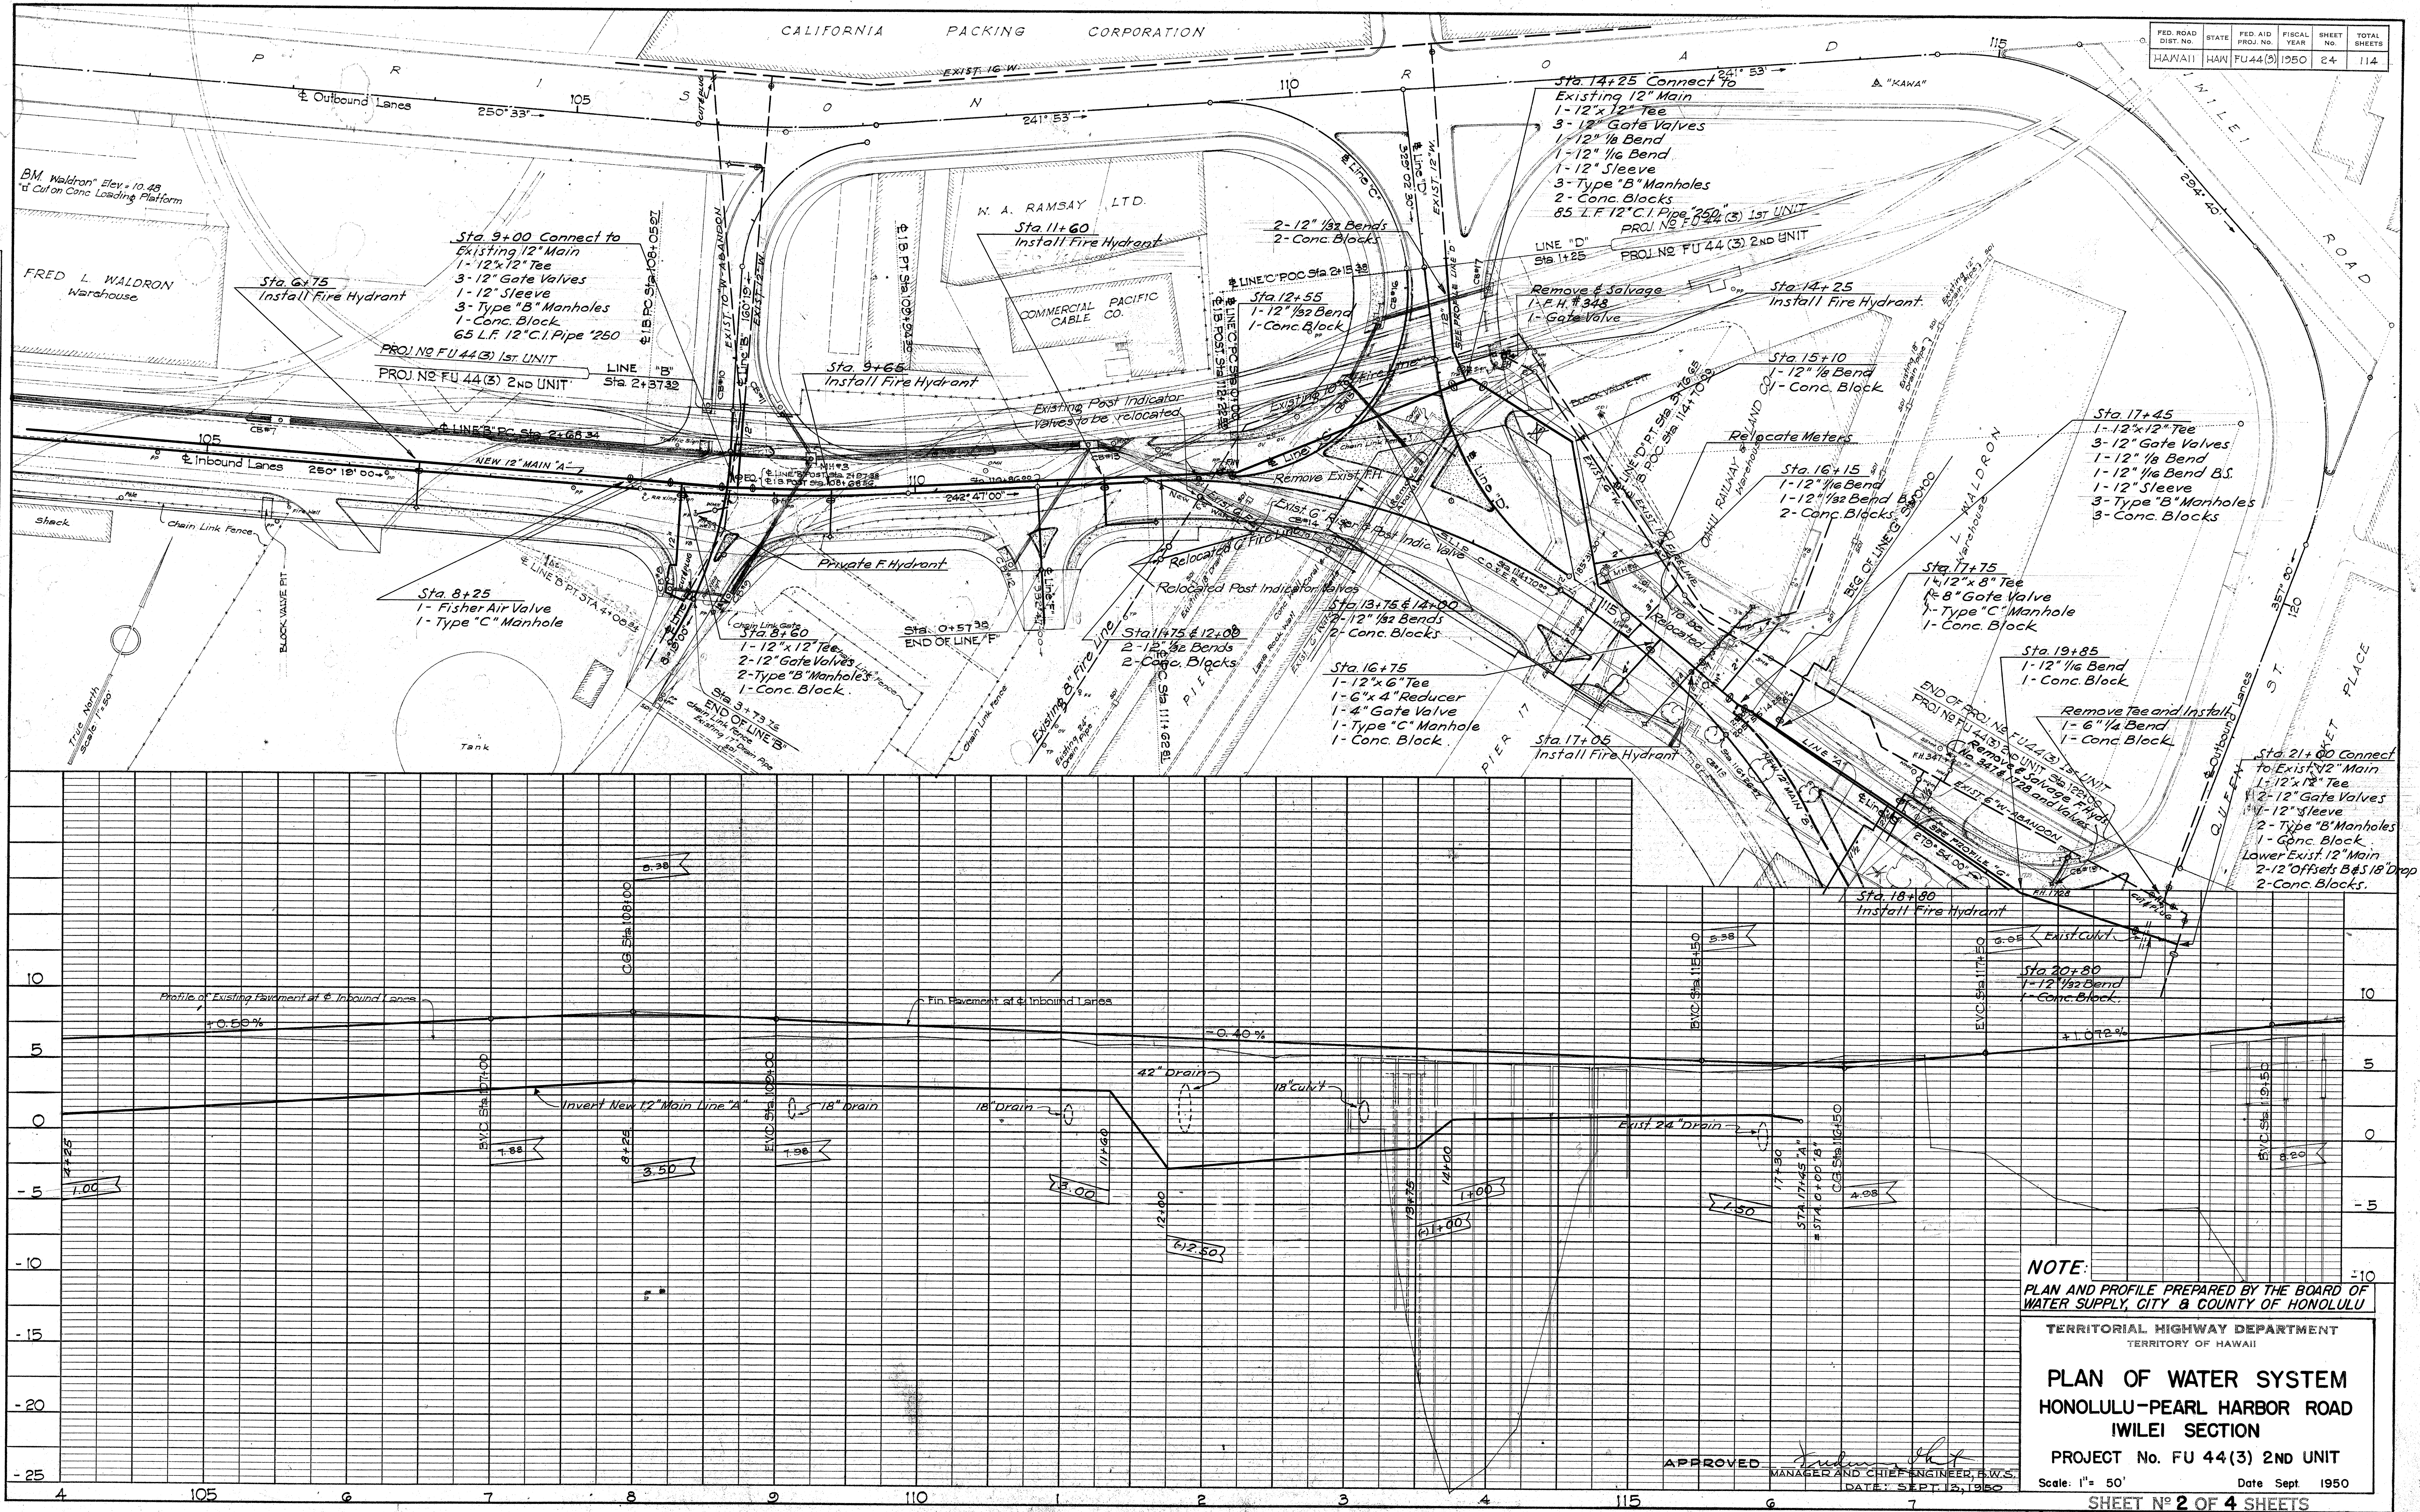


PLATE 1-PLAN-PROFILE (O.P.R. & R.E. STANDARD)
KEUFFEL & ESSER CO., NEW YORK

K & E Co. No. 348-10

5484.24

DATE	BY
SURVEYED	
NOTED	
RT. OF WAY CHECKED	
NO.	

DATE	BY
SURVEYED	
NOTED	
RT. OF WAY CHECKED	
NO.	

