

TERRITORY OF HAWAII
TERRITORIAL HIGHWAY DEPARTMENT
HONOLULU, OAHU, T. H.

PLANS OF
HONOLULU PEARL HARBOR ROAD
IWILEI SECTION
FEDERAL AID URBAN PROJECT NO. FU 44 (3) 2ND UNIT
DISTRICT OF HONOLULU
ISLAND OF OAHU


INDEX TO DRAWINGS	
SHEET NO.	DESCRIPTION
1	Title Sheet
2 - 3	Typical Sections
4 - 6	Plan and Profile
7	Location of Waste Area
8 - 12	Detail Plan of Roadway & Intersection
13 - 22	Oil Pipe Line Layout
23 - 26	Plan of Water System
27 - 30	Railroad Tracks
31 - 33	Highway Lighting System
34 - 36	Traffic Signal System
37 - 40	Traffic Signs & Pavement Markings
41 - 47	Landscape Plans
48 - 51	Detail of Drainage Structures
52	Estimated Quantities of Structures
53 - 55	Standard Details
56 - 66	Cross Sections
67 - 80	Kapalama Relief Sewer
81 - 112	Slip Cover, Retaining Wall, & Bridge
113 - 114	Alterations to Pier 18

CONVENTIONAL SIGNS

Center Line (C) & Base Line (B)	100
Right of Way (R/W) Line	or
Fences (Named)	
Existing Roadway	
Concrete Pipe Culvert	
Concrete Box Culvert	
Standard Catch Basin	
Concrete Drop Intake	
Existing Drain Pipe	
Manhole (Named)	
Water Line	
Fuel Oil Line	
Diesel Oil Line	
Telephone Pole	
Electric Power Pole	
Fire Hydrant	
Tree (Large, Named)	
Existing R R Track	
Relocated R R Track	
R R Track to be Removed	
Adjusted R. R. Track	

SCALES


PLAN	1	INCH = 50 FEET
PROFILE	HOR.	1
	VER.	1
		INCH = 5 FEET
GROSS SECTIONS	HOR.	1
	VER.	1
		INCH = 10 FEET
		INCH = 5 FEET

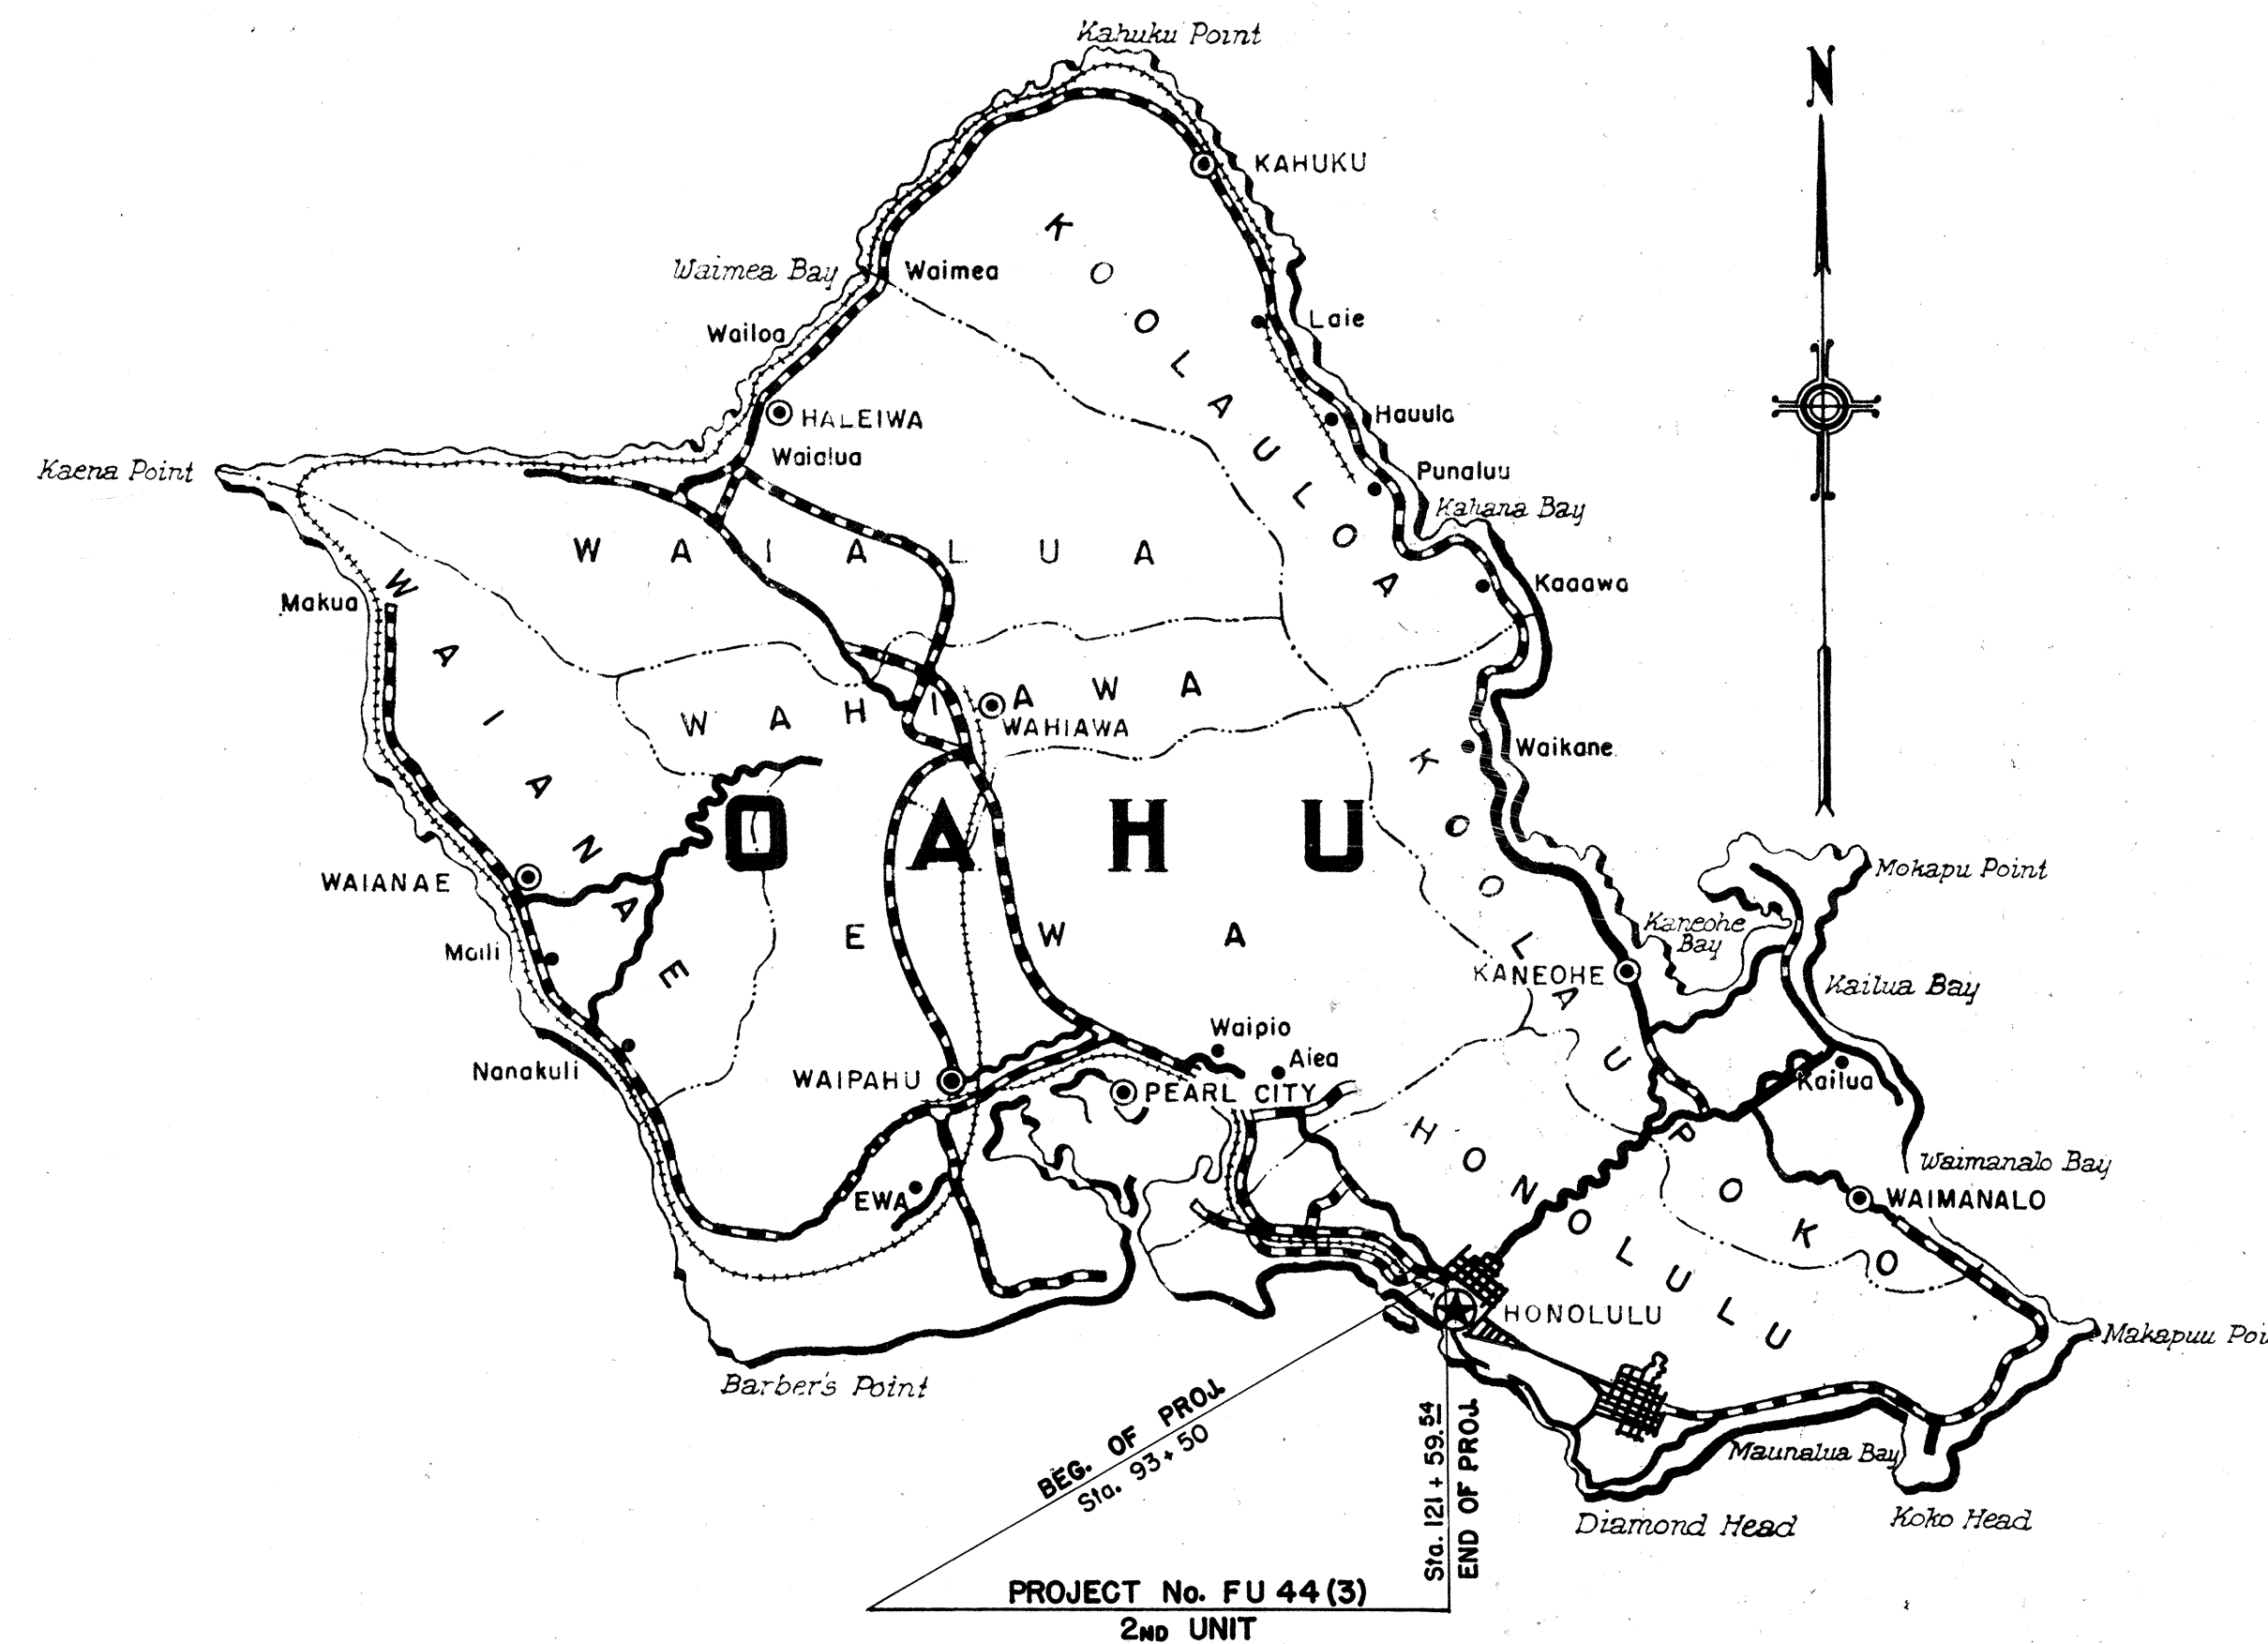

Federal Aid Projects Previously Constructed Or Under Construction

NOTE:
All changes made during construction
have been noted in red in these plans
and checked by:

Bernard J. Okamoto
Project Engineer
Date: Apr. 6, 1953

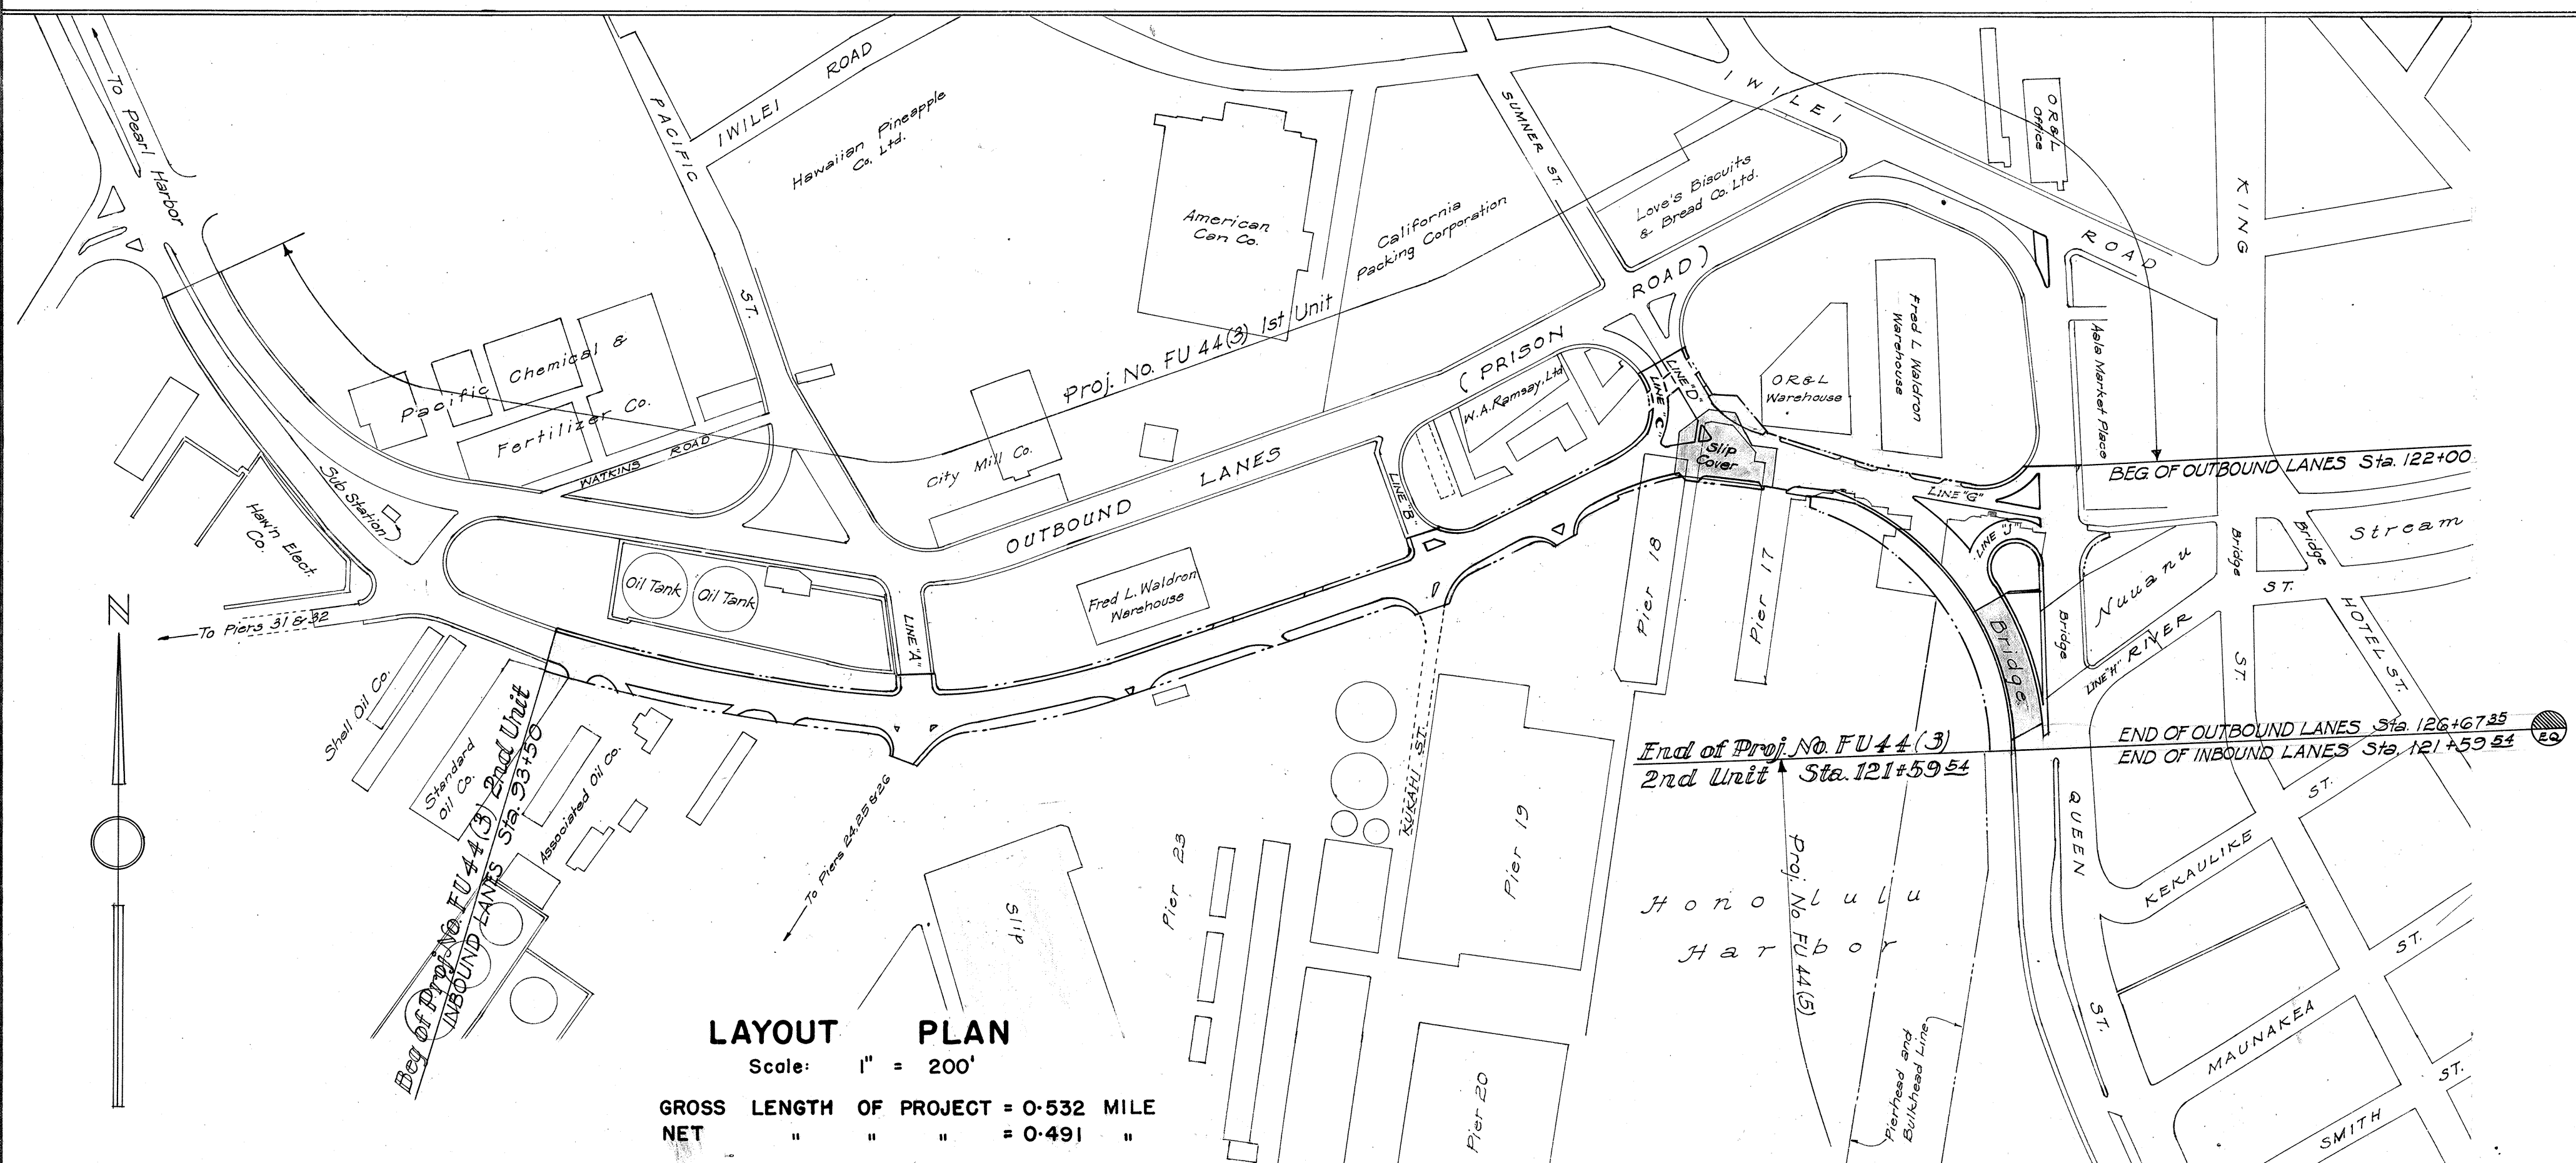

LAYOUT PLAN
Scale: 1" = 200'
GROSS LENGTH OF PROJECT = 0.532 MILE
NET " " " = 0.491 "

APPROVED
TERRITORIAL HIGHWAY ENGINEER

DEPARTMENT OF COMMERCE
BUREAU OF PUBLIC ROADS
RECOMMENDED FOR APPROVAL:
DISTRICT ENGINEER
APPROVED:
DIVISION ENGINEER

5484.1