



PLAN
Scale: $\frac{1}{8}$ " = 1'-0"

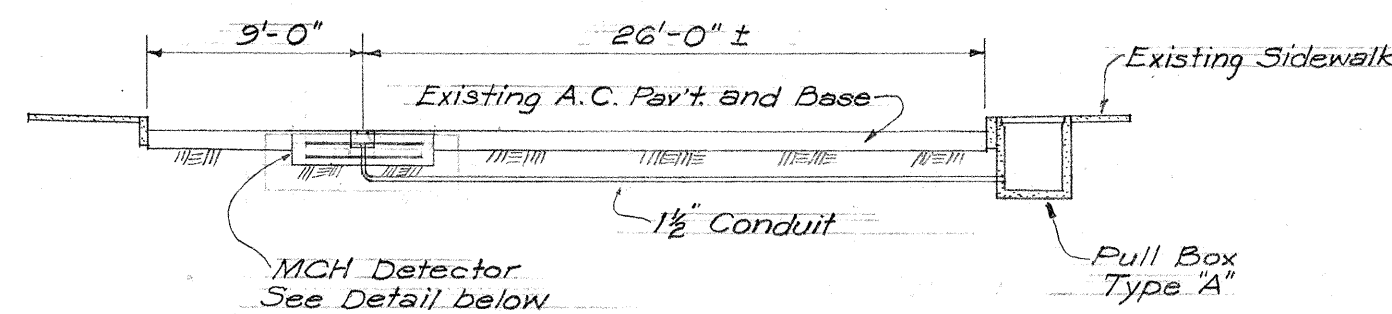


LAYOUT OF DETECTOR IN CONC. BLOCK
LOCATED IN LINE "H" (RIVER ST.)
Scale: $\frac{1}{8}$ " = 1'-0"

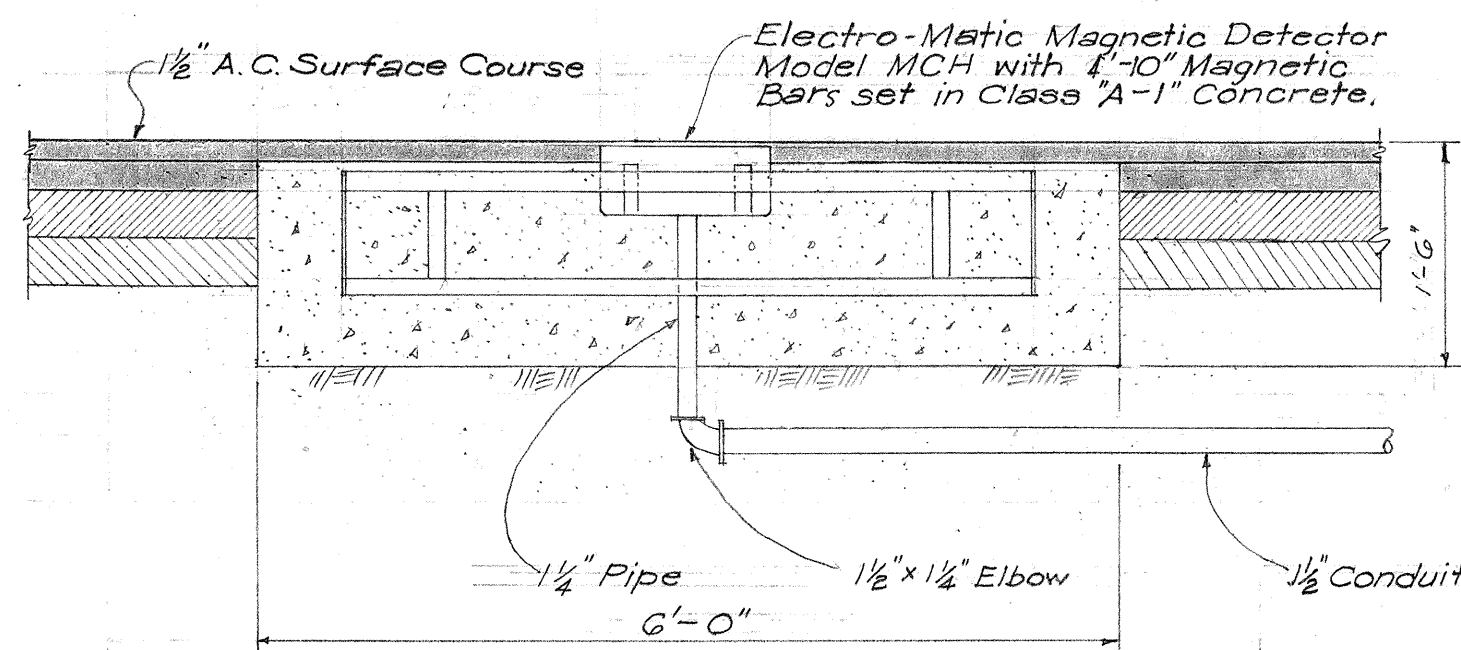


DETAIL OF DETECTOR IN CONCRETE
Scale: $\frac{3}{4}$ " = 1'-0"


NOTE: Class "A-1" Concrete shall be paid for under the appropriate contract item of "Class A-1" Concrete other than in Bridges. Excavation shall be paid for under the item of "Unclassified Excavation for Structures".

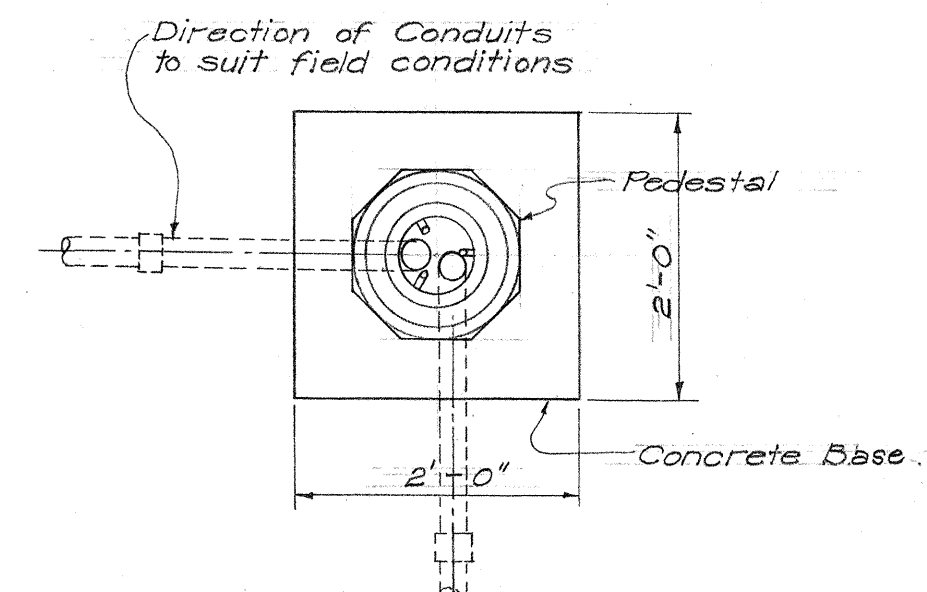


SECTION "A-A"

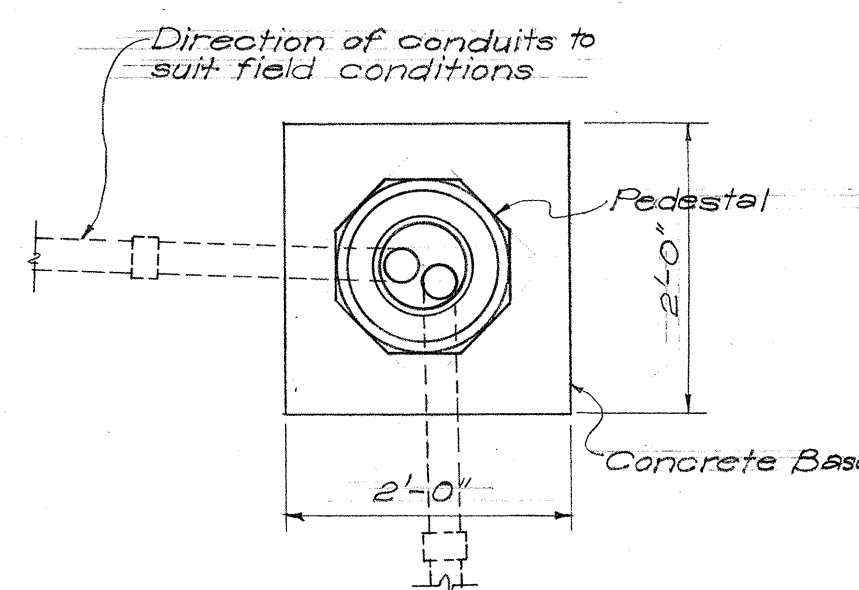


SECTION "A-A"

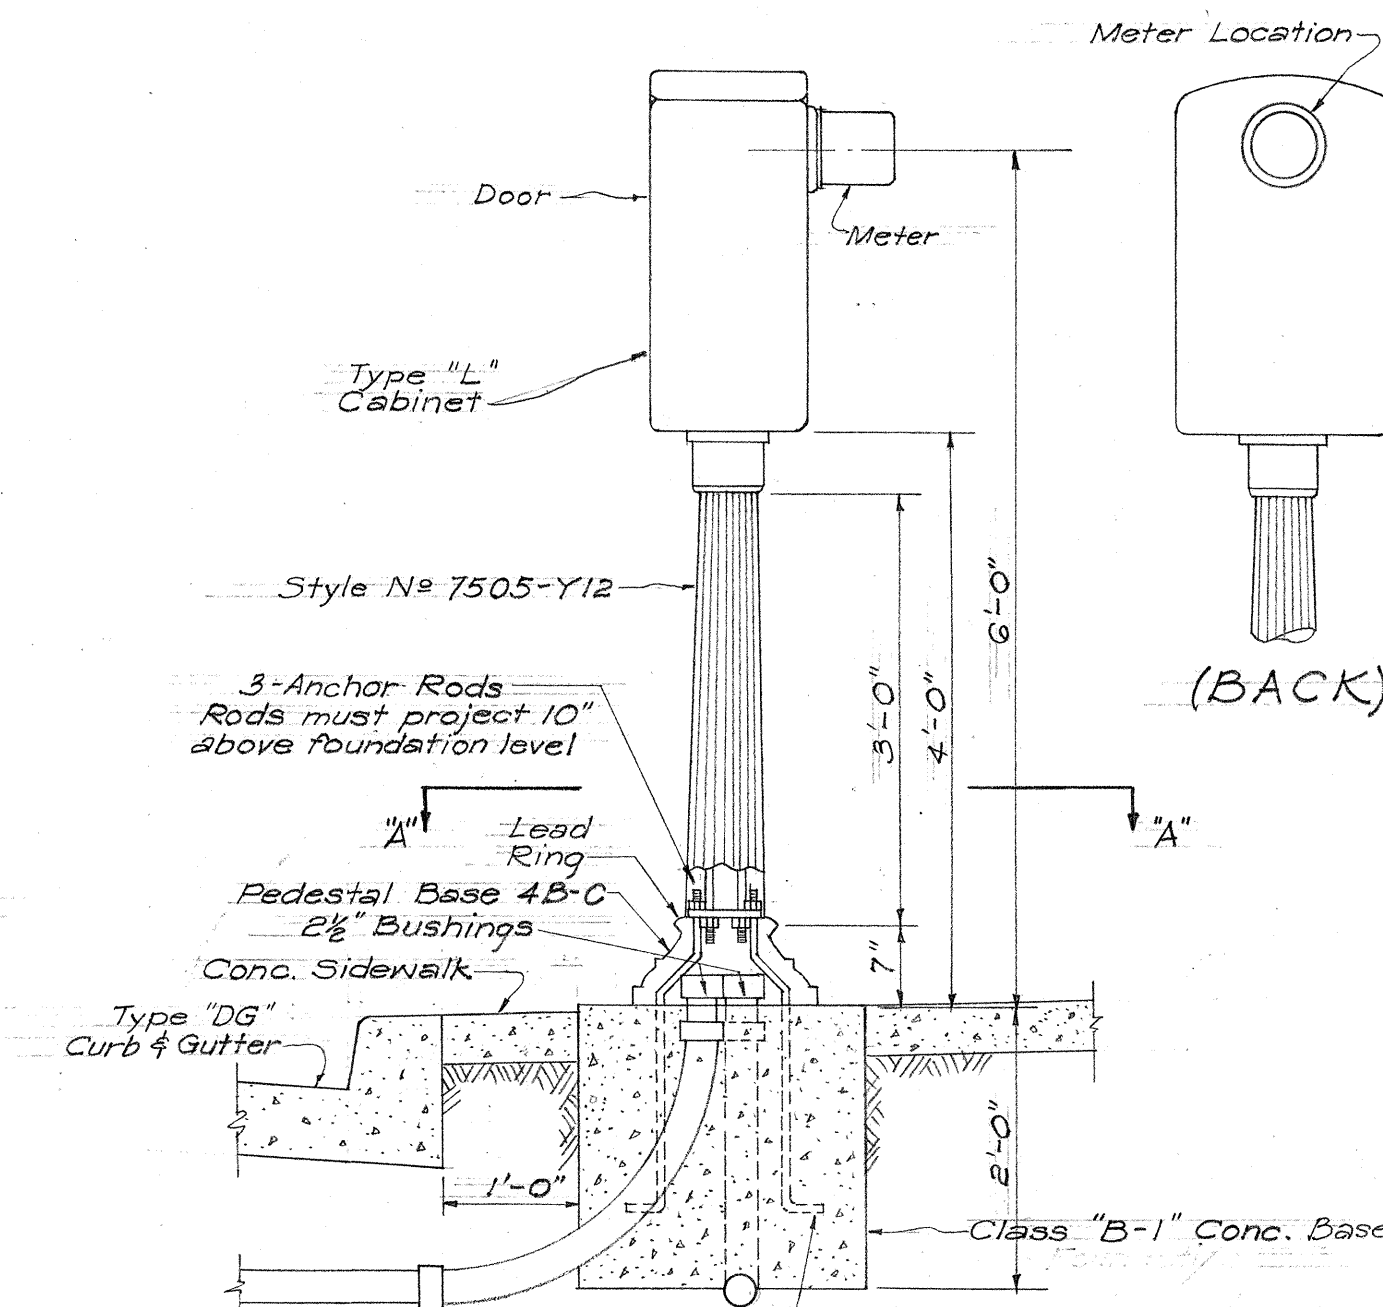


DISPATCHER CABINET ASSEMBLY
Scale: $\frac{3}{4}$ " = 1'-0"

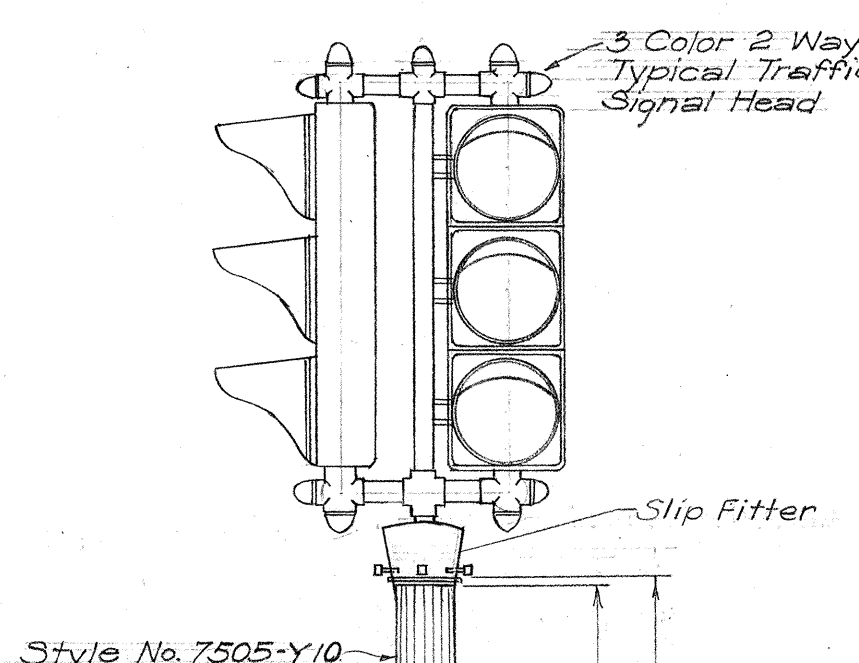

TRAFFIC SIGNAL ASSEMBLY
Scale: $\frac{3}{4}$ " = 1'-0"

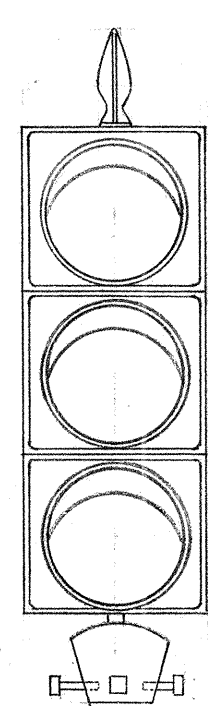

ONE-WAY
SIGNAL HEAD
Scale: 1" = 1'-0"

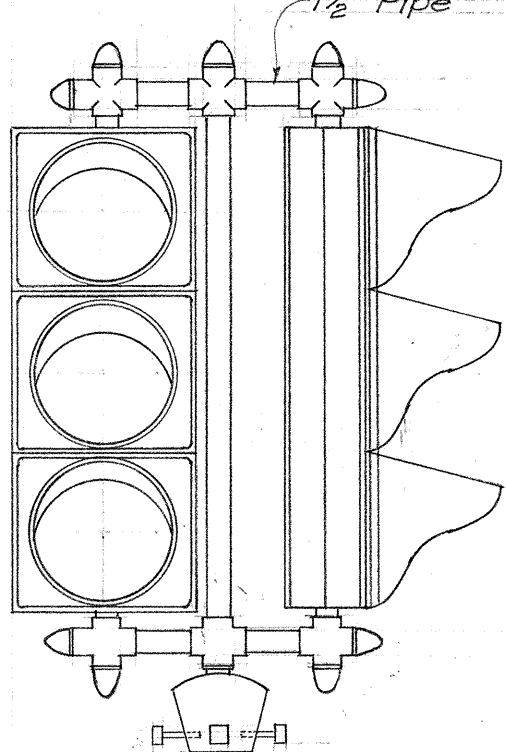

TWO-WAY
SIGNAL HEAD
Scale: 1" = 1'-0"

1 required at Line "A" (Pacific St) Intersection. 3 required at Line "A" (Pacific St) Intersection.
1 required at Line "H" (River St) Intersection. 2 required at Line "H" (River St) Intersection.


NOTE: All traffic signal heads shall be sectionalized adjustable traffic signals and shall be assembled together to conform to sketches shown above.

One-Way, Three Color Signals shall be General Electric Model No. 2TA23A13.
Two-Way, Three Color Signals shall be General Electric Model No. 2TA23B4.


All signal heads shall be complete with the required red, yellow and green lenses with fixed focus sockets, reflectors, sheet aluminum visors of conventional design, and lamps as shown in General Electric Co. Catalogue Section No. 3621.

All signal heads shall be assembled with $\frac{1}{2}$ " pipe, pipe fittings and adaptor as shown in General Electric Co. Catalogue Section No. 3621, pages 2 and 6.


All tapes used for splicing wires, cables, etc. shall be Scotch Tape No. 33.

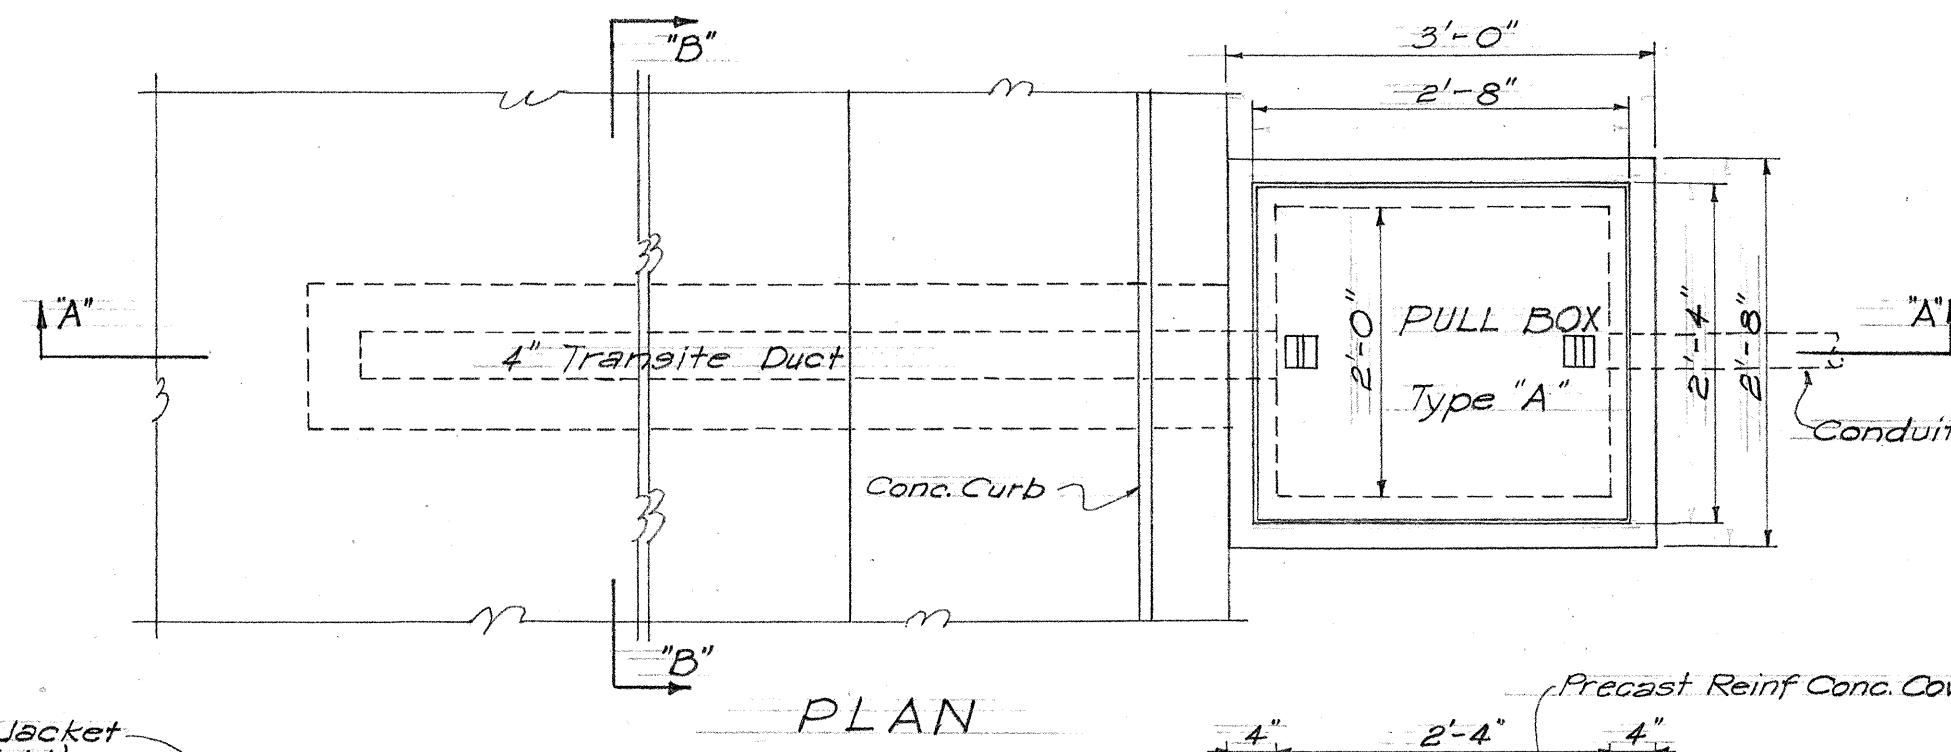

PLAN

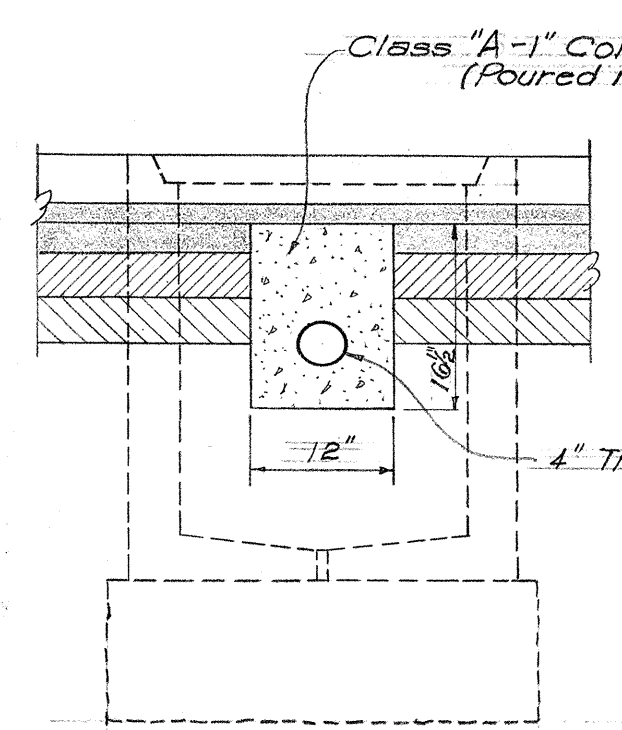


SECTION "B-B"

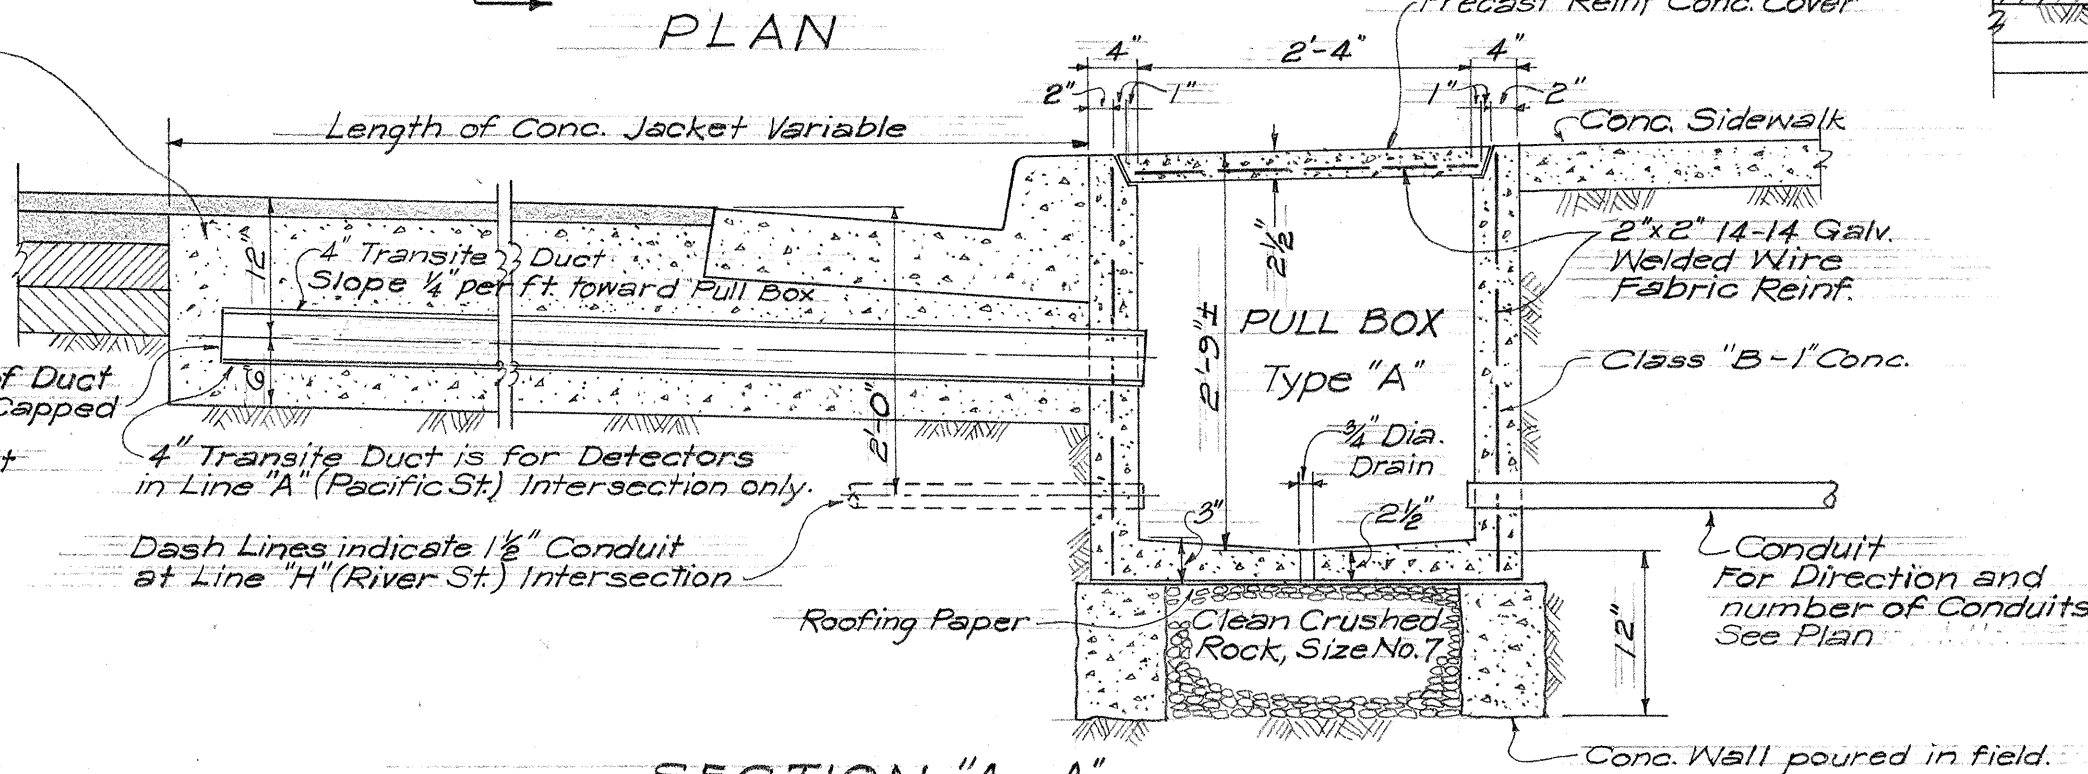

SECTION "A-A"

DETAIL SHOWING TRANSITE DUCT & PULL BOX-TYPE "A"
Scale: $\frac{3}{4}$ " = 1'-0"

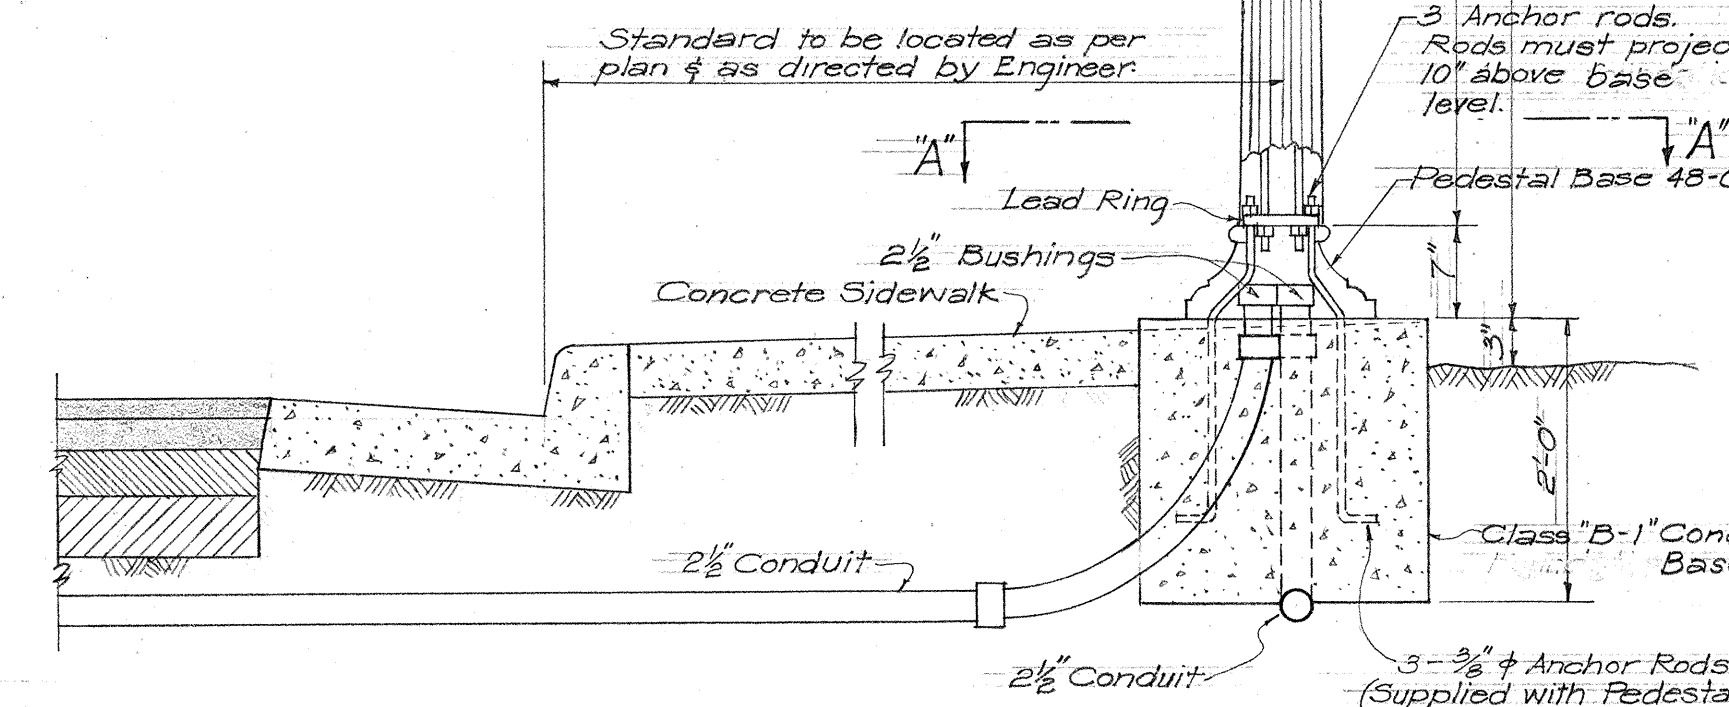

TERRITORIAL HIGHWAY DEPARTMENT
TERRITORY OF HAWAII
DETAILS FOR
TRAFFIC SIGNAL SYSTEM
HONOLULU-PEARL HARBOR ROAD
IWILEI SECTION
PROJECT No. FU 44(3) 2ND UNIT
Scale: As Noted Date: July 1950

SHEET No. 3 OF 3 SHEETS

5484.36