


FED. ROAD DIST. NO.	STATE	FED. AID PROJ. NO.	FISCAL YEAR	SHEET NO.	TOTAL SHEETS
HAWAII	HAW	U44(6)	1951	13	44

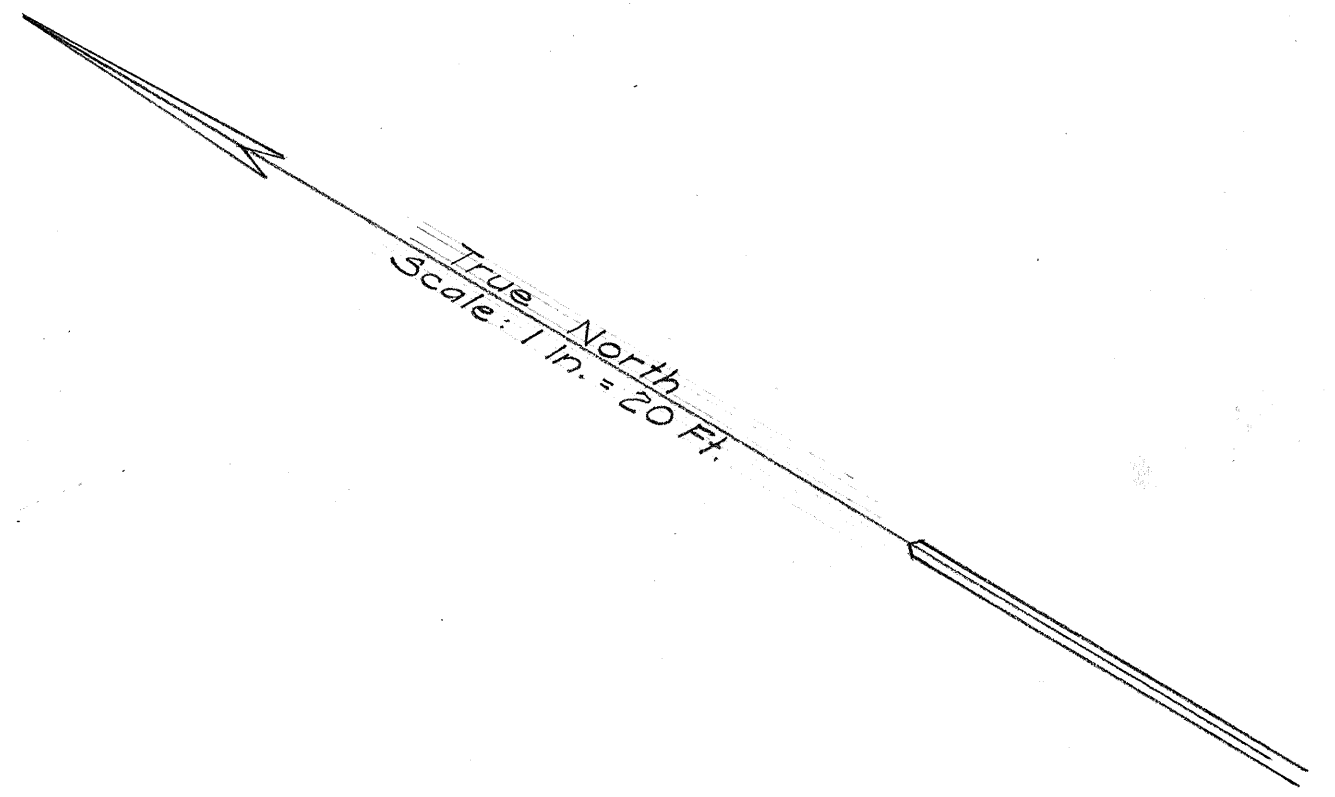

FORT STREET

BISHOP STREET

ALA MOANA ROAD

NOTE:

All curbs within Irwin Park area shall be Lava Rock Curb unless otherwise specified. All new gutters shall be Type "F" Concrete Gutter. For Typical Section see Sheet No. 5505.4

Capacity of Existing Parking Area = 173 Cars.
 Parking Stalls to be removed due to road widening = 77
 Total capacity of new parking lot = 182 Cars.

REVISED 2/5/52

TERRITORIAL HIGHWAY DEPARTMENT

TERRITORY OF HAWAII

ALTERATIONS TO

IRWIN MEMORIAL PARK

PARKING LOT

HONOLULU-PEARL HARBOR ROAD

HALEKAUWILA-ALA MOANA SECTION

PROJECT NO. U 44(6)

Scale: 1 in. = 20 Ft.

Aug. 1950

5505.13