



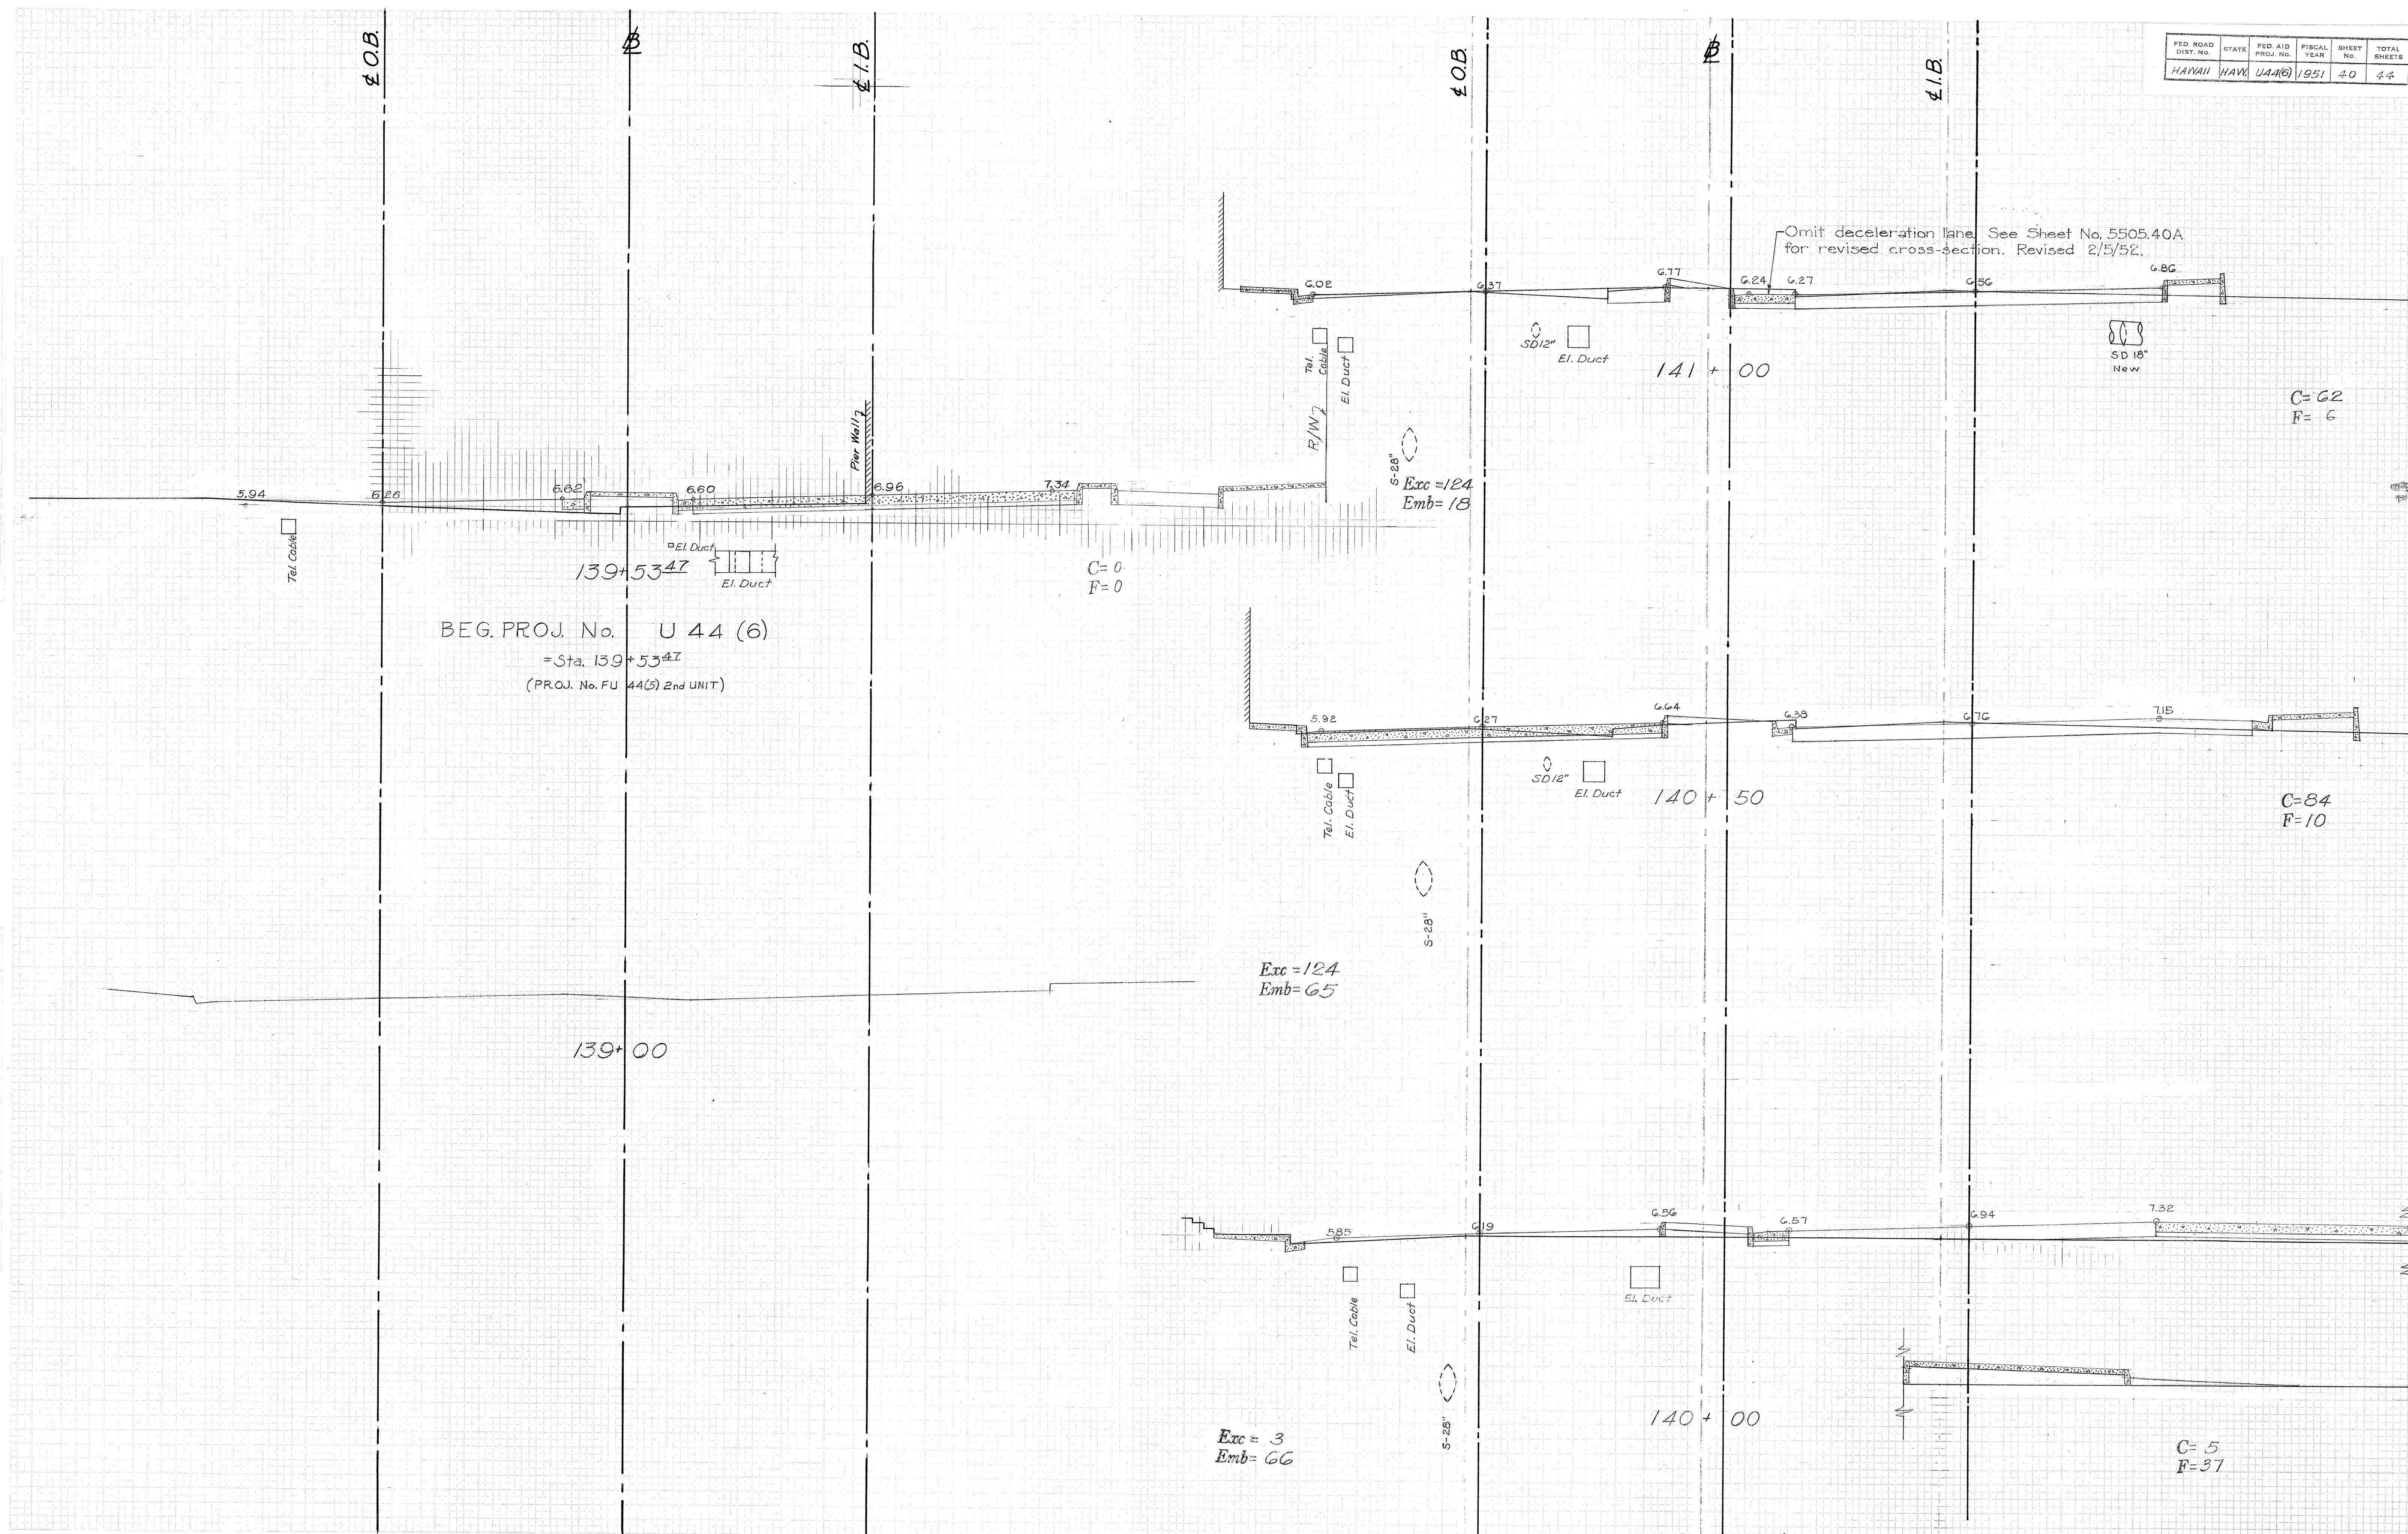

5505.40

Full Date

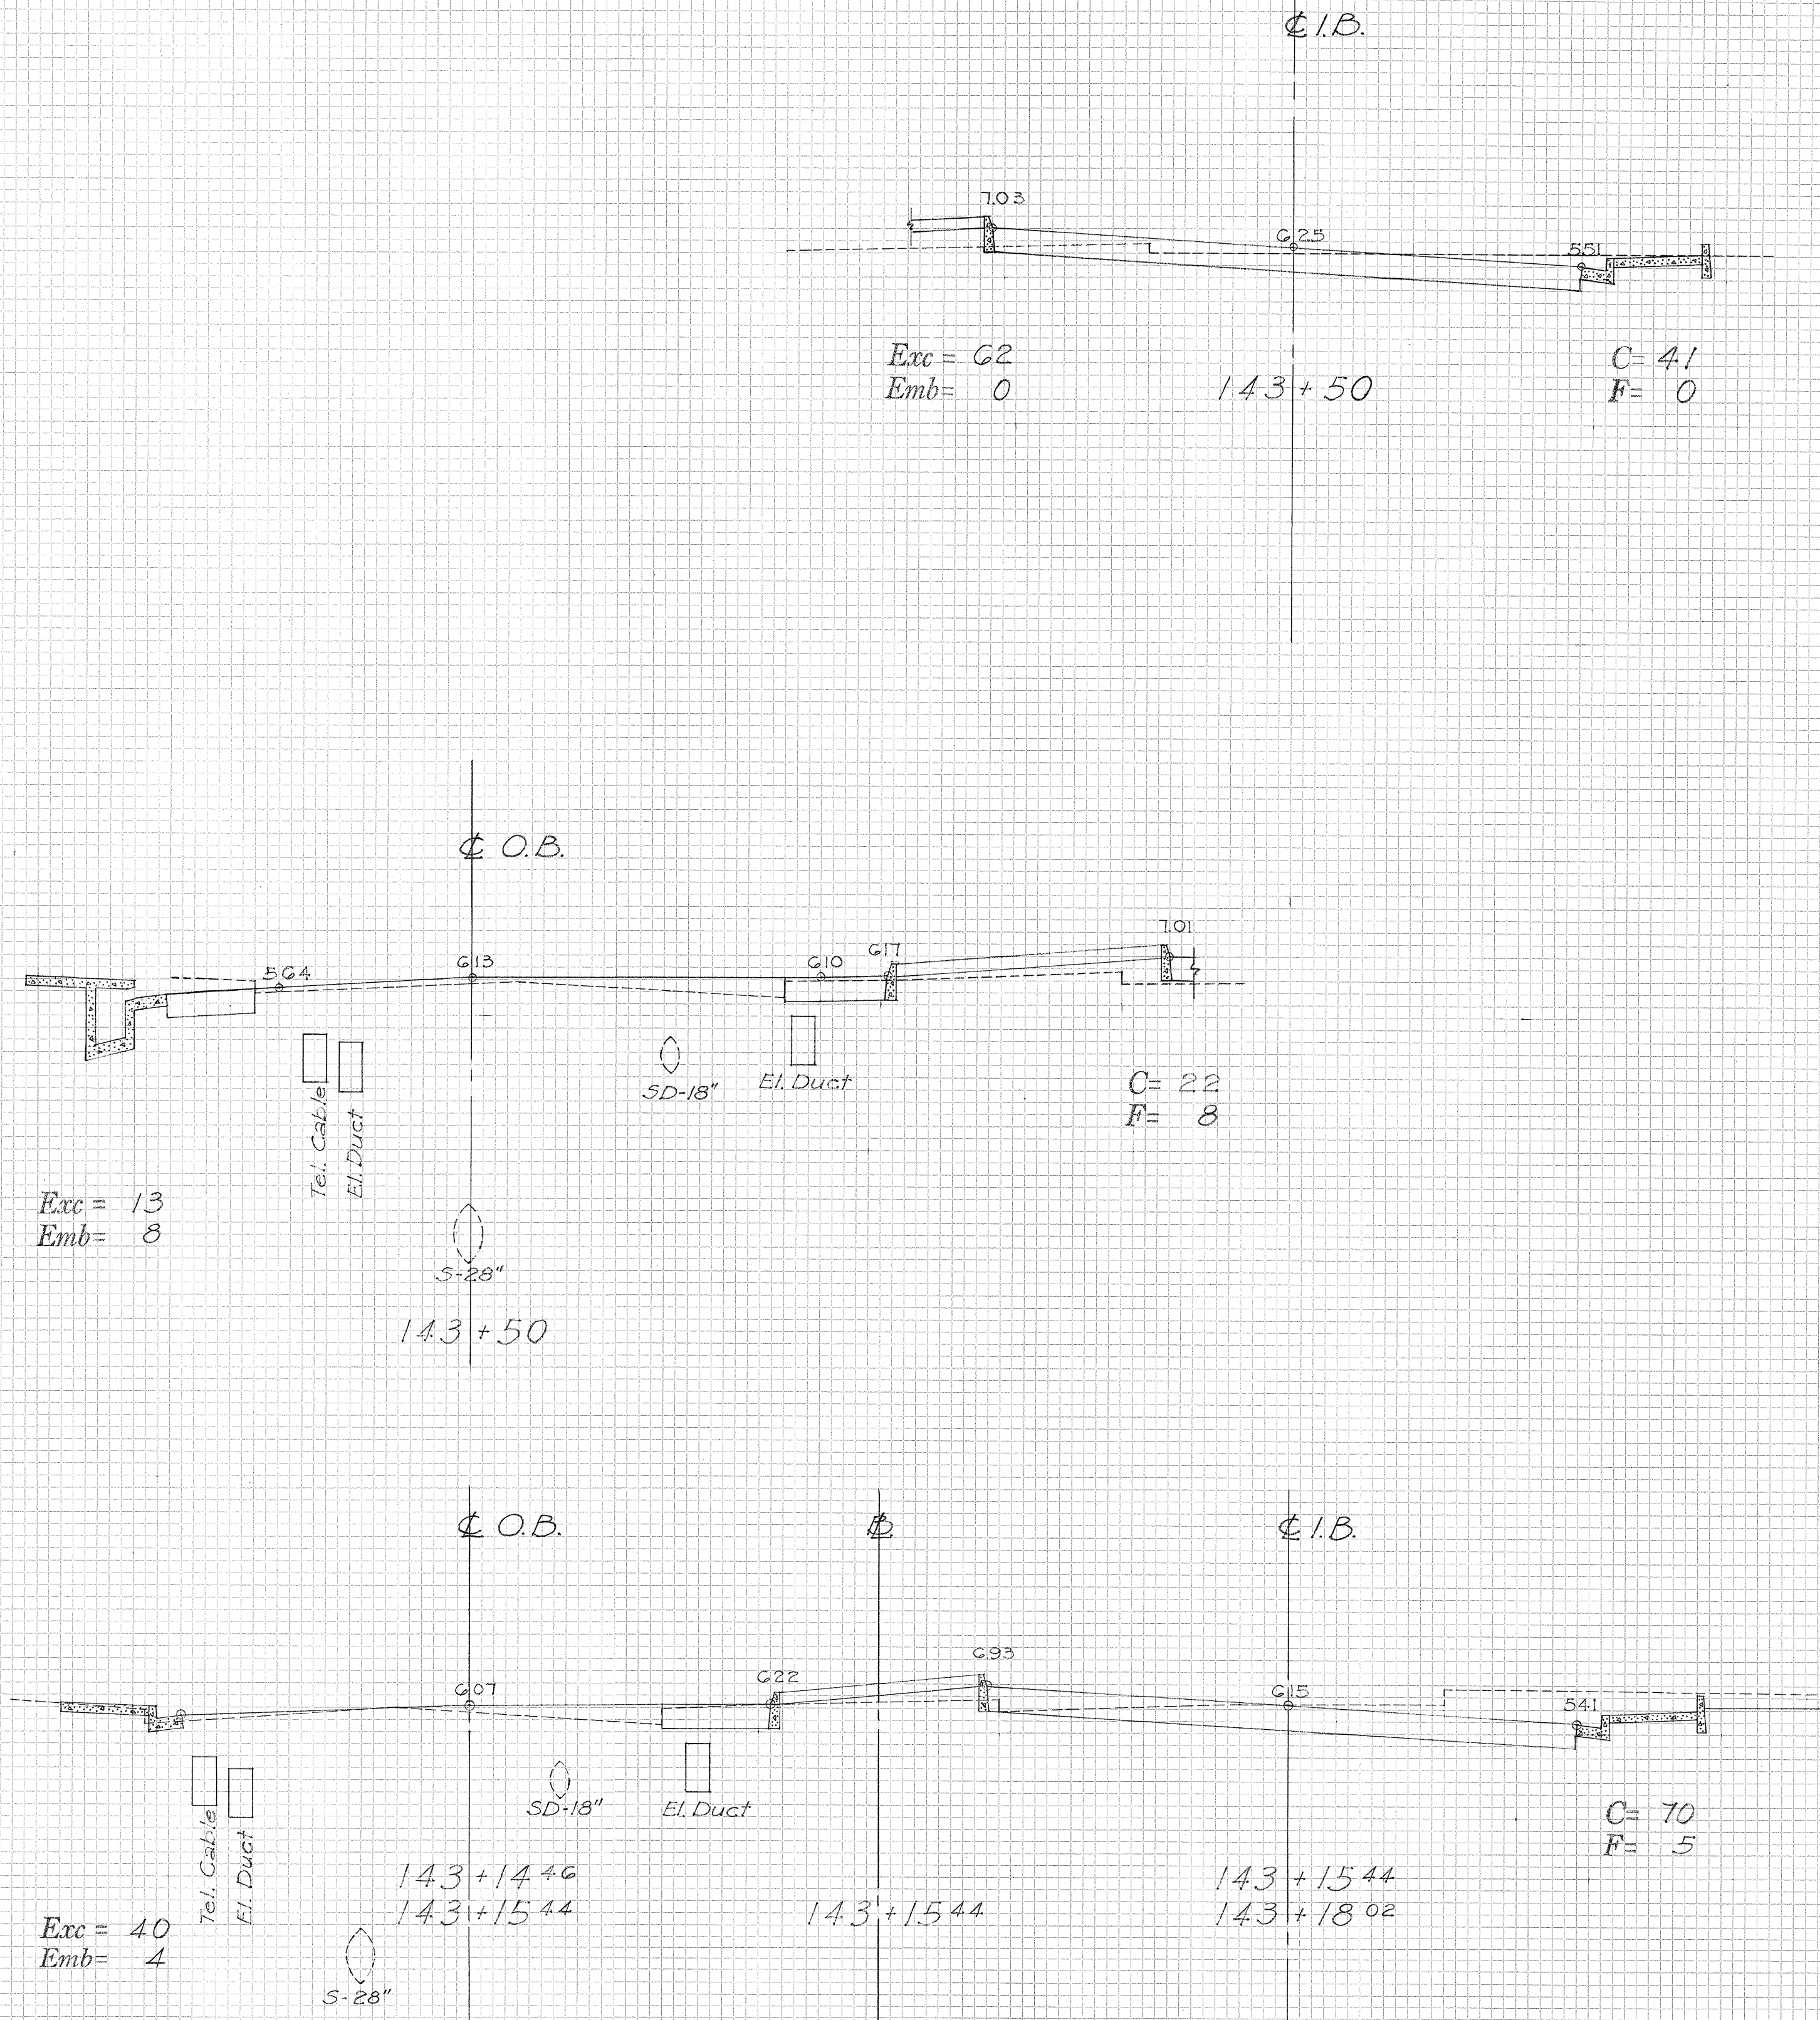


5505.40 A

DATE	BY	REVISION	DATE	BY	REVISION

DATE	BY	REVISION	DATE	BY	REVISION

FED. ROAD DIST. NO.	STATE	FED. AID PROJ. NO.	FISCAL YEAR	SHEET NO.	TOTAL SHEETS
HAWAII	HAW.	U44(6)	1951	4-1	4-4


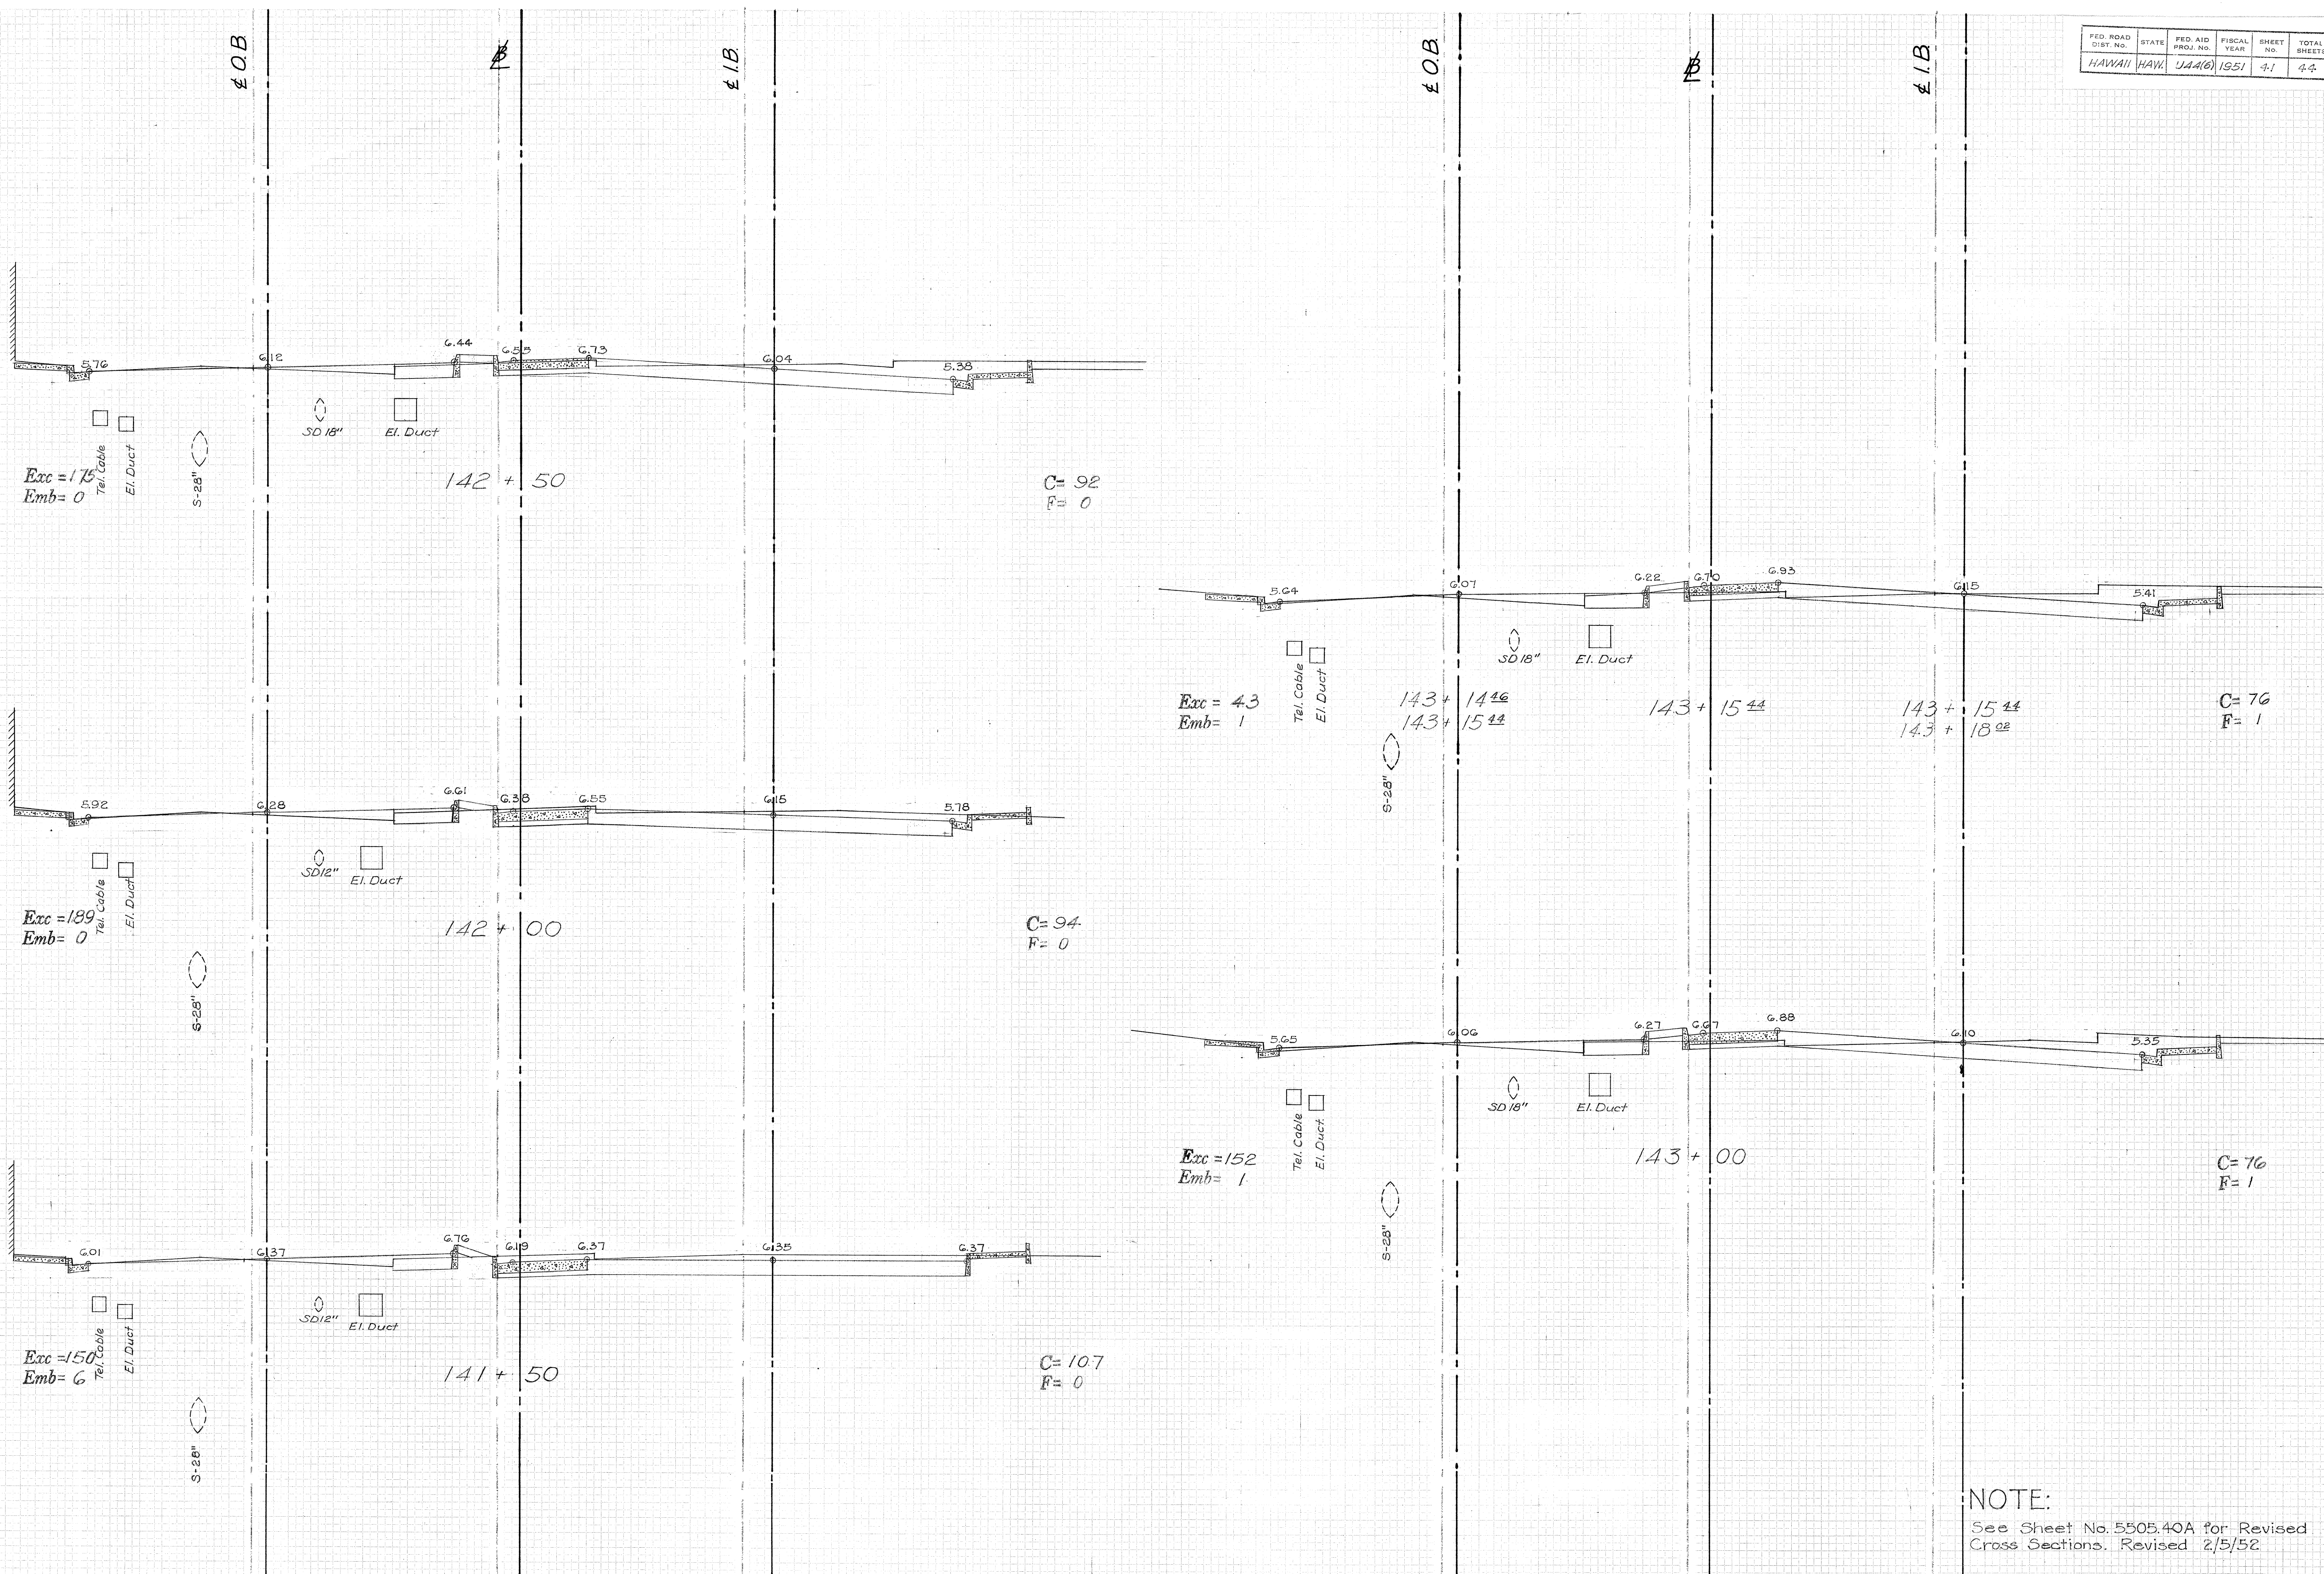


NOTE:
See Sheet No. 5505.40A for Revised
Cross Sections. Revised 2/5/52

5505.41

5505.42

FED. ROAD DIST. No.	STATE	FED. AID PROJ. No.	FISCAL YEAR	SHEET No.	TOTAL SHEETS
HAWAII	HAW.	U44(6)	1951	43	44

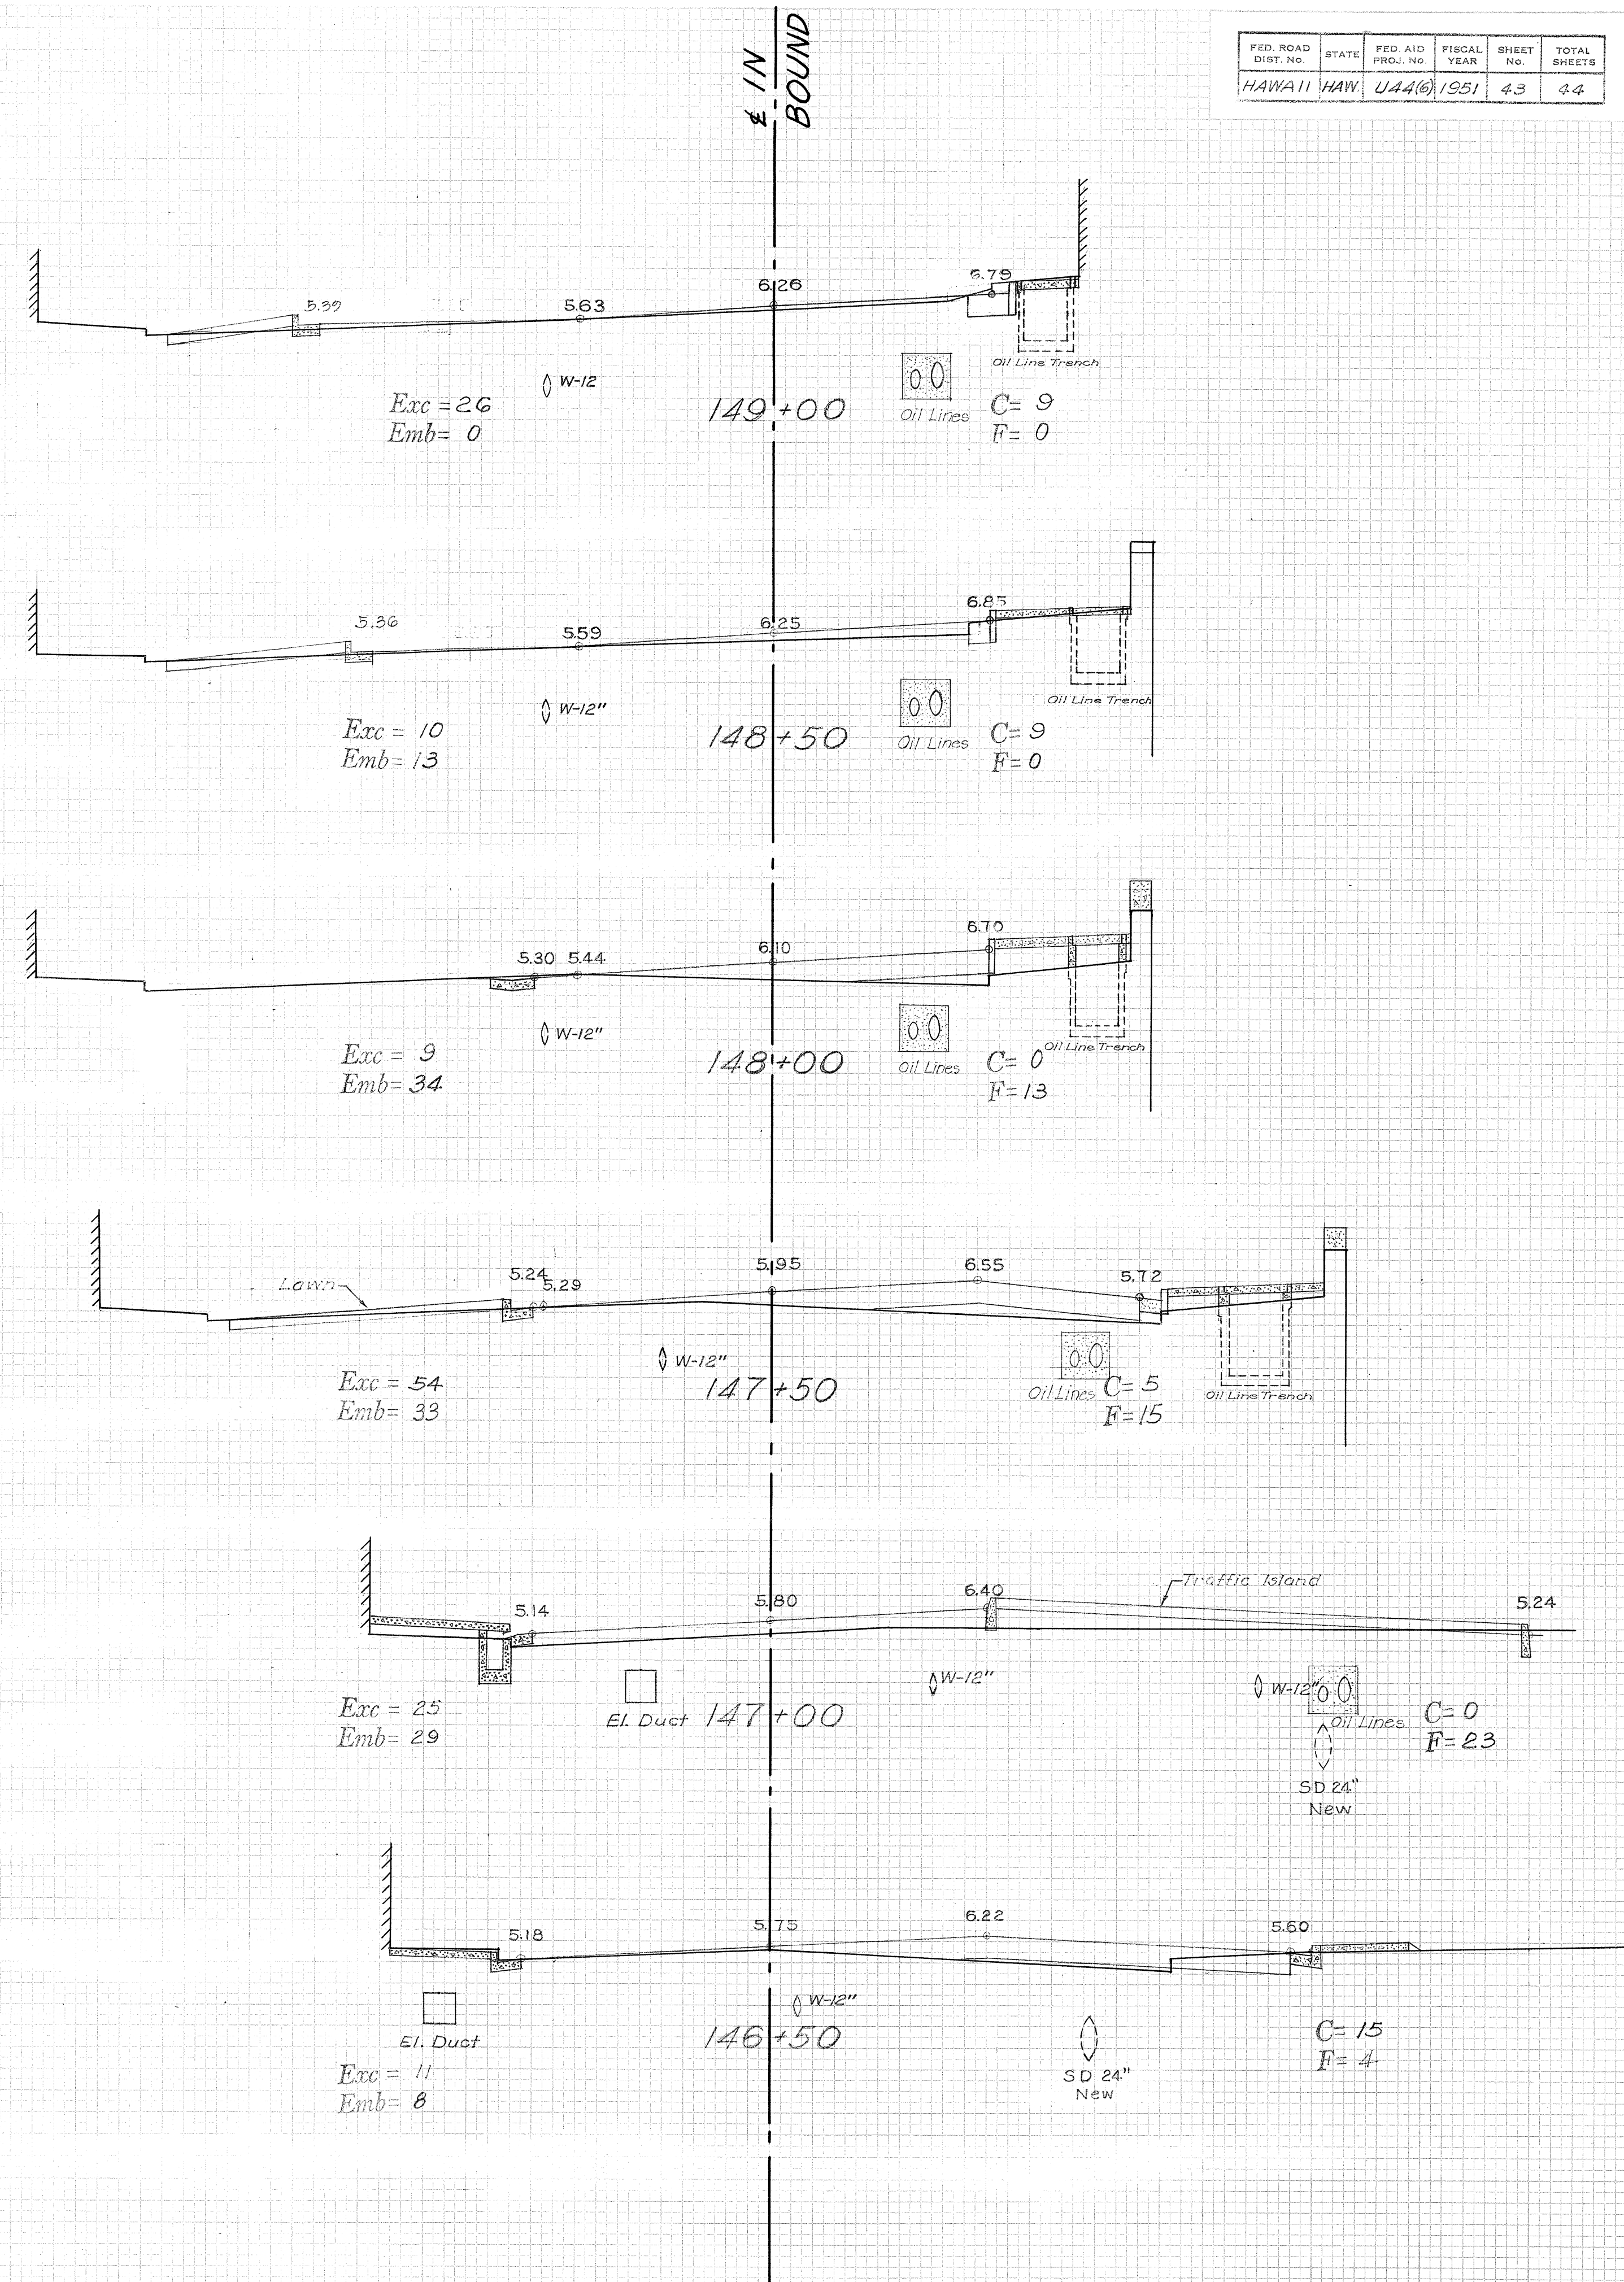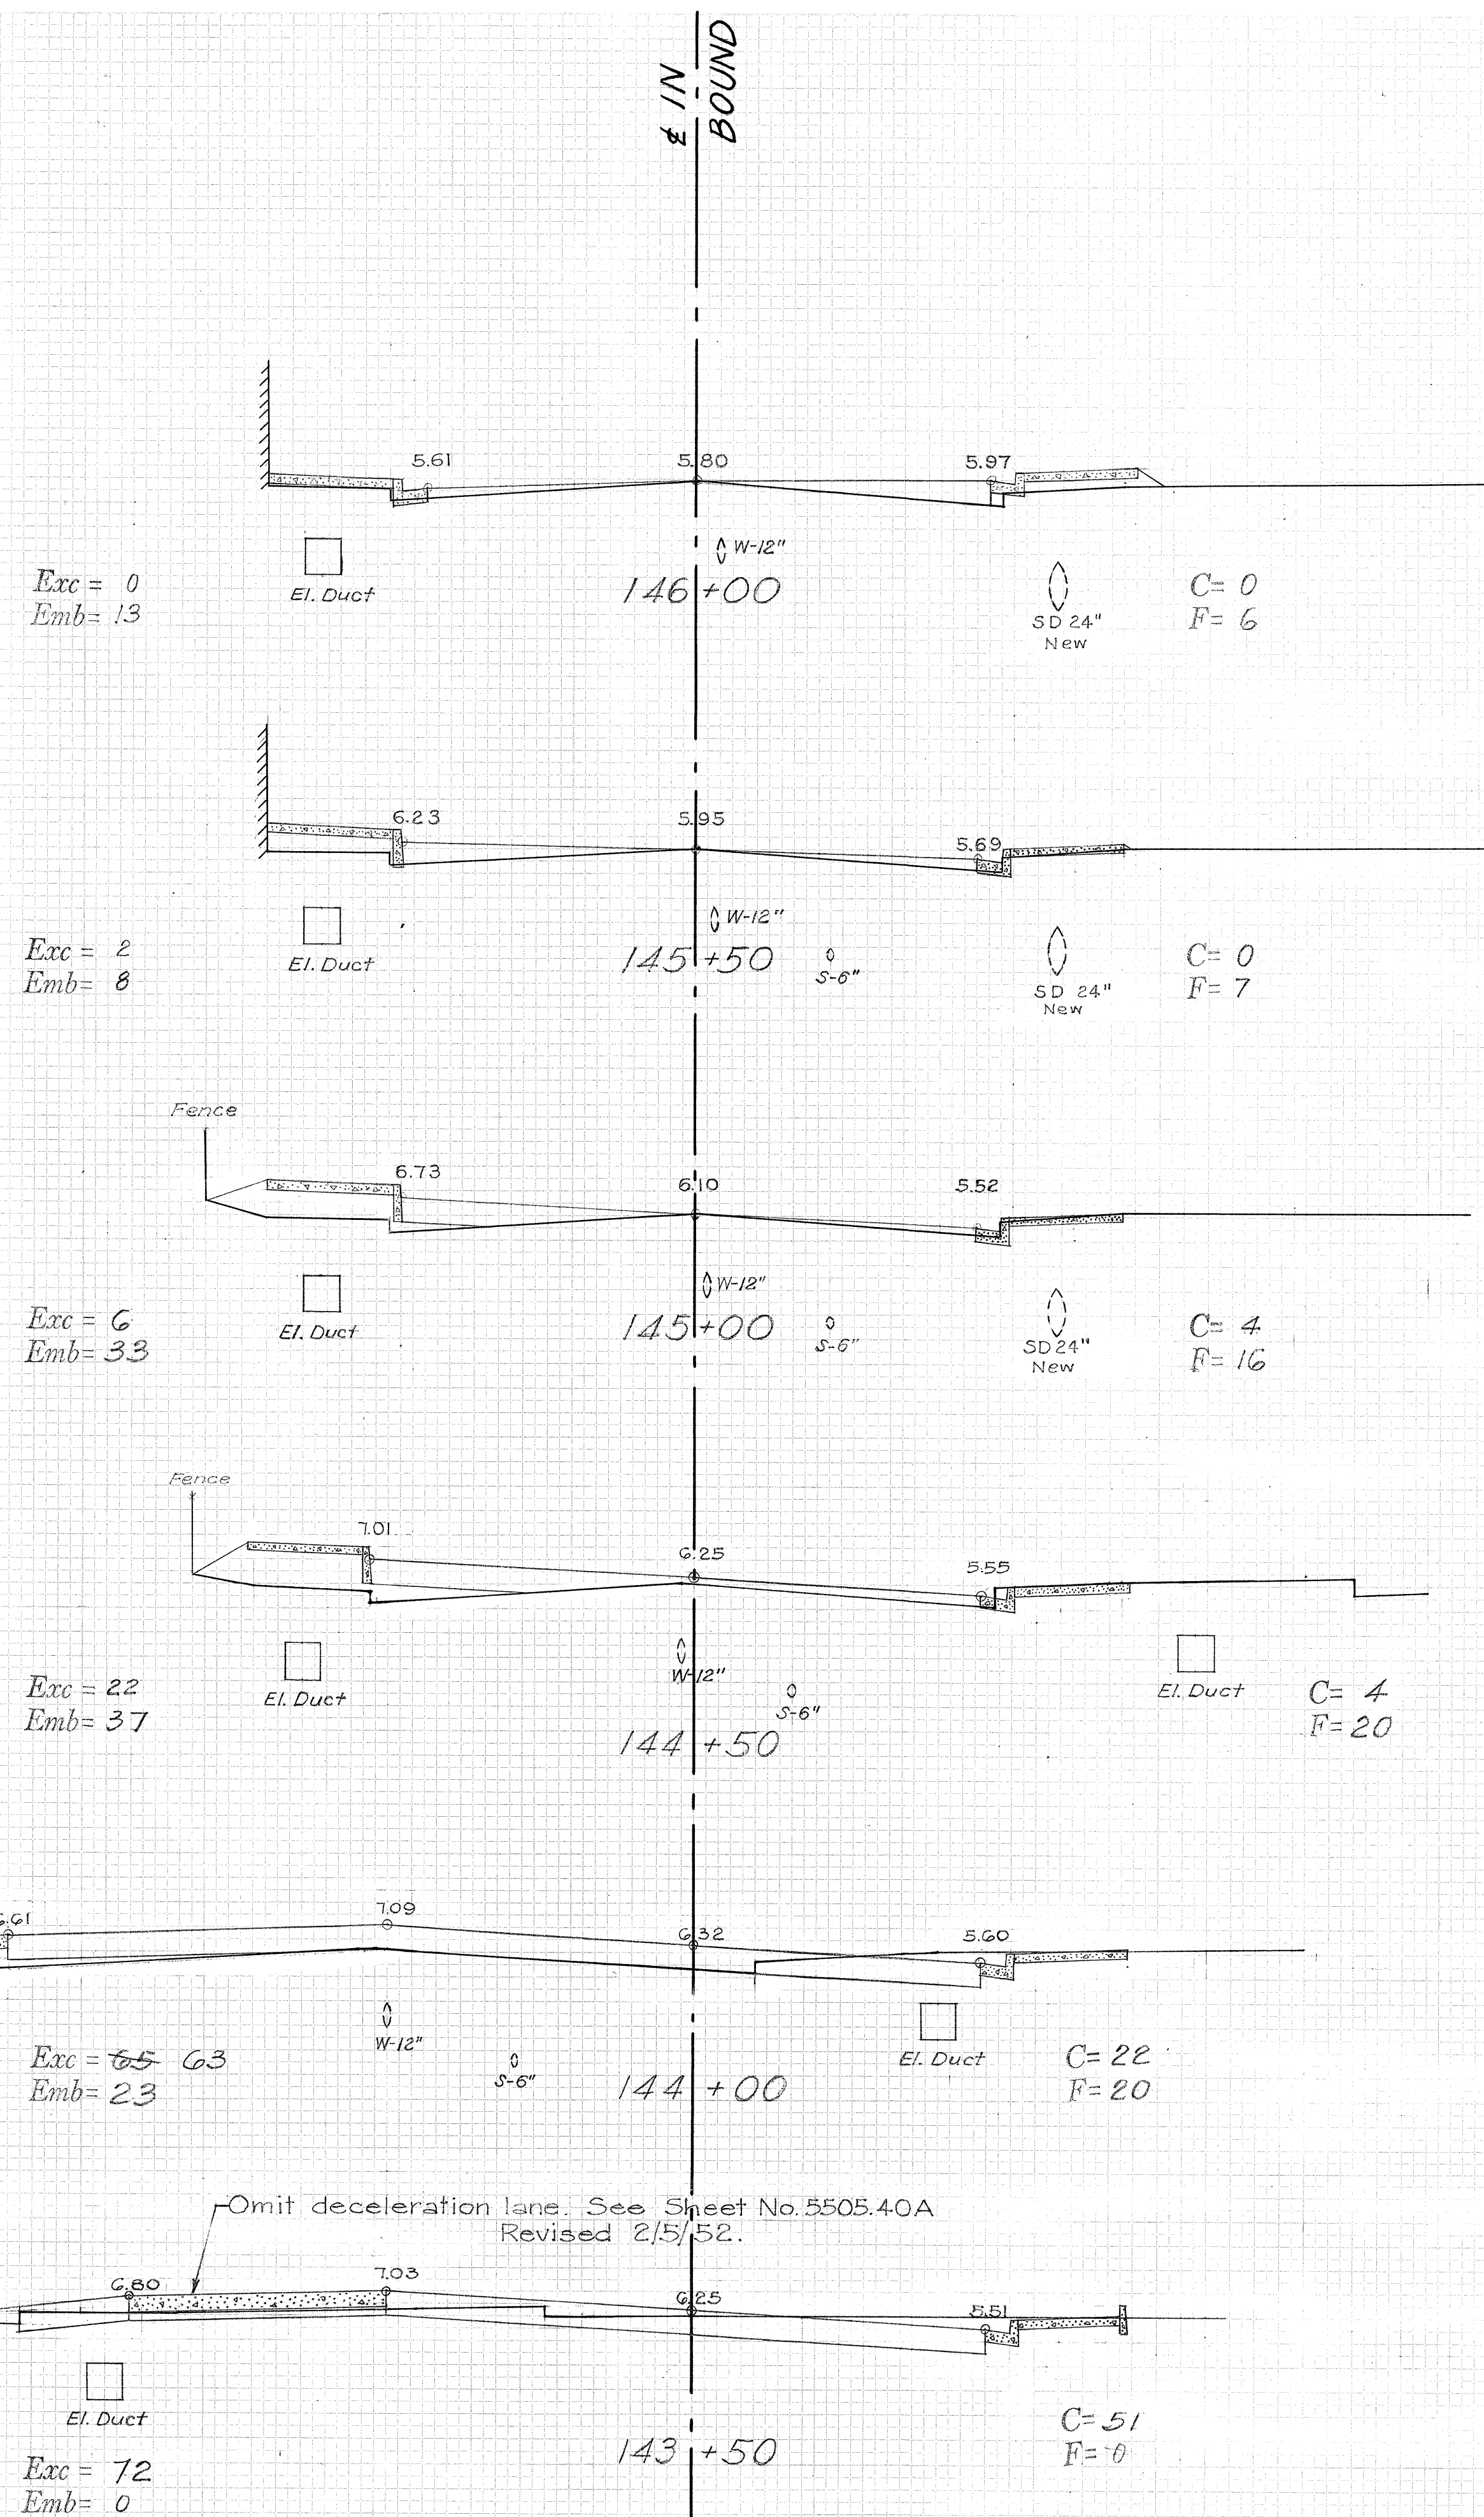

5505.43

FU 44 (6)

FED. ROAD DIST. NO.	STATE	FED. AID PROJ. NO.	FISCAL YEAR	SHEET NO.	TOTAL SHEETS
HAWAII	HAW	U446	1951	44	44

DATE
BY
CHECKED
REVISIONS
NO.

DATE
BY
CHECKED
REVISIONS
NO.

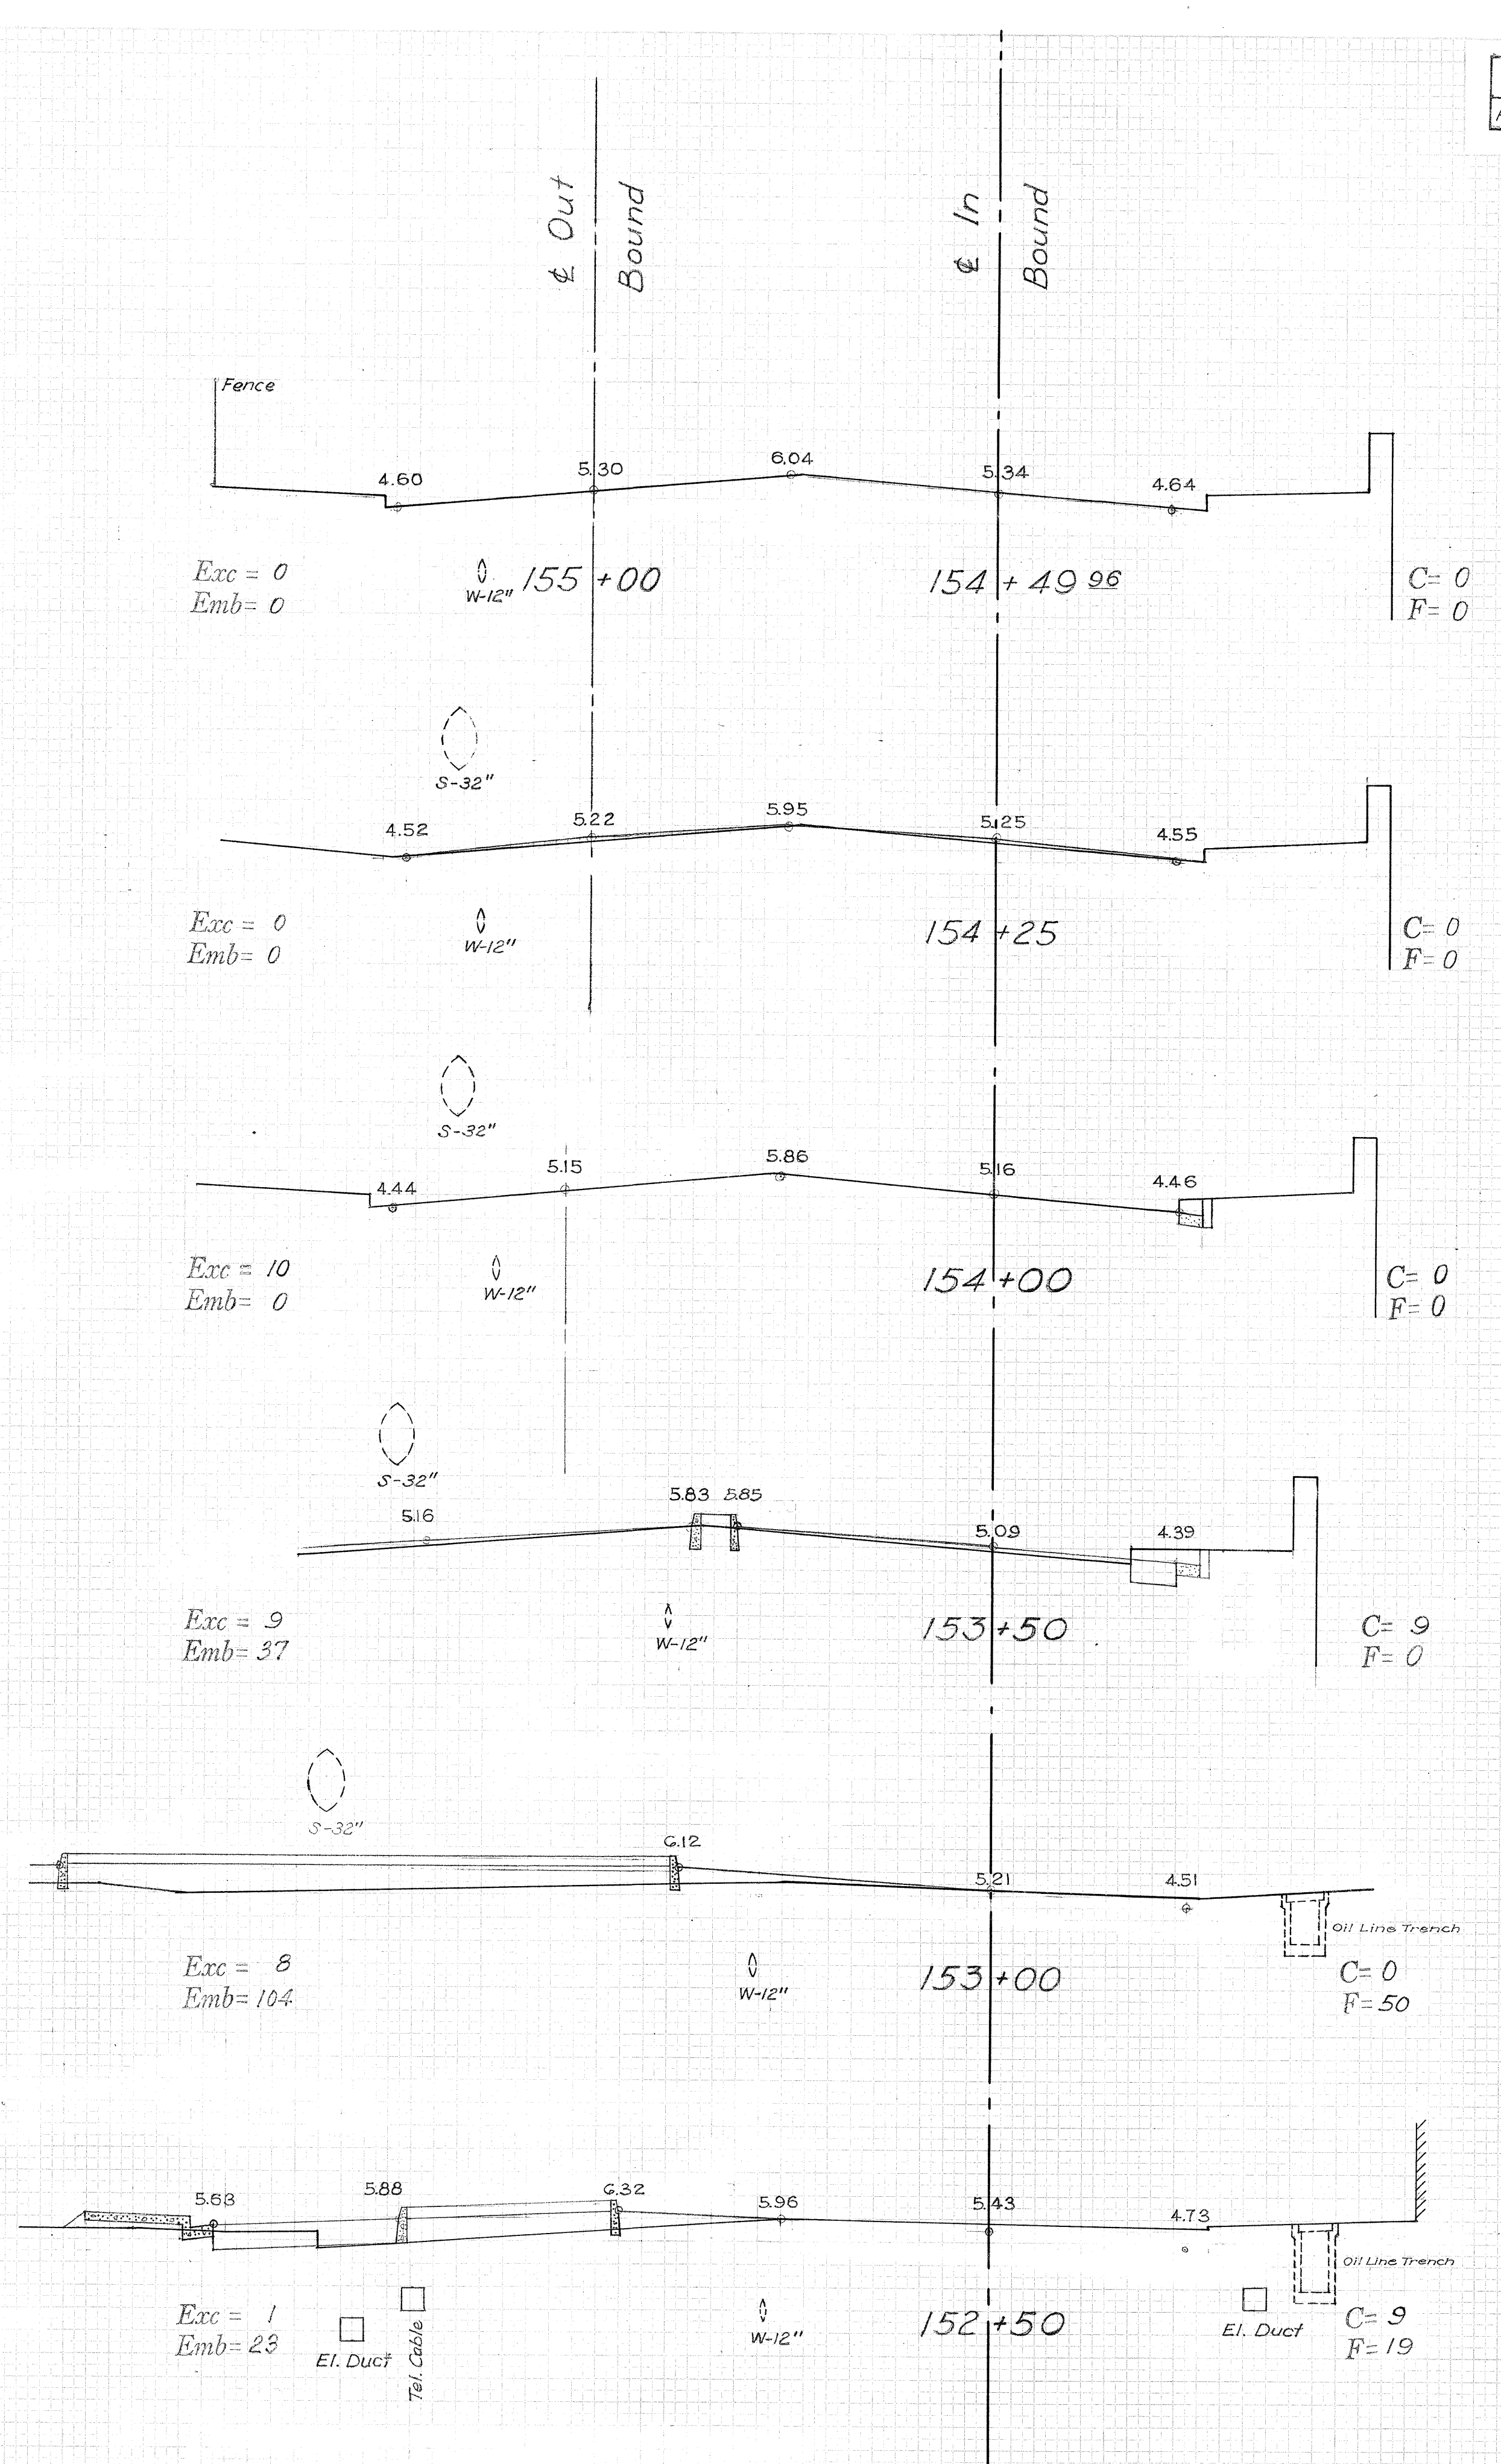
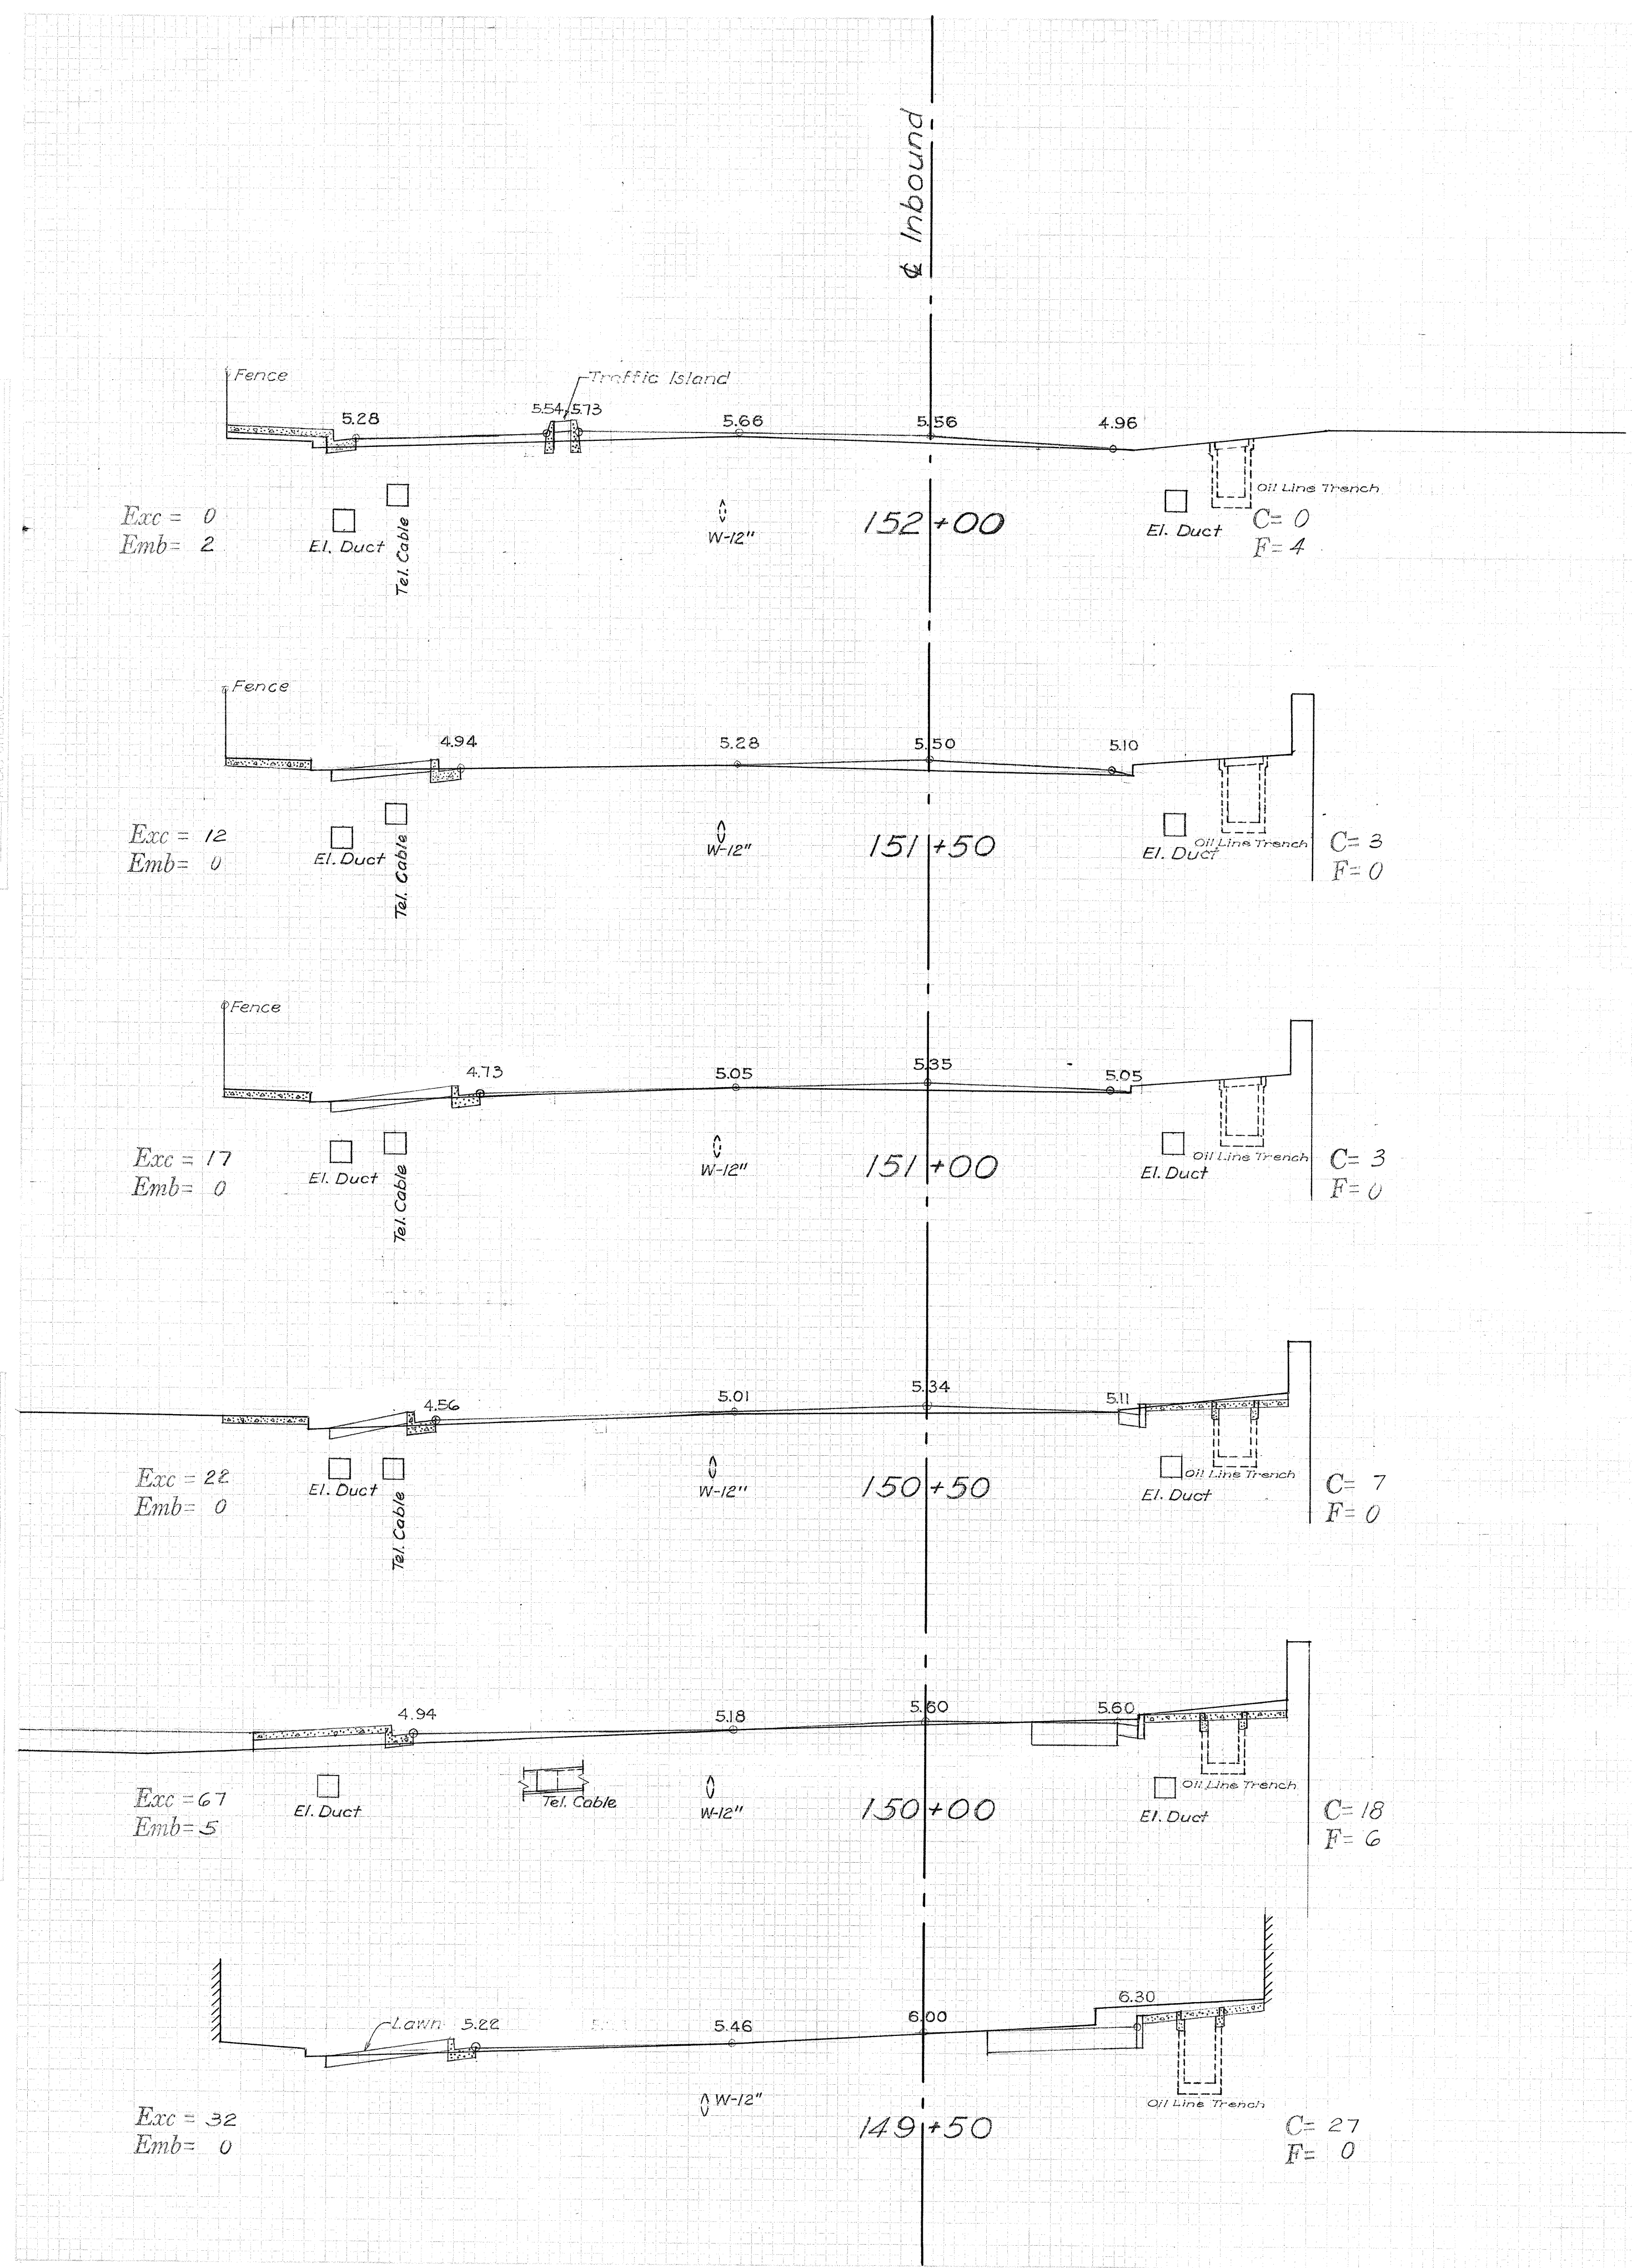


PLATE 3-CROSS SECTION OF L.A.E. STANDARD
NEUTREL & EIDER CO., NEW YORK
S. N. 2 CO. INC. 249-3

5505.44