

HALEKAUWILA STREET

FORT STREET

BISHOP STREET

NOTE:
See Sheet No. 5505.30A for Revised Landscape Plan and Sprinkler System at Median Strip. Revised 2/5/52

SPRINKLER SYSTEM

AQS - 3/4" Quarter Circle Shrubbery Type Sprinkler Head, Adjustable, Brass
AHS - 3/4" Half
Q - 1/2" Quarter Circle Lawn Type Sprinkler Head, Adjustable, Brass
H - 1/2" Half
F - 1/2" Full
ST - 1/2" Rectangular
AQ - 3/4" Quarter Circle
AH - 3/4" Half

Sprinkler Heads to remain
" " " " be removed
" " " " installed
Pipes to be removed
New pipes, or existing pipes to remain

LANDSCAPE PLAN (Revised 2/5/52)

SYMBOL		QUANTITY
①	Monkey Pods to remain	12
②	" " " be transplanted	14
③	Transplanted Monkey Pods	9
④	Coconuts to be transplanted	22
⑤	Transplanted or new Coconuts	15
⑥	Banyans to remain	5
⑦	Bermuda Grass	14,380 sq. ft.
⑧	Tristella Australasica (Ground Cover)	124

NOTE:
Existing pipes to be relocated shall be exposed and if found in good condition shall be relocated as shown on the plan. If any pipe is found in poor condition, new Galvanized Wrought Iron Pipe of the same size as existing pipe shall be installed in its place at the new location, except that where 3" pipe is to be replaced, the new pipe shall be 2 1/2".

GENERAL NOTES -

Meters and Meter Boxes shall be furnished and installed by the Board of Water Supply, City & County of Honolulu.
All pipes in pavement area shall have 2'0" cover below pavement grade.
Minimum size of new pipes shall be 3/4".
Sprinkler Heads shall be spaced as shown on the plan.

REVISED 2/5/52

THOMPSON & THOMPSON
LANDSCAPE ARCHITECTS
HONOLULU, HAWAII

Drawn by: _____
Date: _____

Checked by: _____
Date: _____

File No. _____

TERRITORIAL HIGHWAY DEPARTMENT

TERRITORY OF HAWAII

LANDSCAPE PLAN

HONOLULU-PEARL HARBOR ROAD

HALEKAUWILA-ALA MOANA SECTION

PROJECT NO. U 44(6)


Scale: 1" = 20'

February 1951







SHEET No. 1 OF 3 SHEETS

5505.30

FED. ROAD DIST. NO.	STATE	FED. AID PROJ. NO.	FISCAL YEAR	SHEET NO.	TOTAL SHEETS
HAWAII	HAW	U44(6)	1951	30A	44

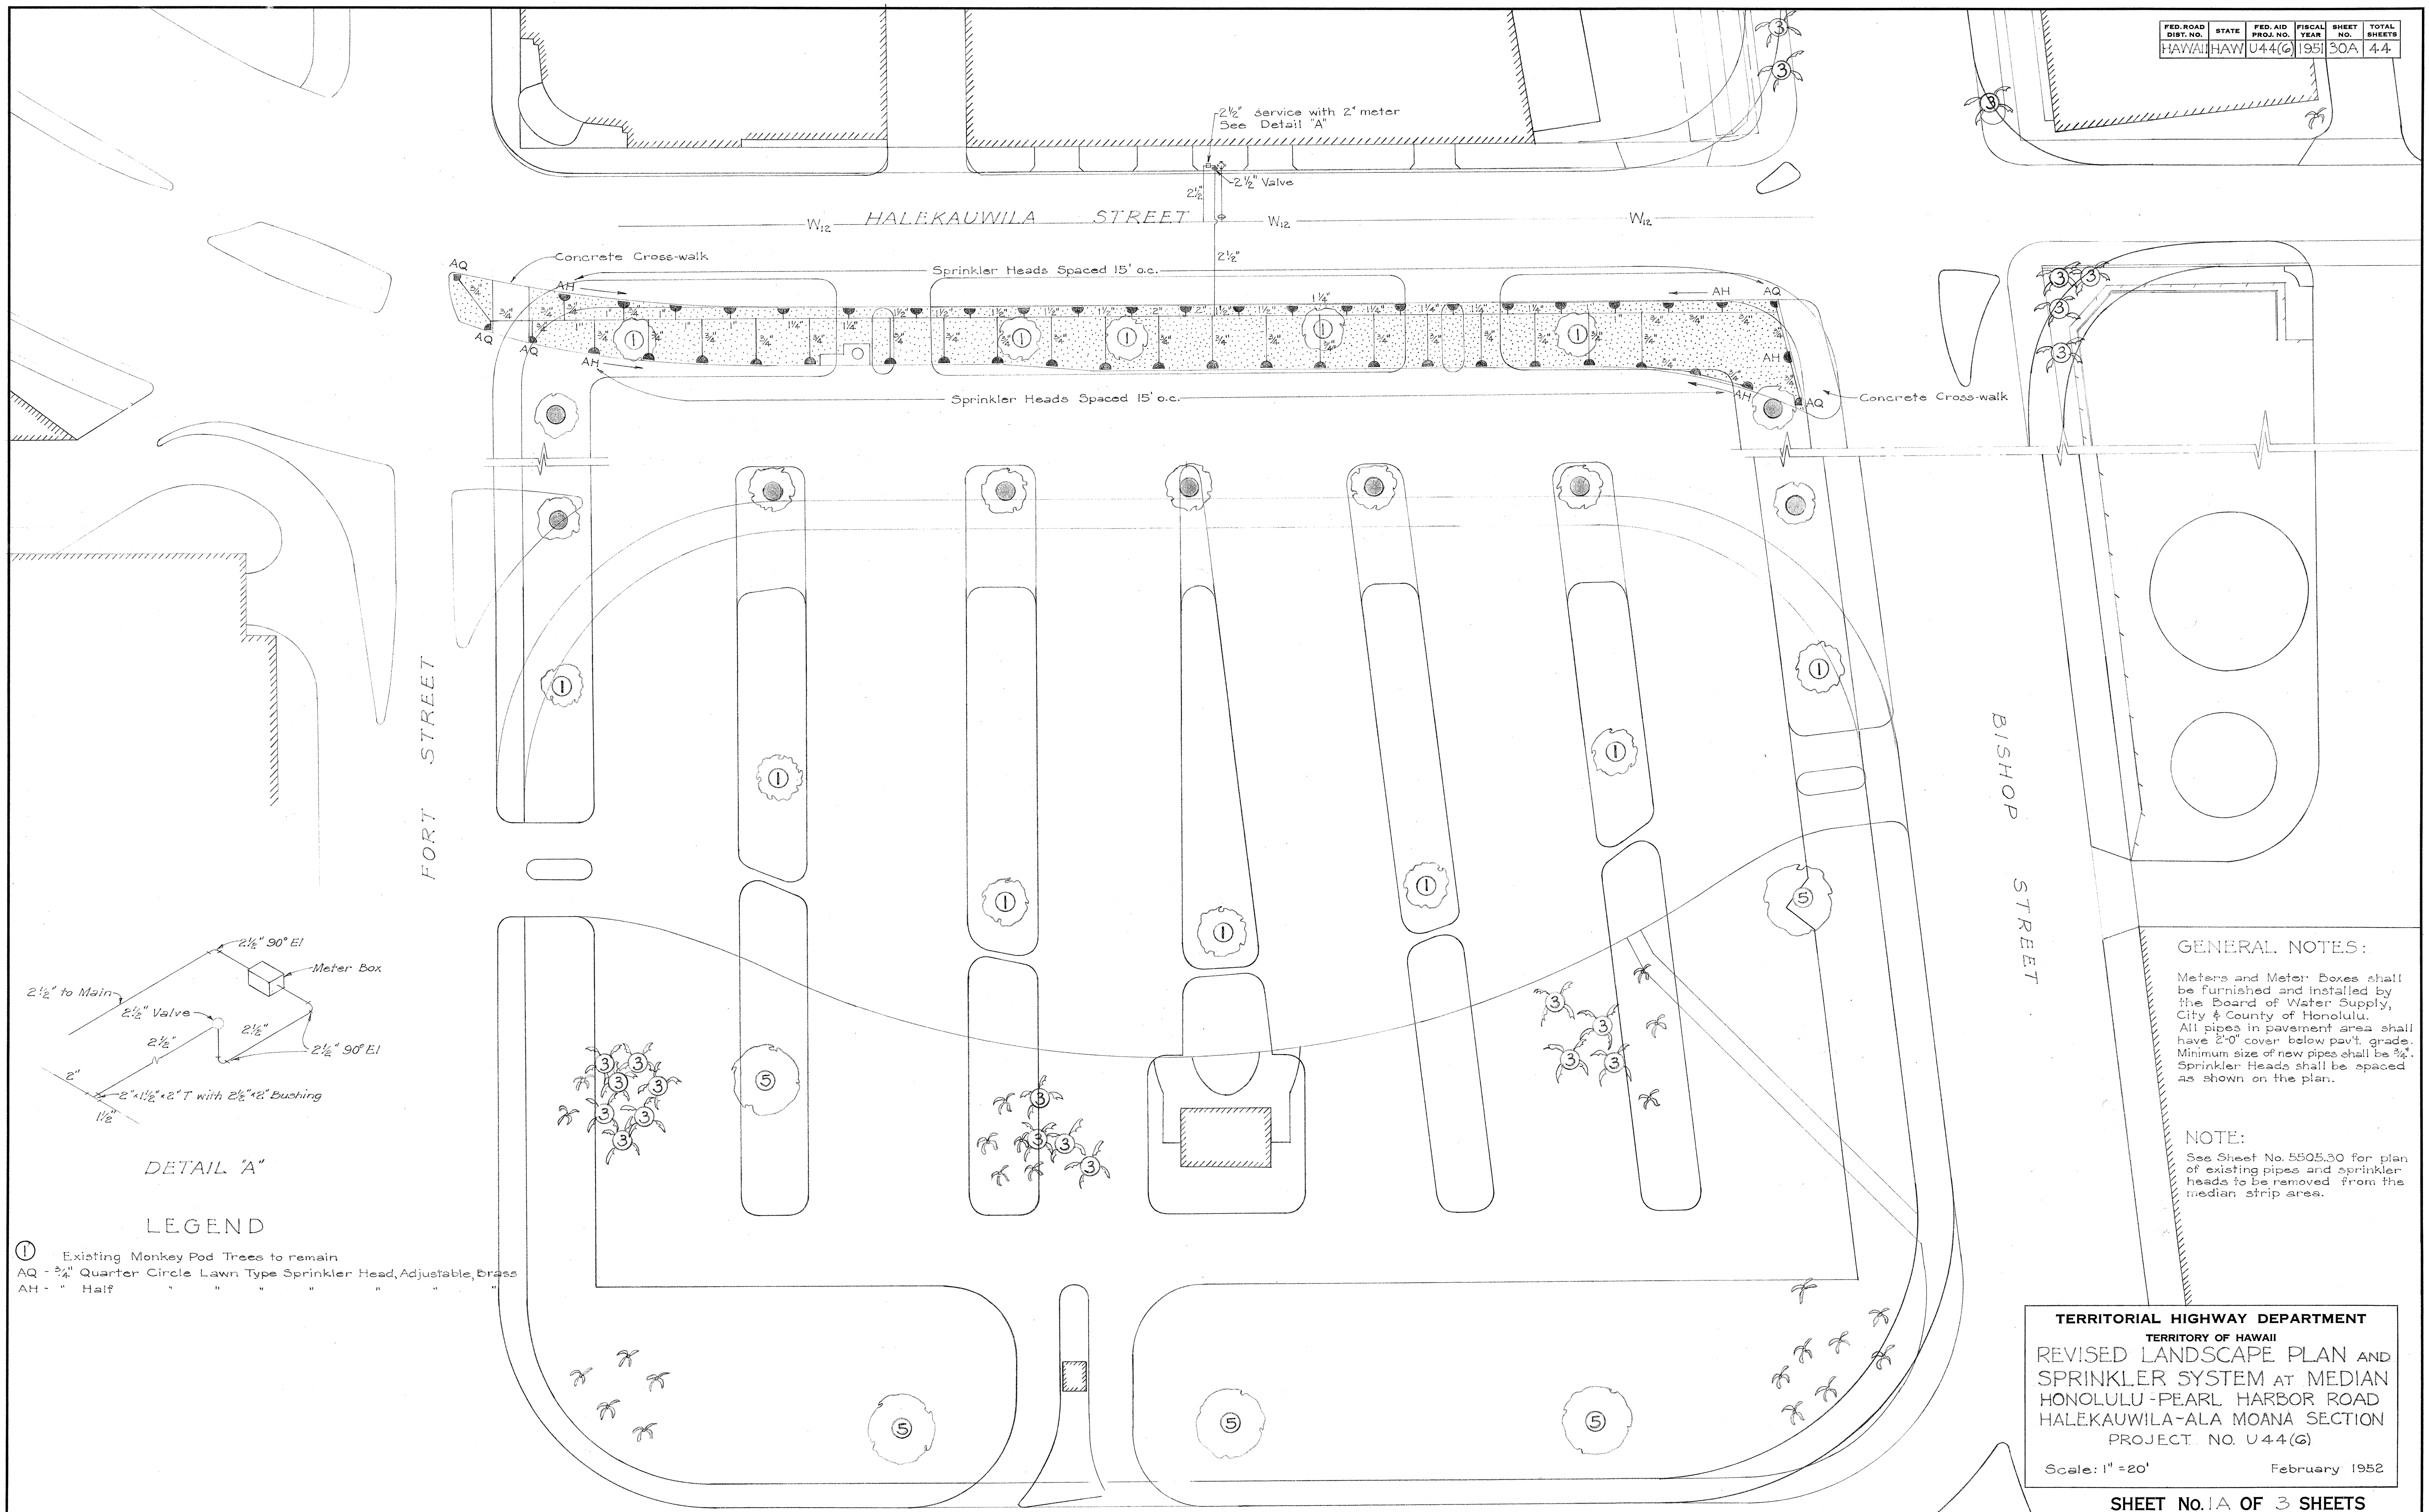

ORIGINAL PLAN	SURVEY PLOTTED BY _____	DATE _____
NOTE BOOK No. _____	DESIGNED BY _____	_____
	DRAWN BY _____	_____
	TRACED BY _____	_____
	QUANTITIES BY _____	_____
	QUANTITIES CHECKED BY _____	_____
	CHECKED BY _____	_____

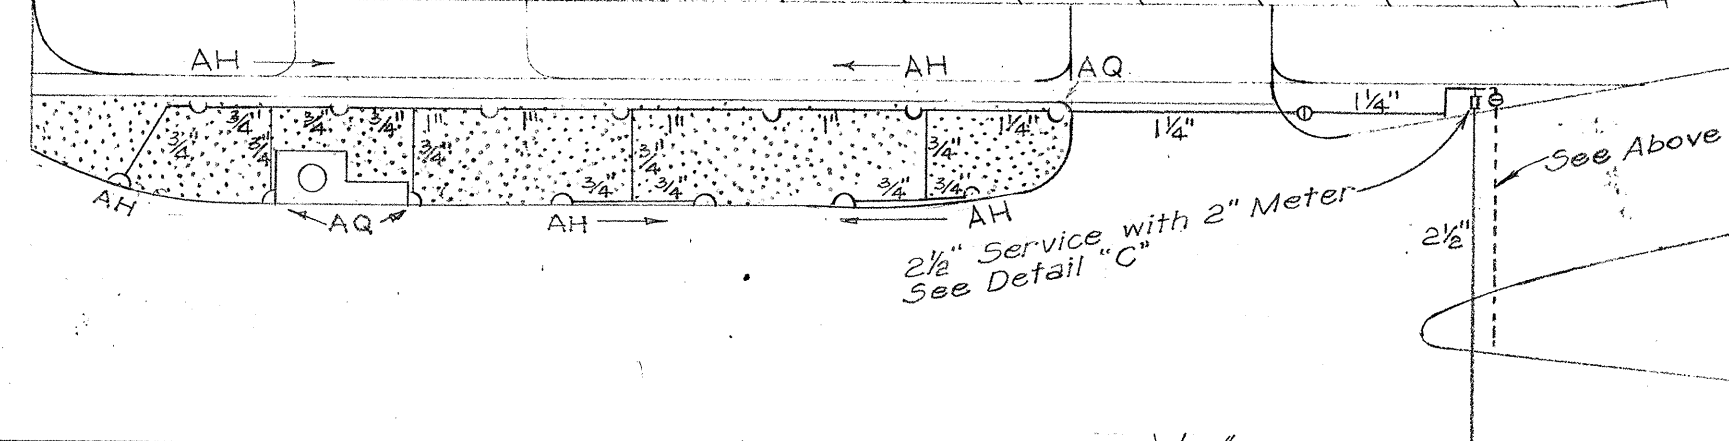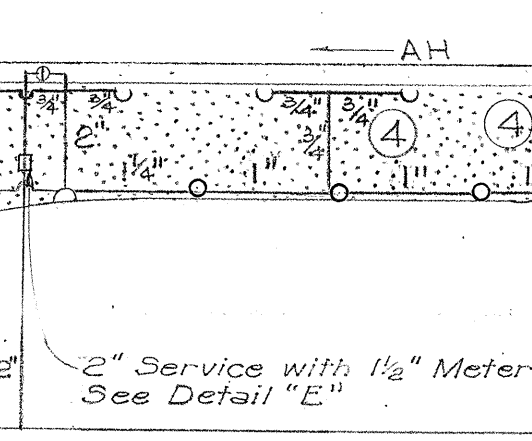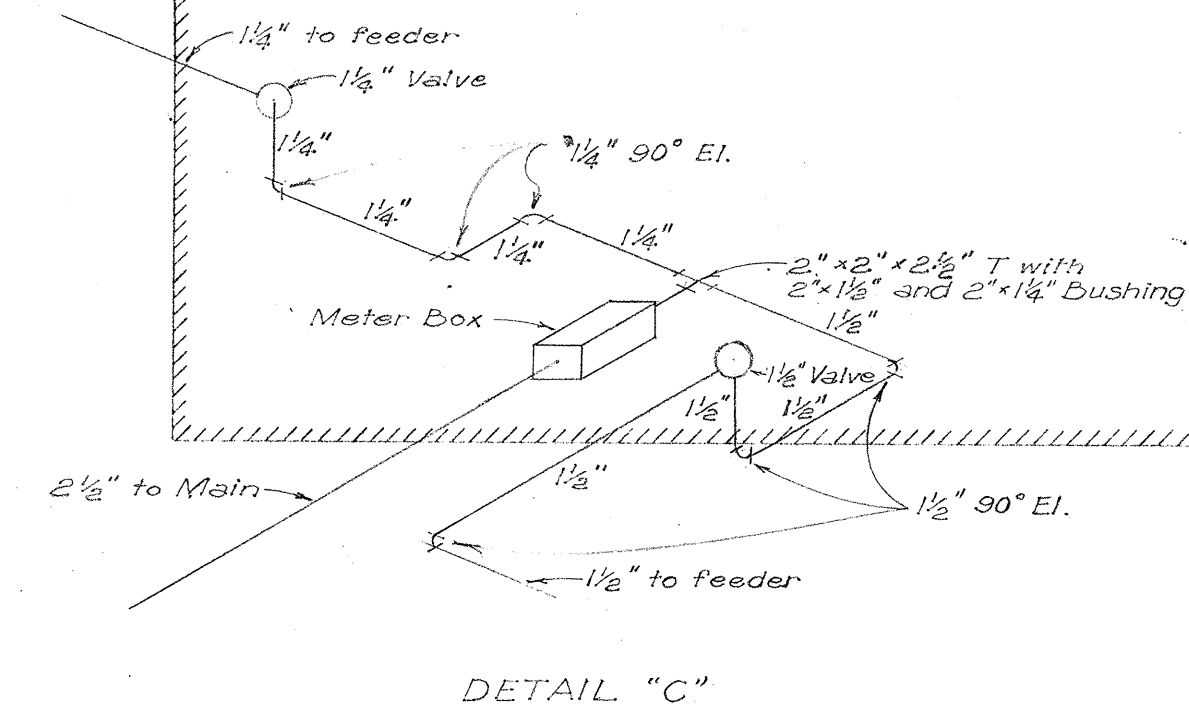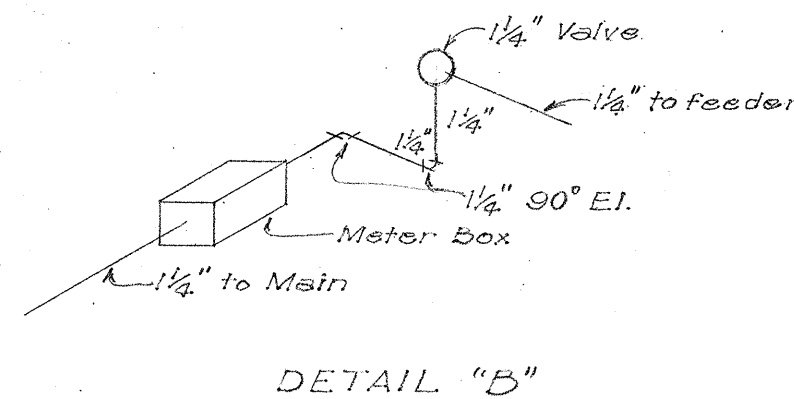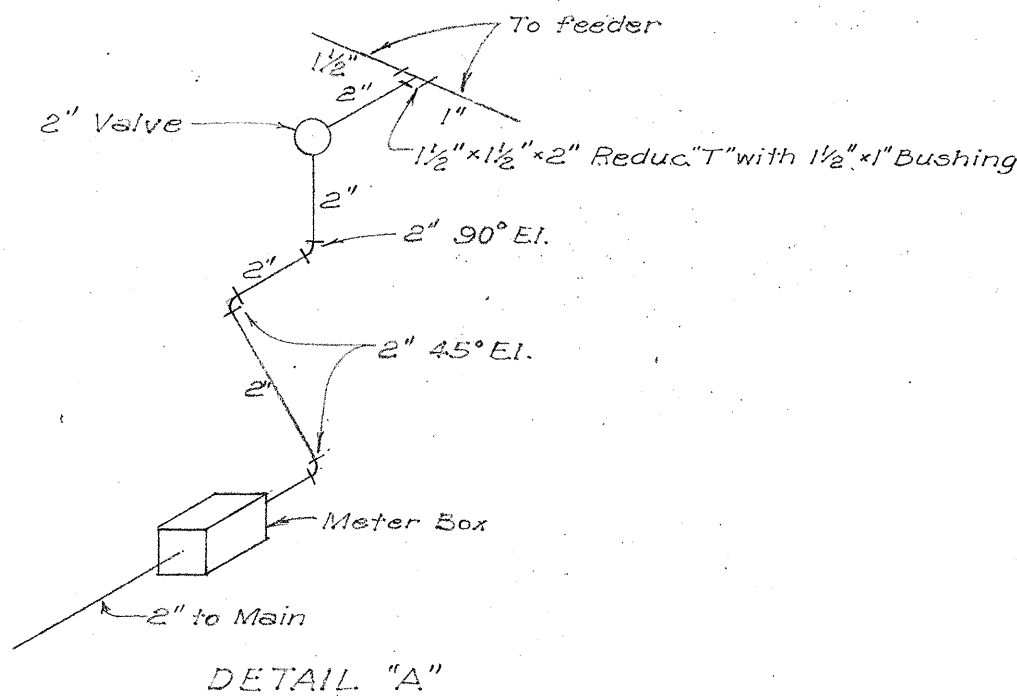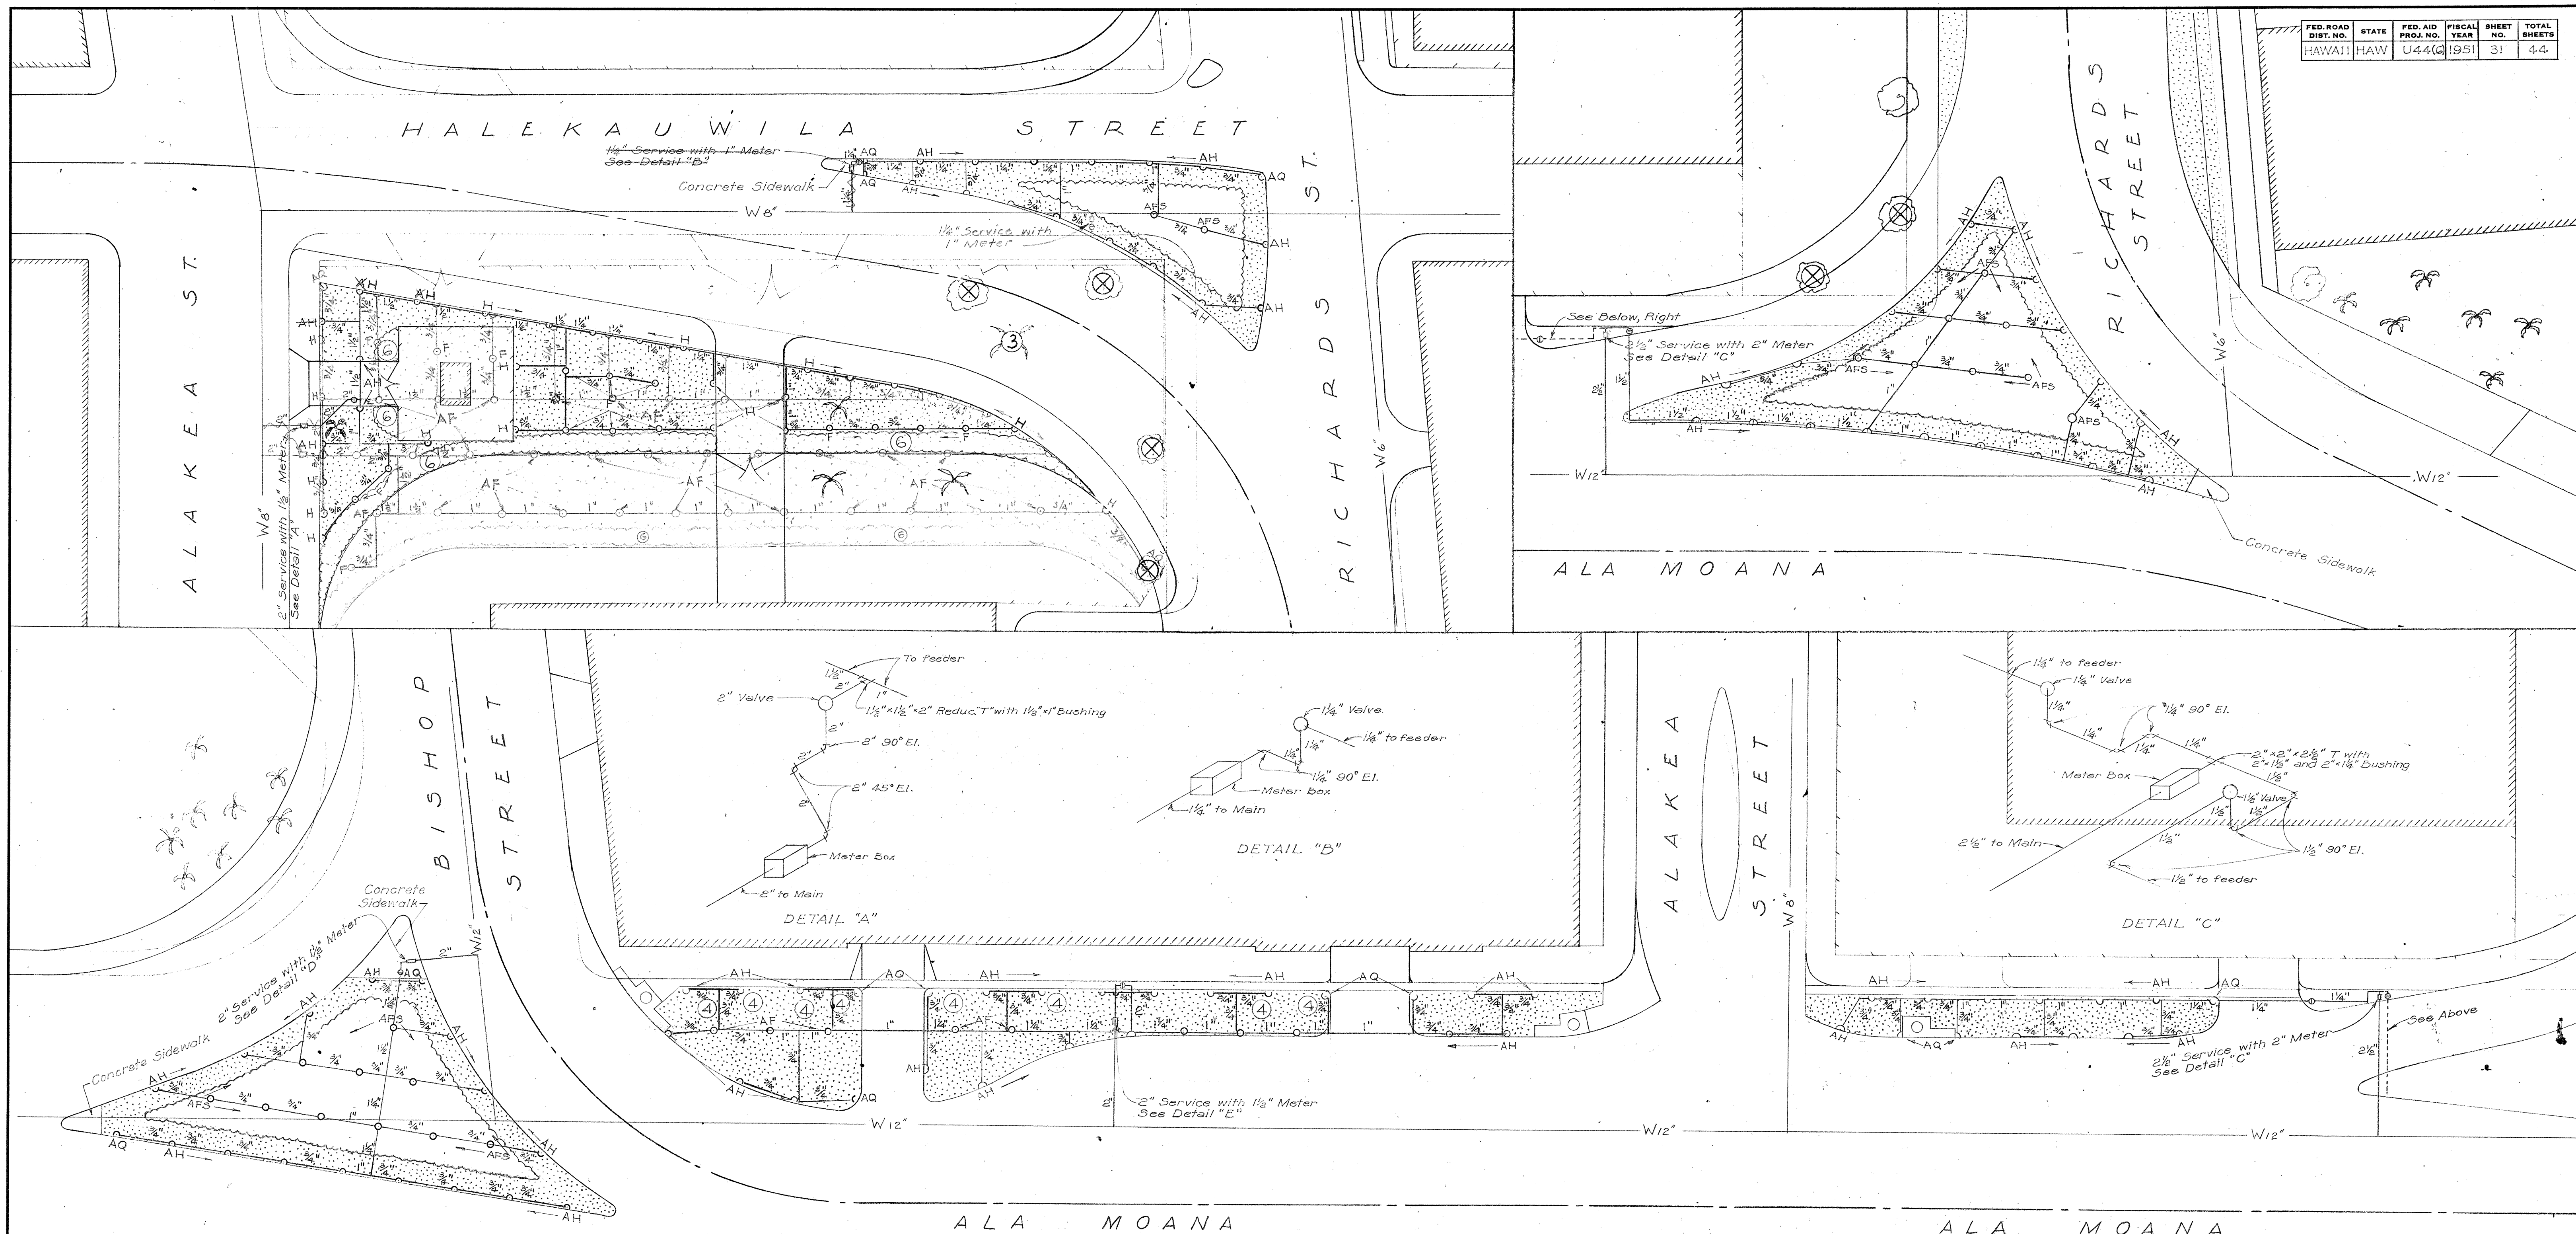

SPRINKLER SYSTEM



- H - 1/2" Half Circle Lawn Type Sprinkler Head
- F - 1/2" Full " " " " " "
- ST - 1/2" Rectangular " " " " " "
- AQ - 3/4" Quarter Circle " " " " " "
- AF - 3/4" Half " " " " " "
- AFS - 3/4" Full " " " " " "
- AFS - 3/4" Full " " " " " "

GENERAL NOTES

Shall be furnished and installed by the Board of Water Supply, City & County of Honolulu.
All Pipes in Pavement Area shall have 2'-0" cover below pavement grade.
Sprinkler Heads shall be spaced as shown above; normal spacing - 15' o.c.

LANDSCAPE PLAN

SYMBOL	NAME	QUANTITY	SPACE	STOCK
③	Tristella Australasiae (Ground Cover)	363	4' Apart	1 Gal.
④	Coconuts to be transplanted	1		
⑤	Transplanted Coconuts	8	As Shown	Existing
⑥	New Red Hibiscus	70	6' Apart - Staggered	1 Gal.
⊗	Ironwoods to be destroyed	6		
⊗	Bermuda Grass	15,140 sq. ft.	As Shown	Cuttings

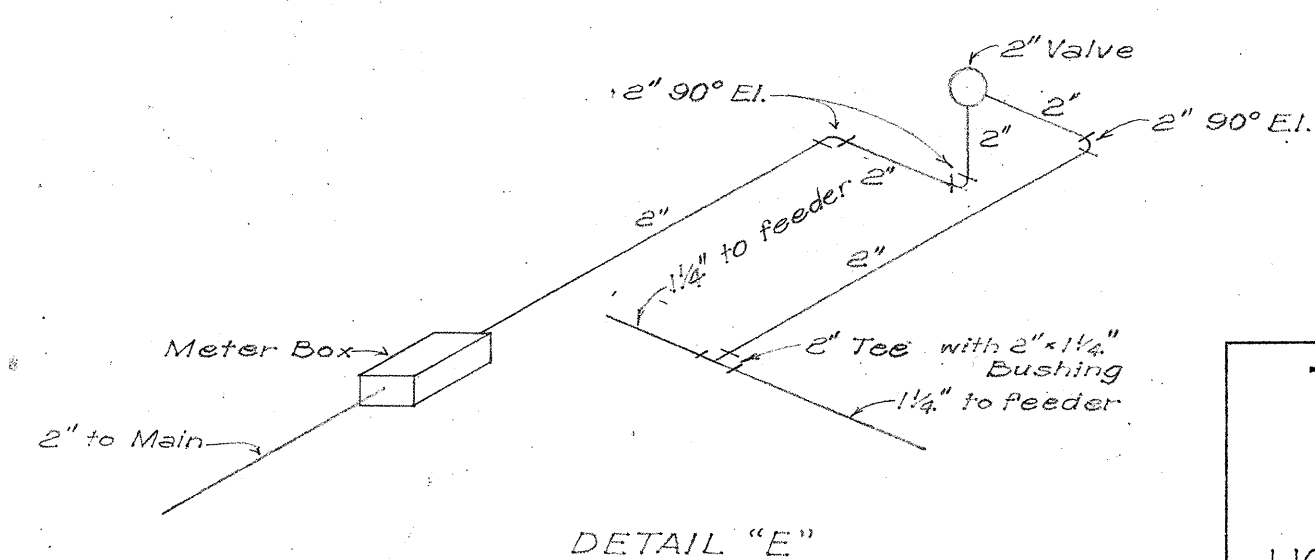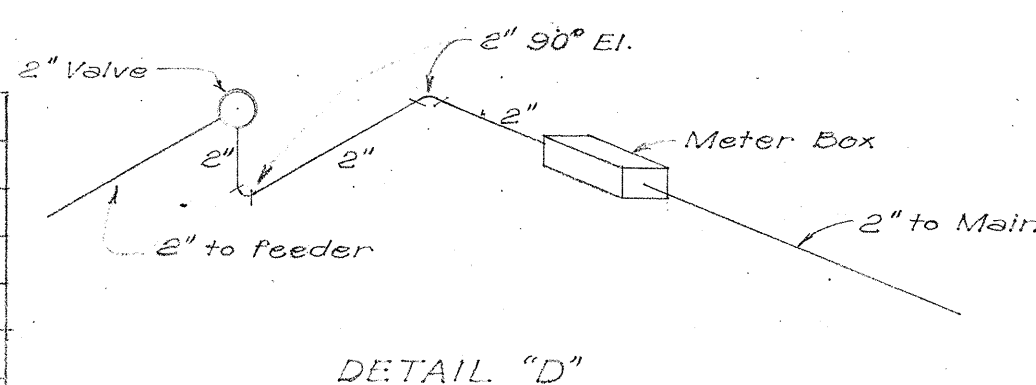


TERRITORIAL HIGHWAY DEPARTMENT TERRITORY OF HAWAII

LANDSCAPE PLAN
HONOLULU-PEARL HARBOR ROAD
HALEKAUWILA-ALA MOANA SECTION
PROJECT NO. U 44(6)

Scale: 1" = 20' February 1951

SHEET No. 2 OF 3 SHEETS

5505.31

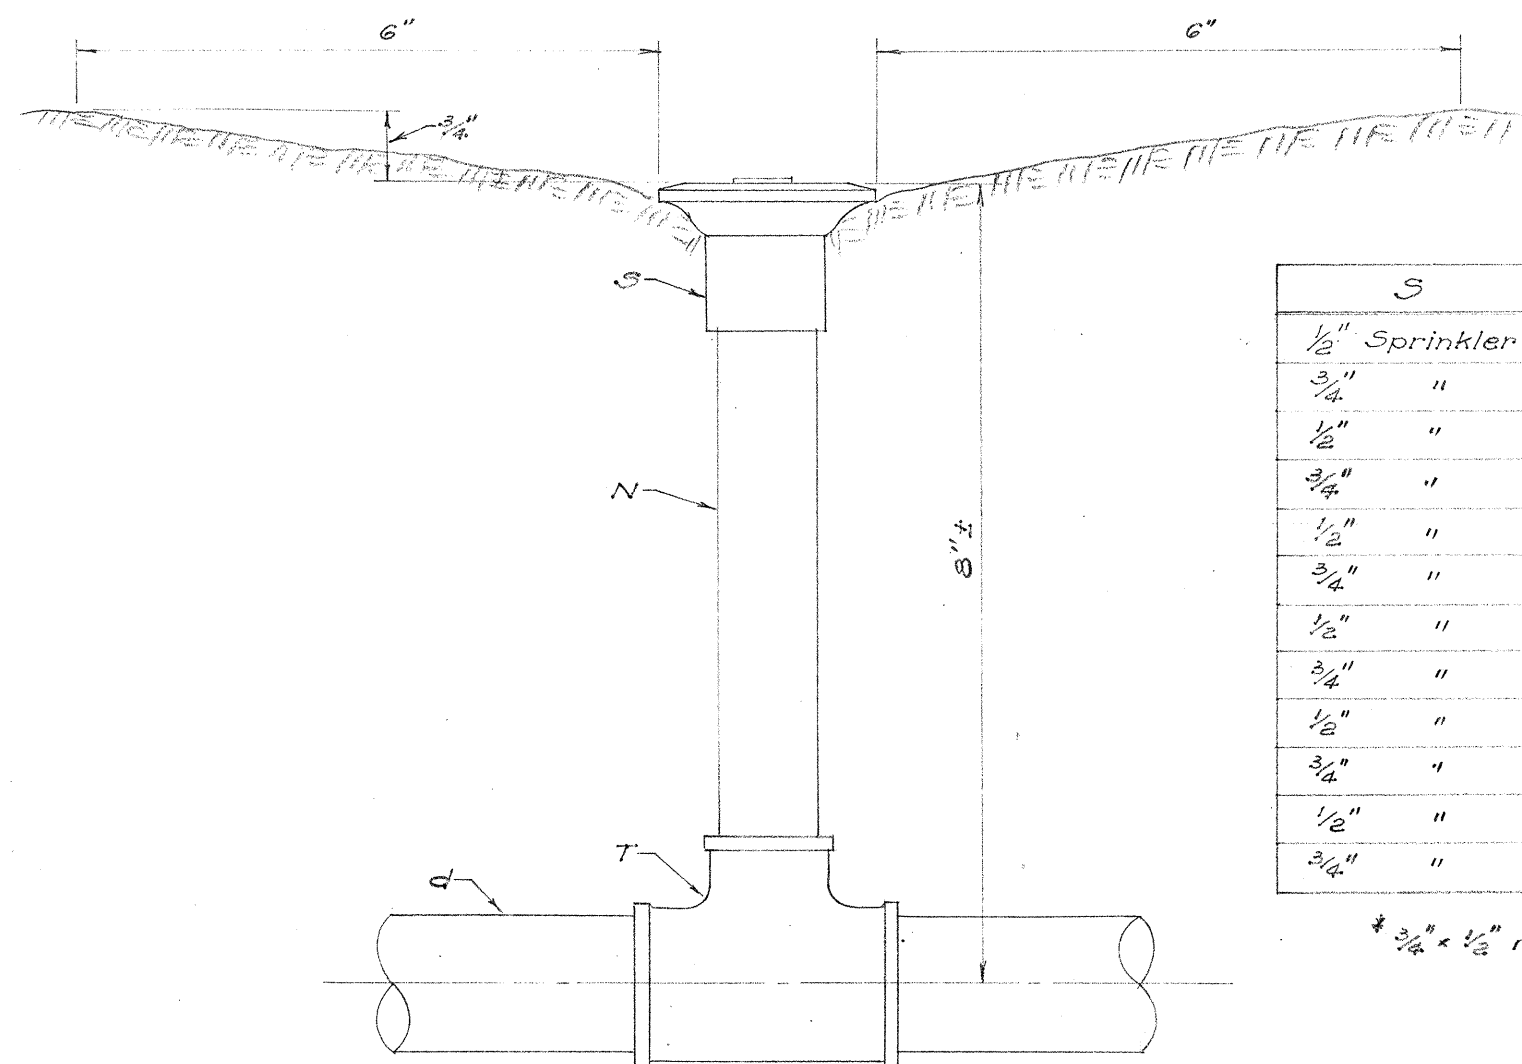

S	N	T	d
1/2" Sprinkler	1/2" x 6" Nipple	3/4" x 1/2" Tee	3/4"
3/4" "	3/4" x 6" "	3/4" x 3/4" "	3/4"
1" "	1" x 6" "	1" x 1" x 1/2" "	1"
1 1/2" "	1 1/2" x 6" "	1 1/2" x 1 1/2" x 1/2" "	1 1/2"
2" "	2" x 6" "	2" x 2" x 1/2" "	2"
2 1/2" "	2 1/2" x 6" "	2 1/2" x 2 1/2" x 1/2" "	2 1/2"
3" "	3" x 6" "	3" x 3" x 1/2" "	3"
3 1/2" "	3 1/2" x 6" "	3 1/2" x 3 1/2" x 1/2" "	3 1/2"
4" "	4" x 6" "	4" x 4" x 1/2" "	4"
4 1/2" "	4 1/2" x 6" "	4 1/2" x 4 1/2" x 1/2" "	4 1/2"
5" "	5" x 6" "	5" x 5" x 1/2" "	5"
5 1/2" "	5 1/2" x 6" "	5 1/2" x 5 1/2" x 1/2" "	5 1/2"
6" "	6" x 6" "	6" x 6" x 1/2" "	6"
6 1/2" "	6 1/2" x 6" "	6 1/2" x 6 1/2" x 1/2" "	6 1/2"
7" "	7" x 6" "	7" x 7" x 1/2" "	7"
7 1/2" "	7 1/2" x 6" "	7 1/2" x 7 1/2" x 1/2" "	7 1/2"
8" "	8" x 6" "	8" x 8" x 1/2" "	8"
8 1/2" "	8 1/2" x 6" "	8 1/2" x 8 1/2" x 1/2" "	8 1/2"
9" "	9" x 6" "	9" x 9" x 1/2" "	9"
9 1/2" "	9 1/2" x 6" "	9 1/2" x 9 1/2" x 1/2" "	9 1/2"
10" "	10" x 6" "	10" x 10" x 1/2" "	10"
10 1/2" "	10 1/2" x 6" "	10 1/2" x 10 1/2" x 1/2" "	10 1/2"
11" "	11" x 6" "	11" x 11" x 1/2" "	11"
11 1/2" "	11 1/2" x 6" "	11 1/2" x 11 1/2" x 1/2" "	11 1/2"
12" "	12" x 6" "	12" x 12" x 1/2" "	12"
12 1/2" "	12 1/2" x 6" "	12 1/2" x 12 1/2" x 1/2" "	12 1/2"
13" "	13" x 6" "	13" x 13" x 1/2" "	13"
13 1/2" "	13 1/2" x 6" "	13 1/2" x 13 1/2" x 1/2" "	13 1/2"
14" "	14" x 6" "	14" x 14" x 1/2" "	14"
14 1/2" "	14 1/2" x 6" "	14 1/2" x 14 1/2" x 1/2" "	14 1/2"
15" "	15" x 6" "	15" x 15" x 1/2" "	15"
15 1/2" "	15 1/2" x 6" "	15 1/2" x 15 1/2" x 1/2" "	15 1/2"
16" "	16" x 6" "	16" x 16" x 1/2" "	16"
16 1/2" "	16 1/2" x 6" "	16 1/2" x 16 1/2" x 1/2" "	16 1/2"
17" "	17" x 6" "	17" x 17" x 1/2" "	17"
94" "	94" x 6" "	94" x 94" x 1/2" "	94"
94 1/2" "	94 1/2" x 6" "	94 1/2" x 94 1/2" x 1/2" "	94 1/2"
95" "	95" x 6" "	95" x 95" x 1/2" "	95"
95 1/2" "	95 1/2" x 6" "	95 1/2" x 95 1/2" x 1/2" "	95 1/2"
96" "	96" x 6" "	96" x 96" x 1/2" "	96"
96 1/2" "	96 1/2" x 6" "	96 1/2" x 96 1/2" x 1/2" "	96 1/2"
97" "	97" x 6" "	97" x 97" x 1/2" "	97"
97 1/2" "	97 1/2" x 6" "	97 1/2" x 97 1/2" x 1/2" "	97 1/2"
98" "	98" x 6" "	98" x 98" x 1/2" "	98"
98 1/2" "	98 1/2" x 6" "	98 1/2" x 98 1/2" x 1/2" "	98 1/2"
99" "	99" x 6" "	99" x 99" x 1/2" "	99"
99 1/2" "	99 1/2" x 6" "	99 1/2" x 99 1/2" x 1/2" "	99 1/2"
100" "	100" x 6" "	100" x 100" x 1/2" "	100"
100 1/2" "	100 1/2" x 6" "	100 1/2" x 100 1/2" x 1/2" "	100 1/2"

* 3/4" x 1/2" reducer required

