


INDEX TO DRAWINGS	
SHEET NO.	DESCRIPTION
1	Title Sheet
2-4	Typical Sections
5-6	Plan & Profile
7-12	Detail Plan of Roadway
13	Alterations to Irwin Park
14-16	Plan of Water System
17-18	Utilities
19-21	Highway Lighting System
22-26	Traffic Signal System
27-29	Traffic Signs & Pavement Markings
30-32	Landscape Plan & Sprinkler System
33-35	Special Catch Basins
35	Estimated Quantities
36-39	Standard Details
40-44	Gross Sections

CONVENTIONAL SIGNS	
Centerline	125
Boundary Lines	or
Fences (Named)	
Existing Roadways	
Circular Culvert	
Box Culvert	
Bridge	
Telephone Pole	
Electric Power Pole	
Water Main	W ₂ (W4, 8, 12, Etc.)
Storm Drain	SD ₁₂ (SD18, 24, Etc.)
Concrete Drop Intake	
Standard Catch Basin	
Standard Manhole	M.S.
Sewer Manhole	S.S.
Telephone Manhole	T.M.H.
Fire Hydrant	F.H.
Tree (Large, named)	Mano Coco
Railroad	
Mutual Telephone Conduit	T
Electric Conduit	E

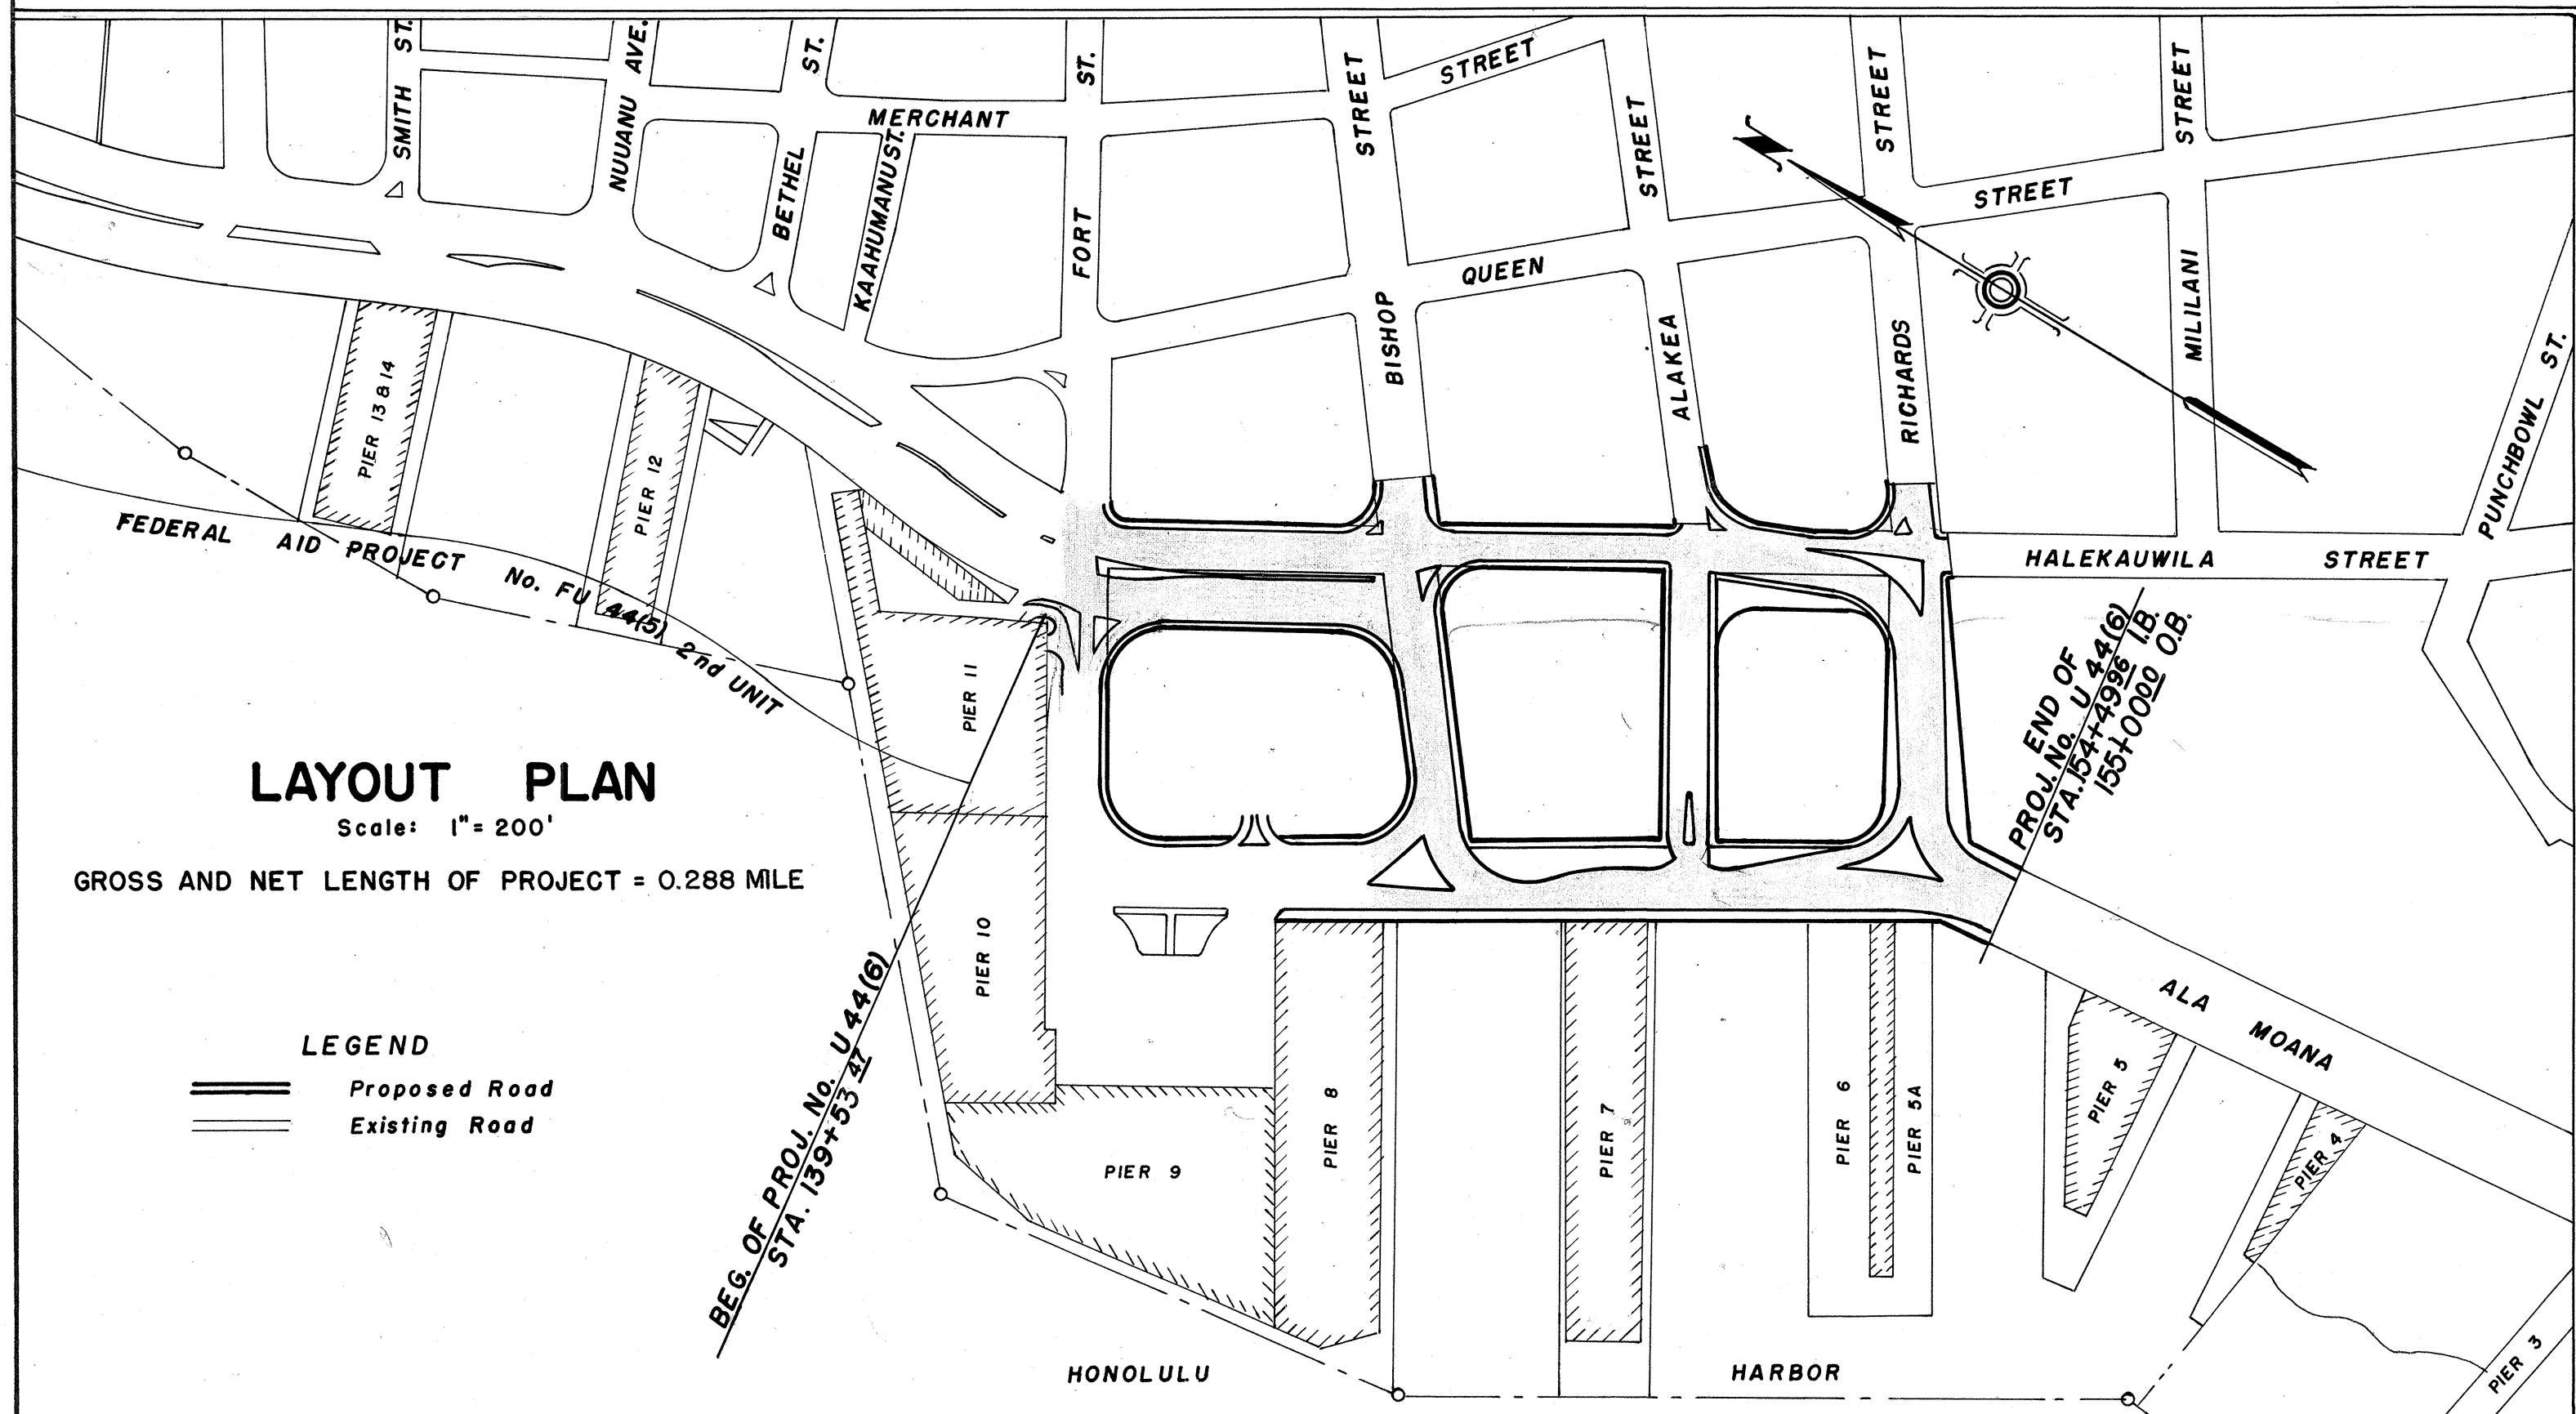

DATE	DESIGNED BY	TRACED BY	QUANTITIES BY	CHECKED BY


TERRITORY OF HAWAII
TERRITORIAL HIGHWAY DEPARTMENT
HONOLULU, OAHU, T. H.

PLANS OF HONOLULU PEARL HARBOR ROAD HALEKAUWILA - ALA MOANA SECTION FEDERAL AID URBAN PROJECT NO. U 44 (6)

DISTRICT OF HONOLULU
ISLAND OF OAHU

SCALES

PLAN	1 INCH = 50 FEET
PROFILE	HOR 1 INCH = 50 FEET VER 1 INCH = 5 FEET
CROSS SECTIONS	HOR 1 INCH = 10 FEET VER 1 INCH = 5 FEET

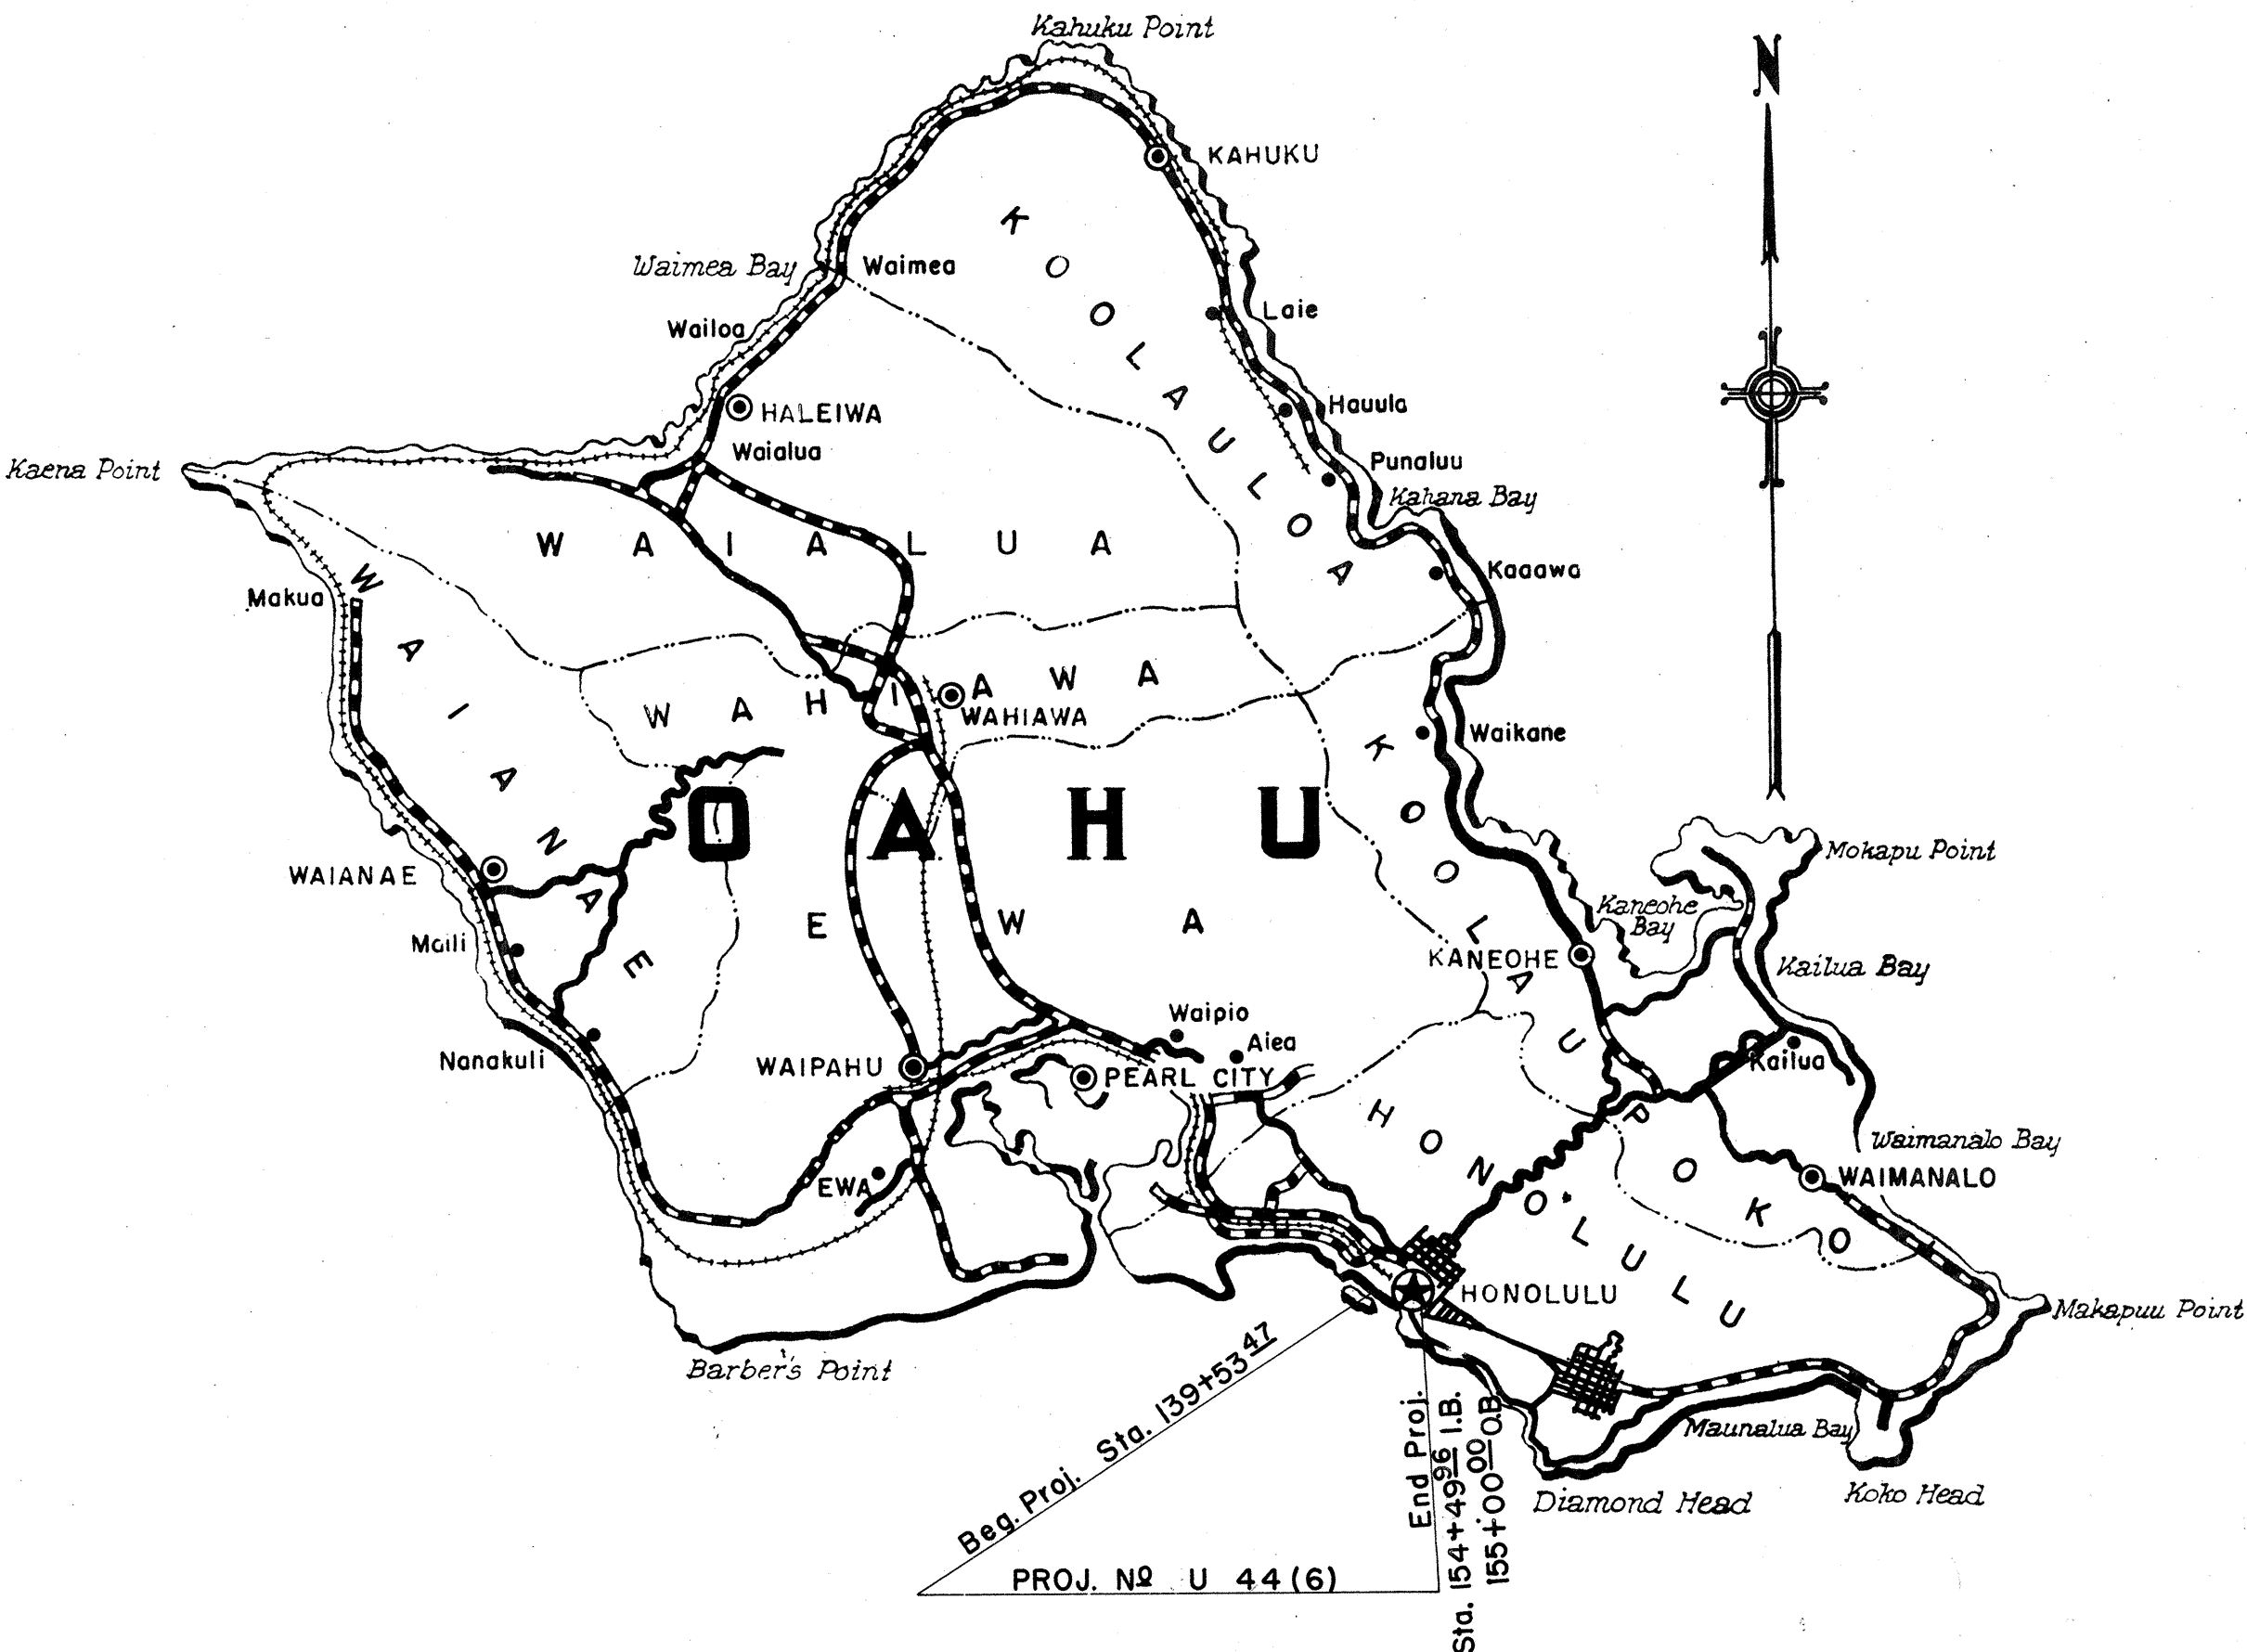

Federal Aid Projects Previously Constructed Or Under Construction

NOTE:
ALL CHANGES MADE DURING CONSTRUCTION
HAVE BEEN NOTED IN RED IN THESE TRACINGS
AND CHECKED BY:

PROJECT ENGINEER
DATE 10-13-52

APPROVED DATE 12-3-51
TERRITORIAL HIGHWAY ENGINEER

DEPARTMENT OF COMMERCE
BUREAU OF PUBLIC ROADS
RECOMMENDED FOR APPROVAL:
DISTRICT ENGINEER DATE
APPROVED:
DIVISION ENGINEER DATE

3505.1

PD J-10