


FINAL	DATE
SURVEY	BY
NOTE BOOK	NO.
TEMPLATE	AREAS CHECKED

ORIGINAL	DATE
SURVEY	BY
NOTE BOOK	NO.
TEMPLATE	AREAS CHECKED

FED. ROAD DIST. NO.	STATE	FED. AID PROJ. NO.	FISCAL YEAR	SHEET NO.	TOTAL SHEETS
HAWAII	HAW	1032-10	1955	11	12

12/21/55

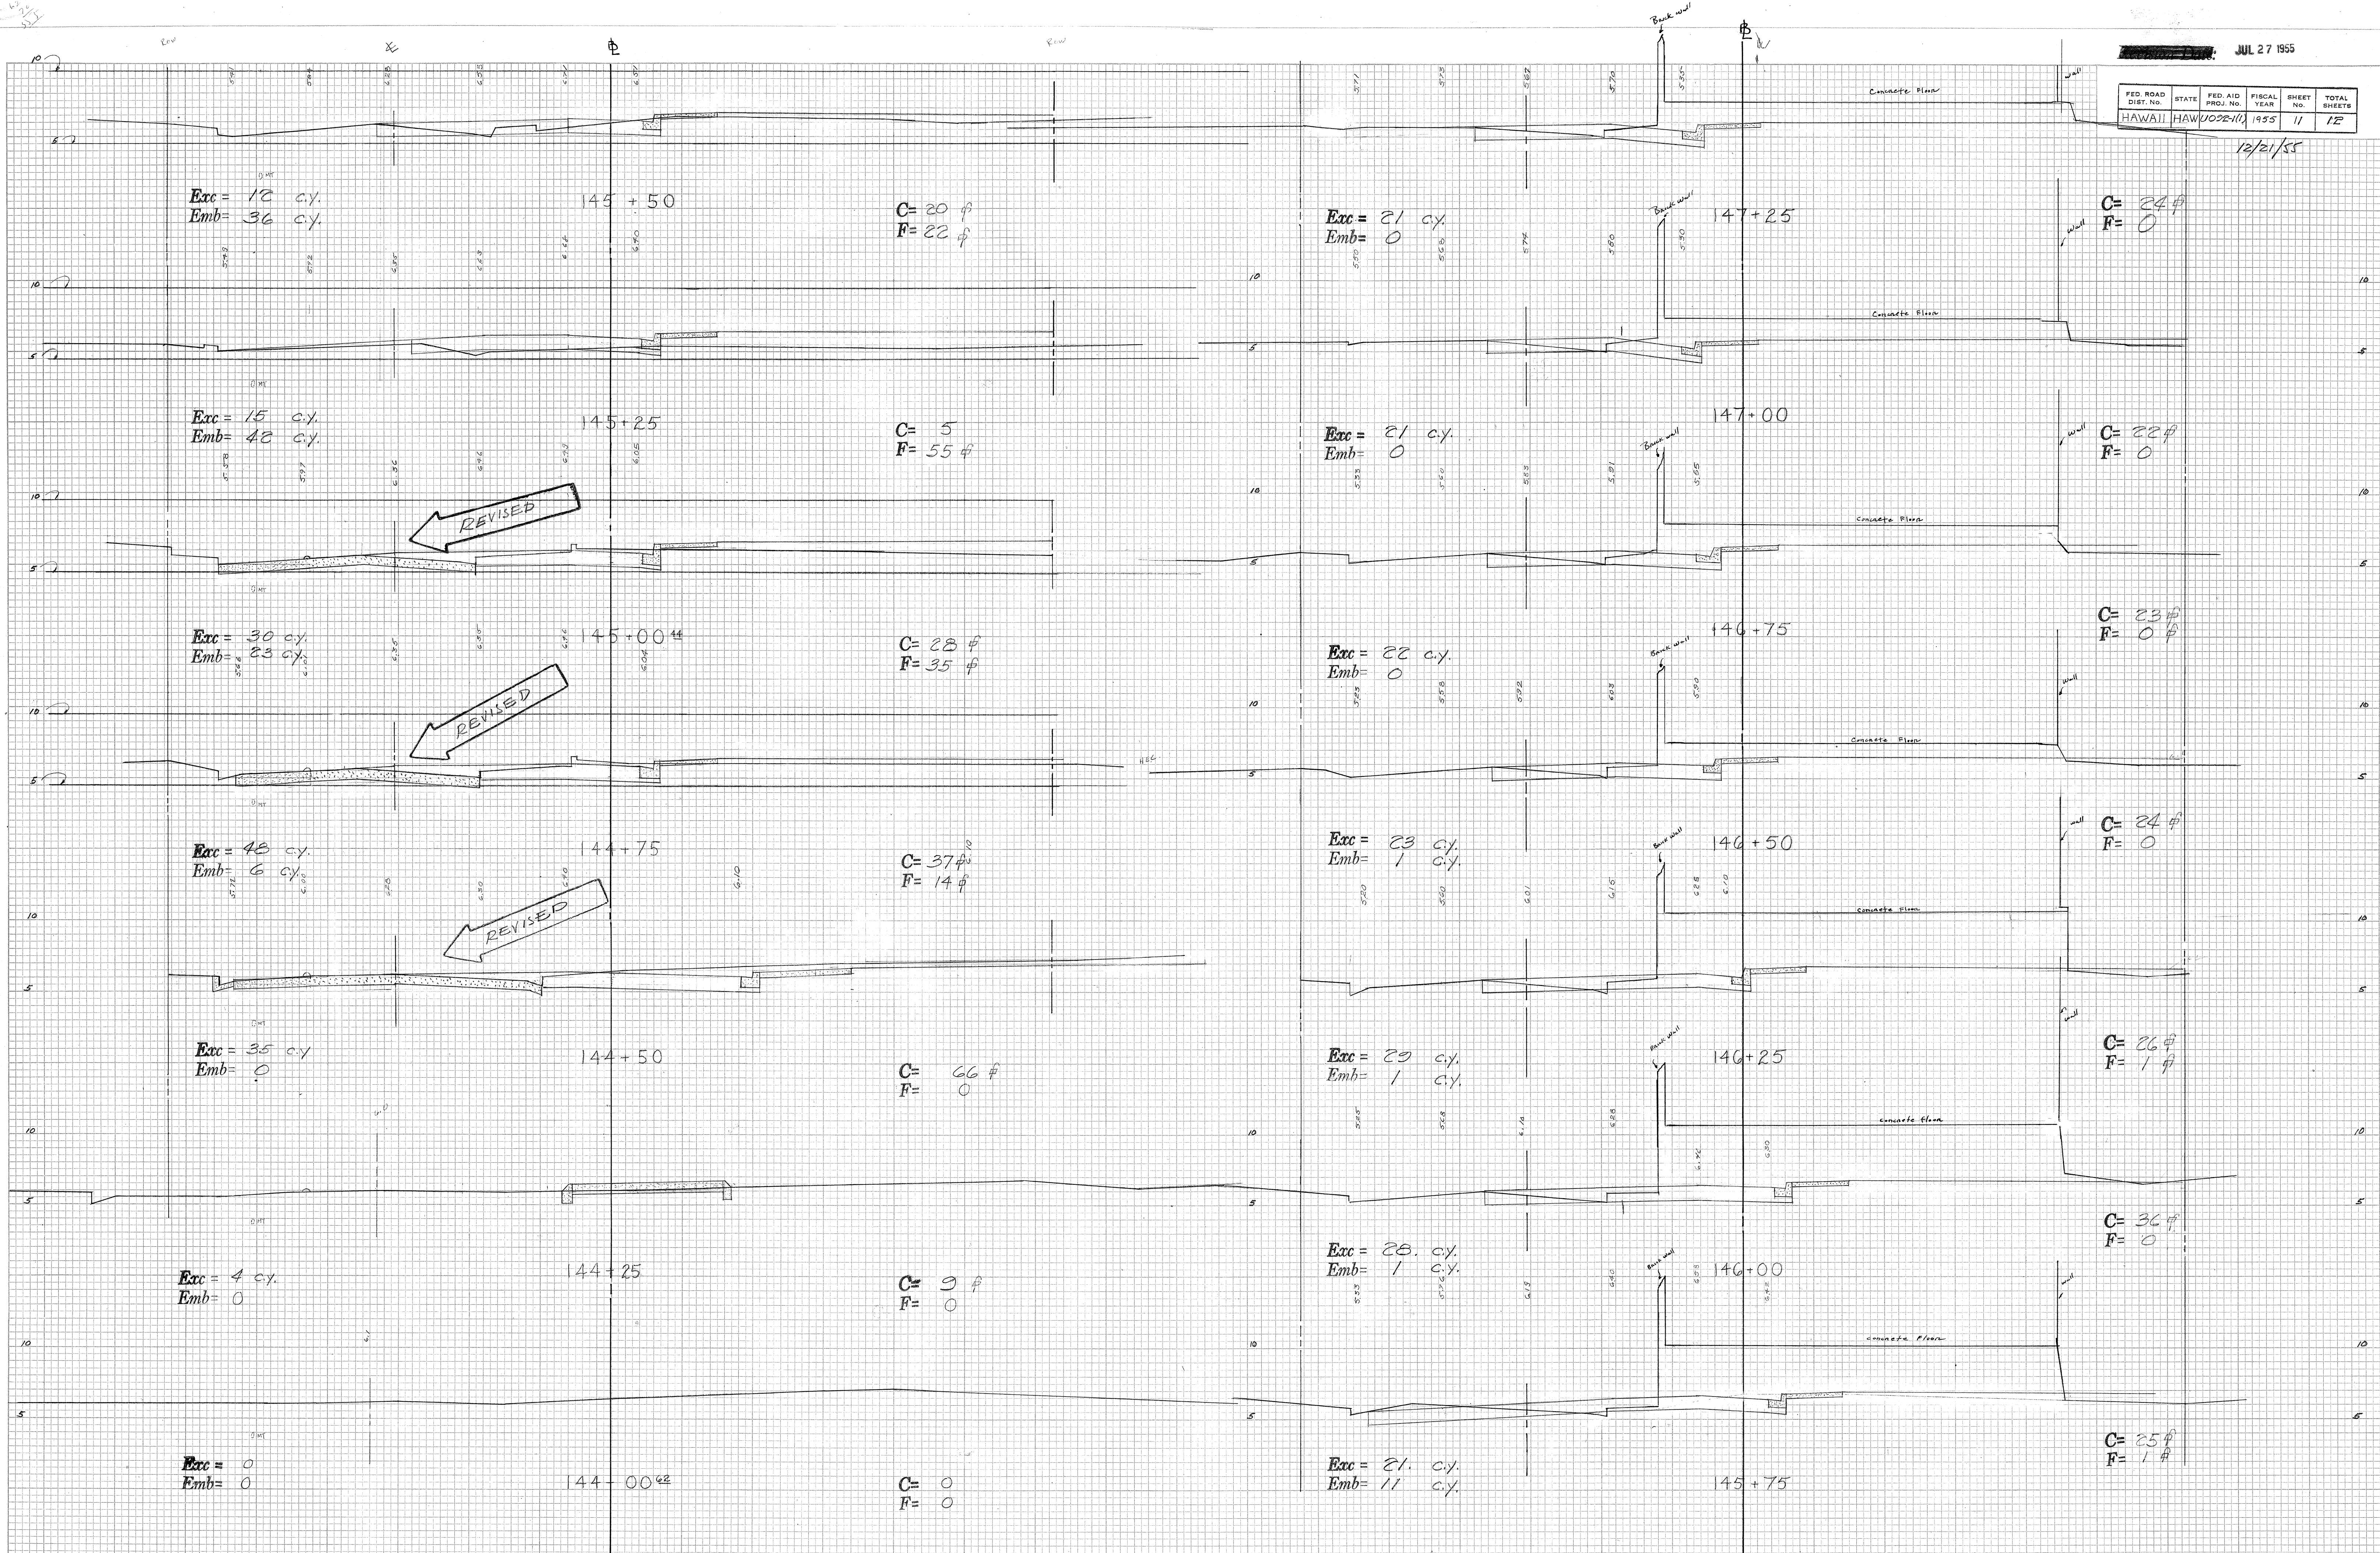

FINAL SURVEY	SURVEYED PLOTTED	BY	DATE
NOTE BOOK	TEMPLATE AREAS		
NO.	AREAS CHECKED		

ORIGINAL SURVEY				BY	DATE
	SURVEYED				
	PLOTTED				
	TEMPLATE				
	AREAS				
NO.	AREAS CHECKED				

