



TERRITORIAL DEPARTMENT OF PUBLIC WORKS			
DISTRICT ENGINEER - OAHU			
FILE	PROJECT	FOLDER	NO.
1577	1	3	61

ESTIMATED QUANTITIES

Structural Excavation	300	cu. yds.
CRM	173	cu. yds.
Class "A-1" Concrete	24	cu. yds.

DETAIL of EXPANSION JOINT

Scale: 3" = 1'-0"

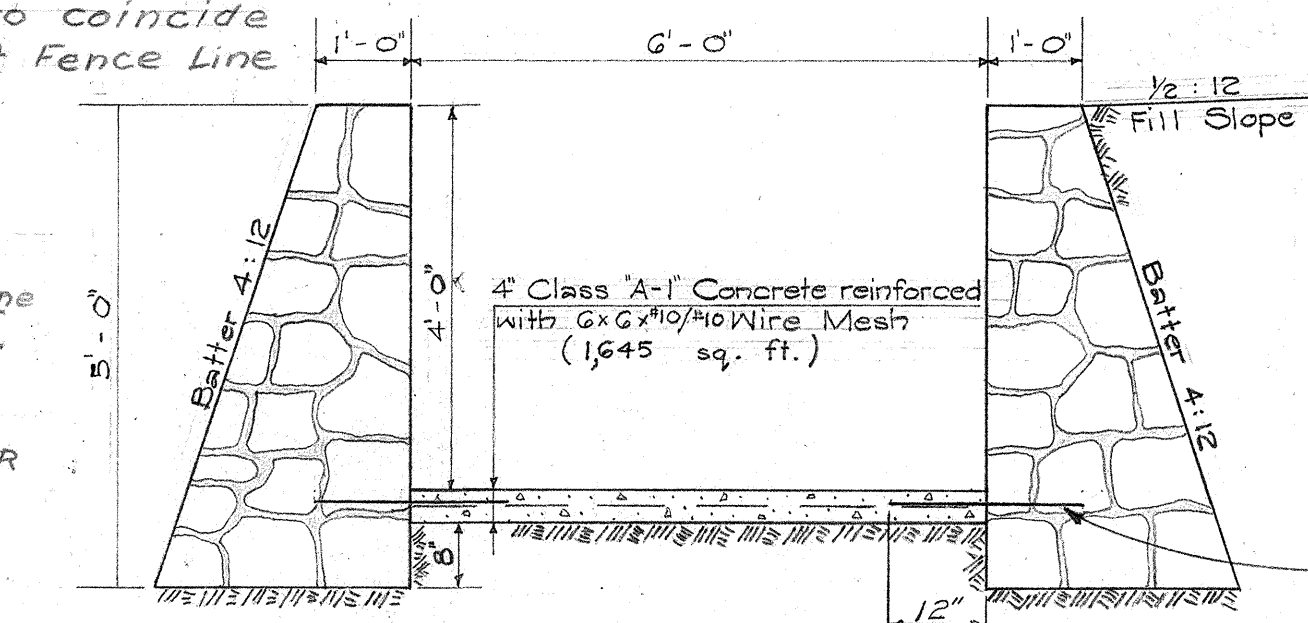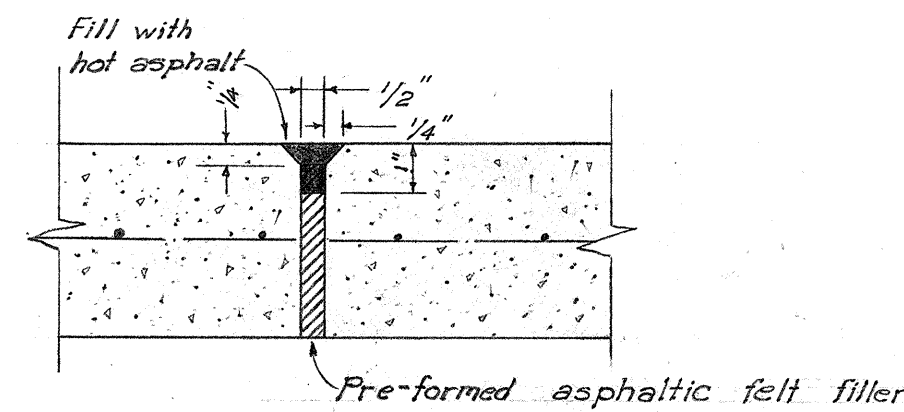




TYPICAL SECTION OF CRM-CONC DITCH

Scale: 1/2" = 1'-0"

NOTE
6x6x10/10 Wire mesh reinforcement, #4 dowels, and expansion joint materials, to be incidental to Class A-1 Concrete.

PLAN
SURVEYED
PLOTTED
NOTE BOOK
NO.

PROFILE
SURVEYED
PLOTTED
NOTE BOOK
NO.

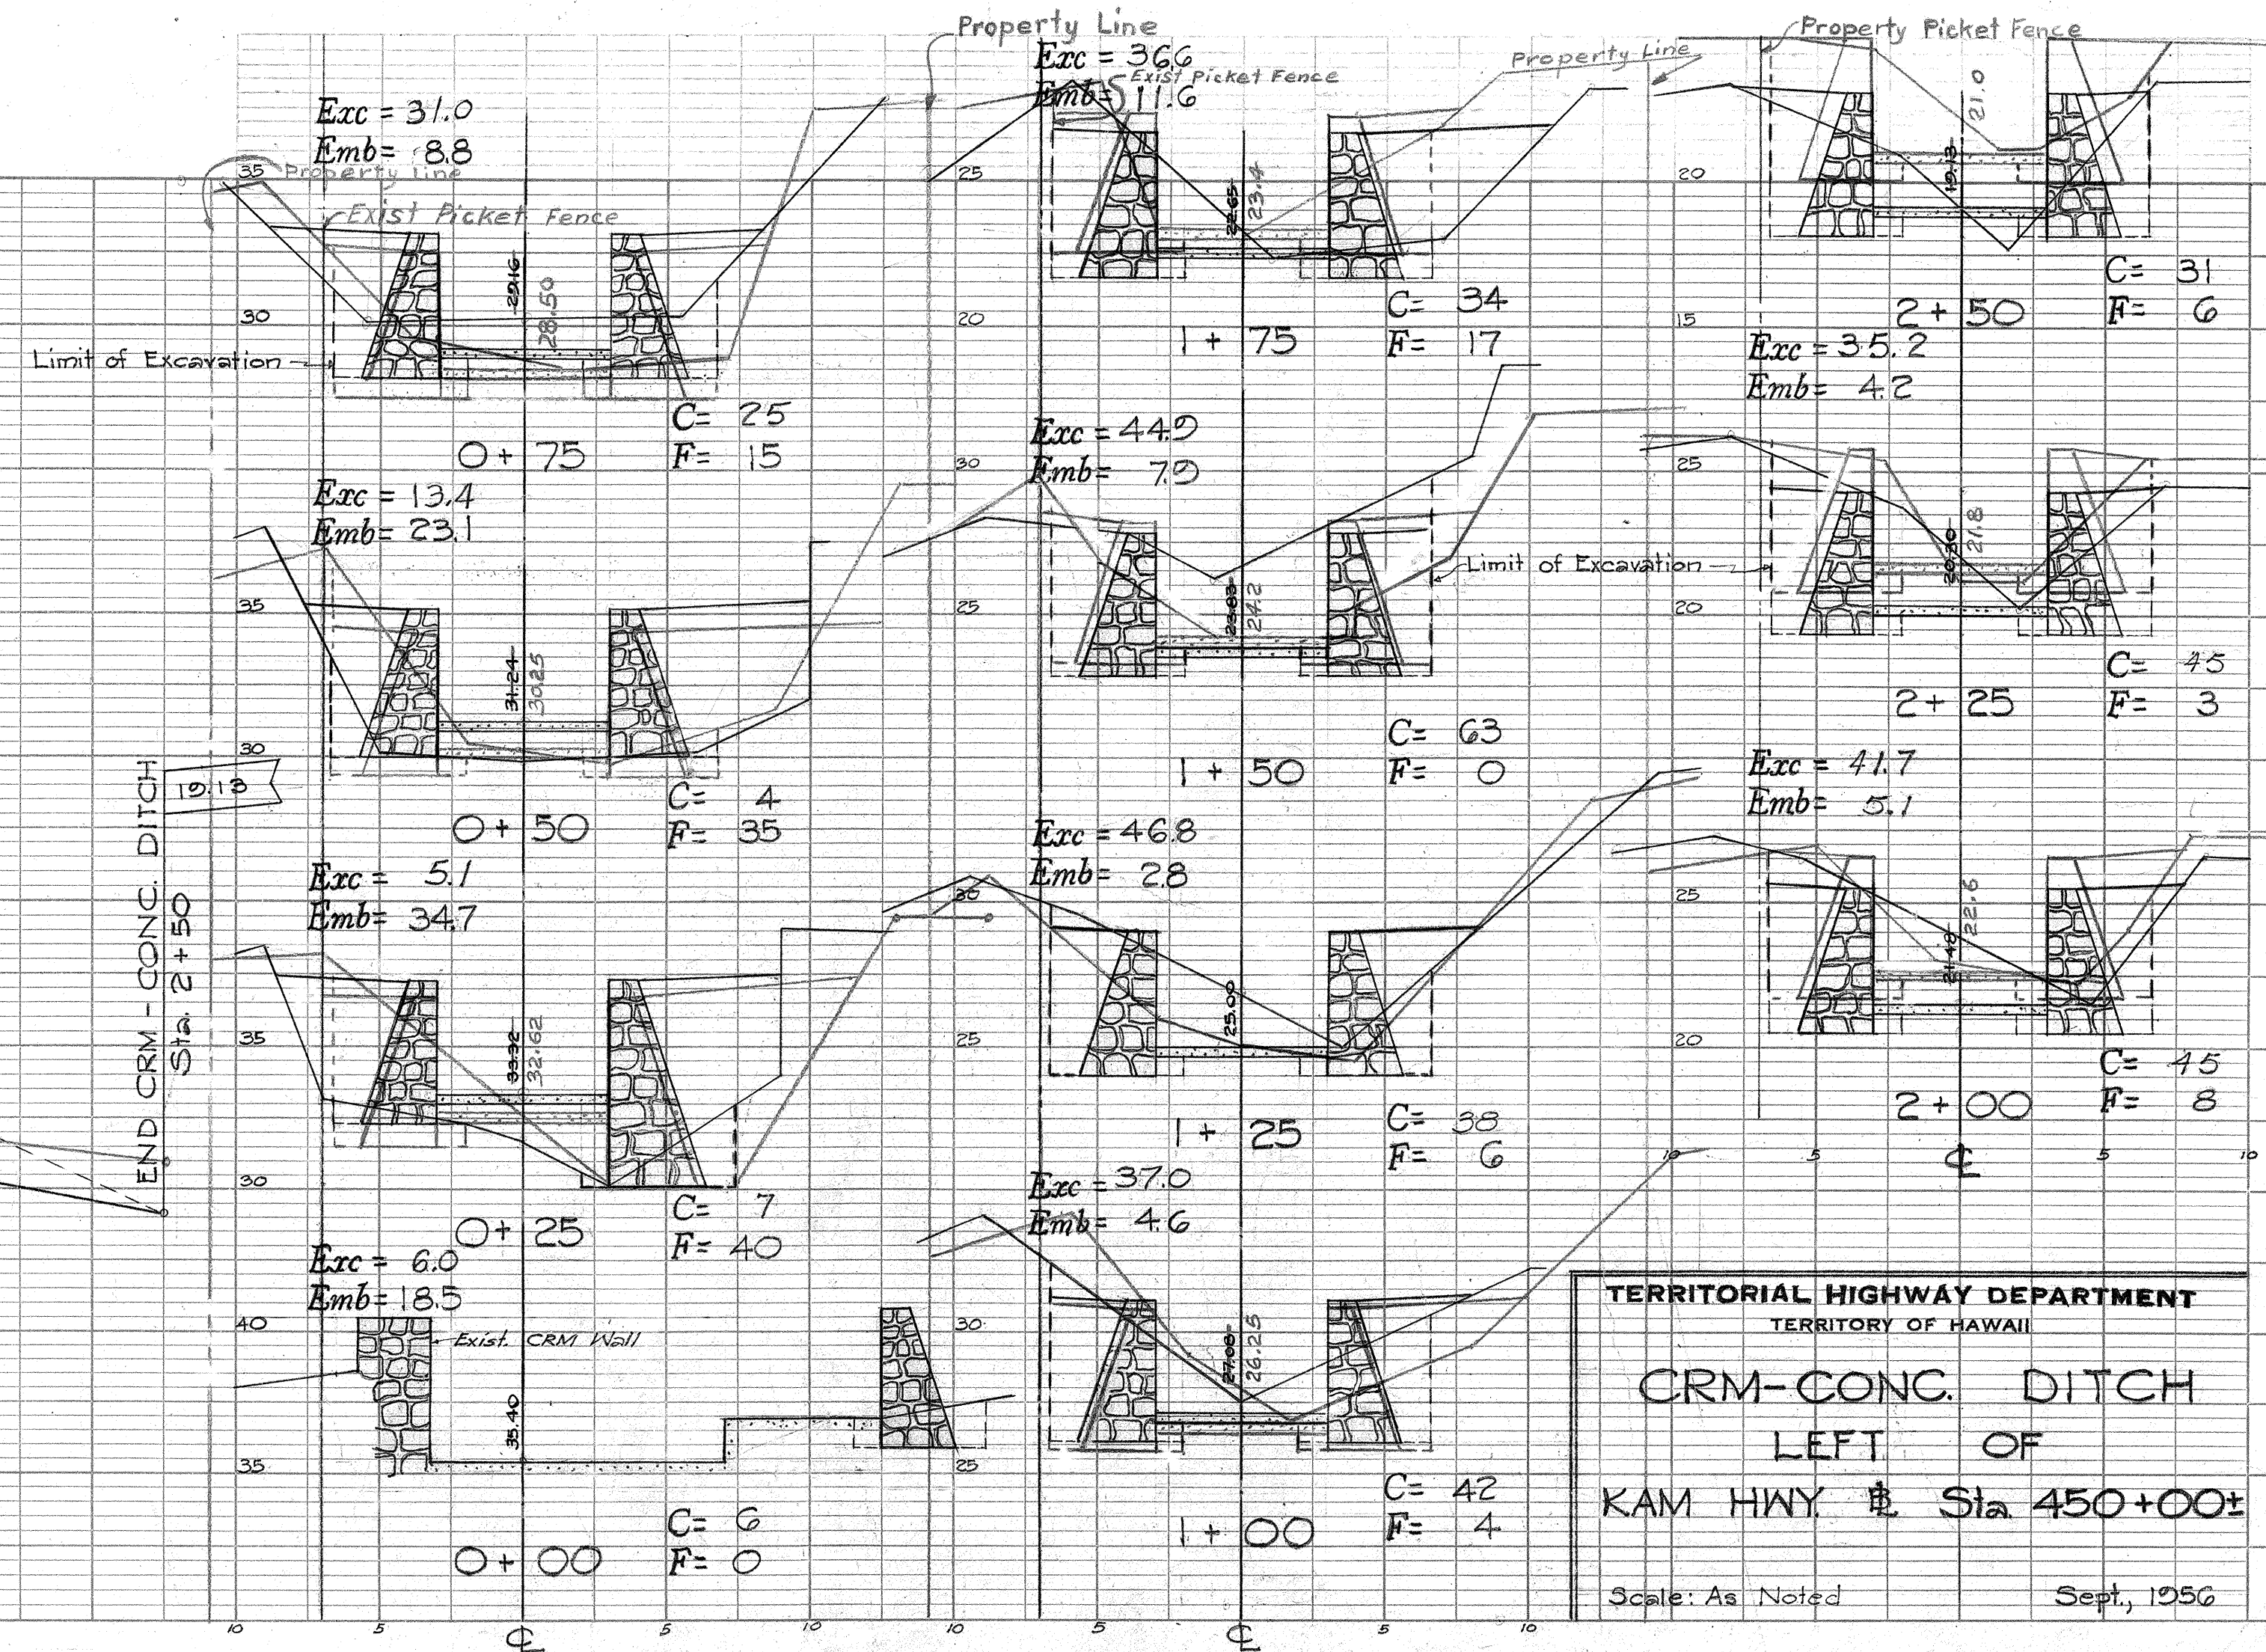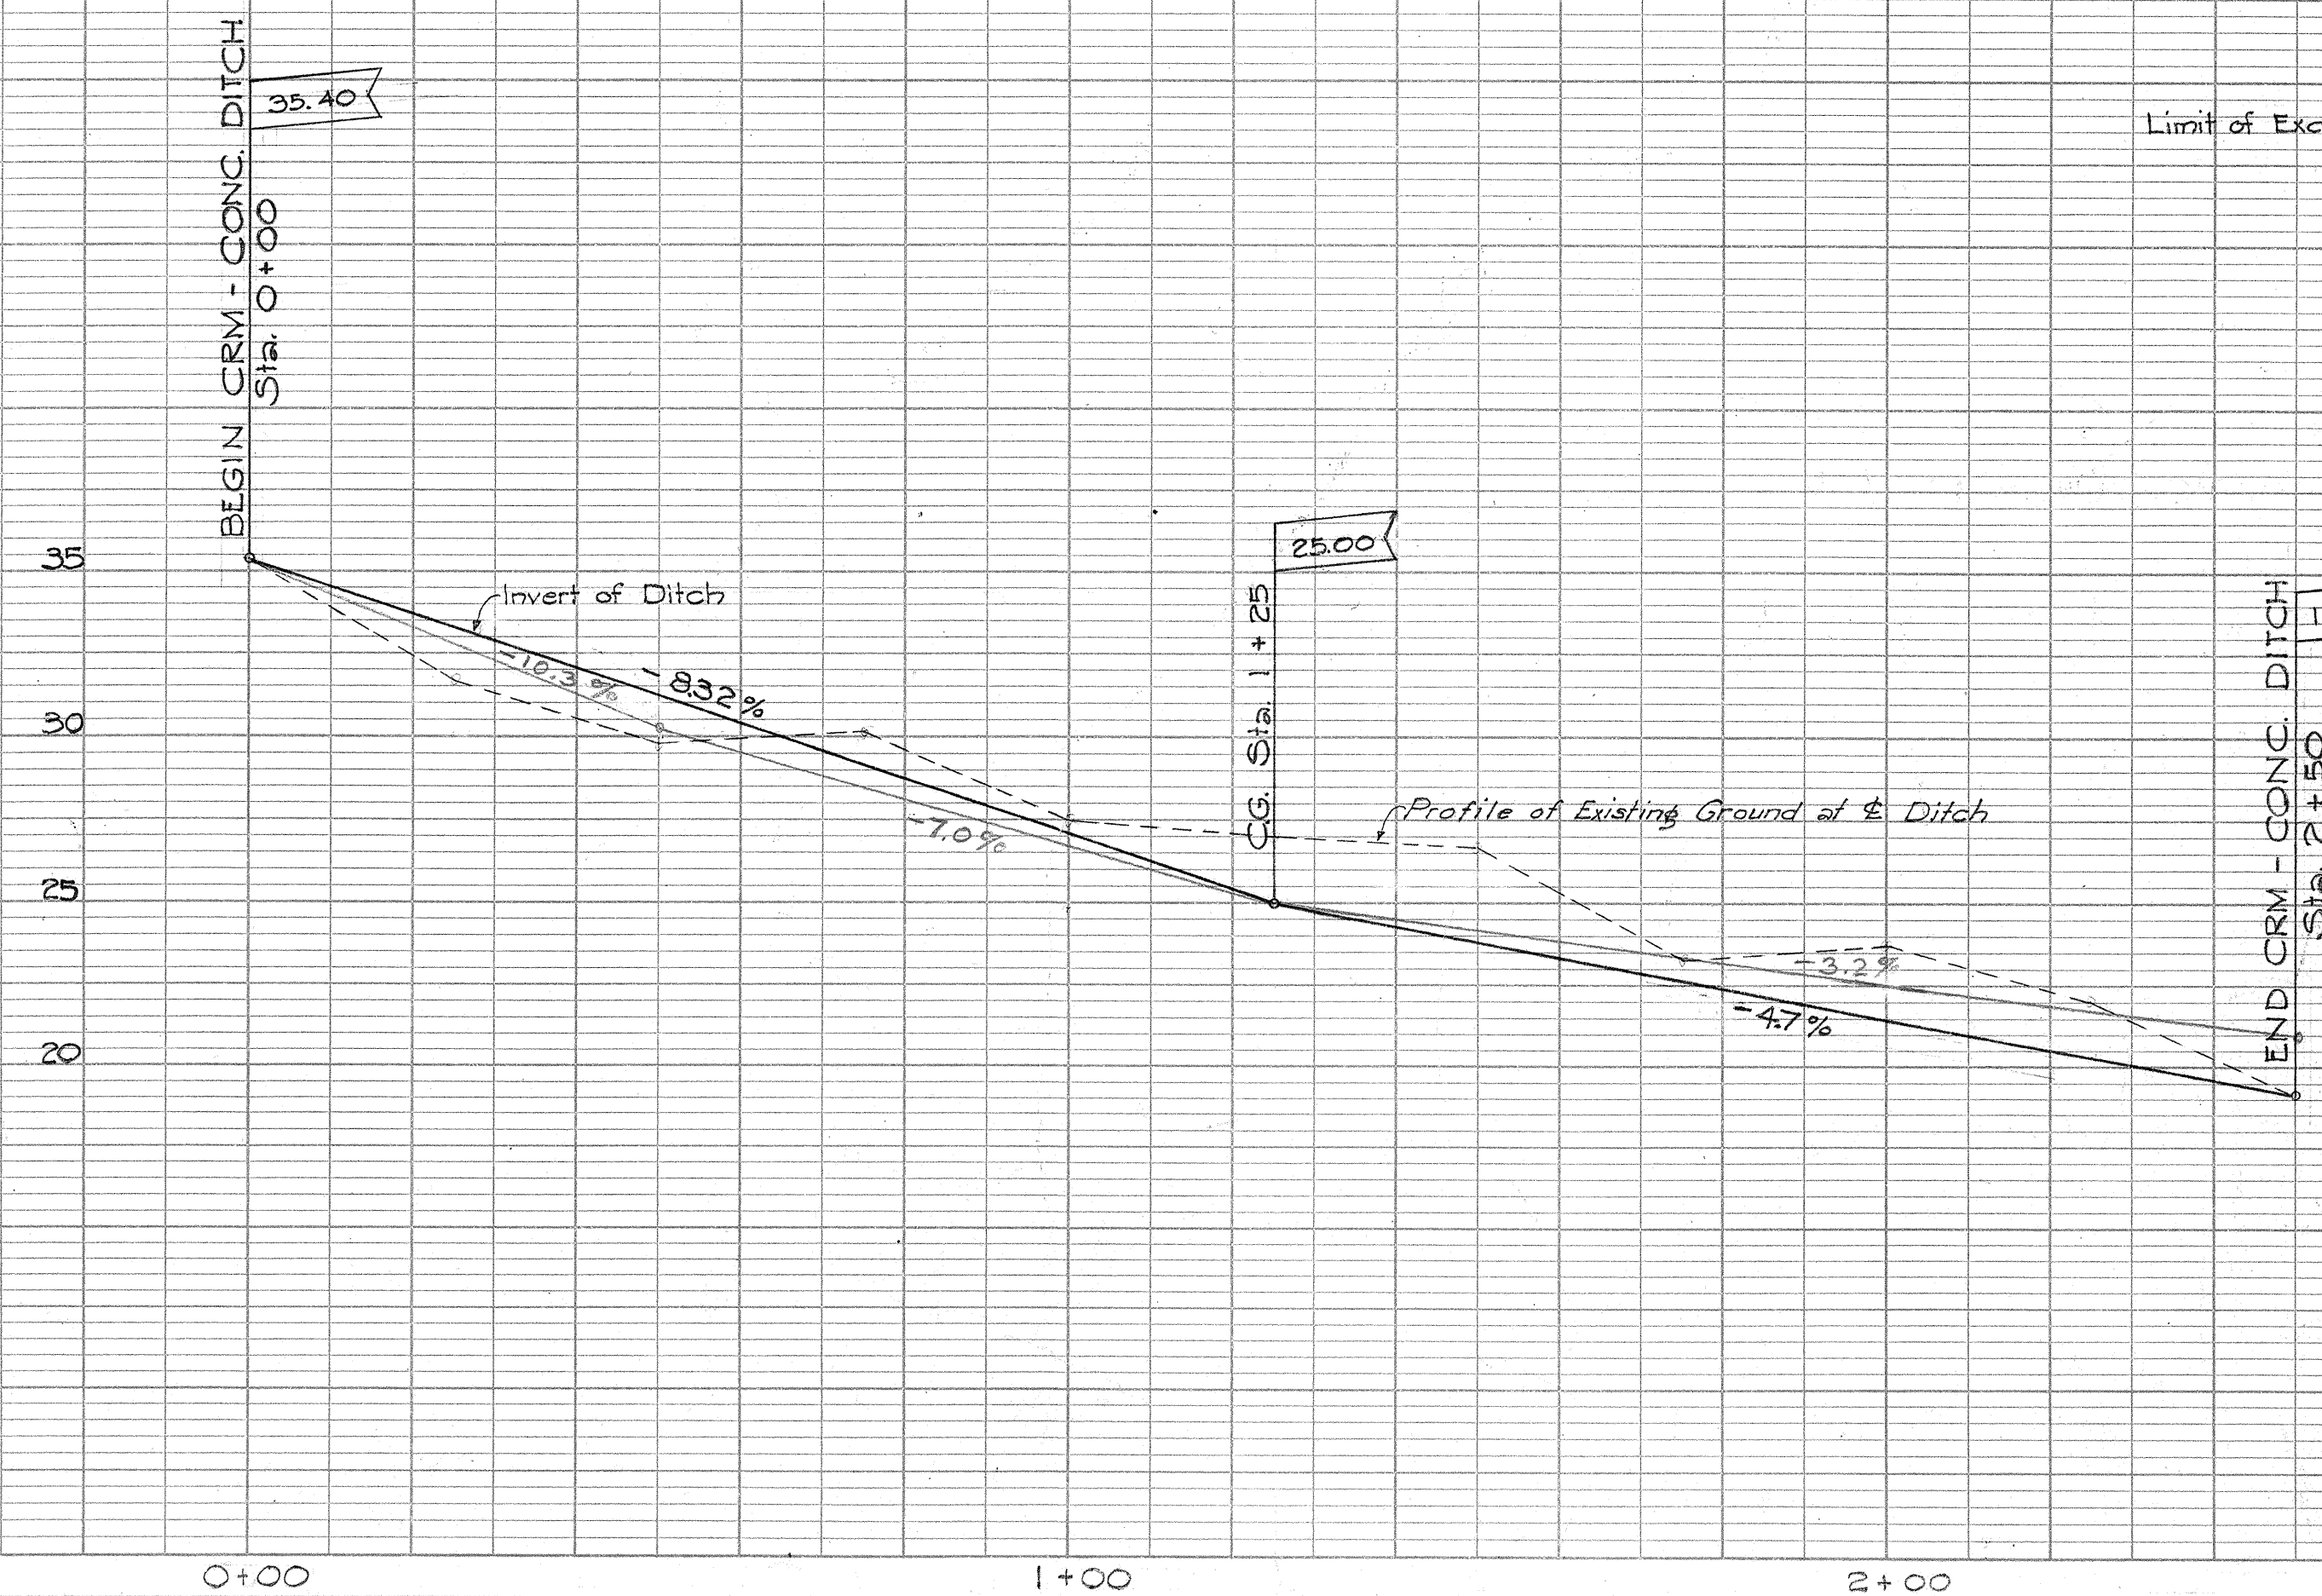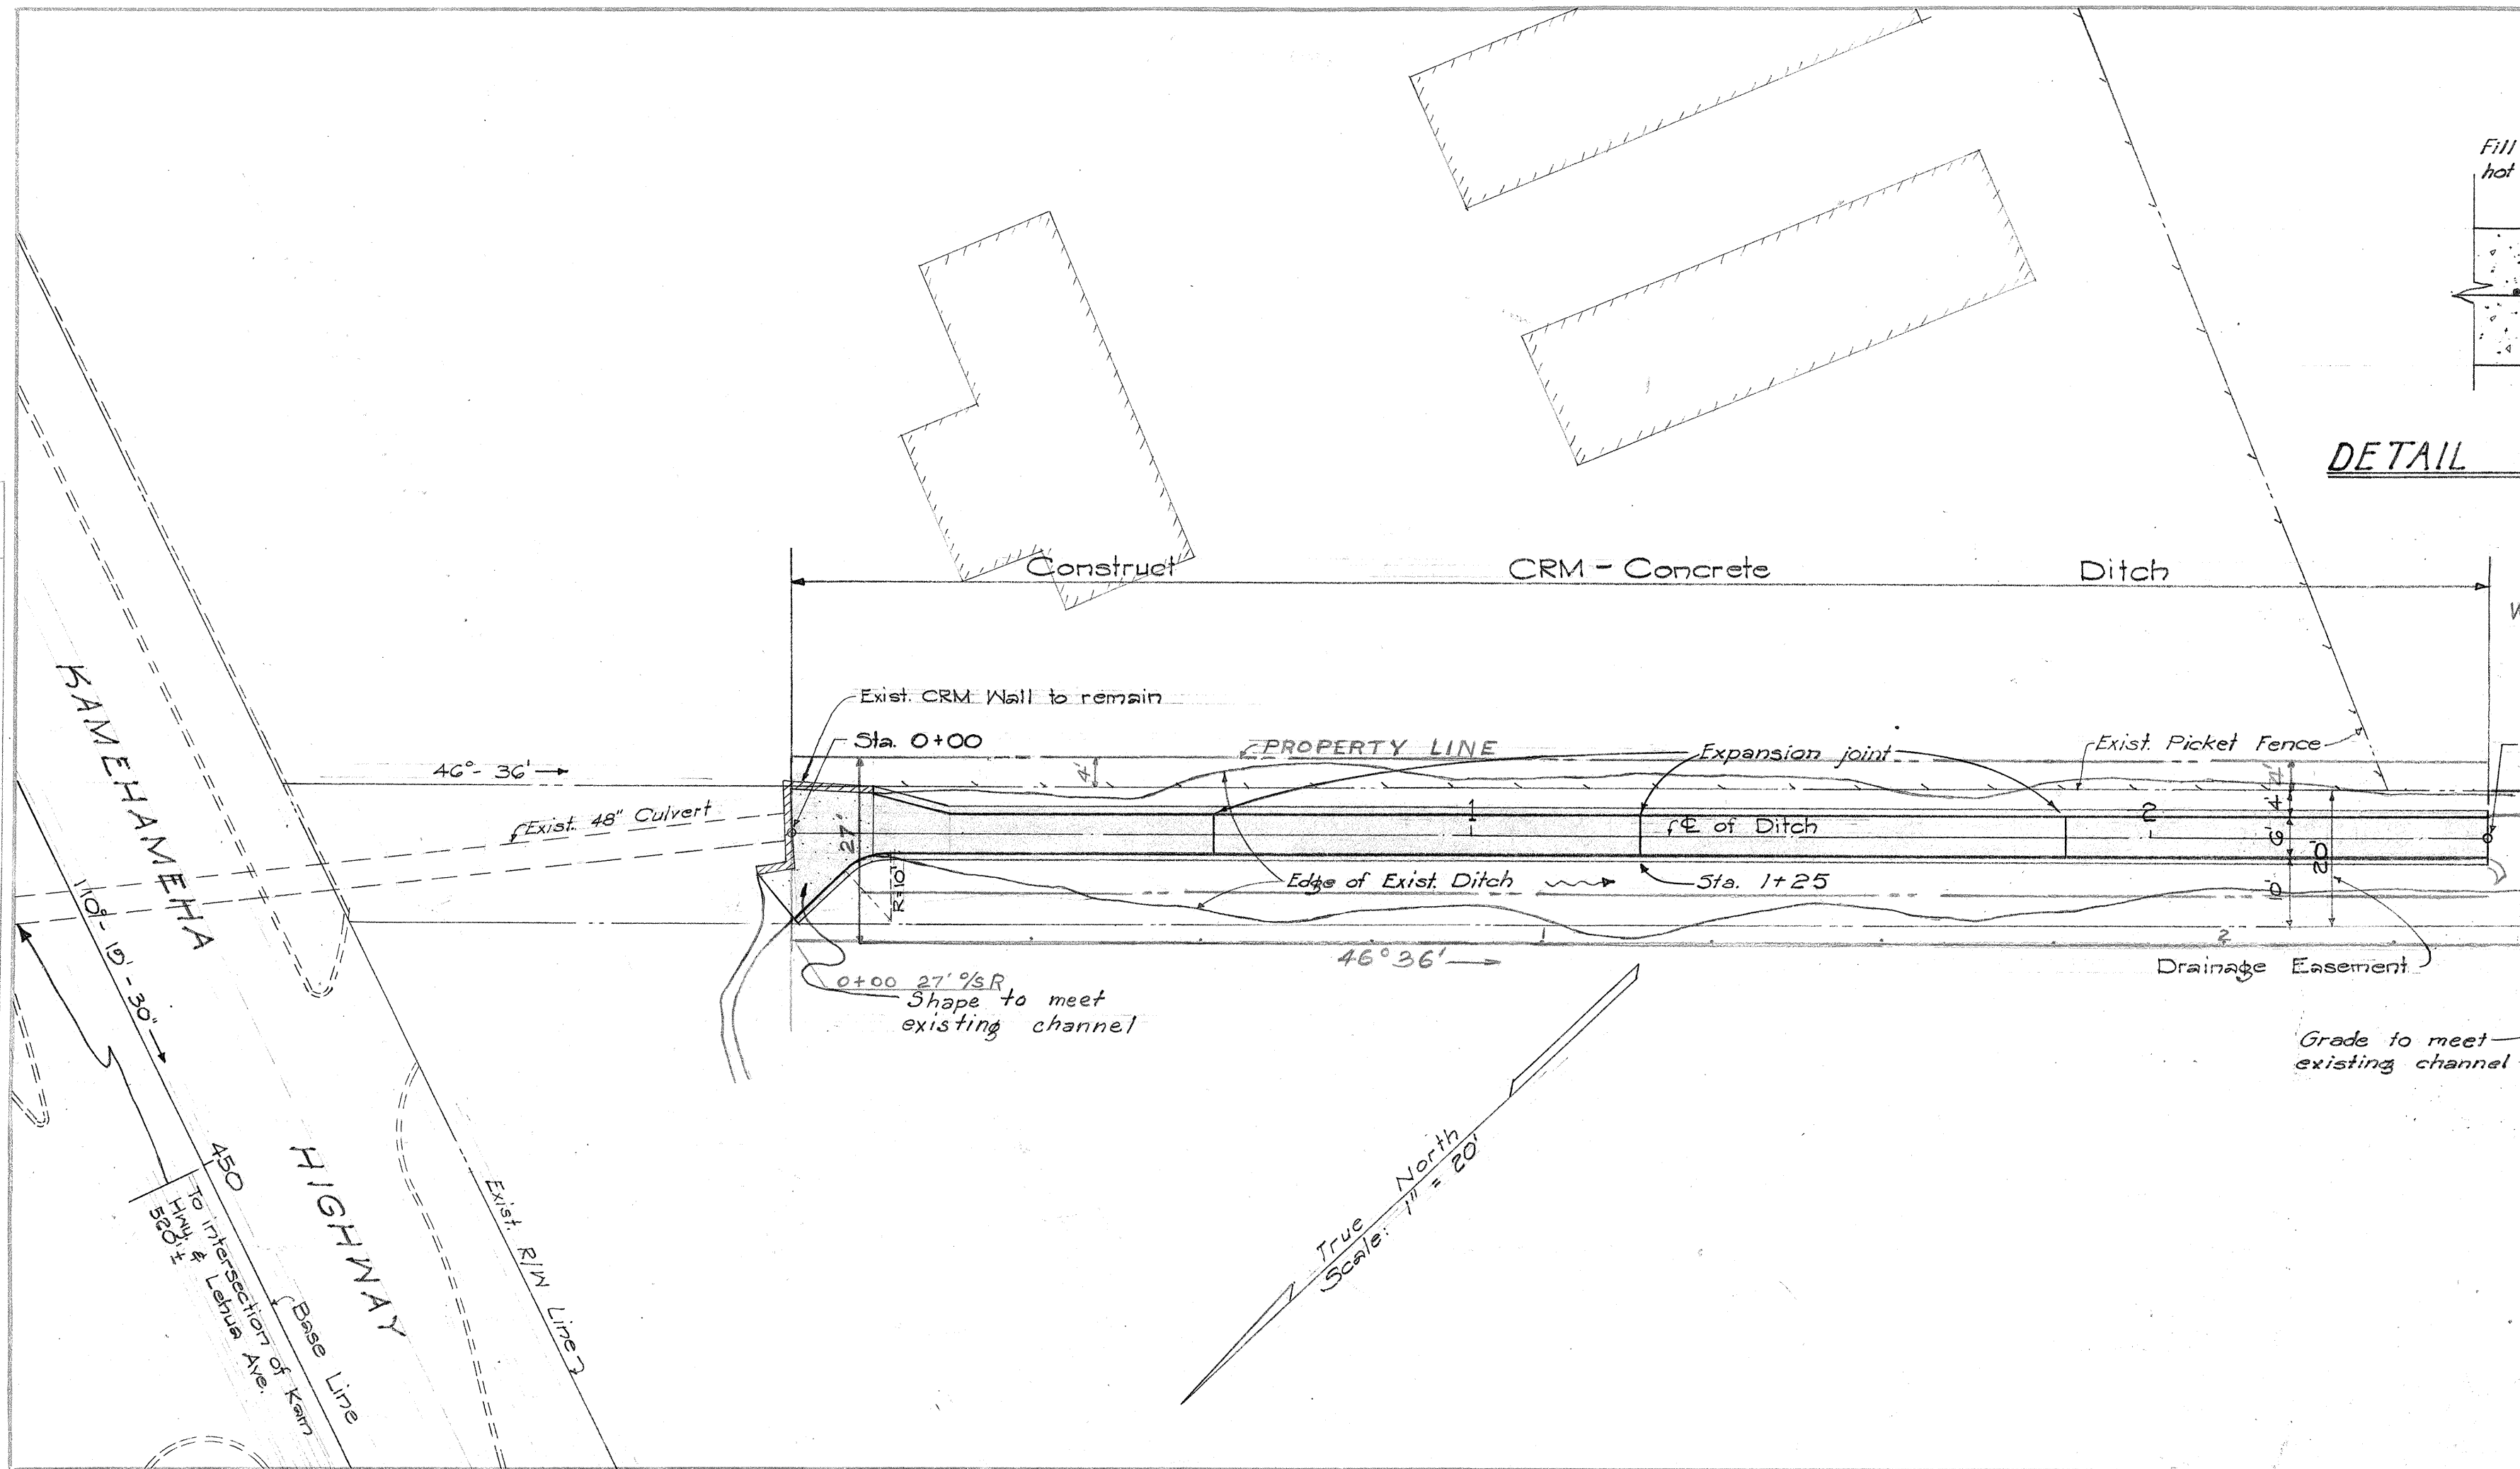

TERRITORIAL HIGHWAY DEPARTMENT
TERRITORY OF HAWAII
CRM-CONC. DITCH
LEFT OF
KAM HWY. Sta 450+00
Scale: As Noted
Sept, 1956