





Revised 10/16/56

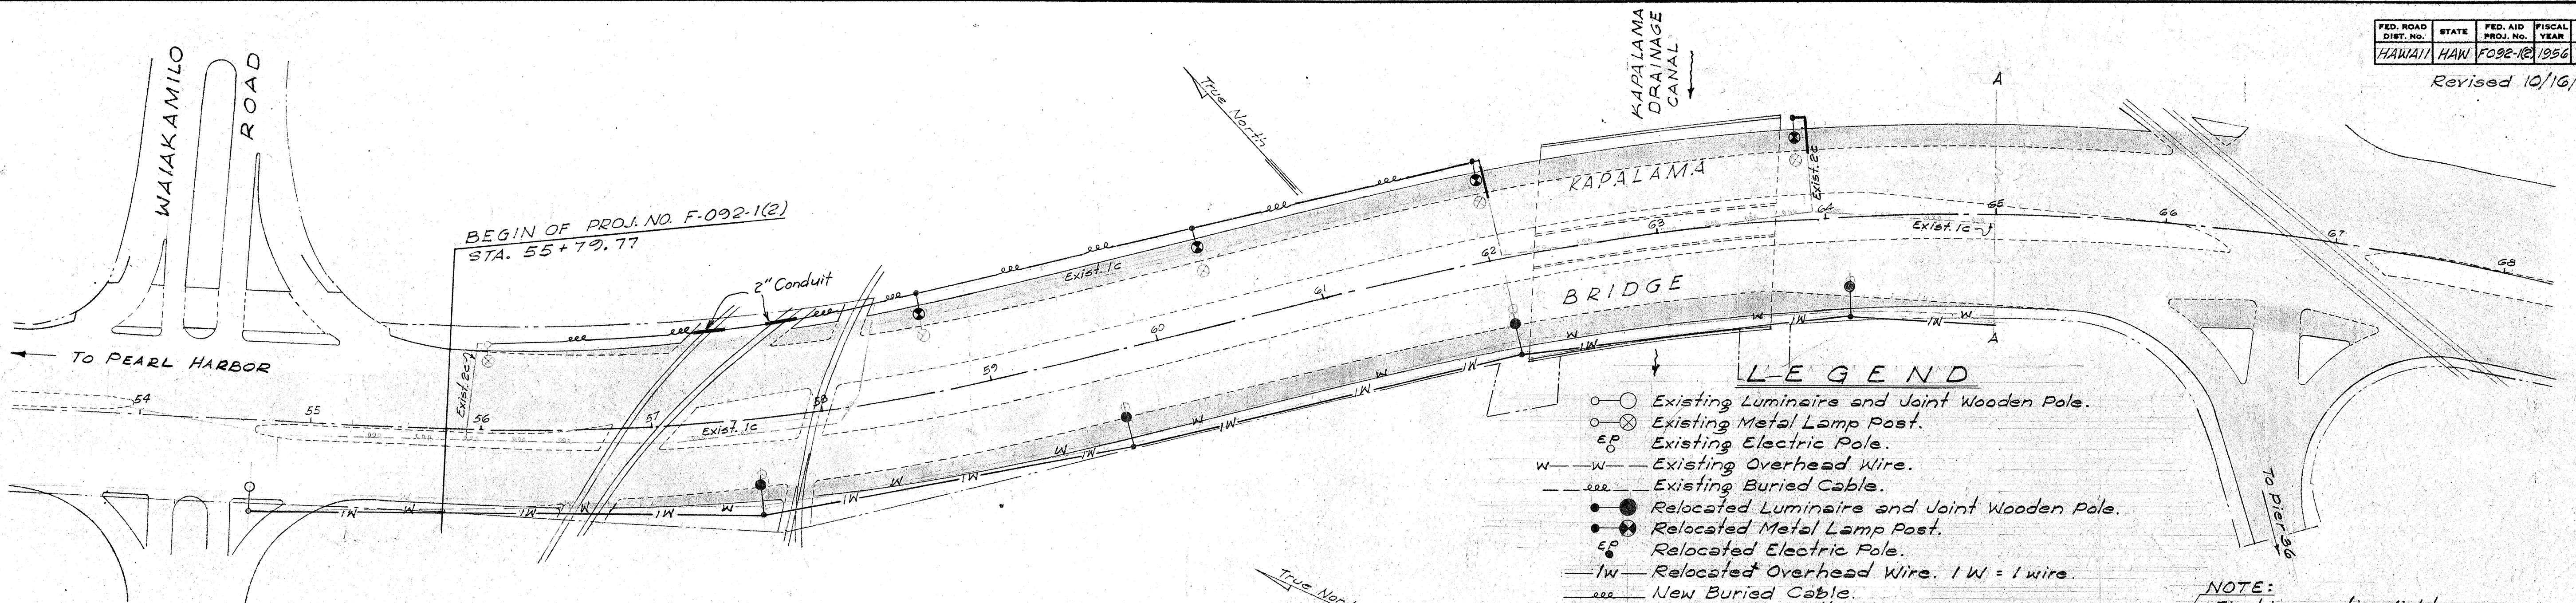

NOTE:
All buried cables installed between Sta. 56+00± (Left) and Sta. 79+25± (Right) shall be new. New locations of cables are shown above. Where new locations are not shown, the new cables shall be buried in the same approximate location as the existing cables, utilizing the existing conduits.

NOTE:
1. All cables under widened portion of roadway to be laid in 2" conduits.
2. Joint wooden poles to be moved by others.

END OF PROJ. NO. F-092-1(2) STA. 84+65.16

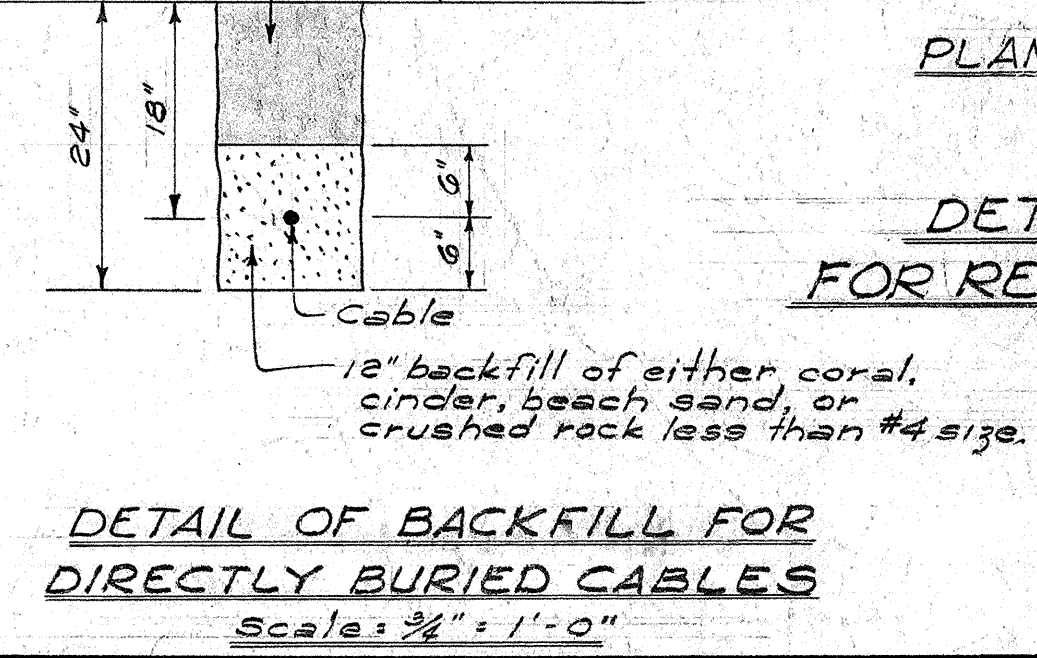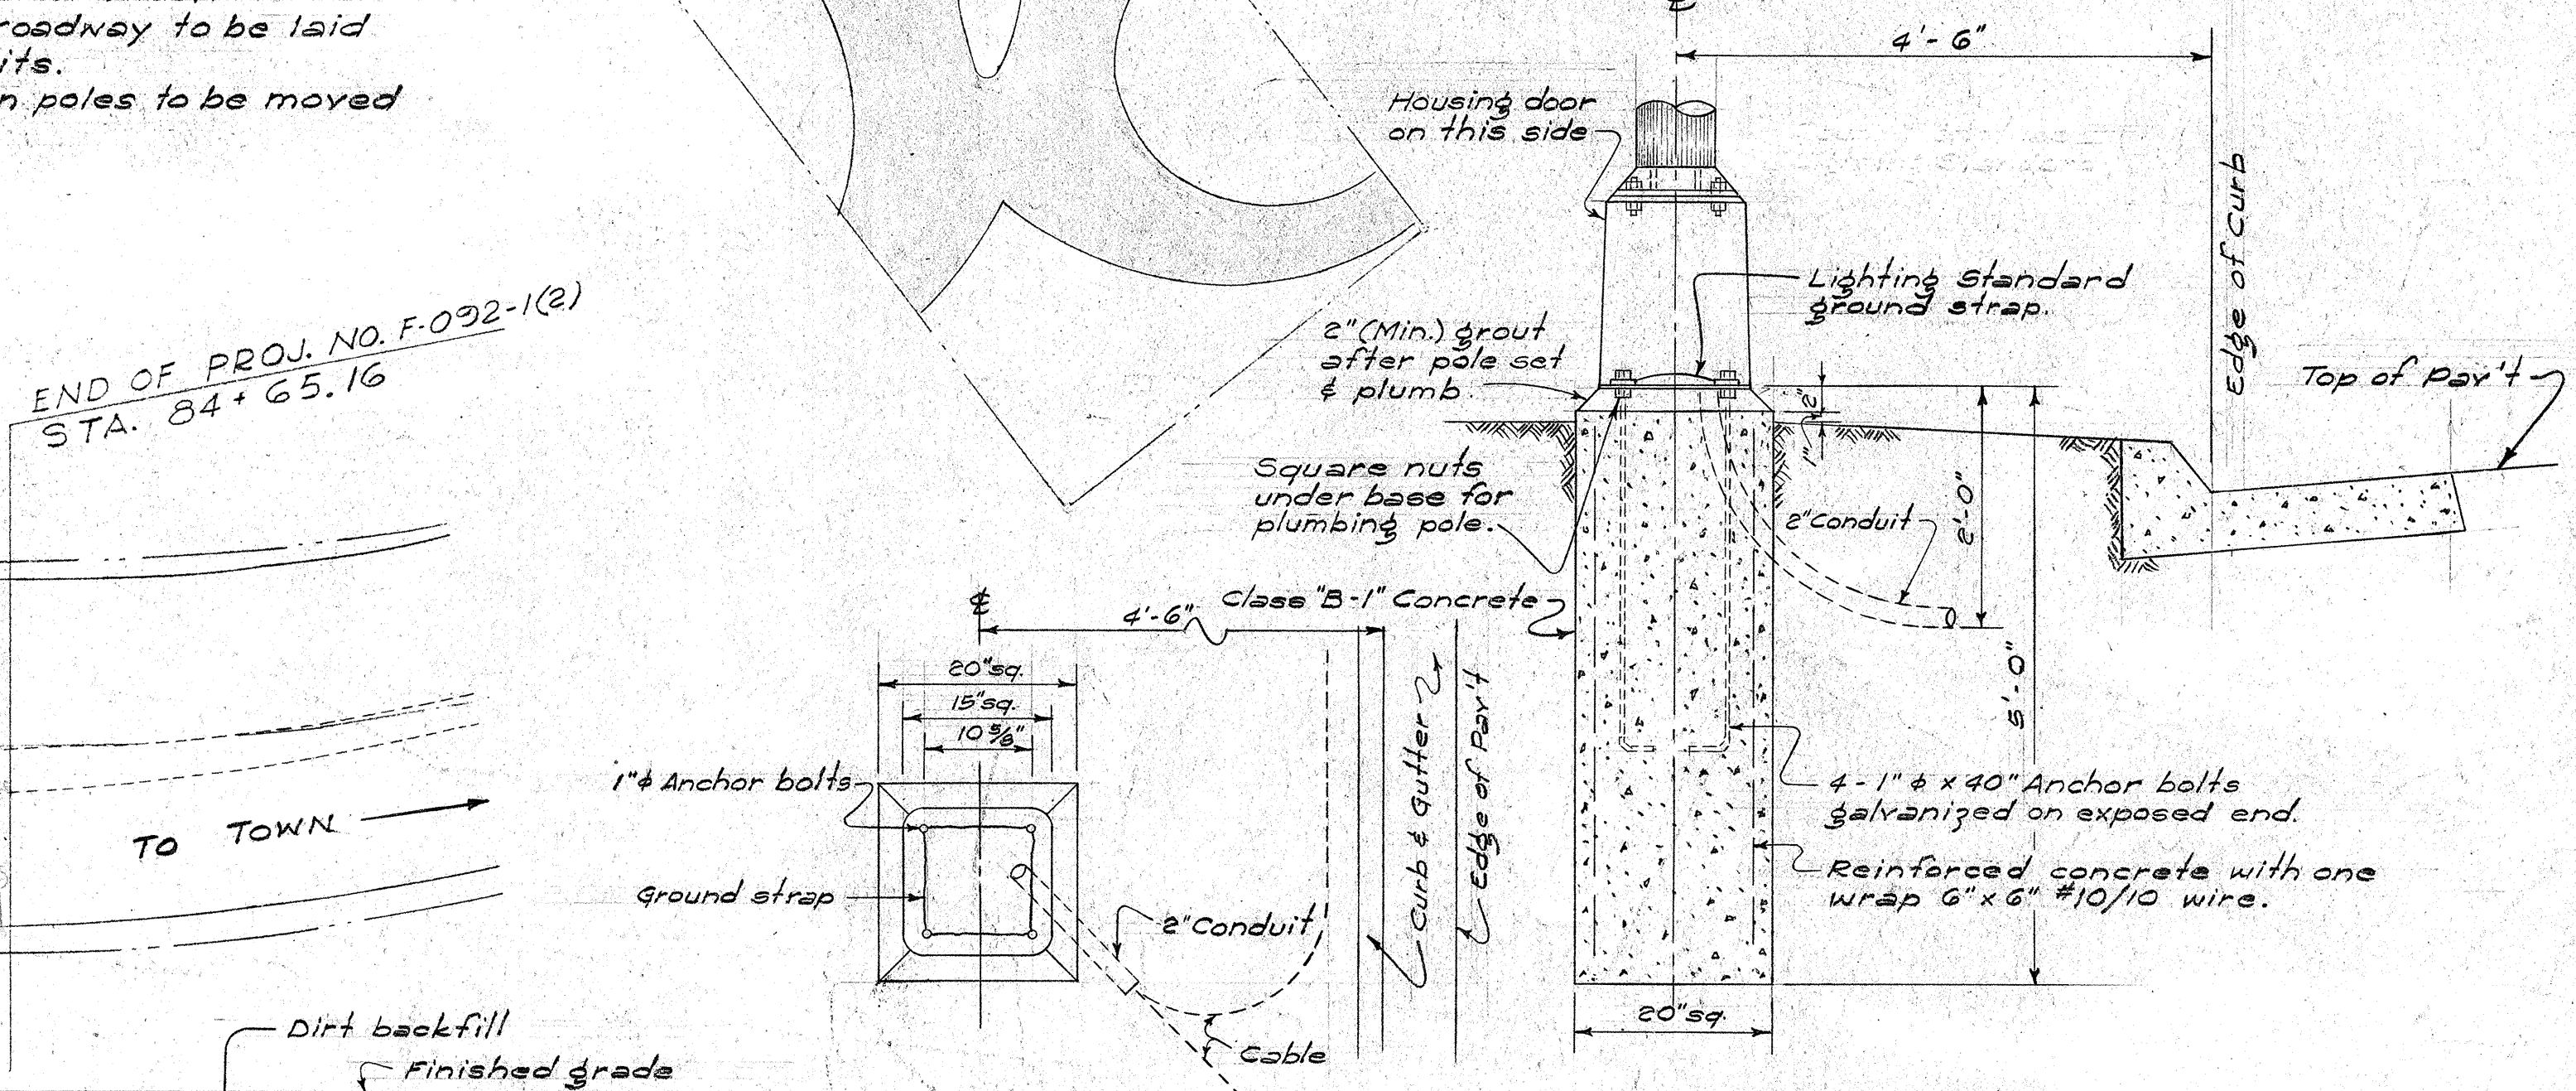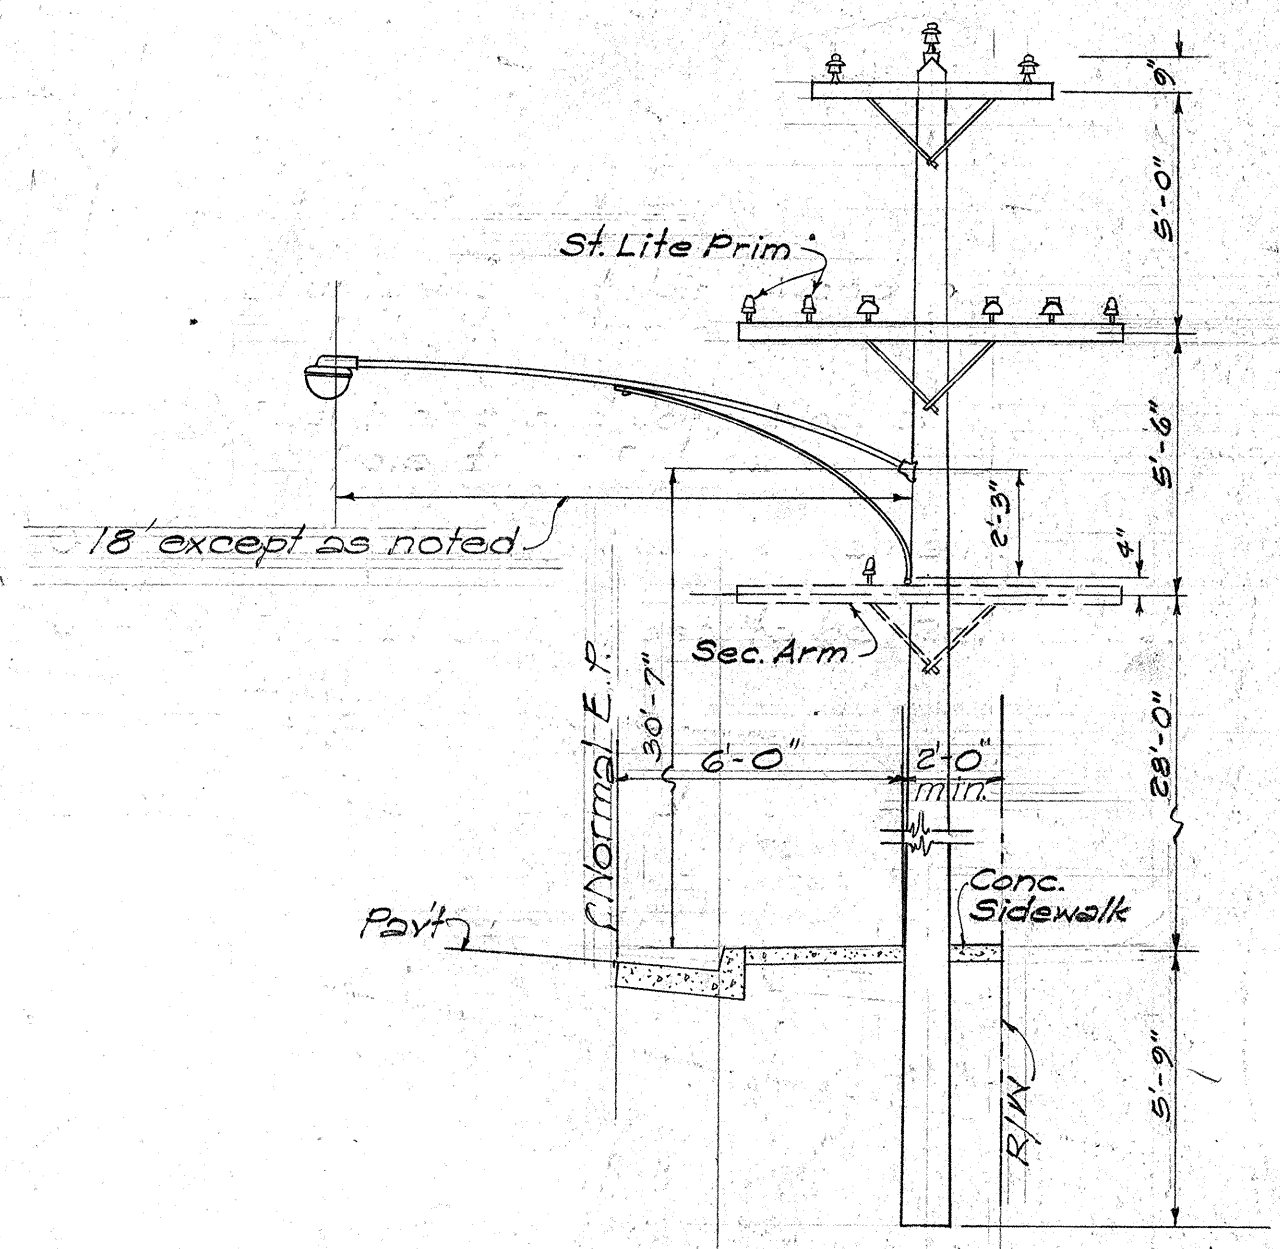

TERRITORIAL HIGHWAY DEPARTMENT
TERRITORY OF HAWAII
ALTERATION TO
HIGHWAY LIGHTING SYSTEM
HONOLULU - PEARL HARBOR ROAD
PROJECT NO. F-092-1(2)
Scale: 1" = 50' APR. 1956

SHEET NO. OF SHEETS