



FED. ROAD DIST. NO.	STATE	FED. AID PROJ. NO.	FISCAL YEAR	SHEET NO.	TOTAL SHEETS
HAWAII	HAW.	F092-1(2)	1996	3	36


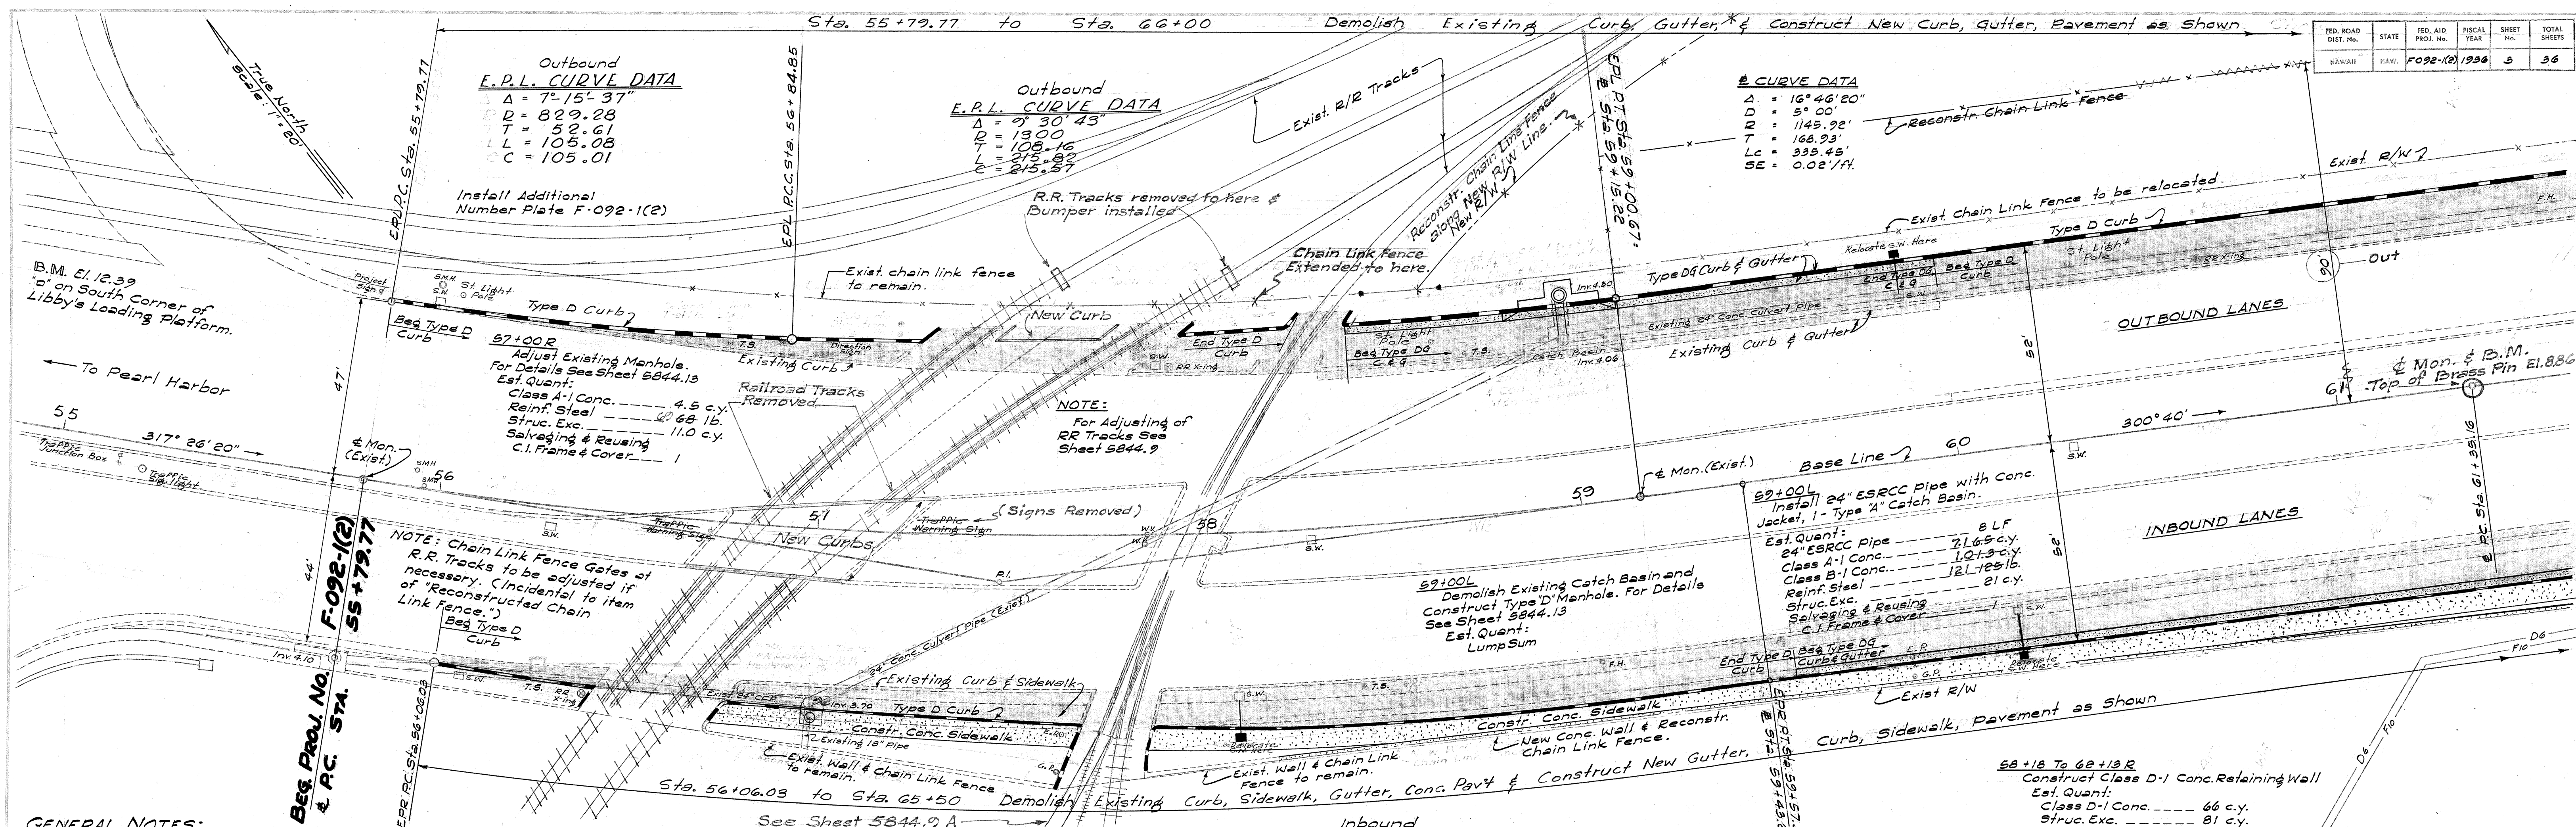


GENERAL NOTES:

1. Azimuths are referred to Punchbowl Triangulation Station.
2. Datum-Elevation referred to Mean Sea Level.
3. Demolishing of existing Curbs, Sidewalk, Gutters, Concrete Pavements, Drainage Structures, etc., is incidental to Unclassified Excavation.
4. Transitions between new and existing Curbs, and Curb and Gutters shall be smooth and pleasing to the eye.
5. Contractor to reset existing Concrete Oil Line Markers that is disturbed during construction. (Incidental to Unclassified Excavation.)
6. For alteration or relocation of Utilities, see their respective sheet.

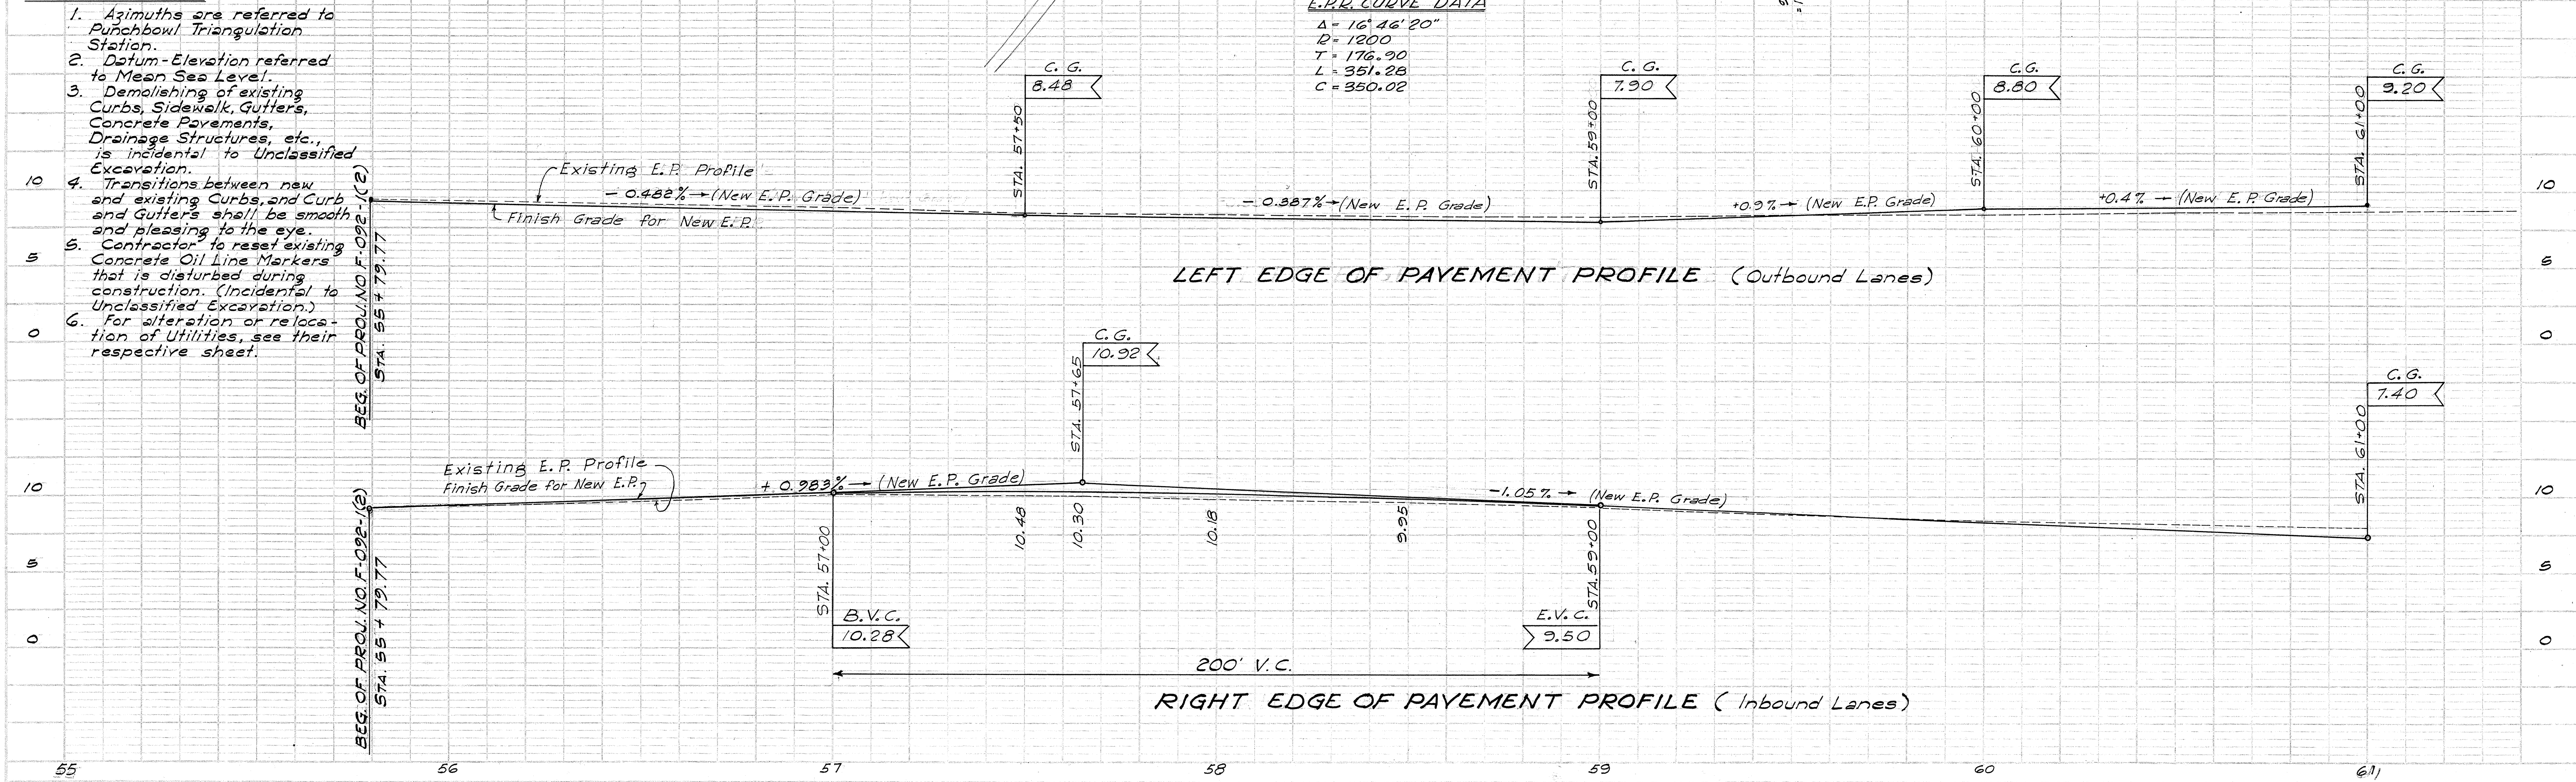



FED. ROAD DIST. NO.	STATE	FED. AID PROJ. NO.	FISCAL YEAR	SHEET NO.	TOTAL SHEETS
HAWAII	HAW.	F02E-102	1956	4	36

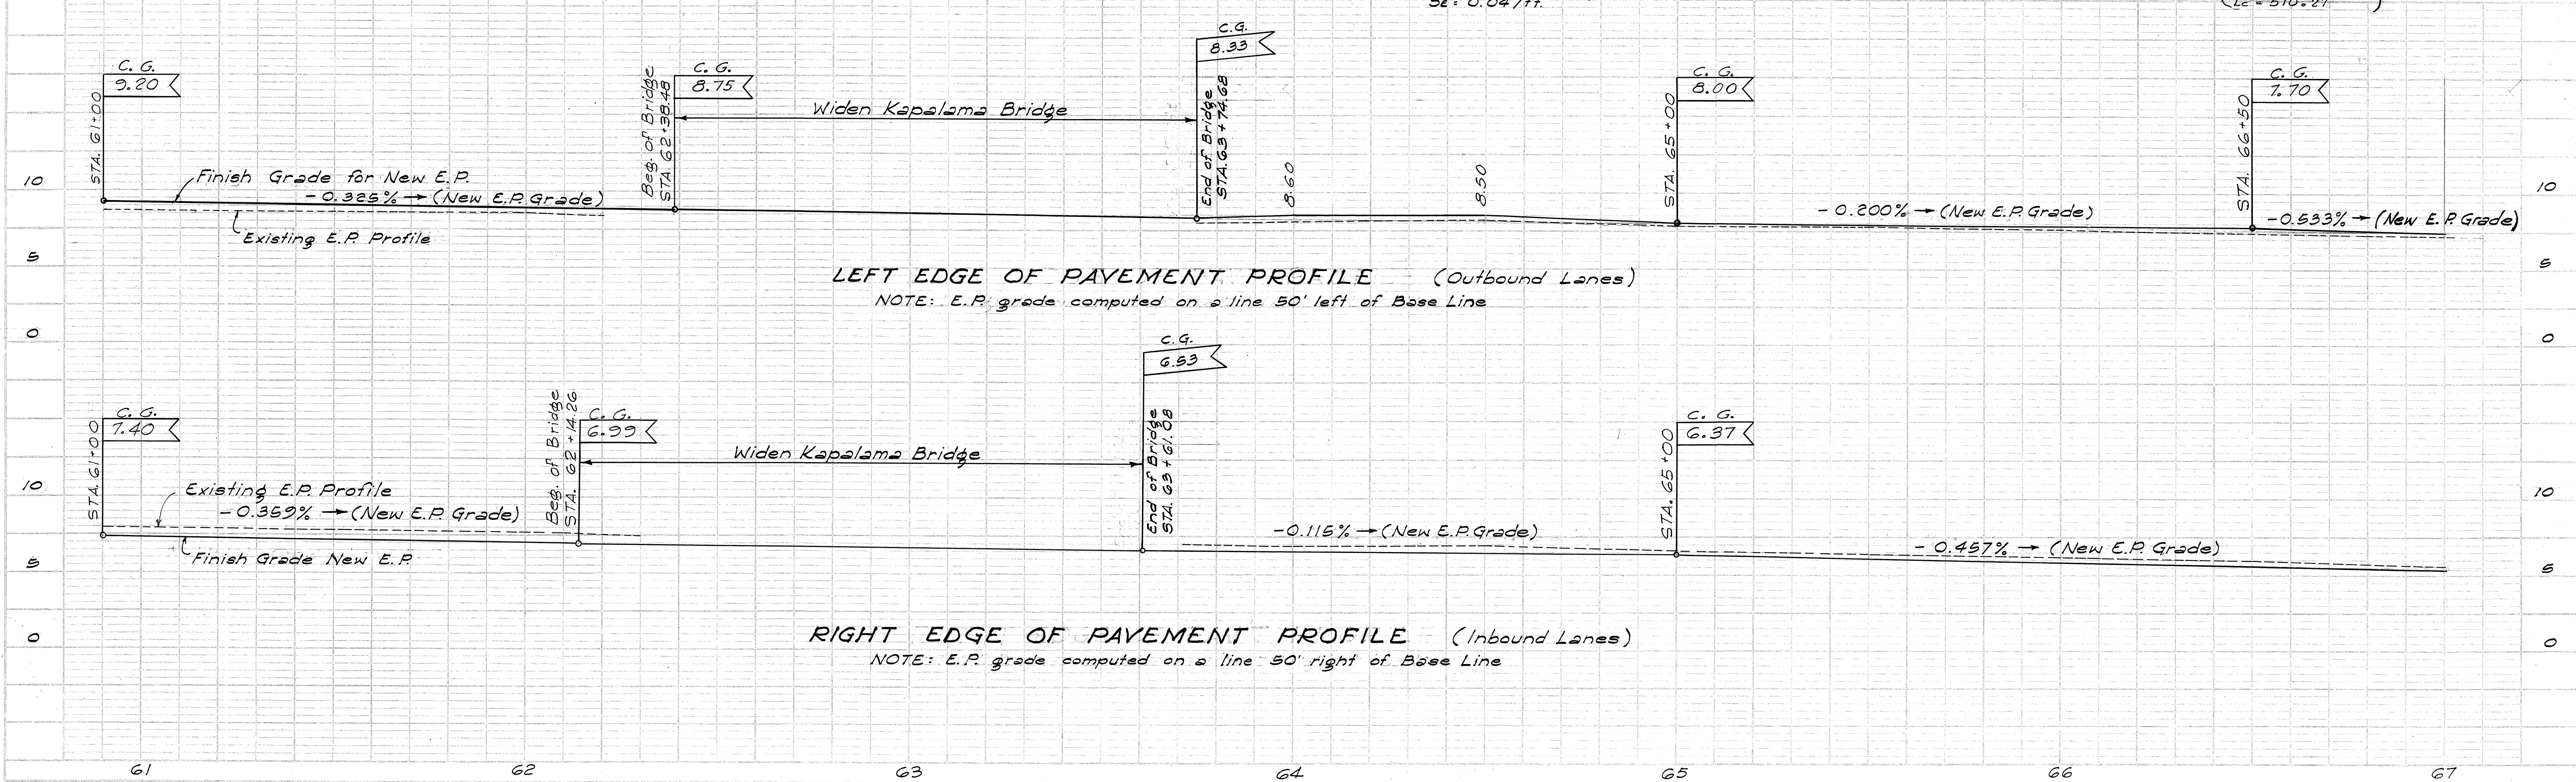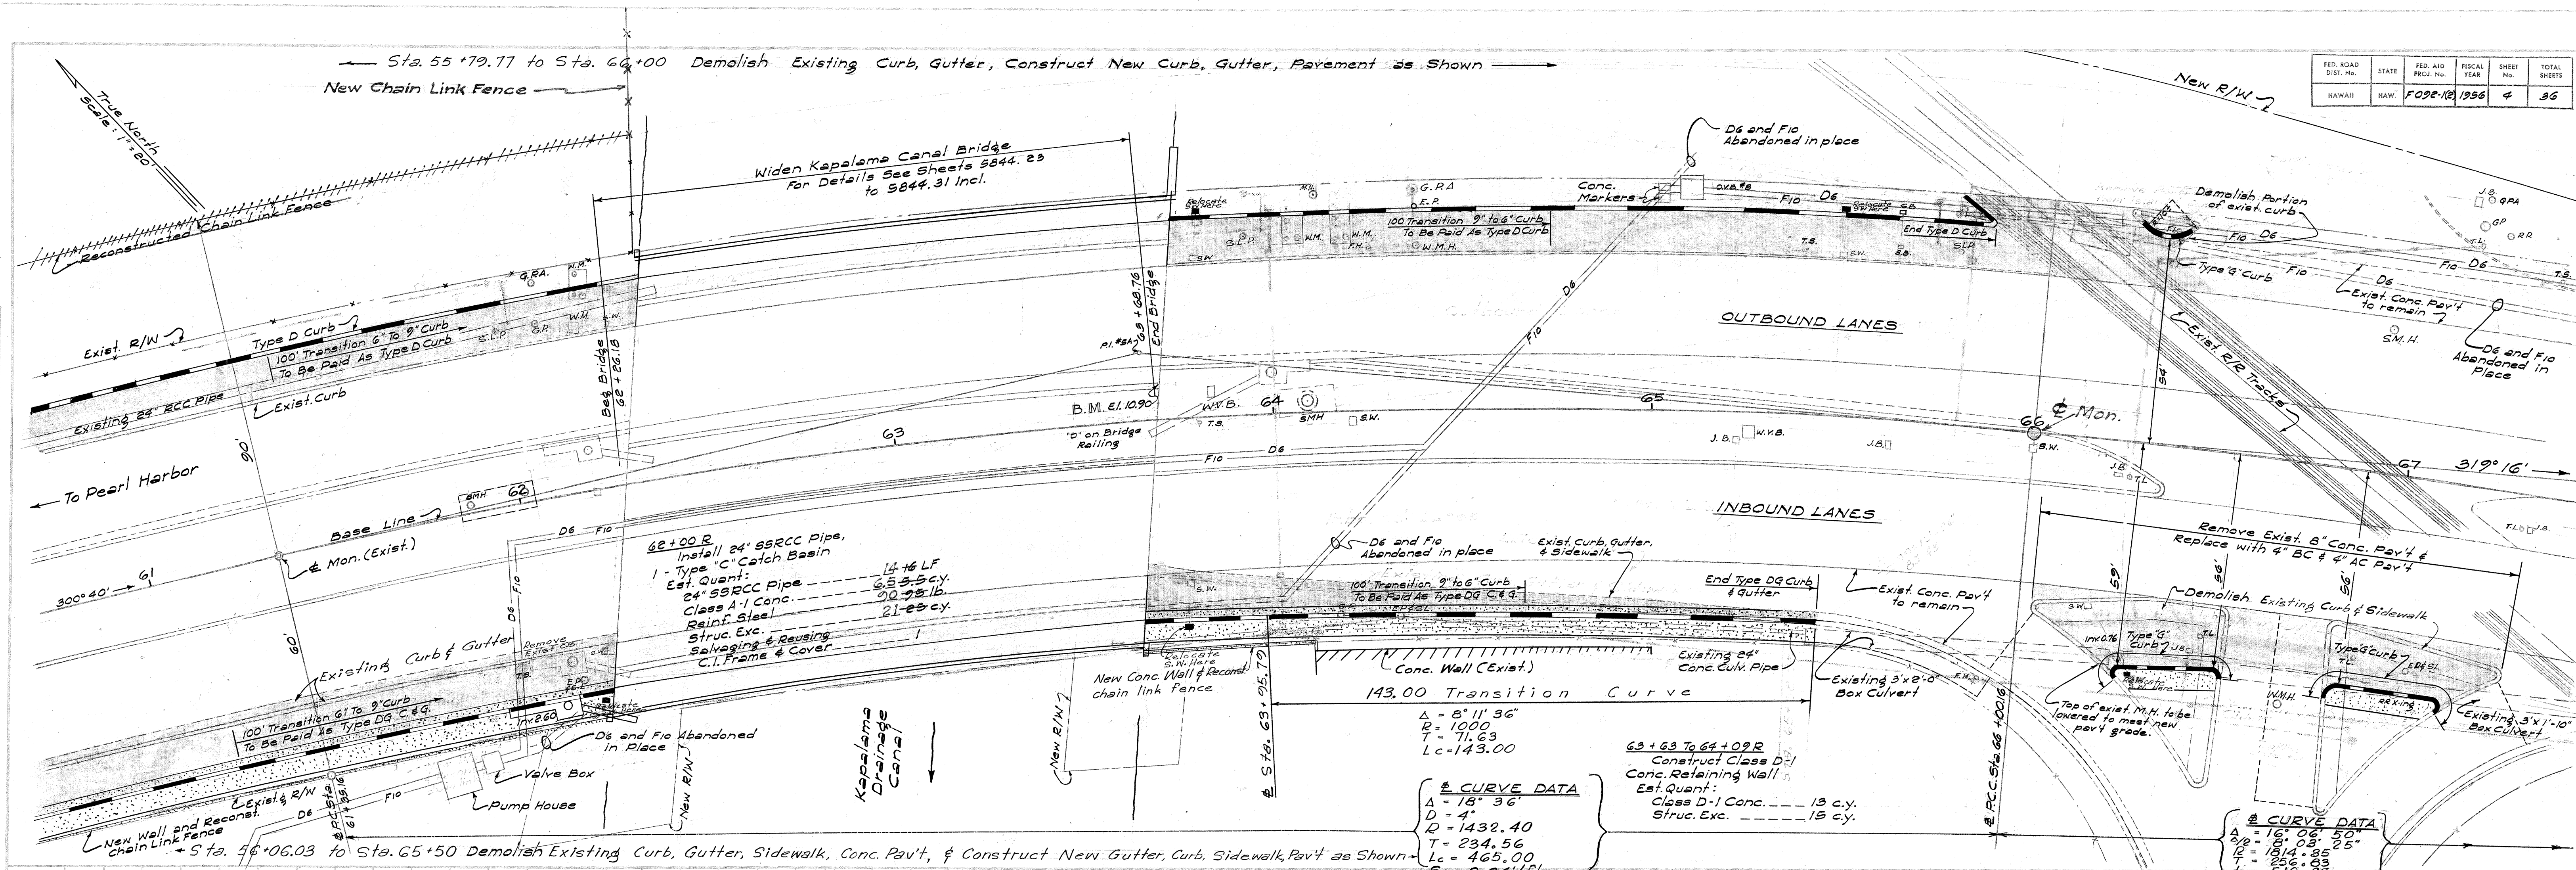

PLAN	SURVEYED	DATE
NO.	BY	
NOTE BOOK	PLOTTED	
NO.	DATE	
NO.	DATE	
NO.	DATE	

PROFILE	SURVEYED	DATE
NO.	BY	
NOTE BOOK	PLOTTED	
NO.	DATE	
NO.	DATE	
NO.	DATE	



FED. ROAD DIST. No.	STATE	FED. AID PROJ. No.	FISCAL YEAR	SHEET No.	TOTAL SHEETS
HAWAII	HAW.	F092-12	1956	6	36

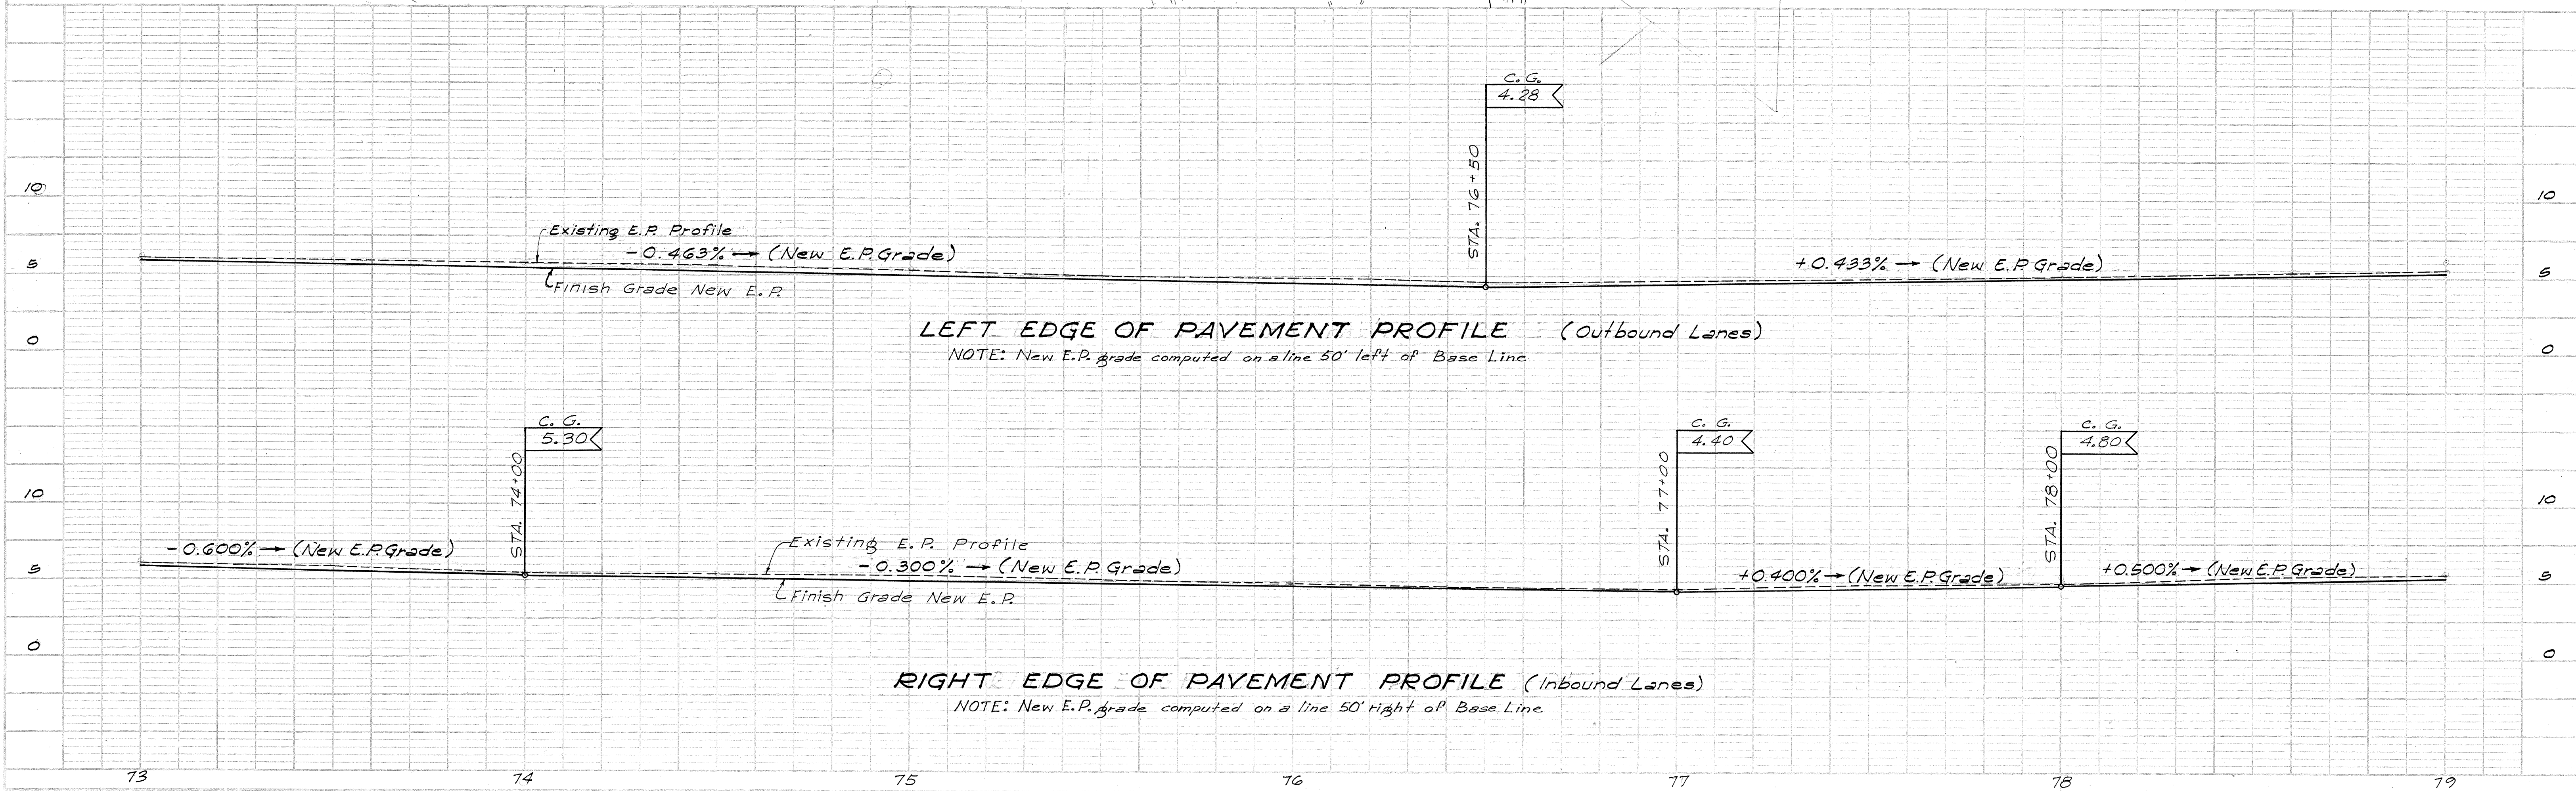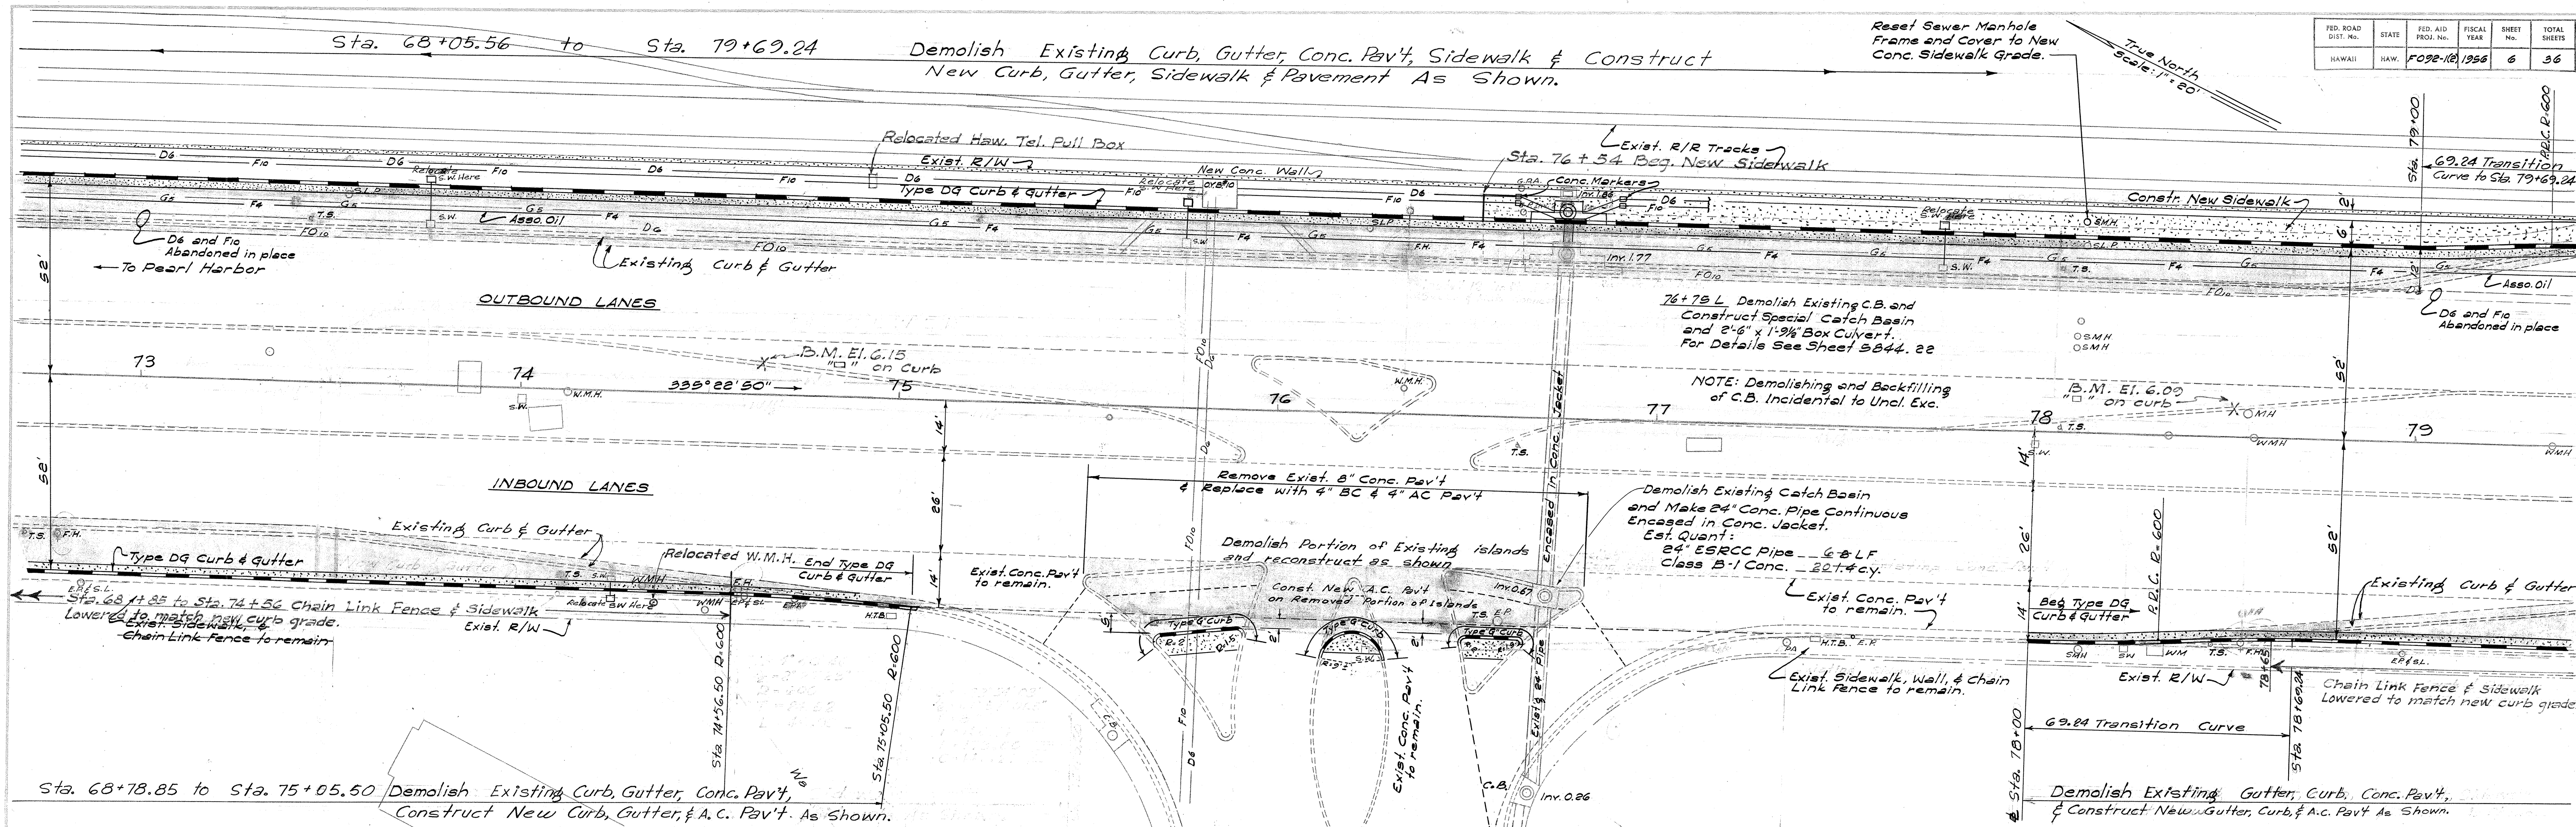

FED. ROAD DIST. No.	STATE	FED. AID PROJ. No.	FISCAL YEAR	SHEET No.	TOTAL SHEETS
HAWAII	HAW.	F092-1(2)	1996	7	36

Install Additional Number Plate F-092-1(2)

END PROJECT NO. F-092-1(2) Beg. Proj. 444(3) STA. 84+65.16

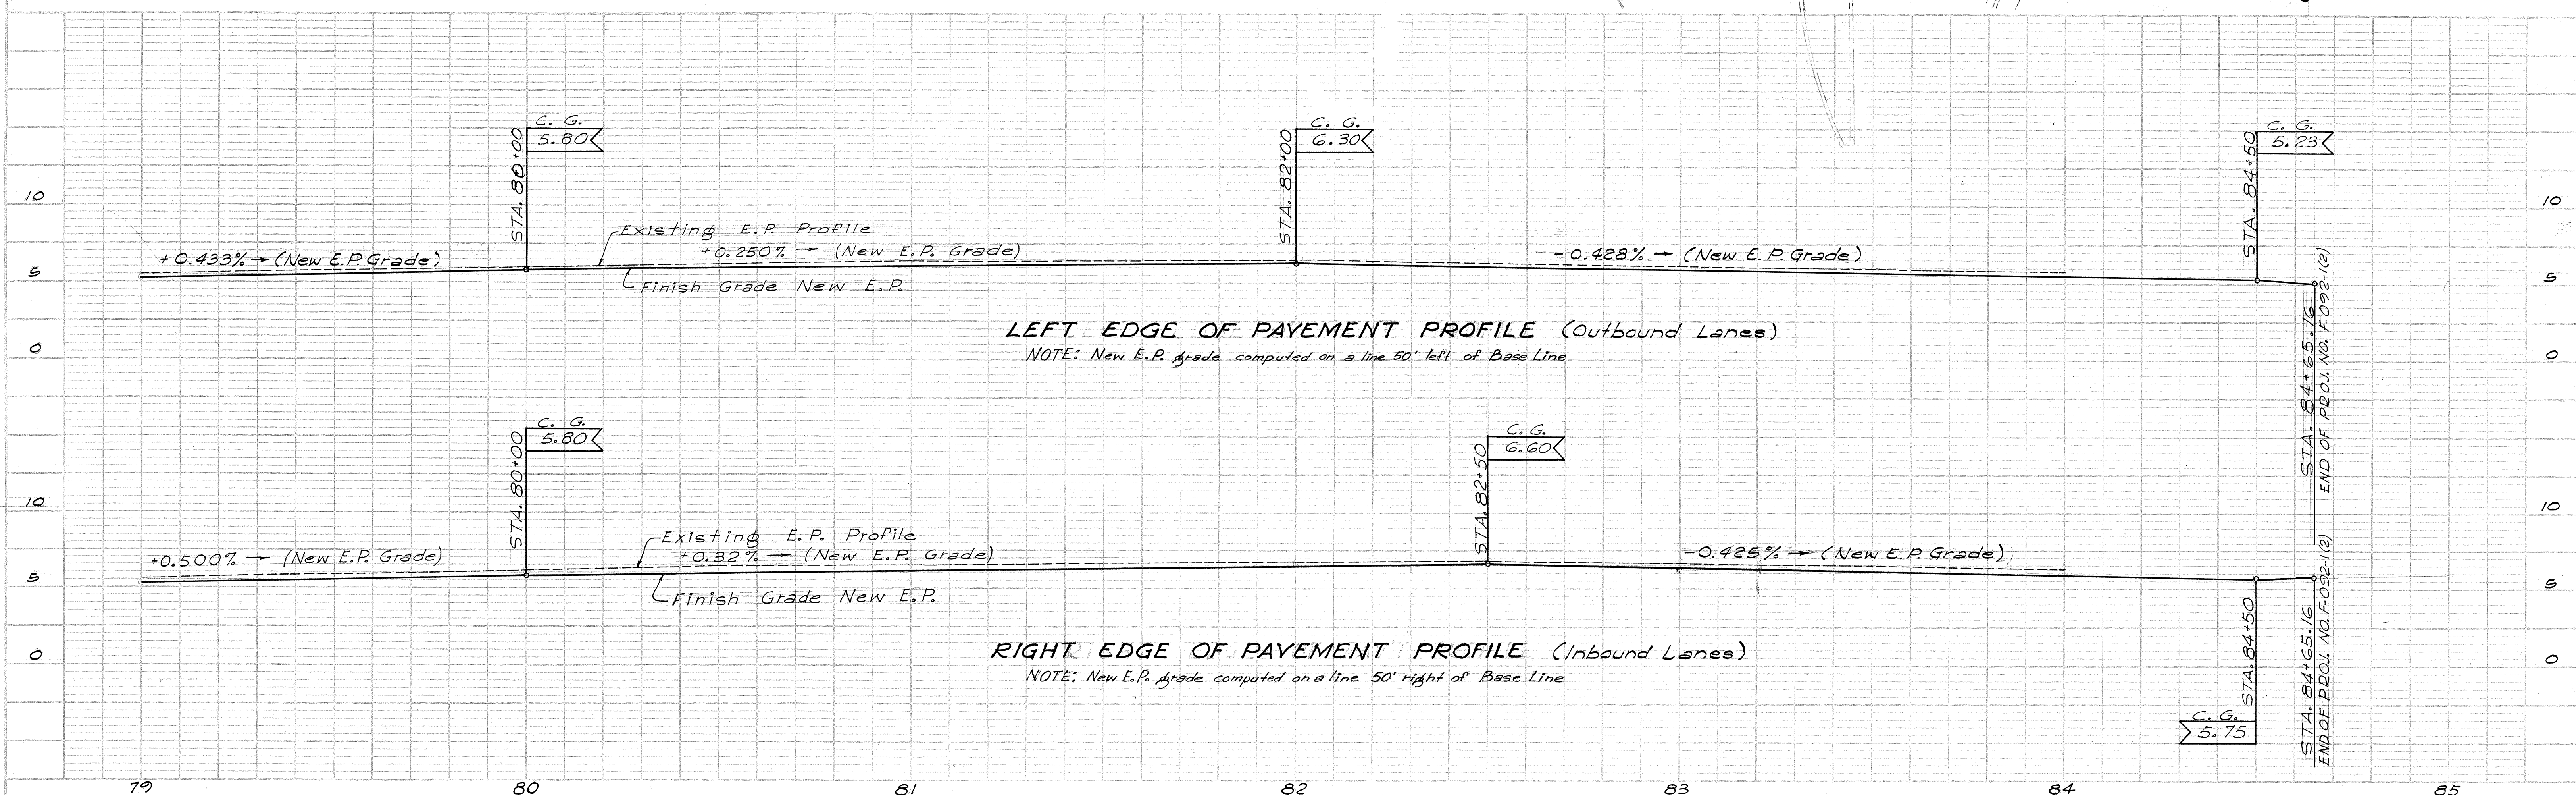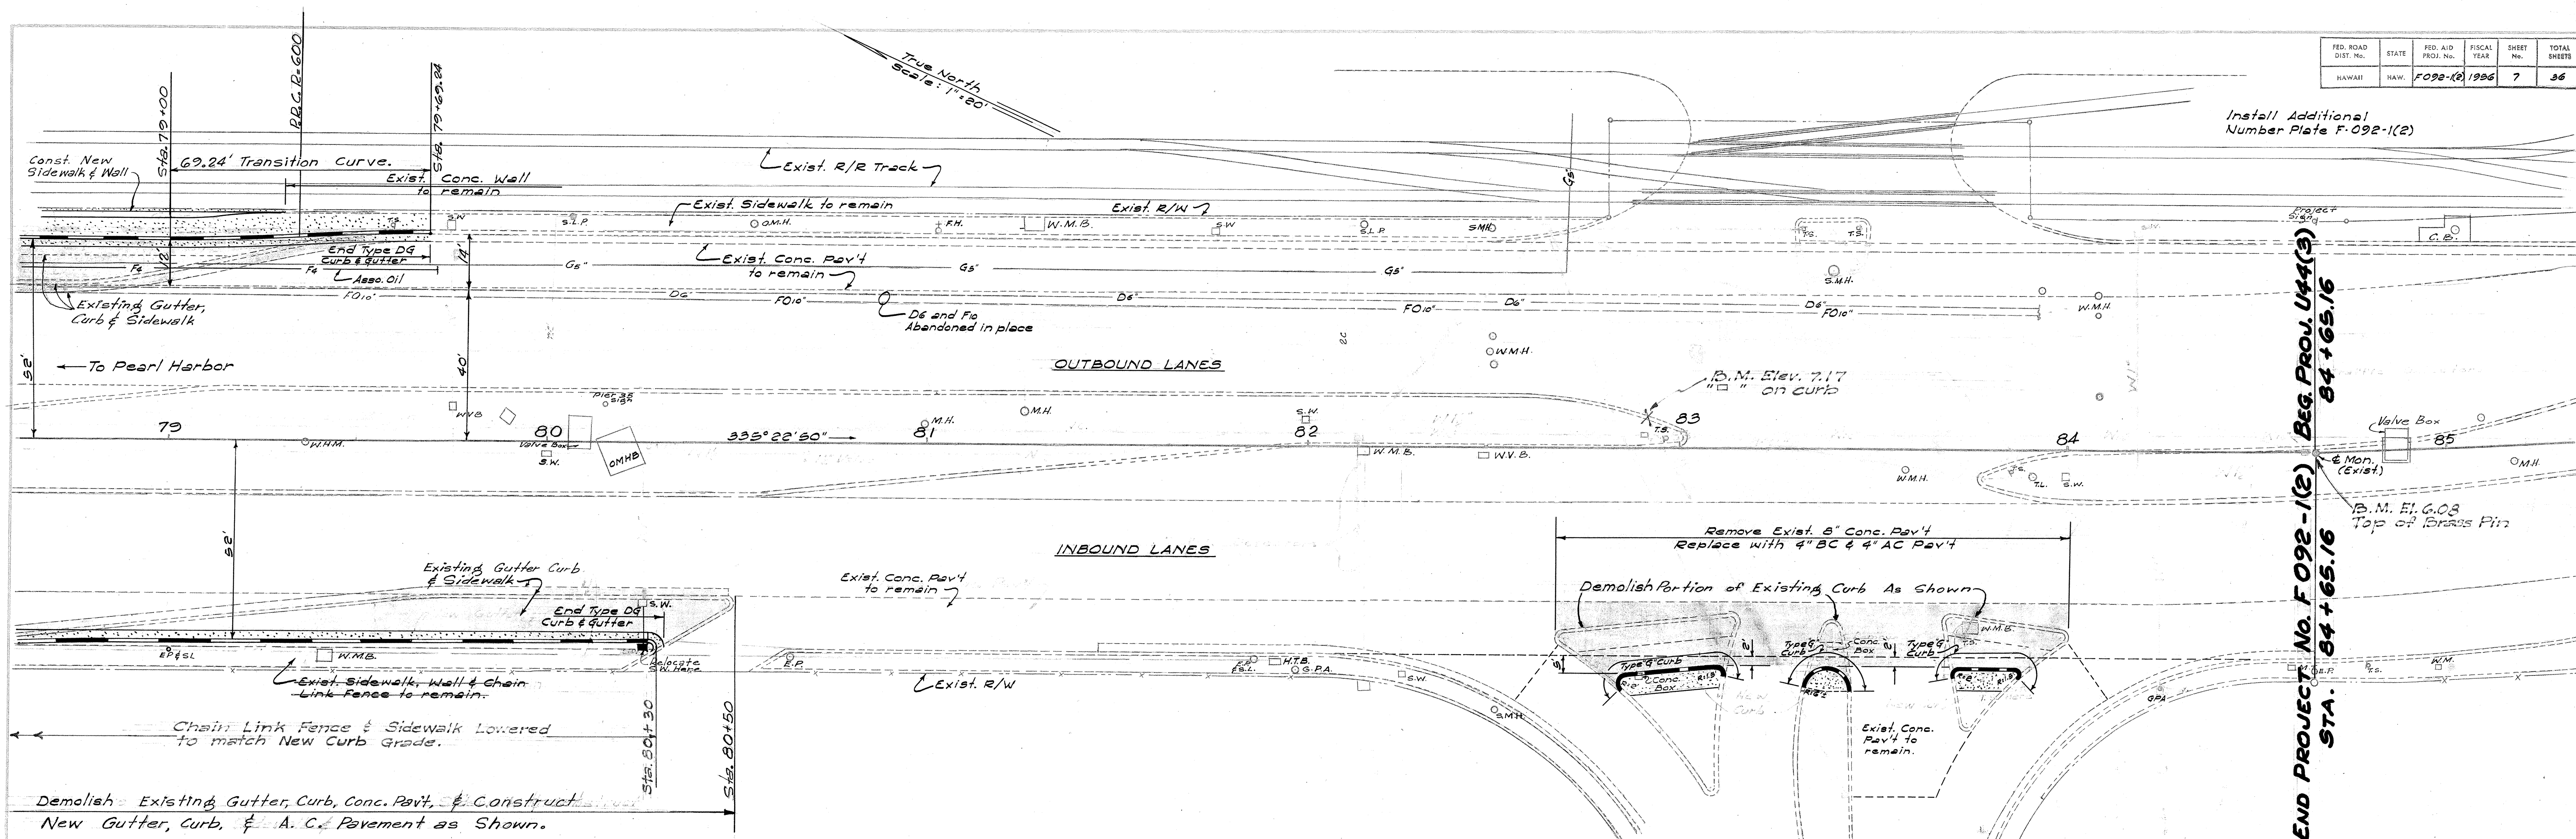

5844.7