


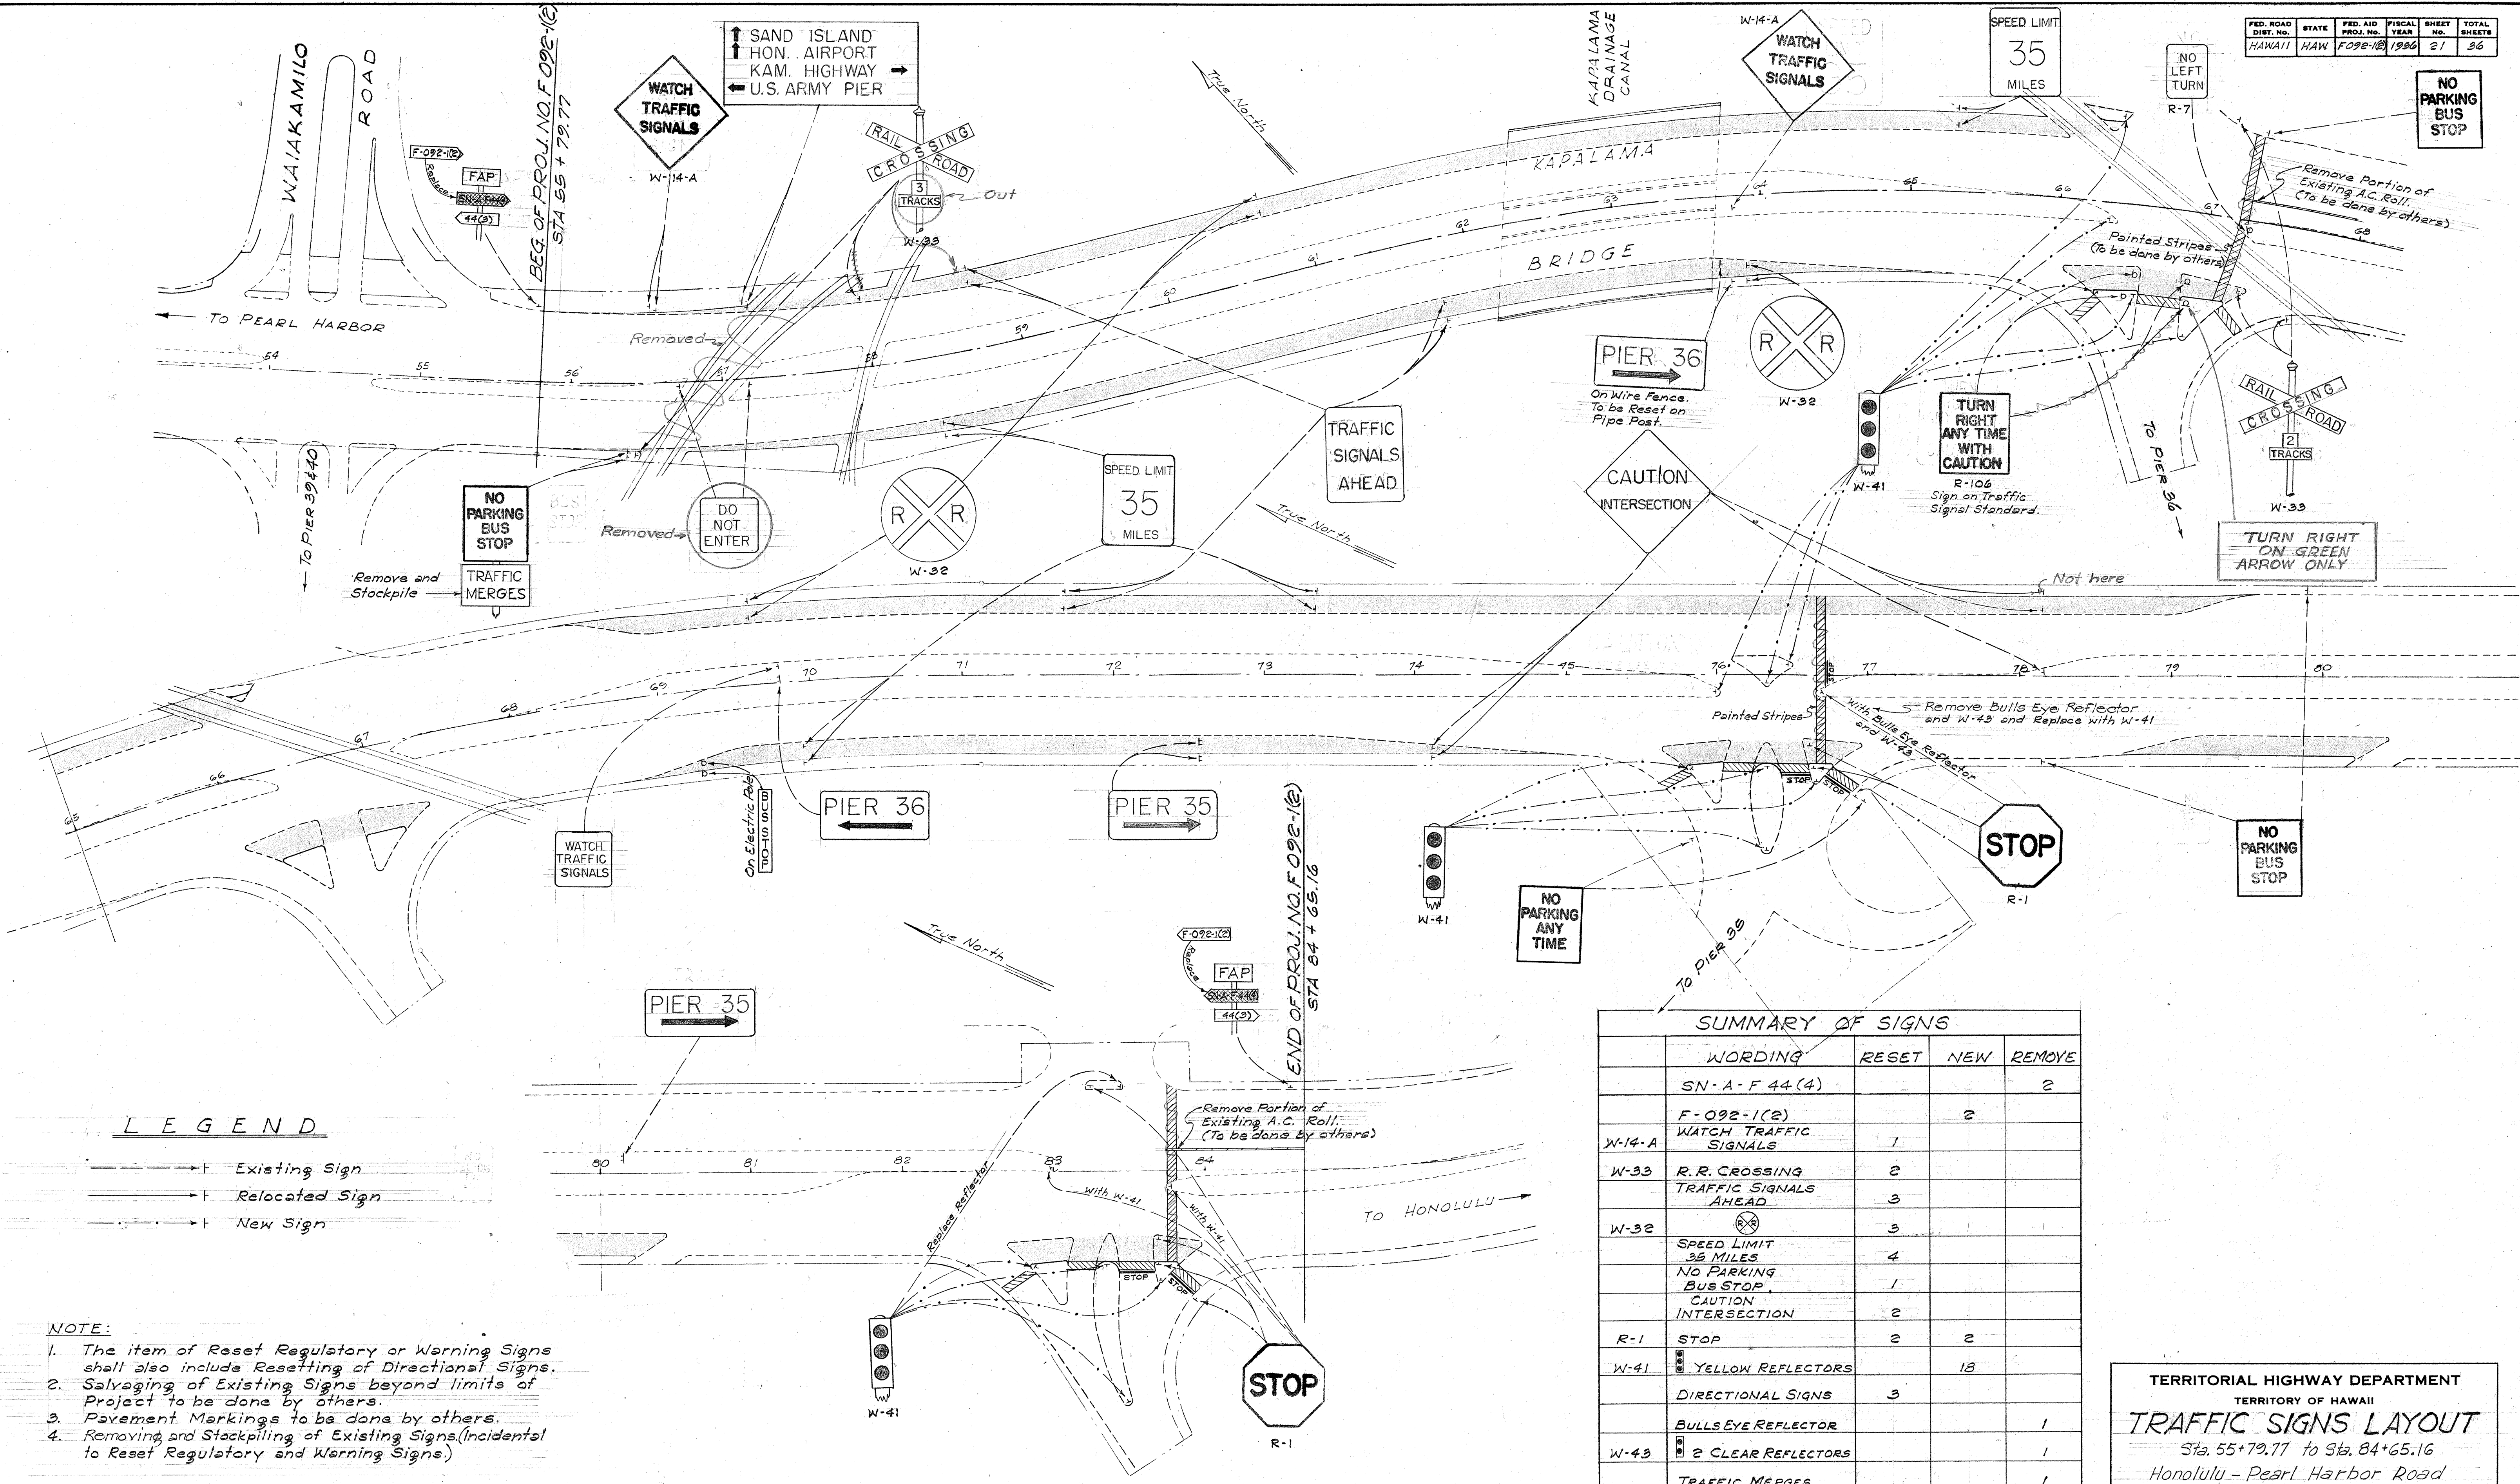

LEGEND

- Existing Sign
- Relocated Sign
- New Sign

NOTE:

- The item of Reset Regulatory or Warning Signs shall also include Resetting of Directional Signs.
- Salvaging of Existing Signs beyond limits of Project to be done by others.
- Pavement Markings to be done by others.
- Removing and Stockpiling of Existing Signs (Incidental to Reset Regulatory and Warning Signs).

SUMMARY OF SIGNS				
	WORDING	RESET	NEW	REMOVE
	SN-A-F 44(4)			2
	F-092-1(2)		2	
W-14-A	WATCH TRAFFIC SIGNALS	1		
W-33	R.R. CROSSING TRAFFIC SIGNALS AHEAD	2		
W-32	CAUTION INTERSECTION	3		
	SPEED LIMIT 35 MILES	4		
	NO PARKING BUS STOP	1		
	STOP	2	2	
W-41	YELLOW REFLECTORS		18	
	DIRECTIONAL SIGNS	3		
W-43	BULLS EYE REFLECTOR			1
	2 CLEAR REFLECTORS			1
	TRAFFIC MERGES			1
	BUS STOP TURN RIGHT ANYTIME WITH CAUTION	1		
R-106	TURN RIGHT ANYTIME WITH CAUTION	2		
TOTALS		24	22	5

TERRITORIAL HIGHWAY DEPARTMENT
TERRITORY OF HAWAII
TRAFFIC SIGNS LAYOUT
Sta. 55+79.77 to Sta. 84+65.16
Honolulu - Pearl Harbor Road
Project No. F-092-1(2)
Scale: 1"=50' Date: 7-11-56