



HEIGHT OF FILL	FILL SLOPE
0' - 4'	4:1
4' - 10'	3:1

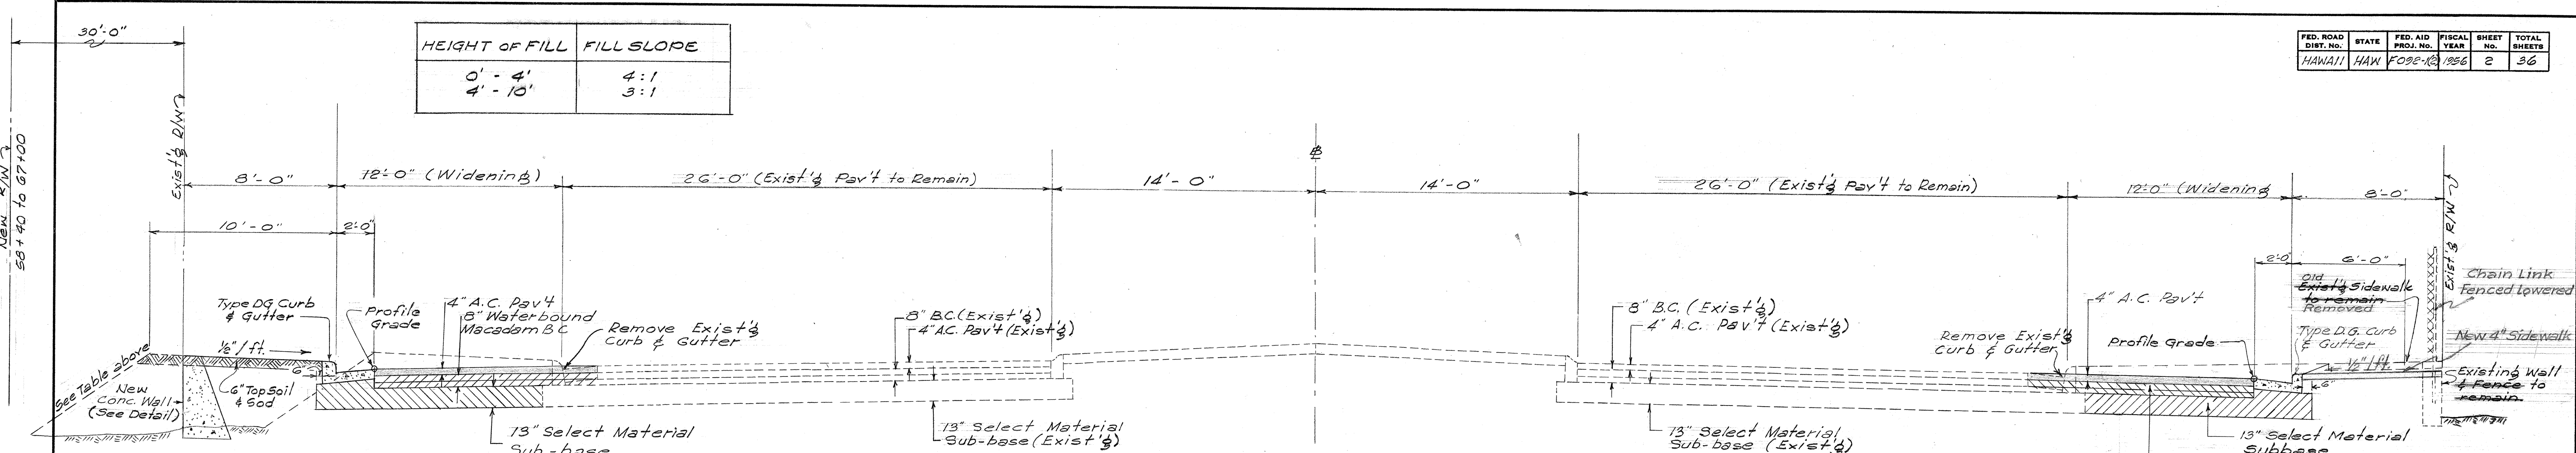


TYPICAL ROAD SECTION ON TANGENTS
Scale: 1/4" = 1'-0"

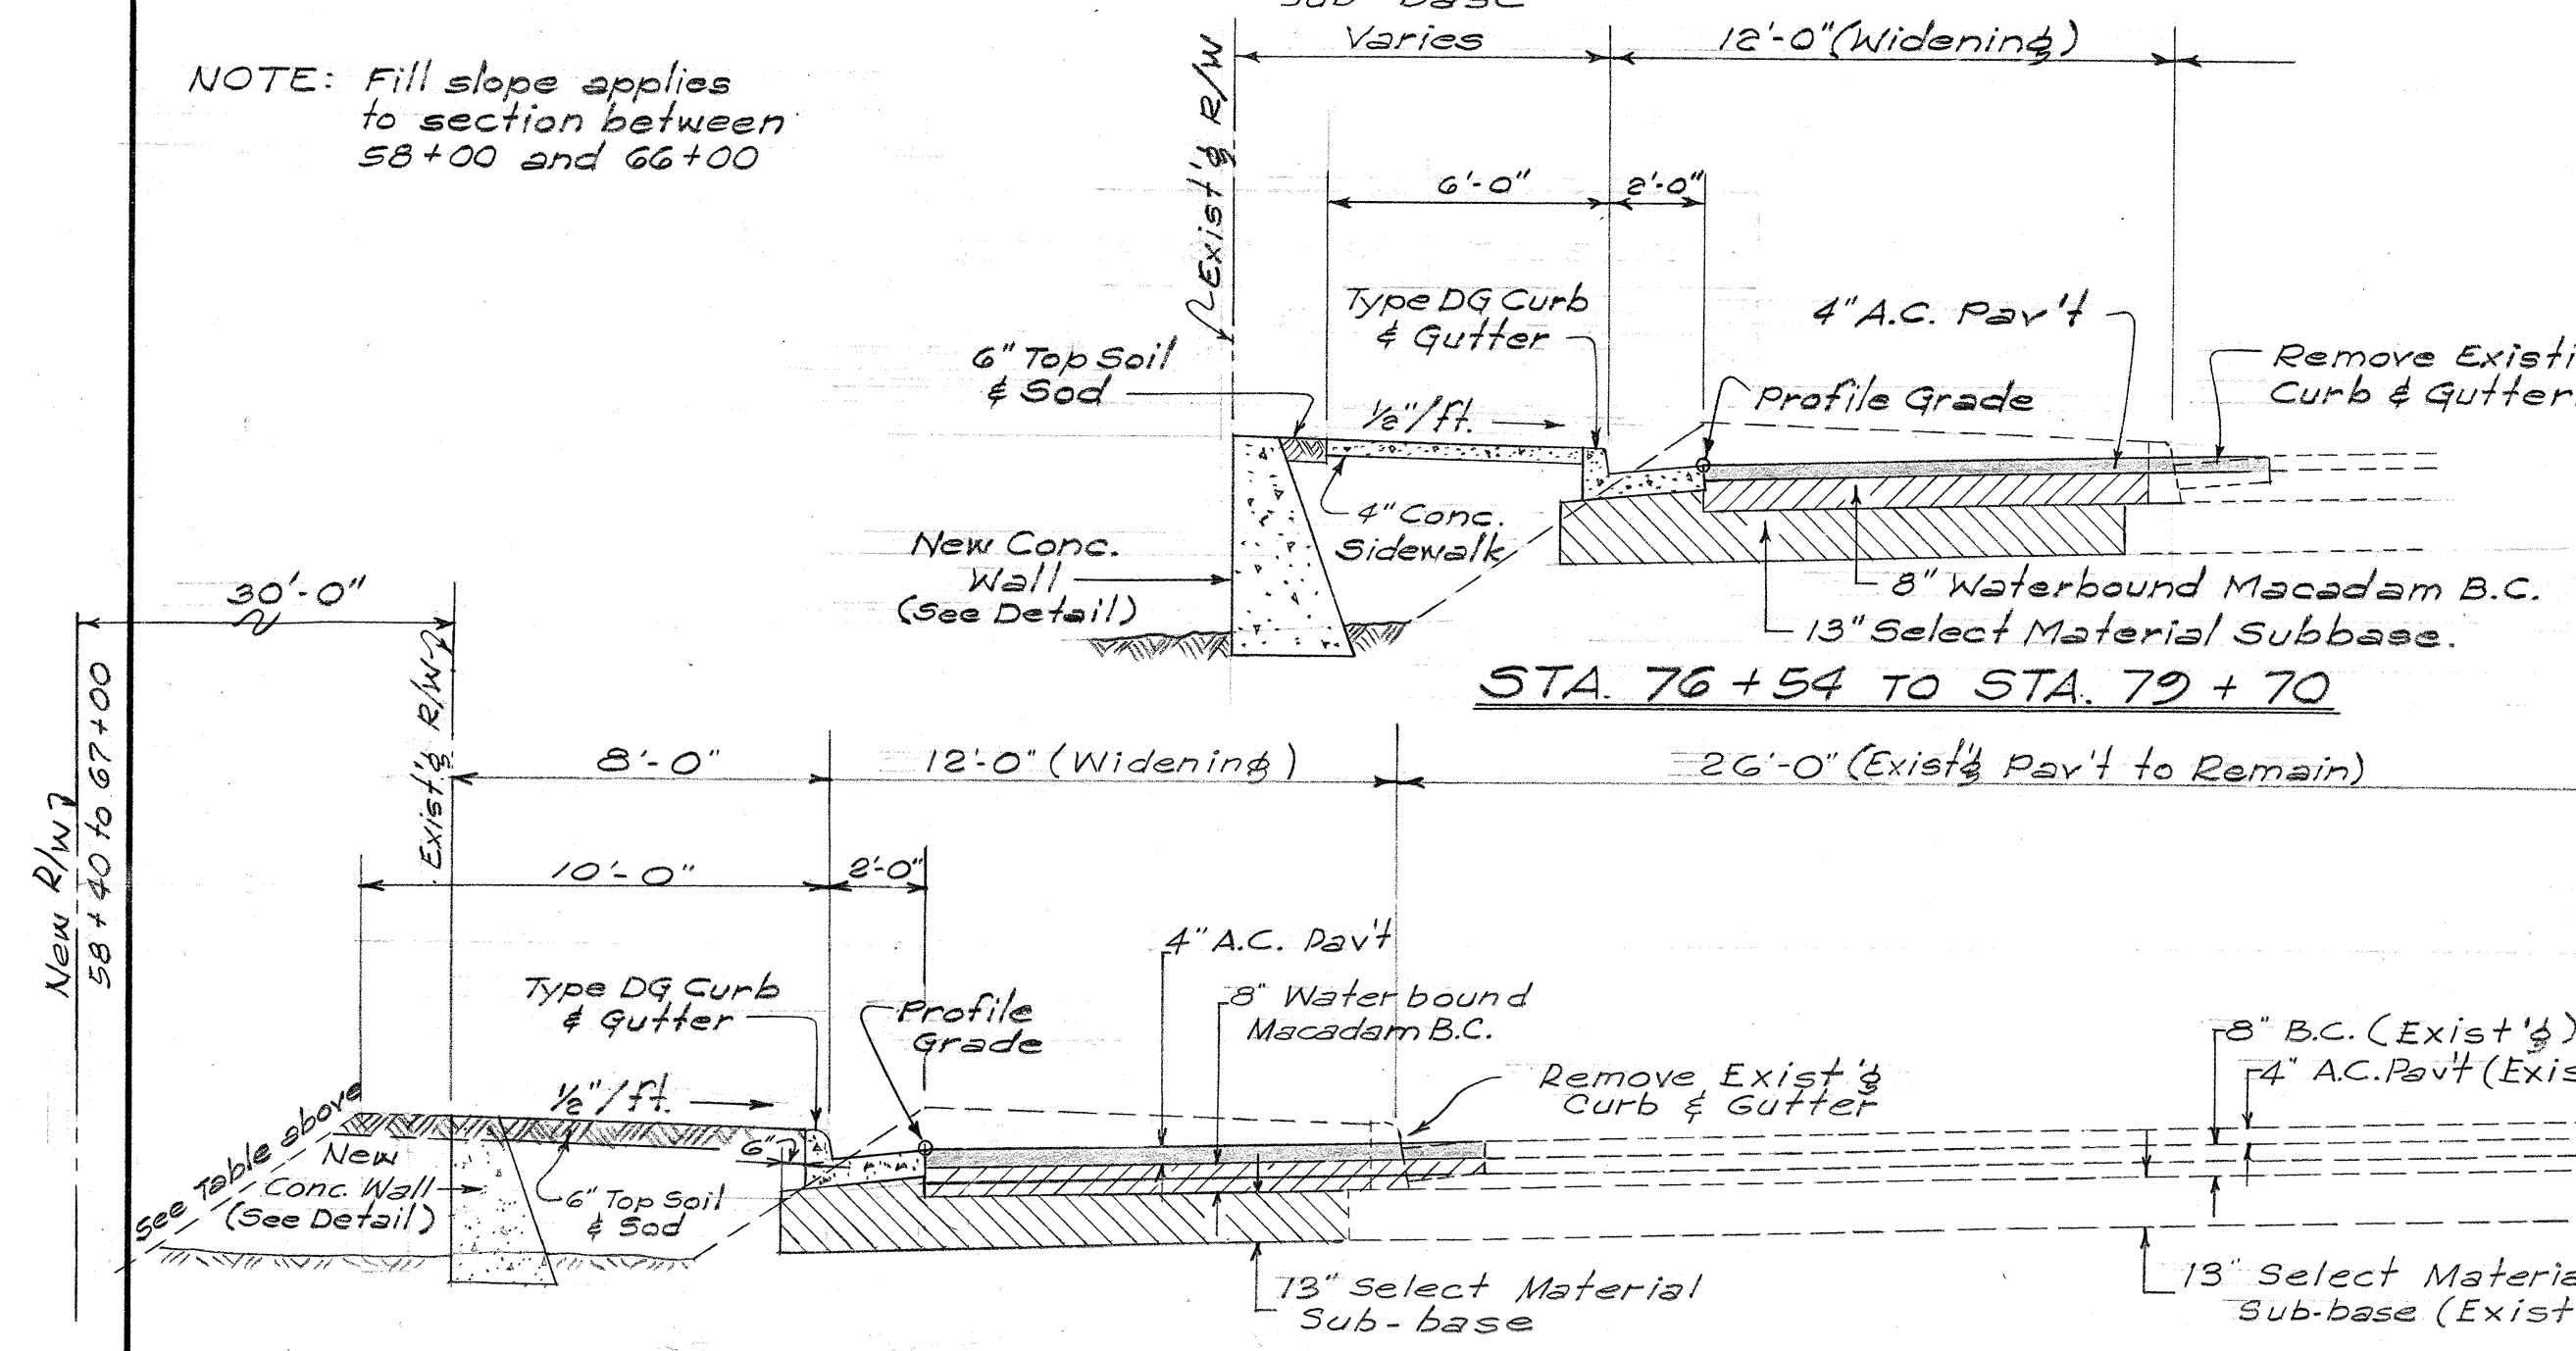


TYPICAL ROAD SECTION ON CURVES
Scale: 1/4" = 1'-0"

- GENERAL NOTES:
- 1 - Pavement shall be asphalt concrete 4" compacted thickness laid in two layers consisting of 2 1/2" compacted thickness of levelling course using Mix No. II and 1 1/2" compacted thickness of surface course using Mix No. I.
 - 2 - Base Course shall be Waterbound Macadam 8" compacted thickness laid in two layers of 4" each.

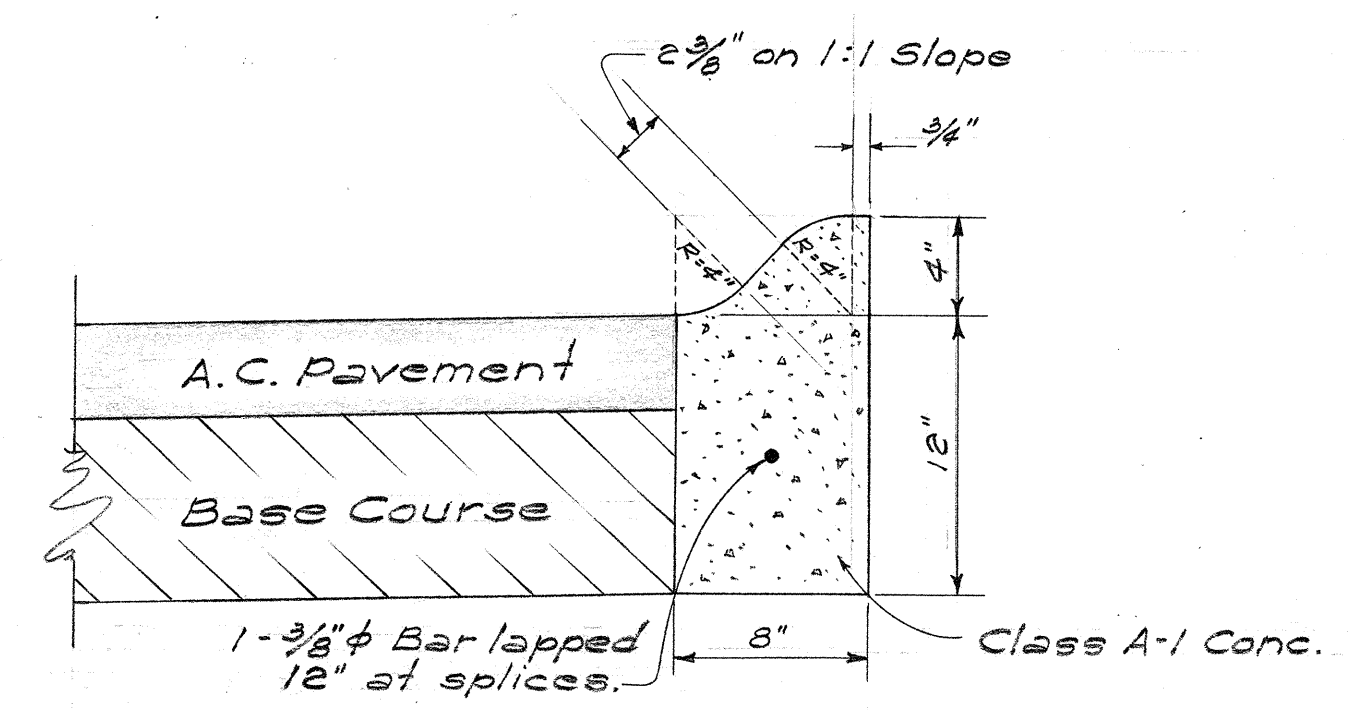

DETAIL OF TYPE "G" CAST-IN-PLACE CONCRETE CURB
Scale: 1 1/2" = 1'-0"

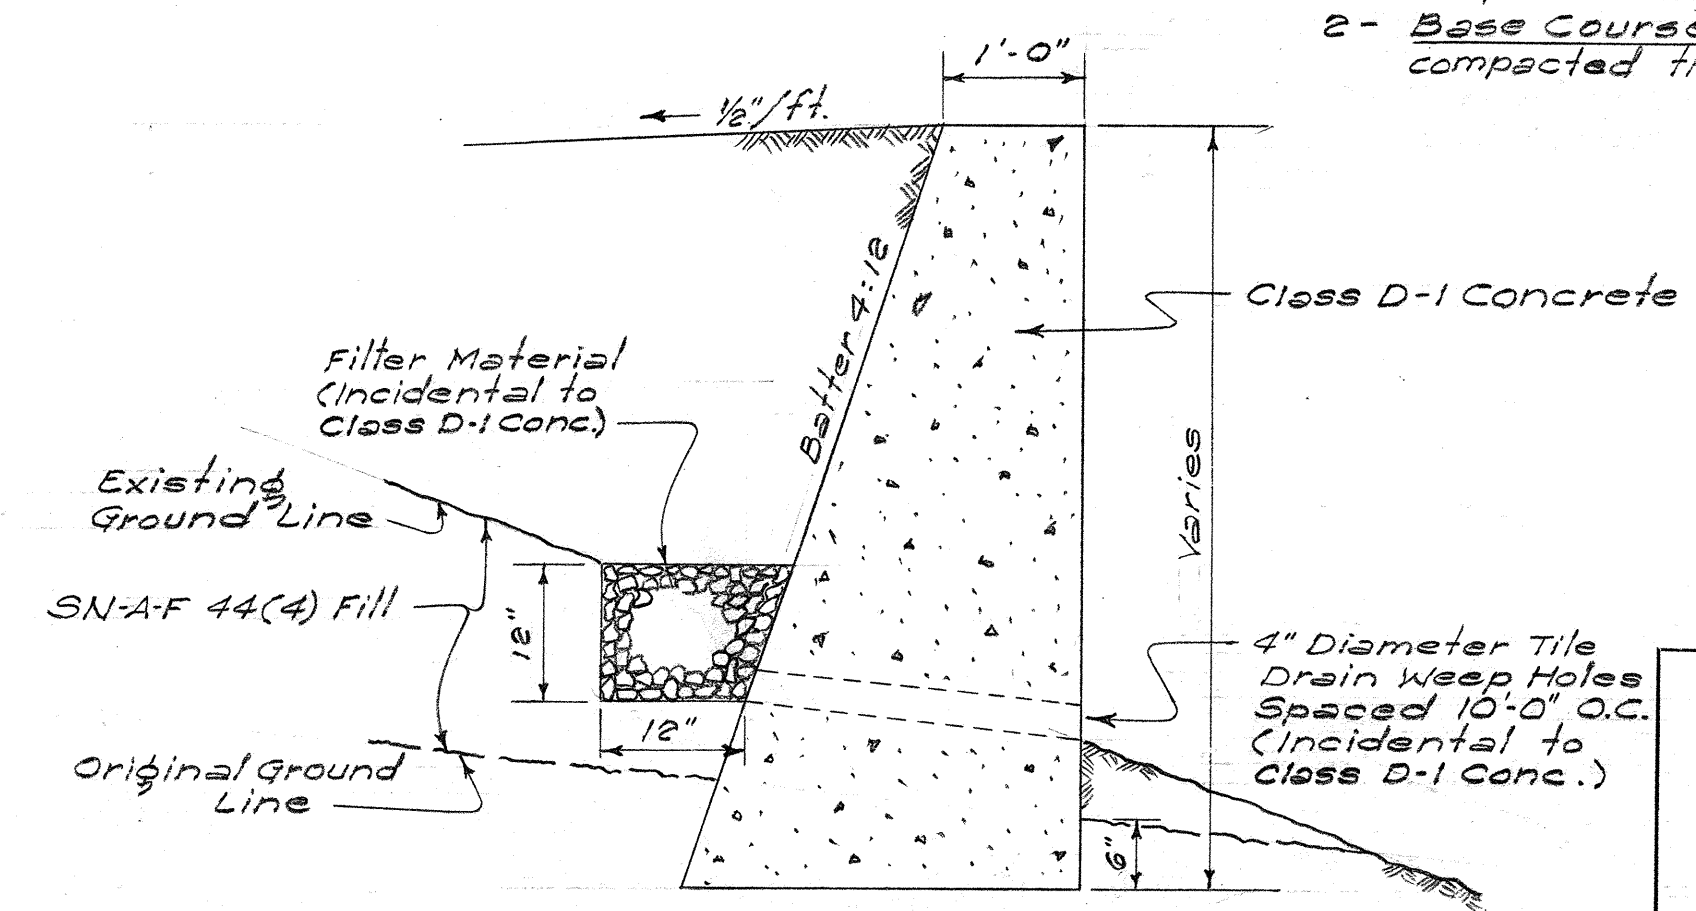

DETAIL OF CONC. RETAINING WALL
Scale: 3/4" = 1'-0"

TERRITORIAL HIGHWAY DEPARTMENT
TERRITORY OF HAWAII
TYPICAL SECTION
HONOLULU-PEARL HARBOR ROAD
PROJECT No. F-092-1(2)
Scale: As Noted
Feb, 1956

SURVEY PLOTTED BY
DATE
DRAWN BY
TRACED BY
QUANTITIES CHECKED BY
NOTE BOOK
No.