


PROJ. ROAD DIST. NO.	STATE	FED. AID PROJ. NO.	FISCAL YEAR	SHEET NO.	TOTAL SHEETS
HAWAII	HAW.	F020-1(3)	1937	2	6

PROJ. ROAD DIST. NO.	STATE	FED. AID PROJ. NO.	FISCAL YEAR	SHEET NO.	TOTAL SHEETS
HAWAII	HAW.	F022-1(3)	1937	2	6

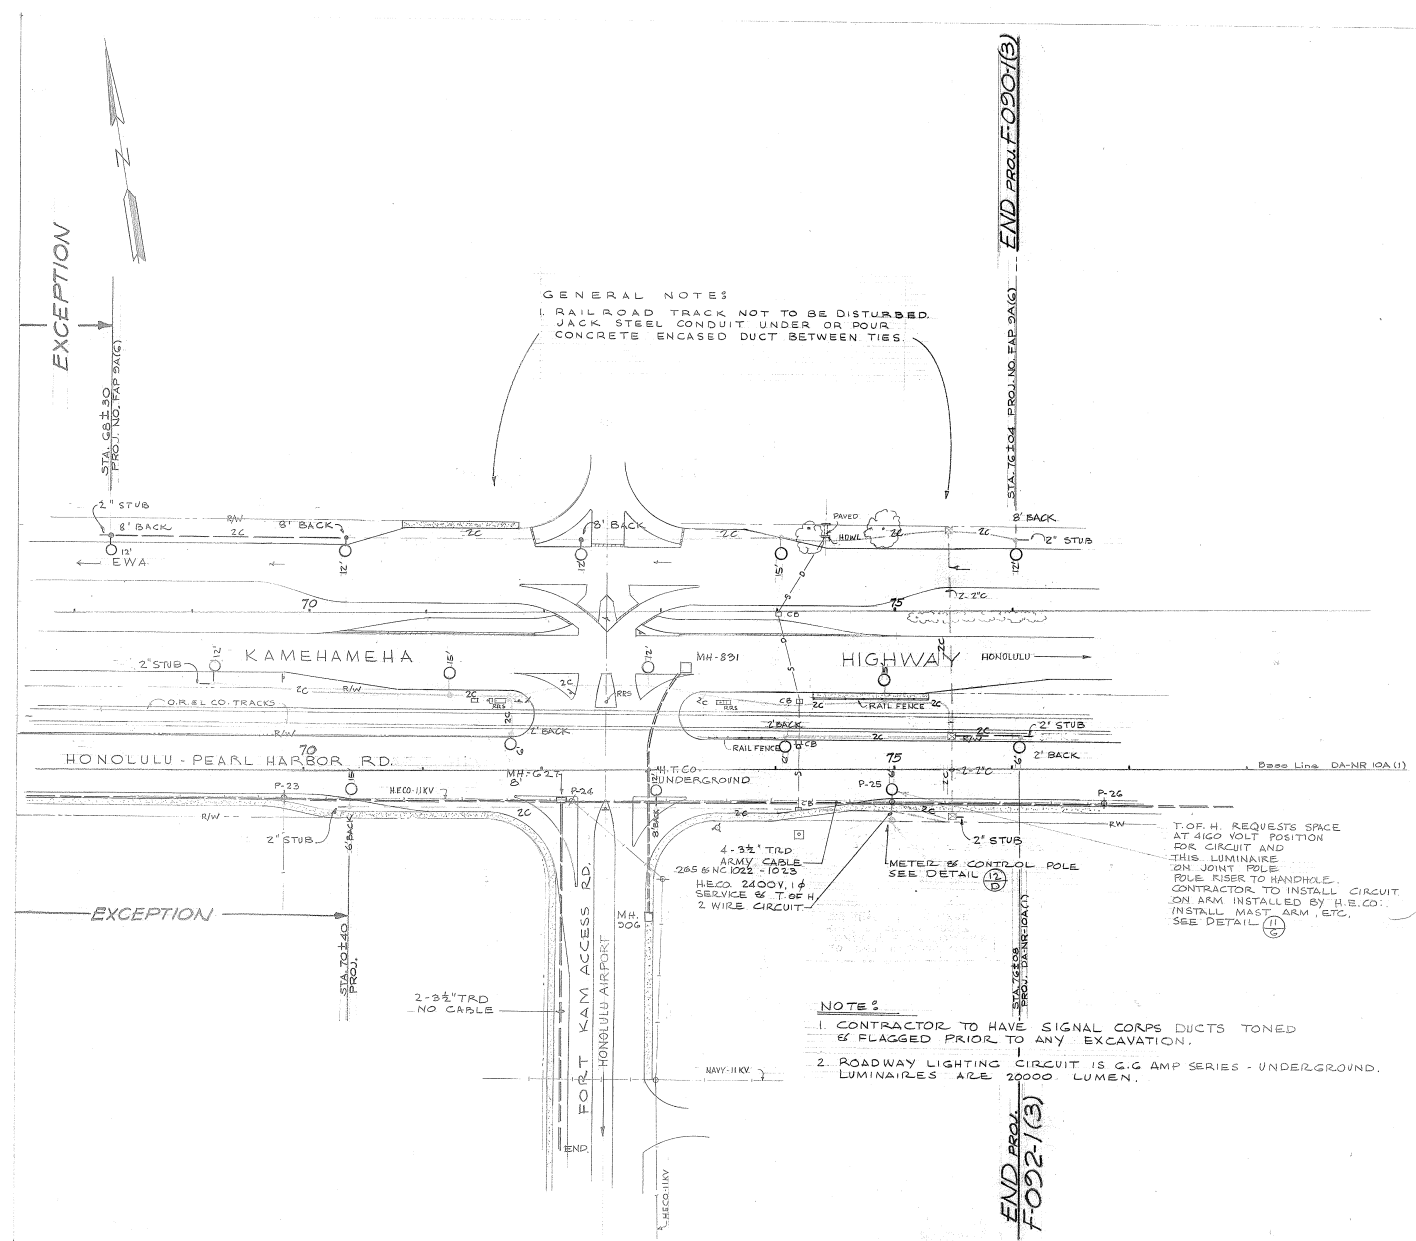

GENERAL NOTES:
 1. RAILROAD TRACK NOT TO BE DISTURBED.
 JACK STEEL CONDUIT UNDER OR POUR
 CONCRETE ENCASED DUCT BETWEEN TIES.

- NOTE:
1. CONTRACTOR TO HAVE SIGNAL CORPS DUCTS TONED & FLAGGED PRIOR TO ANY EXCAVATION.
 2. ROADWAY LIGHTING CIRCUIT IS G.G. AMP SERIES - UNDERGROUND. LUMINAIRES ARE 20000 LUMEN.

T.O.F.H. REQUESTS SPACE AT 4160 VOLT POSITION FOR CIRCUIT AND THIS LUMINAIRE ON JOINT POLE TOLE RISER TO HANDHOLE. CONTRACTOR TO INSTALL CIRCUIT ON ARM INSTALLED BY H.E.CO. INSTALL MAST ARM, ETC. SEE DETAIL (11)



JAMES J. OBERHAUSEN
 ELECTRICAL ENGINEER

TERRITORIAL HIGHWAY DEPARTMENT
 TERRITORY OF HAWAII
INTERSECTION LIGHTING
 KAM HIGHWAY & FORT KAM
 ACCESS RD. & HONOLULU-PEARL
 HARBOR RD.

PROJECT NOS. F-020-1(3) & F-022-1(3)
 SCALE: 1" = 80' DATE: JUNE 1937
 SHEET NO. 2 OF 5 SHEETS

Proj. F-020-1(3) Proj. F-022-1(3)