INDEX TO DRAWINGS	
SHEET NO.	DESCRIPTION
1	TITLE
2	INTERSECTION OF HONOLULU-P.H. ROAD & KAMEHAMEHA HWY.
3.	INTERSECTION OF HONOLULU PH. ROAD & FT. KAM. ACCESS ROAD
4	INTERSECTION LIGHTING & MISC. DETAILS
5	INTERSECTION LIGHTING & MISC. DETAILS
6	INTERSECTION LIGHTING, ELECTRICAL SYMBOLS, & MISC. DETAILS

TERRITORY OF HAWAII
TERRITORIAL HIGHWAY DEPARTMENT
HONOLULU, OAHU, T.H.

PLANS OF

## INTERSECTION LIGHTING

HONOLULU-PEARL HARBOR RD.


FEDERAL AID PROJECT NO. F-092-I(3)


DISTRICT OF HONOLULU

ISLAND OF OAHU

SCALE


PLAN I IN. = 50 FT.

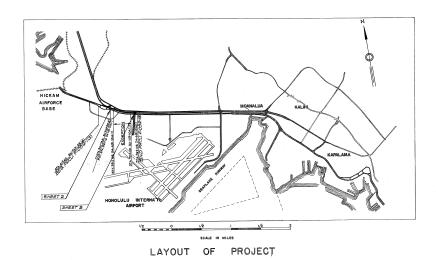

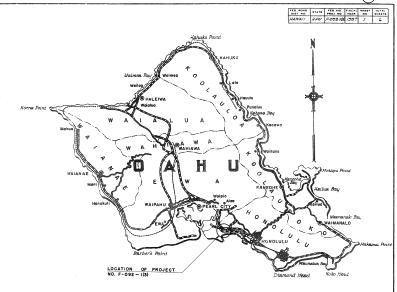

Federal Aid Projects Previously Constructed Or Under Construction

Stand W. Butging Acts TERRITORIAL HIGHWAY ENGINEER

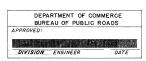

5904.1