

EXIST. CONDUIT ON BRIDGE WITH 1 CABLE. INSTALL 2 NEW CABLES TO NEW LAMP POST.

EXIST. 10'-0" BACK FROM PAVEMENT

DO NOT DISTURB EXIST. DIRECT BURIAL CABLE

INSTALL NEW DUCT MARKERS

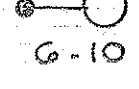
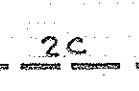
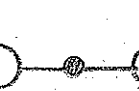
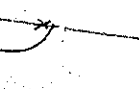
EXIST. 10'-0" BACK FROM PAVEMENT

EXIST. CONDUIT ON BRIDGE WITH 1 CABLE

EXIST. 10'-0" BACK FROM PAVEMENT

LOCATE CLOSE AS POSSIBLE TO R/W LINE FENCE

ELECTRICAL SYMBOLS & NOTES

-  LUMINAIRE ON METAL LAMP POST. FIRST NUMERAL INDICATES DISTANCE FROM FACE OF TRANSFORMER BASE TO FACE OF CURB OR PAVEMENT. SECOND NUMERAL INDICATES BRACKET LENGTH
-  EXISTING METAL LAMP POST WITH LUMINAIRE.
-  EXISTING WOOD POLE WITH LUMINAIRE.
-  20,000 LUMEN MERCURY VAPOR LUMINAIRE.
-  11,000 LUMEN MERCURY VAPOR LUMINAIRE.
-  DIRECT BURIAL CABLE FOR SERIES CIRCUIT. 2C INDICATES 2 CABLE - 1C INDICATES 1 CABLE.
-  CABLE IN CONDUIT (OR DUCT) FOR SERIES CIRCUIT. 2C INDICATES 2 CABLES - 1C INDICATES 1 CABLE.
-  PULL BOX.
-  DUCT MARKER AT END OF CONDUIT OR CABLE.
-  2 ARM METAL LAMP POST
-  C INDICATES METAL LAMP POST TO BE LOCATED IN CENTER OF MED. STRIP. NUMERAL INDICATES BRACKET LENGTH

DATE: _____
 DESIGNED BY: _____
 DRAWN BY: _____
 CHECKED BY: _____
 QUANTITIES CHECKED BY: _____
 NOTE BOOK NO. _____

TERRITORIAL HIGHWAY DEPARTMENT
 TERRITORY OF HAWAII

HIGHWAY LIGHTING
 MIDDLE ST. TO WAIKAMULO ST.
 HONOLULU - PEARL HARBOR RD.

PROJECT NO. F-092-1(4)
 SCALE: 1" = 50' DATE: JAN. 1958

JAMES J. OBERHAUSEN
 ELECTRICAL ENGINEER

SHEET NO. 2 OF 6 SHEETS

5974.2

