



FED. ROAD DIST. No.	STATE	FED. AID PROJ. No.	FISCAL YEAR	SHEET No.	TOTAL SHEETS
HAWAII	HAW.	F-092-14	1959	5	6


NOTE:
All taps from 2400 volt bus to equipment
to be #8 AWG, 6000-7000 volt wire
Top of 4"x4" Conc. Runners shall be level
3" Fiber Duct

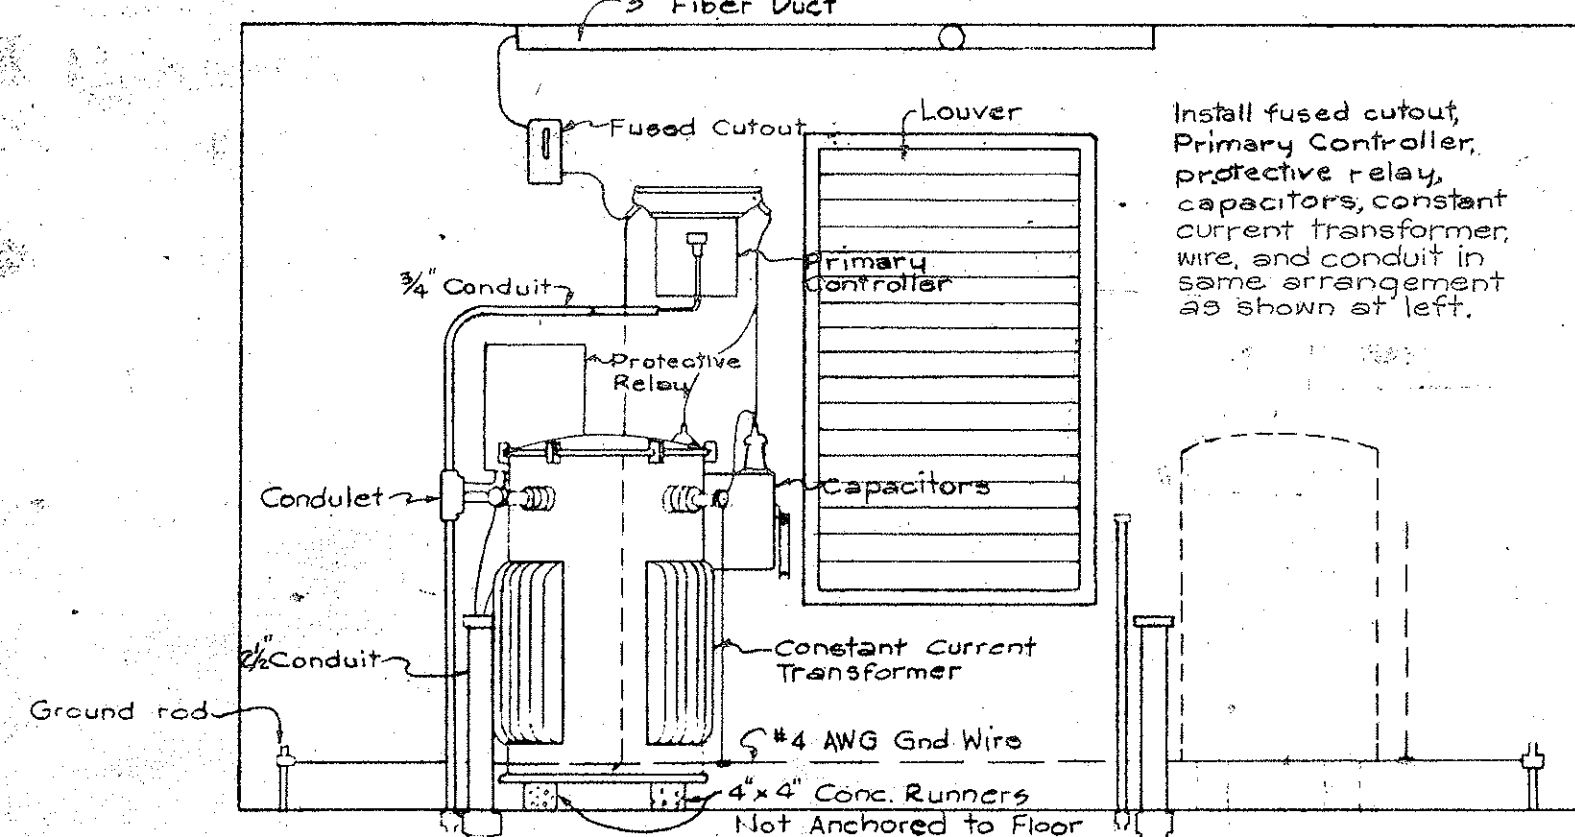


SECTION "A-A"

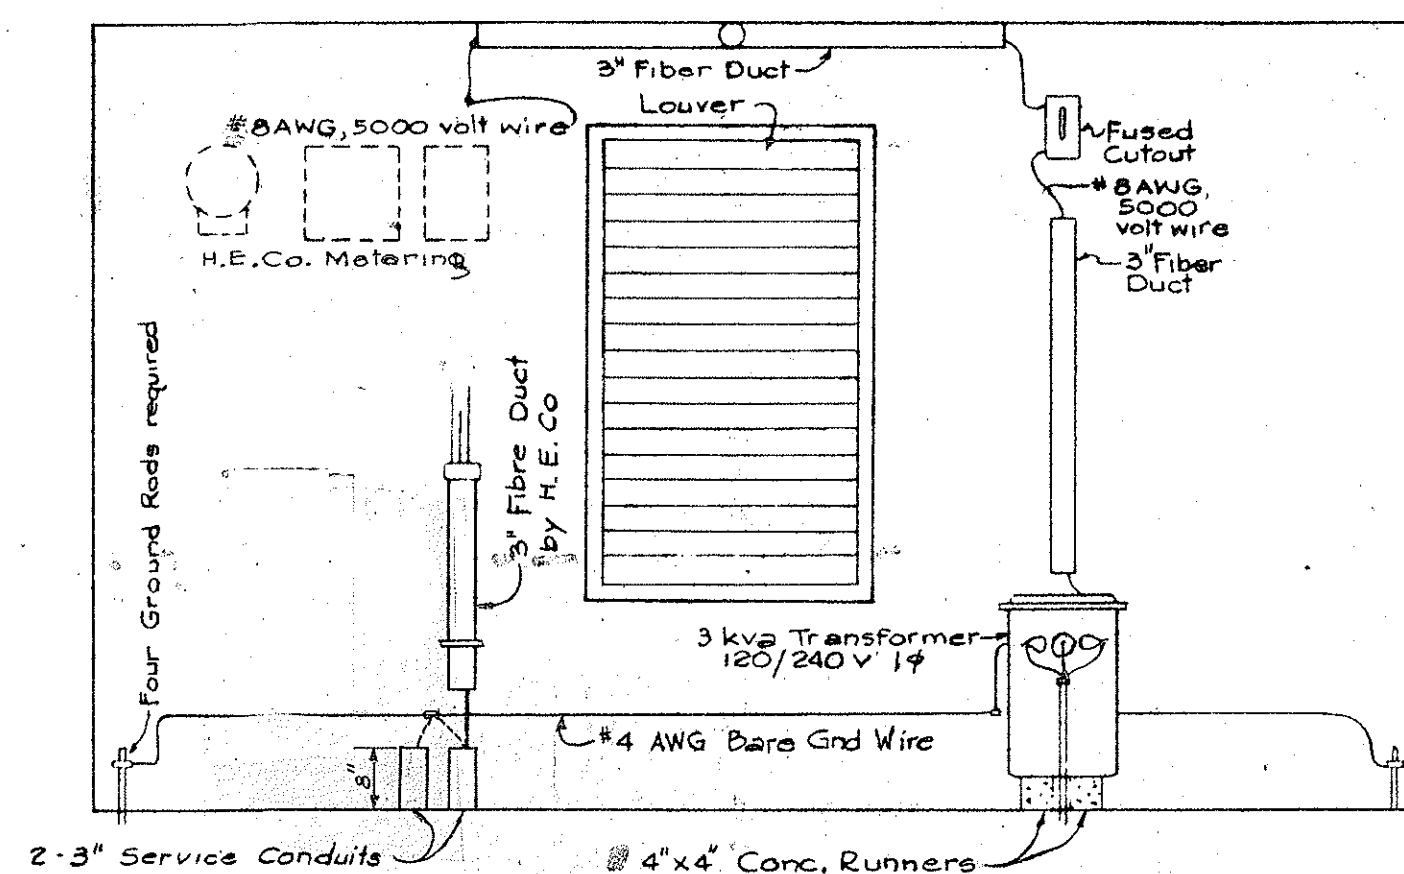


SECTION "B-B"

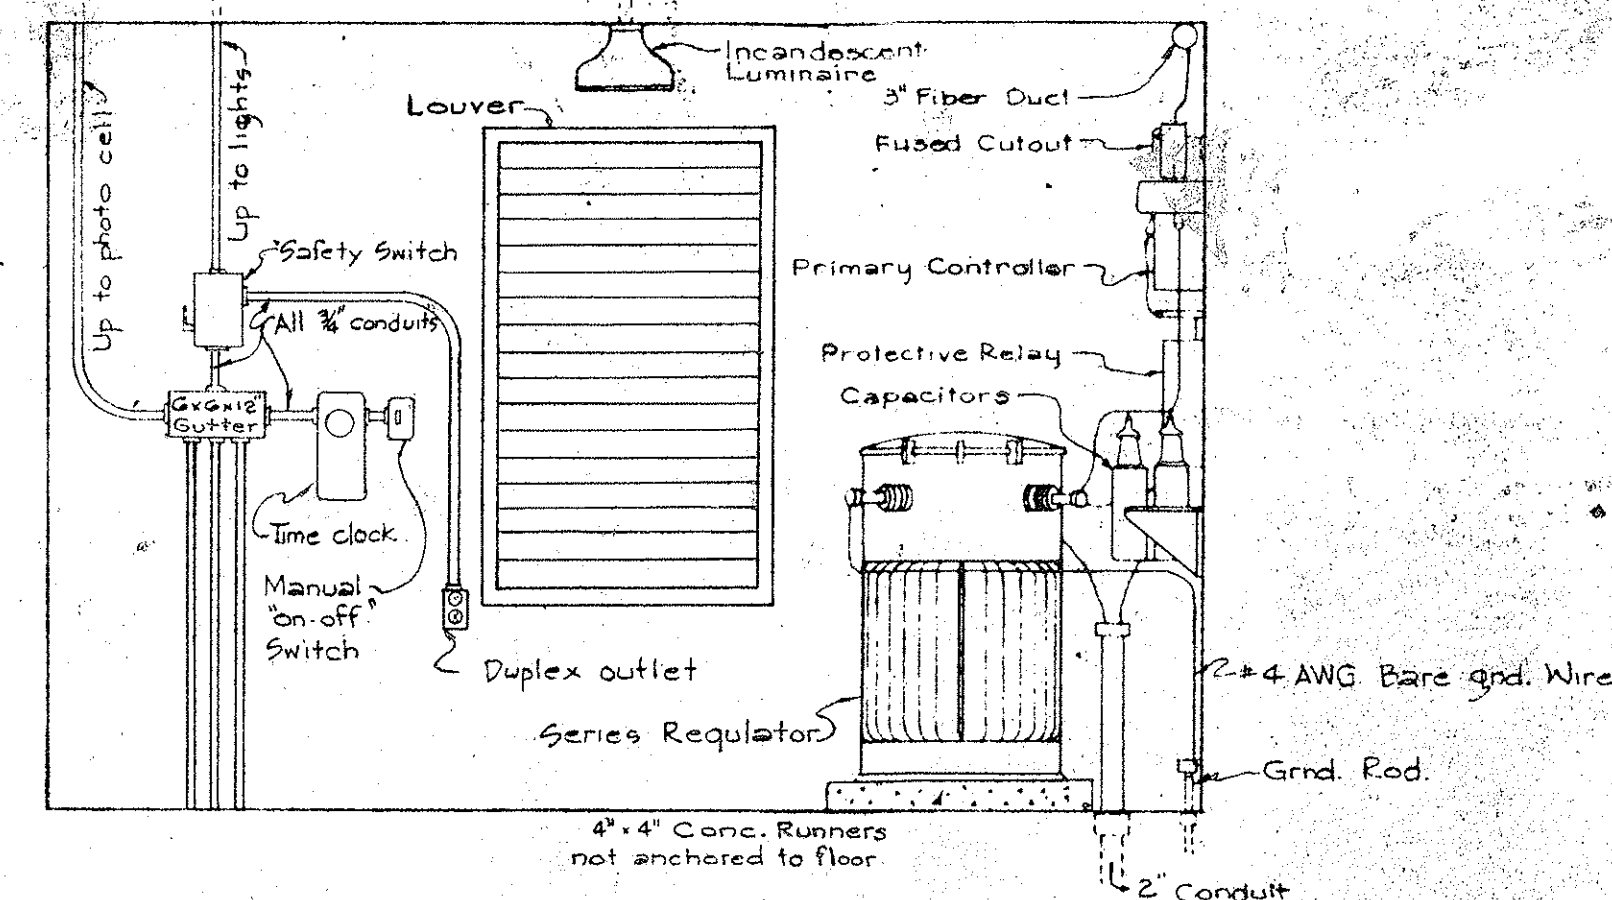


SECTION "C-C"

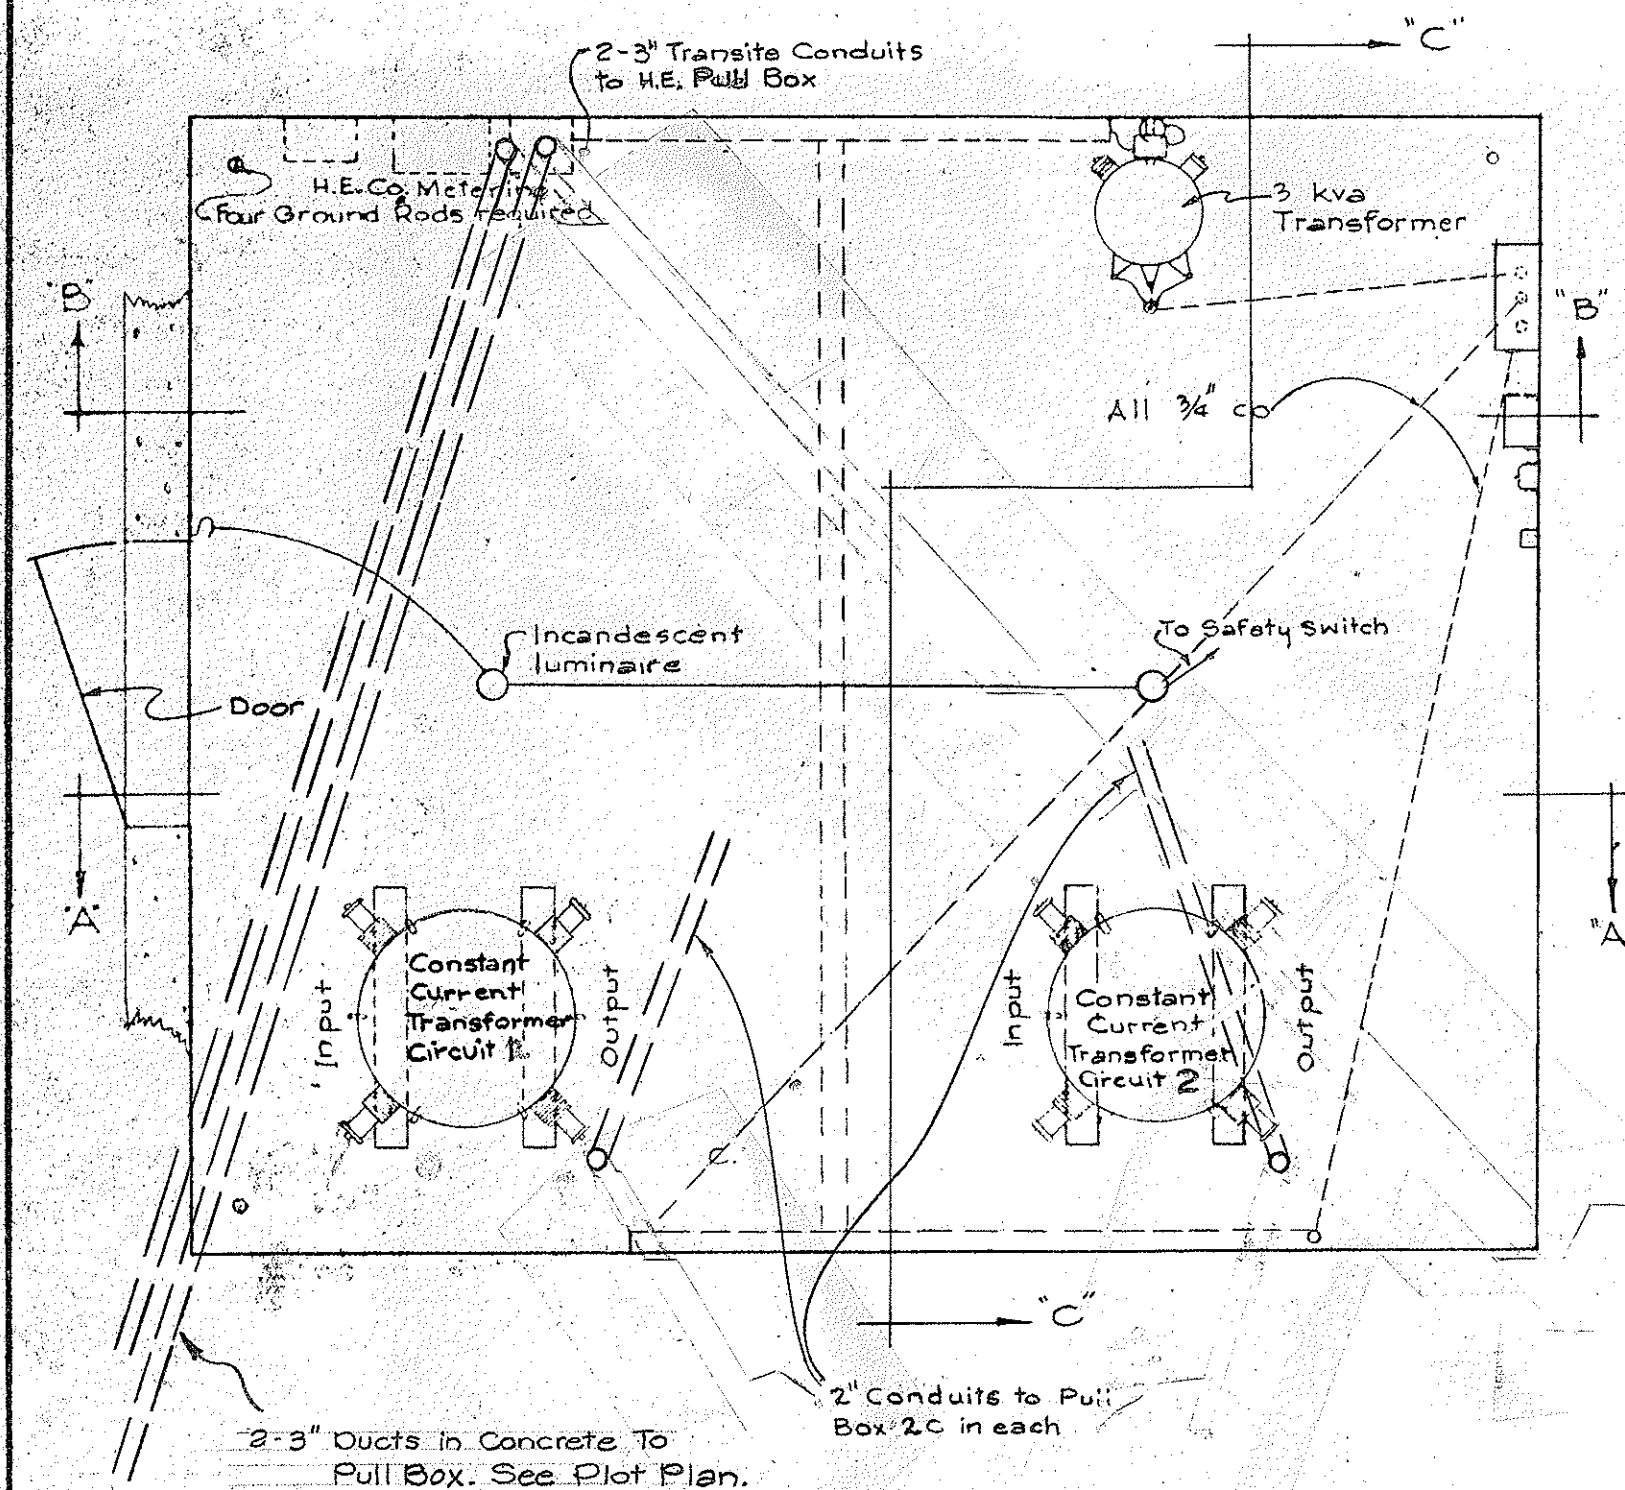


PLAN
Scale: 1/2" = 1'-0"

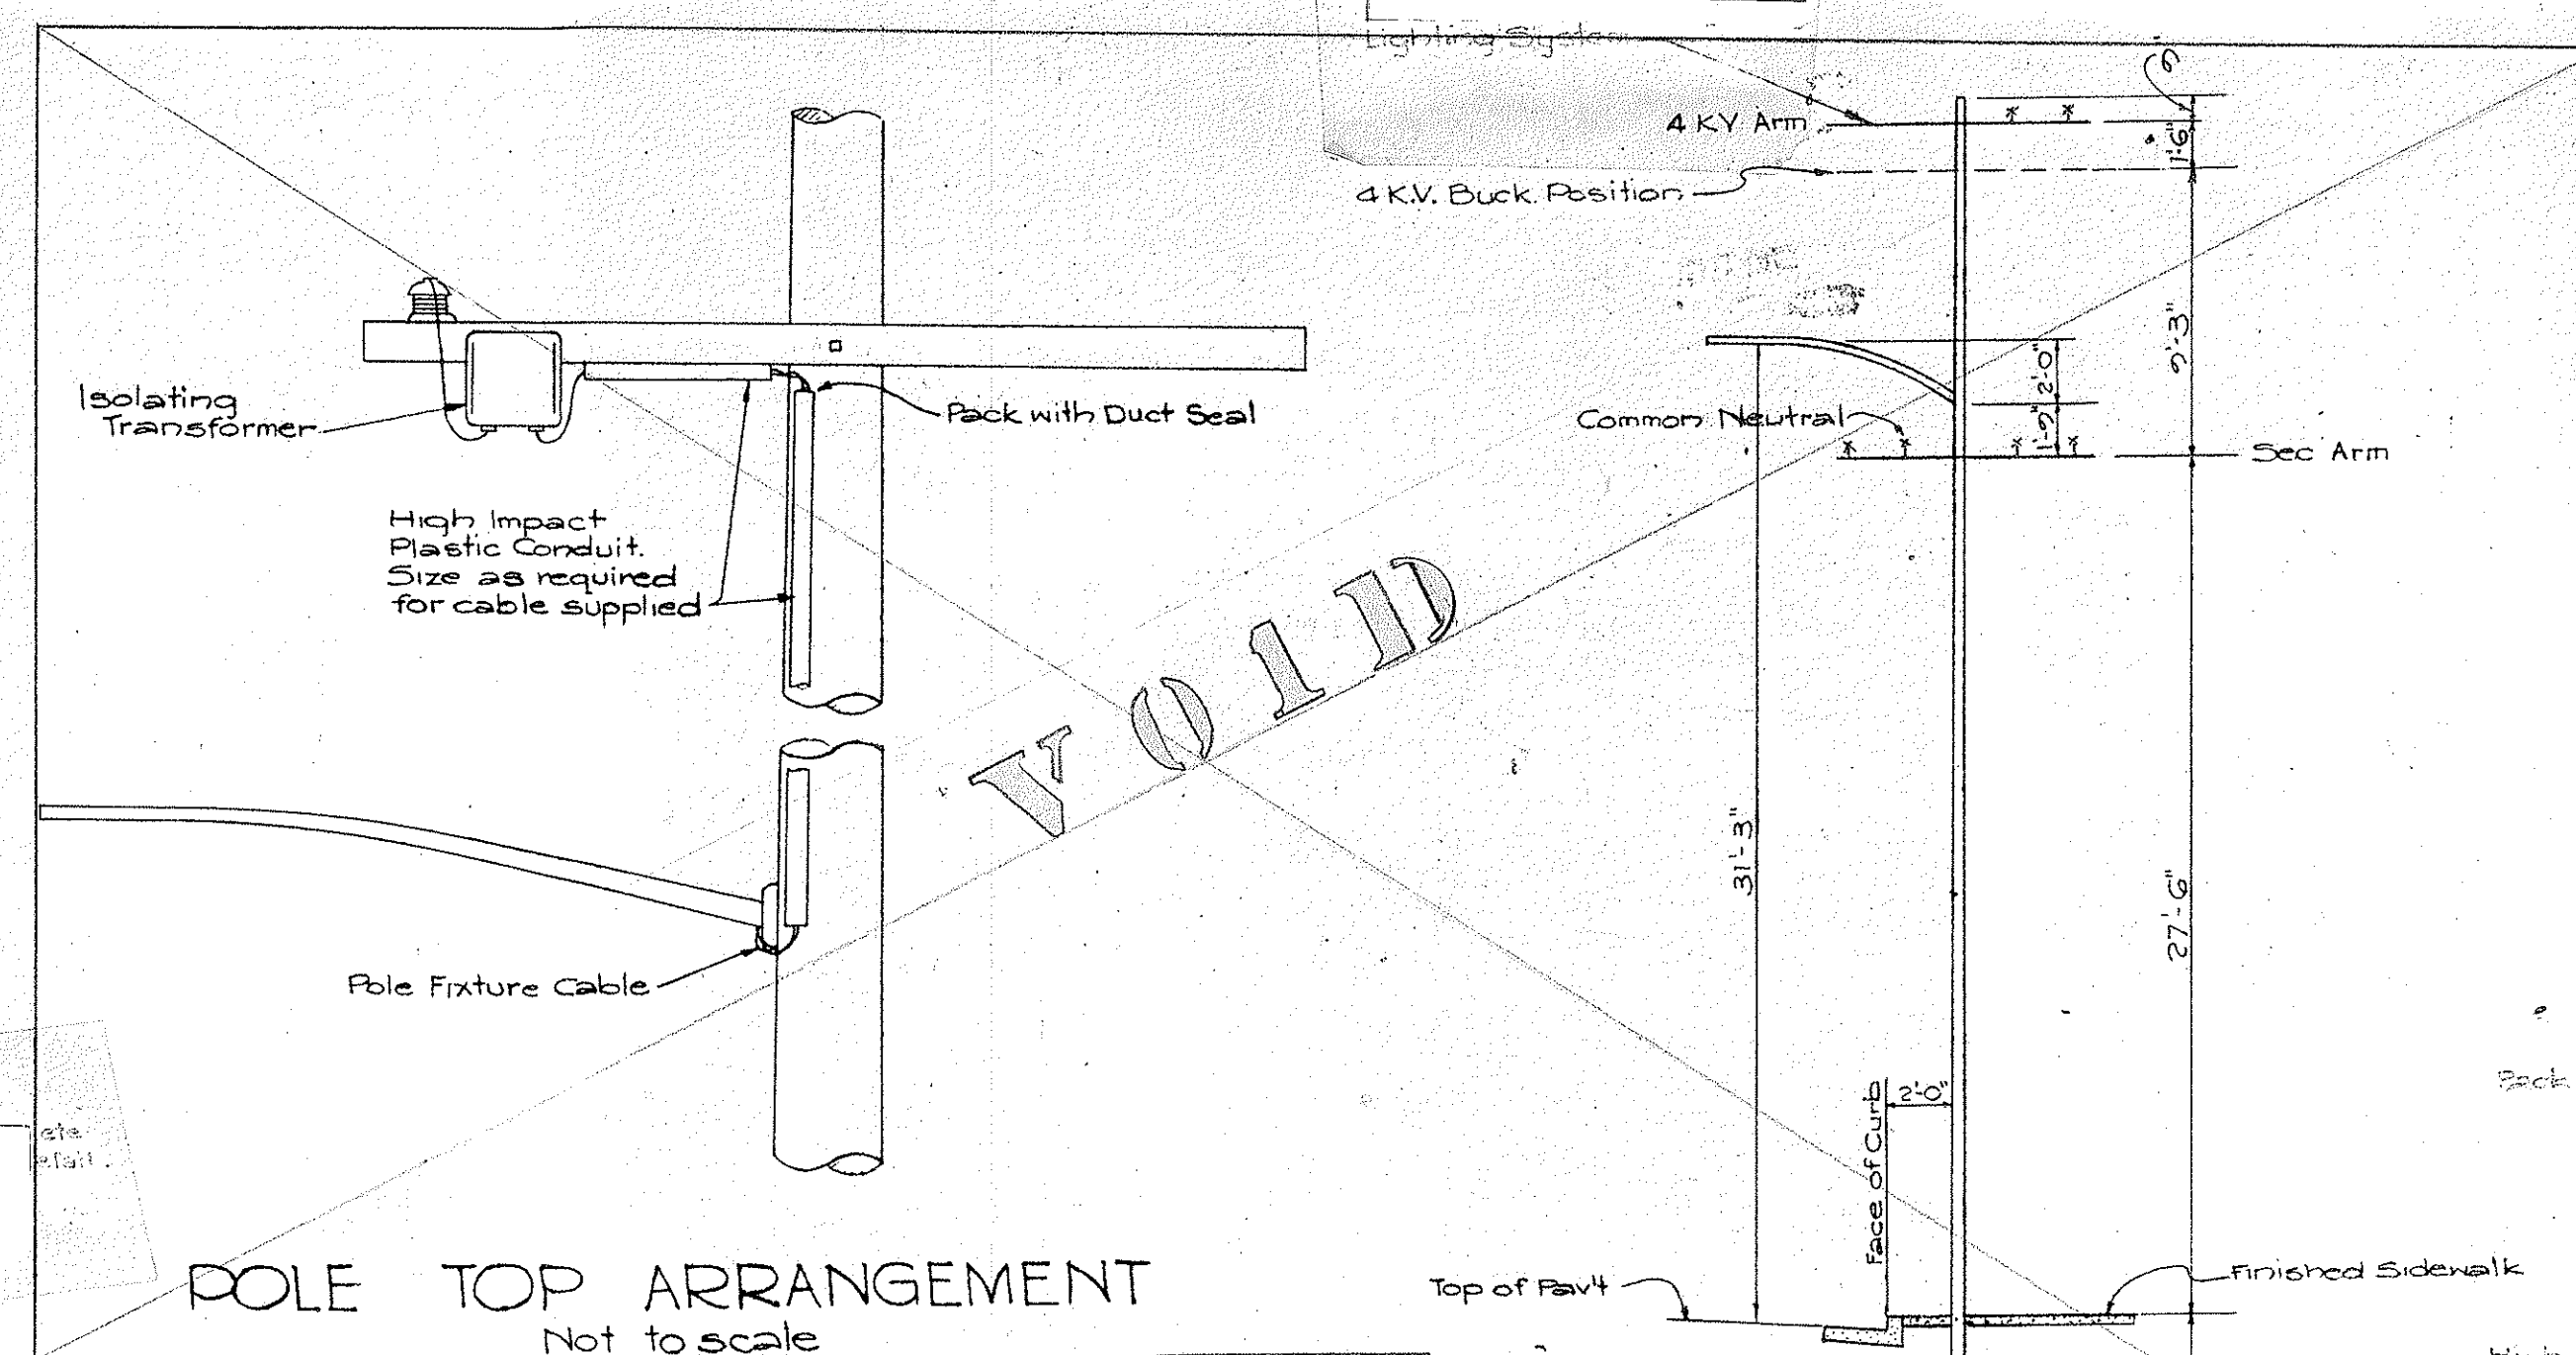

45' JOINT POLE FRAMING DETAIL
Scale: 1"=6'-0"

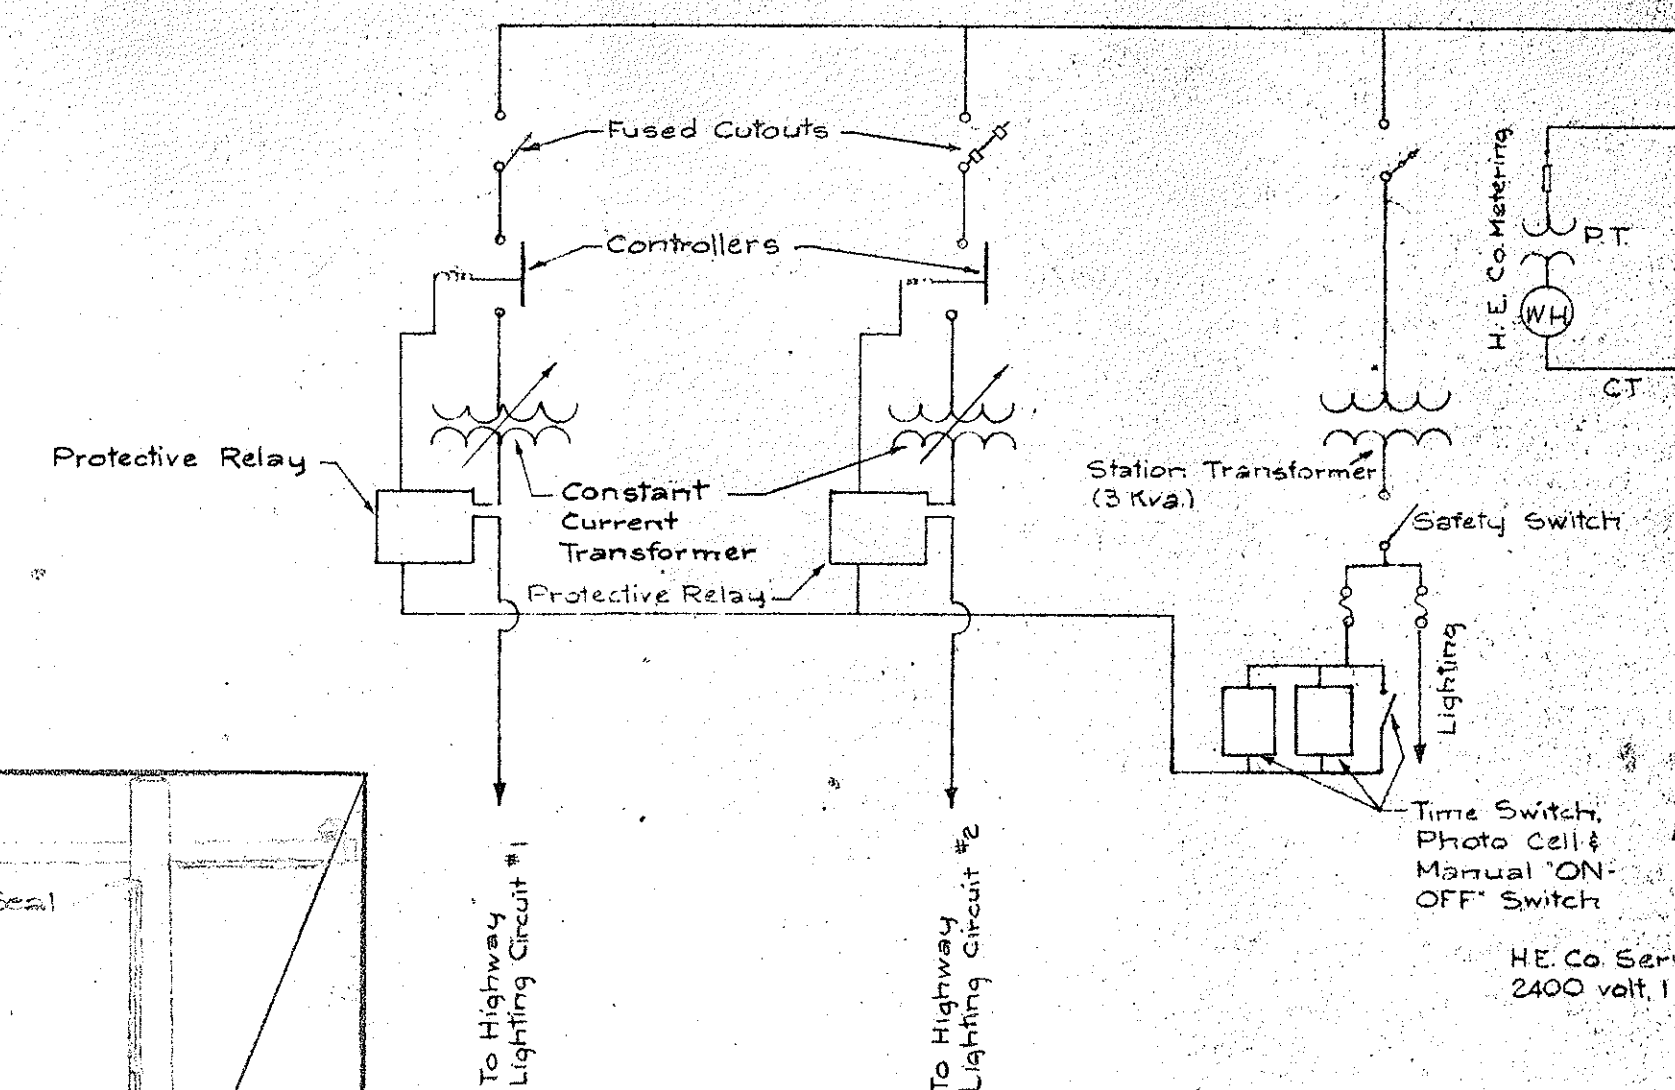

WIRING DIAGRAM

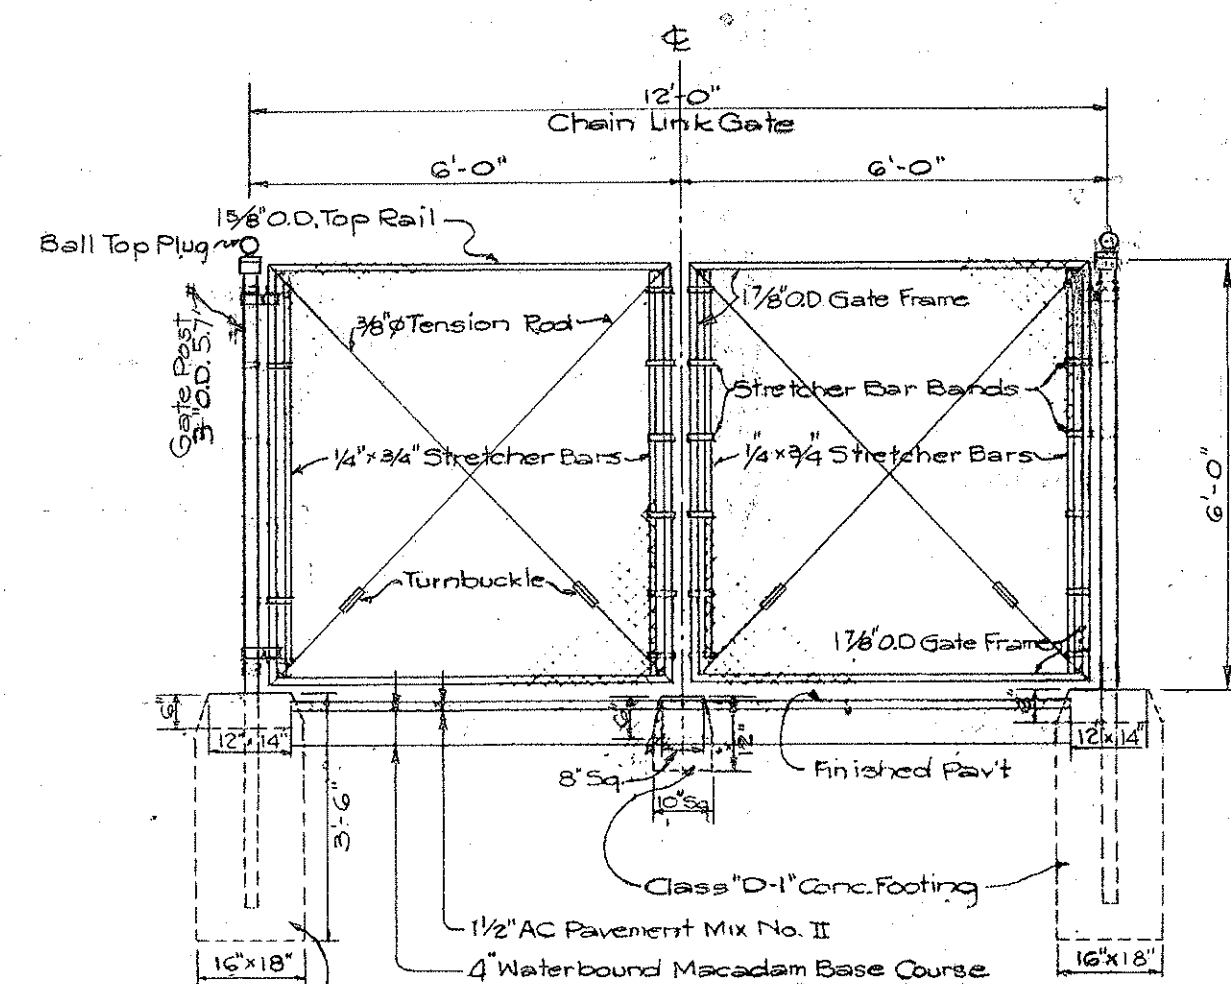

DETAIL OF CHAIN LINK GATE
Scale $\frac{3}{8}" = 1' - 0"$ (SUB-STATION YARD)

NOTE:
Gate latch and lock, Flush Plate and Anchor, and Plunger Bar shall be furnished and installed with Gates and shall be considered as incidents to fence item.

APPROVED:

James J. Oberhausen
ELECTRICAL ENGINEER
Reg. Eng. Cert. No. 664

DATE

TERRITORIAL HIGHWAY DEPARTMENT
TERRITORY OF HAWAII

HIGHWAY LIGHTING SYSTEM

HONOLULU - PEARL HARBOR ROAD
MIDDLE BLVD. TO WAIKAKILU STREET
PROJECT NO. F-092-1(4)


Scale: As Noted

JAN. 1958

SHEET NO. 5 OF 6 SHEETS












5974.5

FED. ROAD DIST. No.	STATE	FED. AID PROJ. No.	FISCAL YEAR	SHEET No.	TOTAL SHEETS
HAWAII	HAW.	F-092-1(4)	1958	6	6

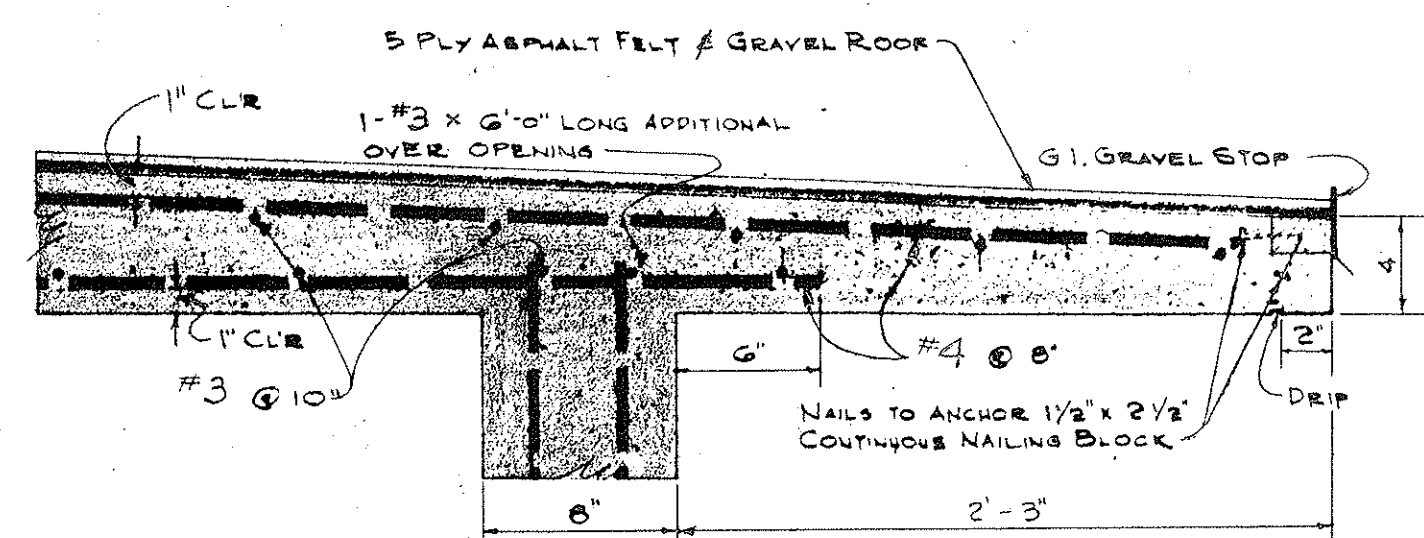

NOTE:

CONCRETE AND CONCRETE FINISH
ALL CONCRETE SHALL BE CLASS A-1 UNLESS OTHERWISE NOTED
ALL EXPOSED EXTERIOR SURFACES OF CONCRETE WALLS AND ROOF
SHALL BE GIVEN "CLASS 2 SURFACE FINISH."

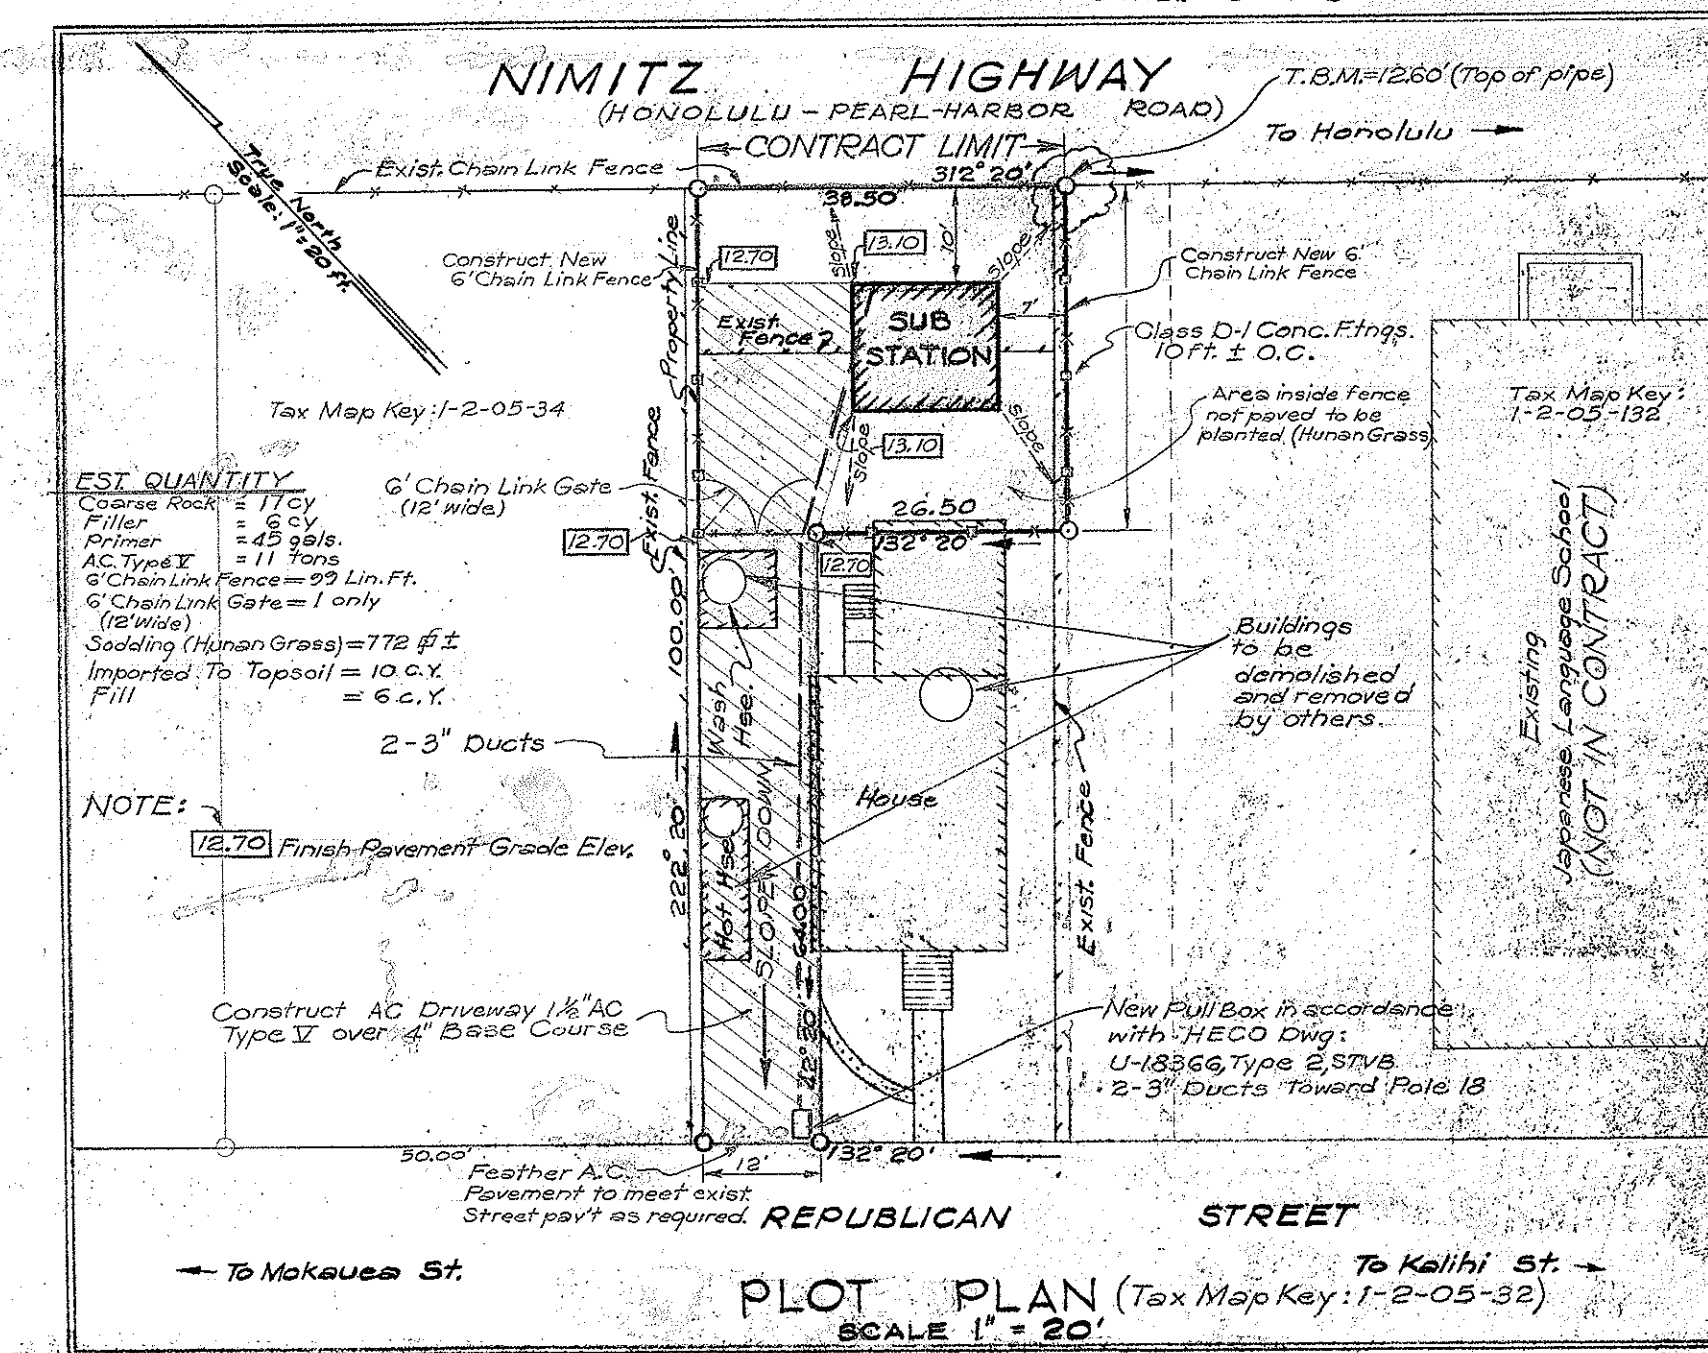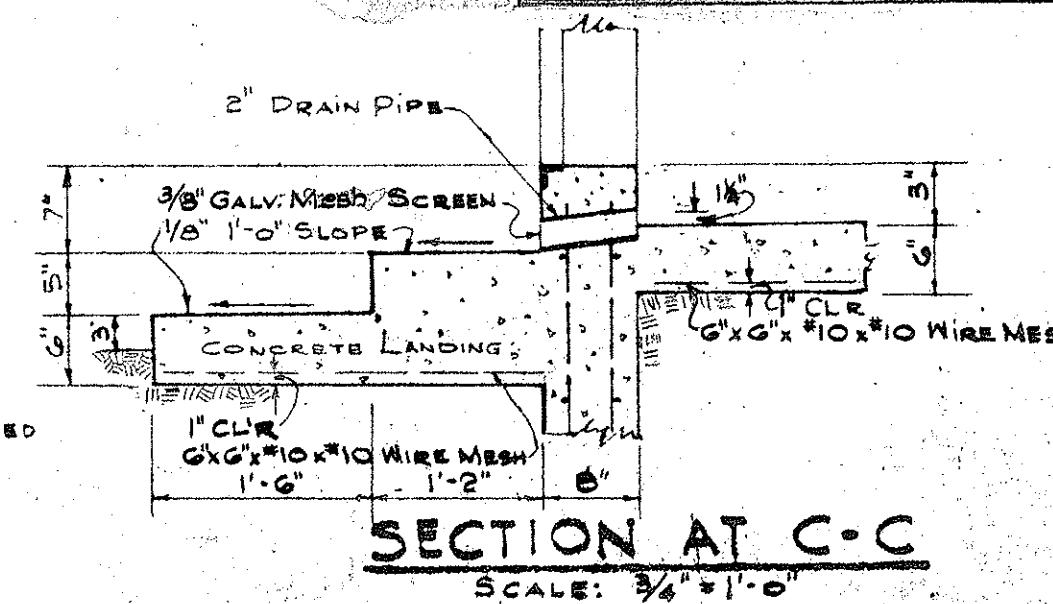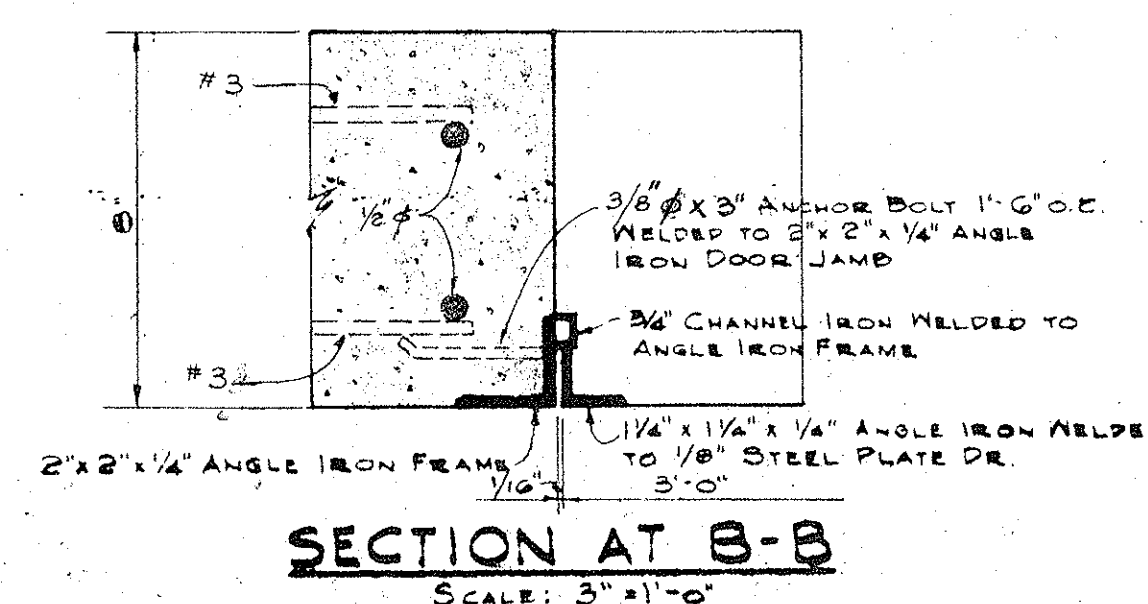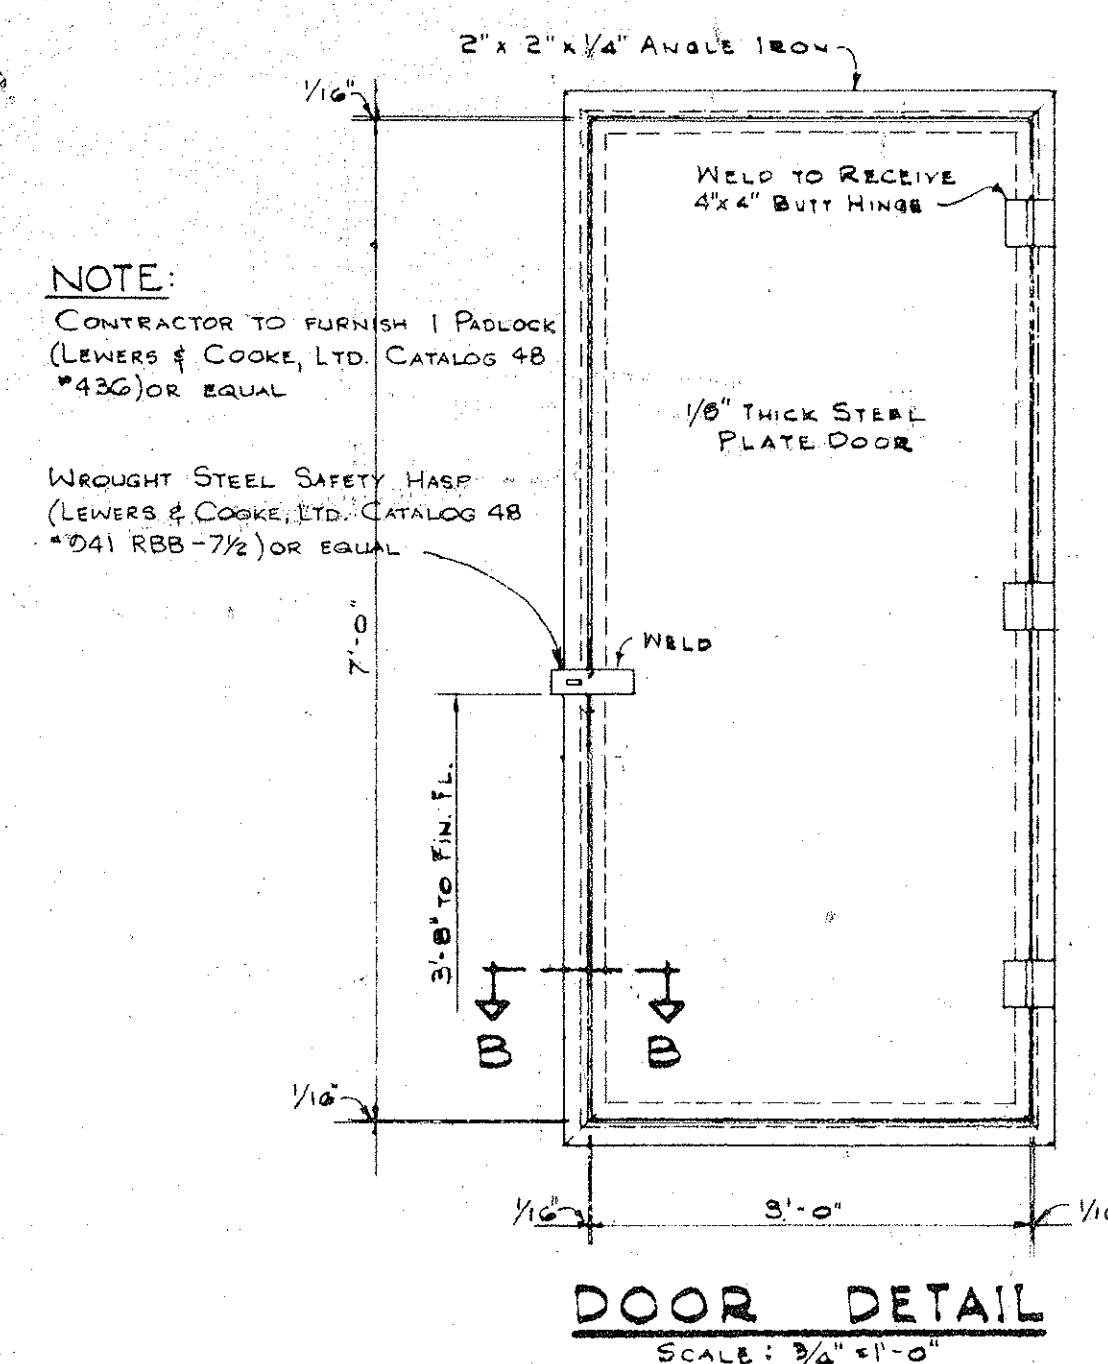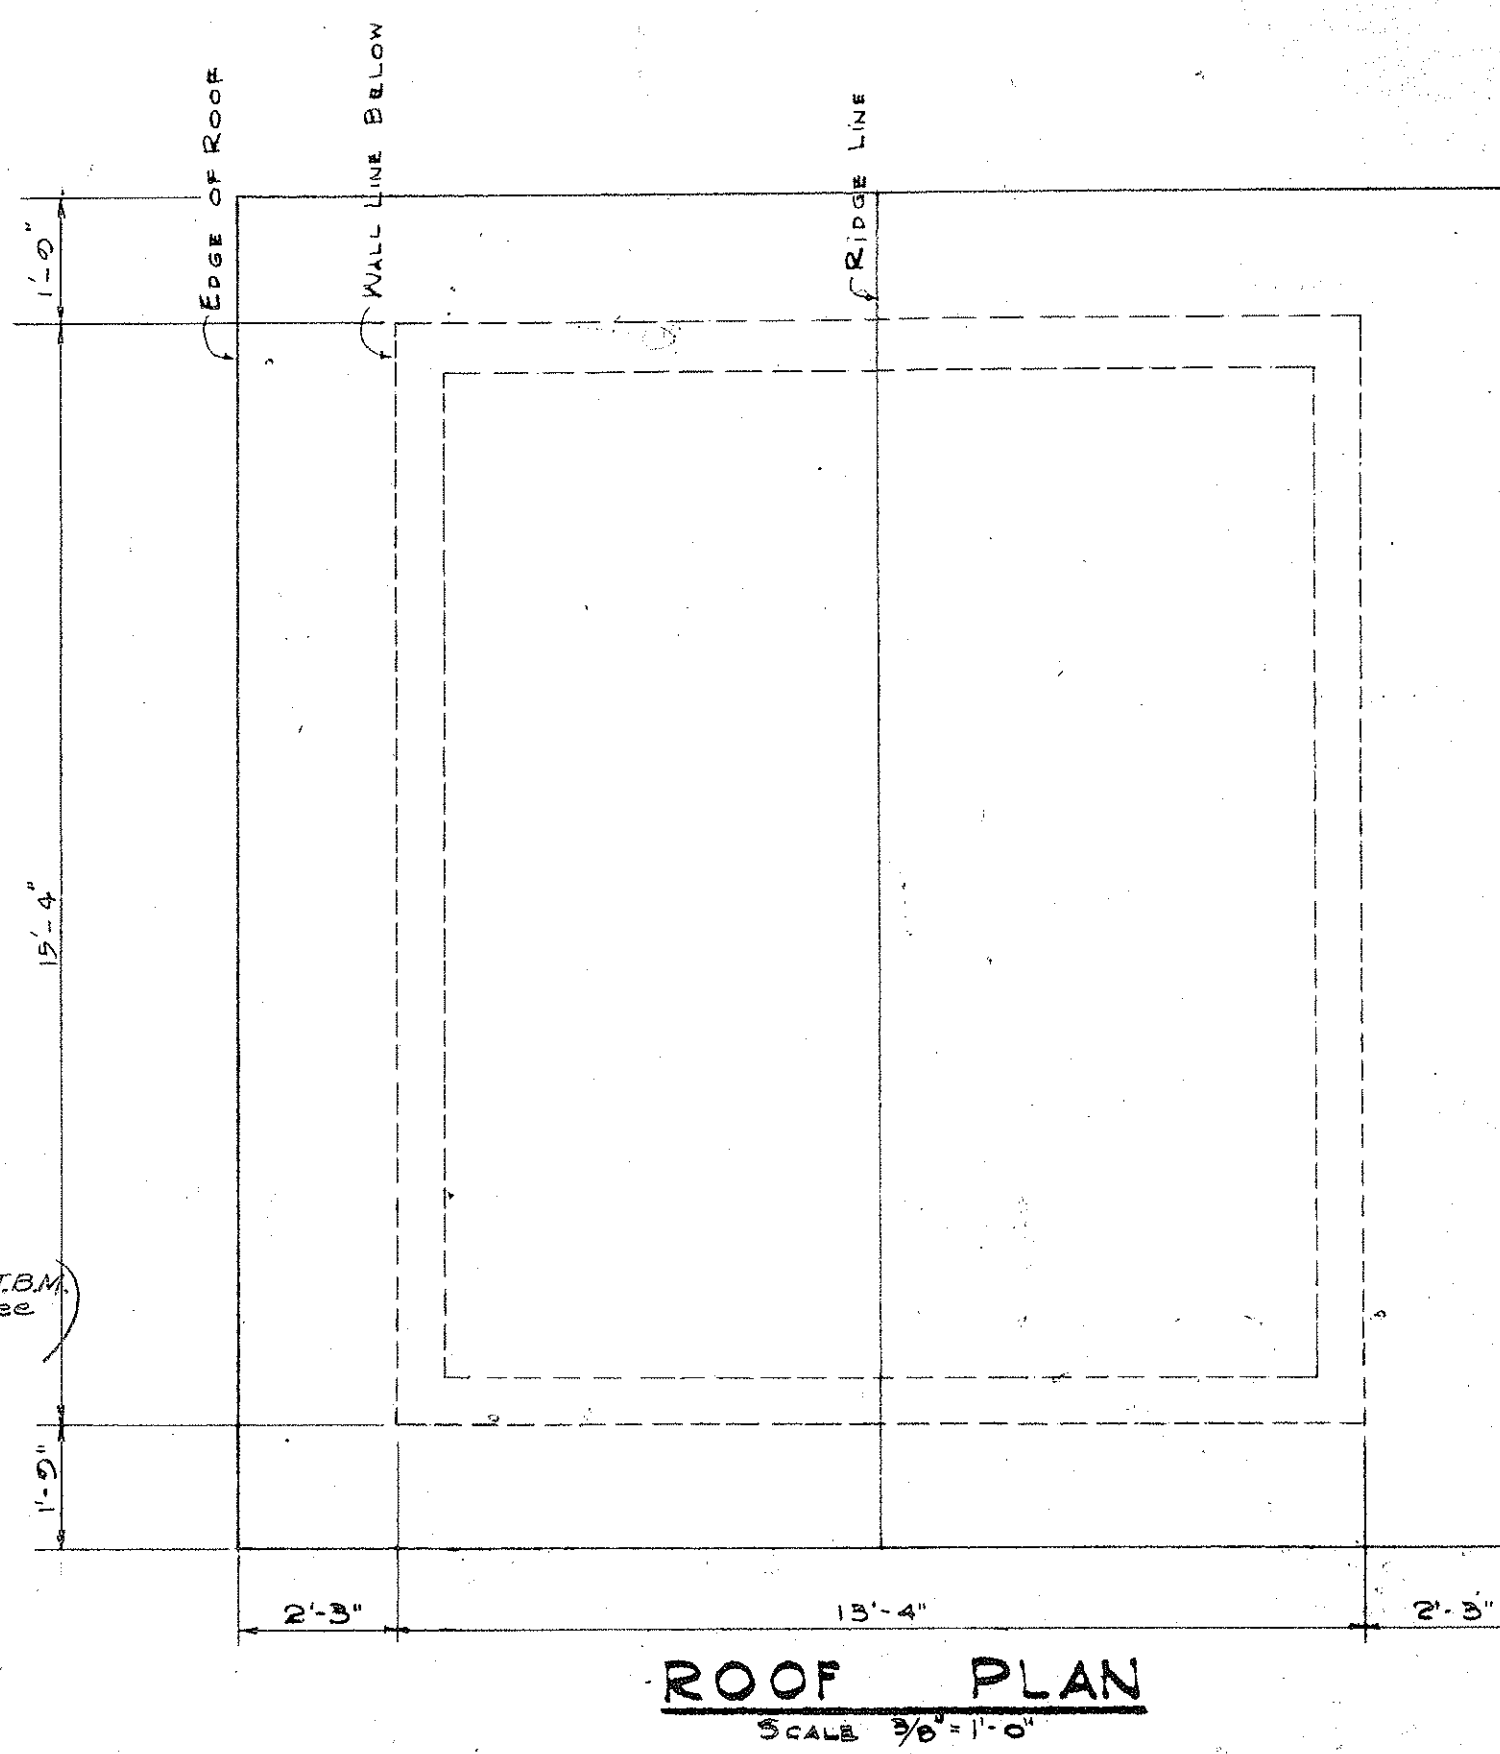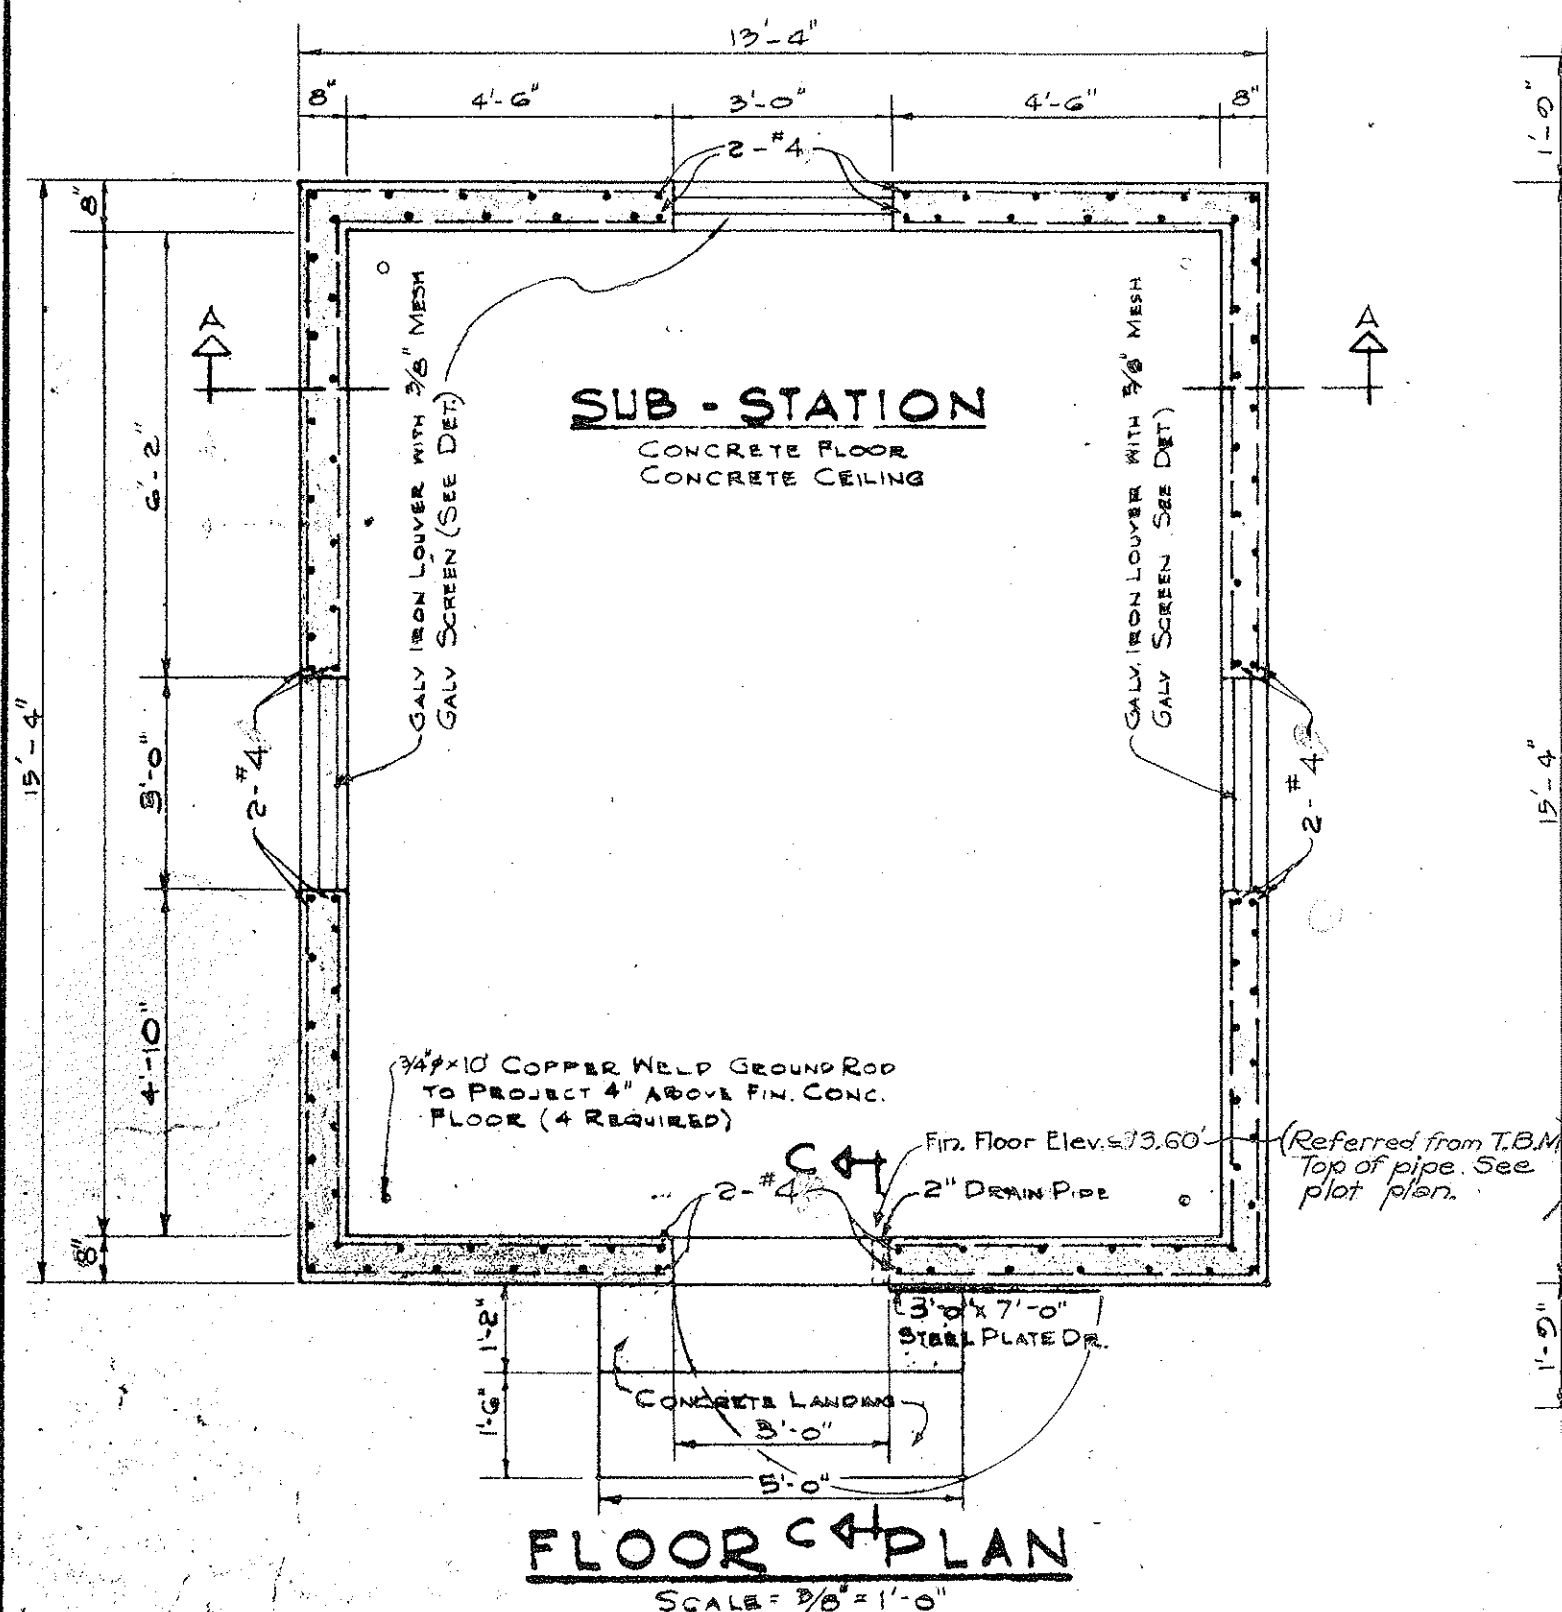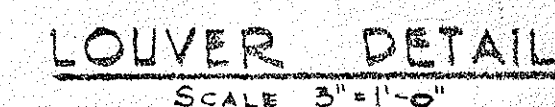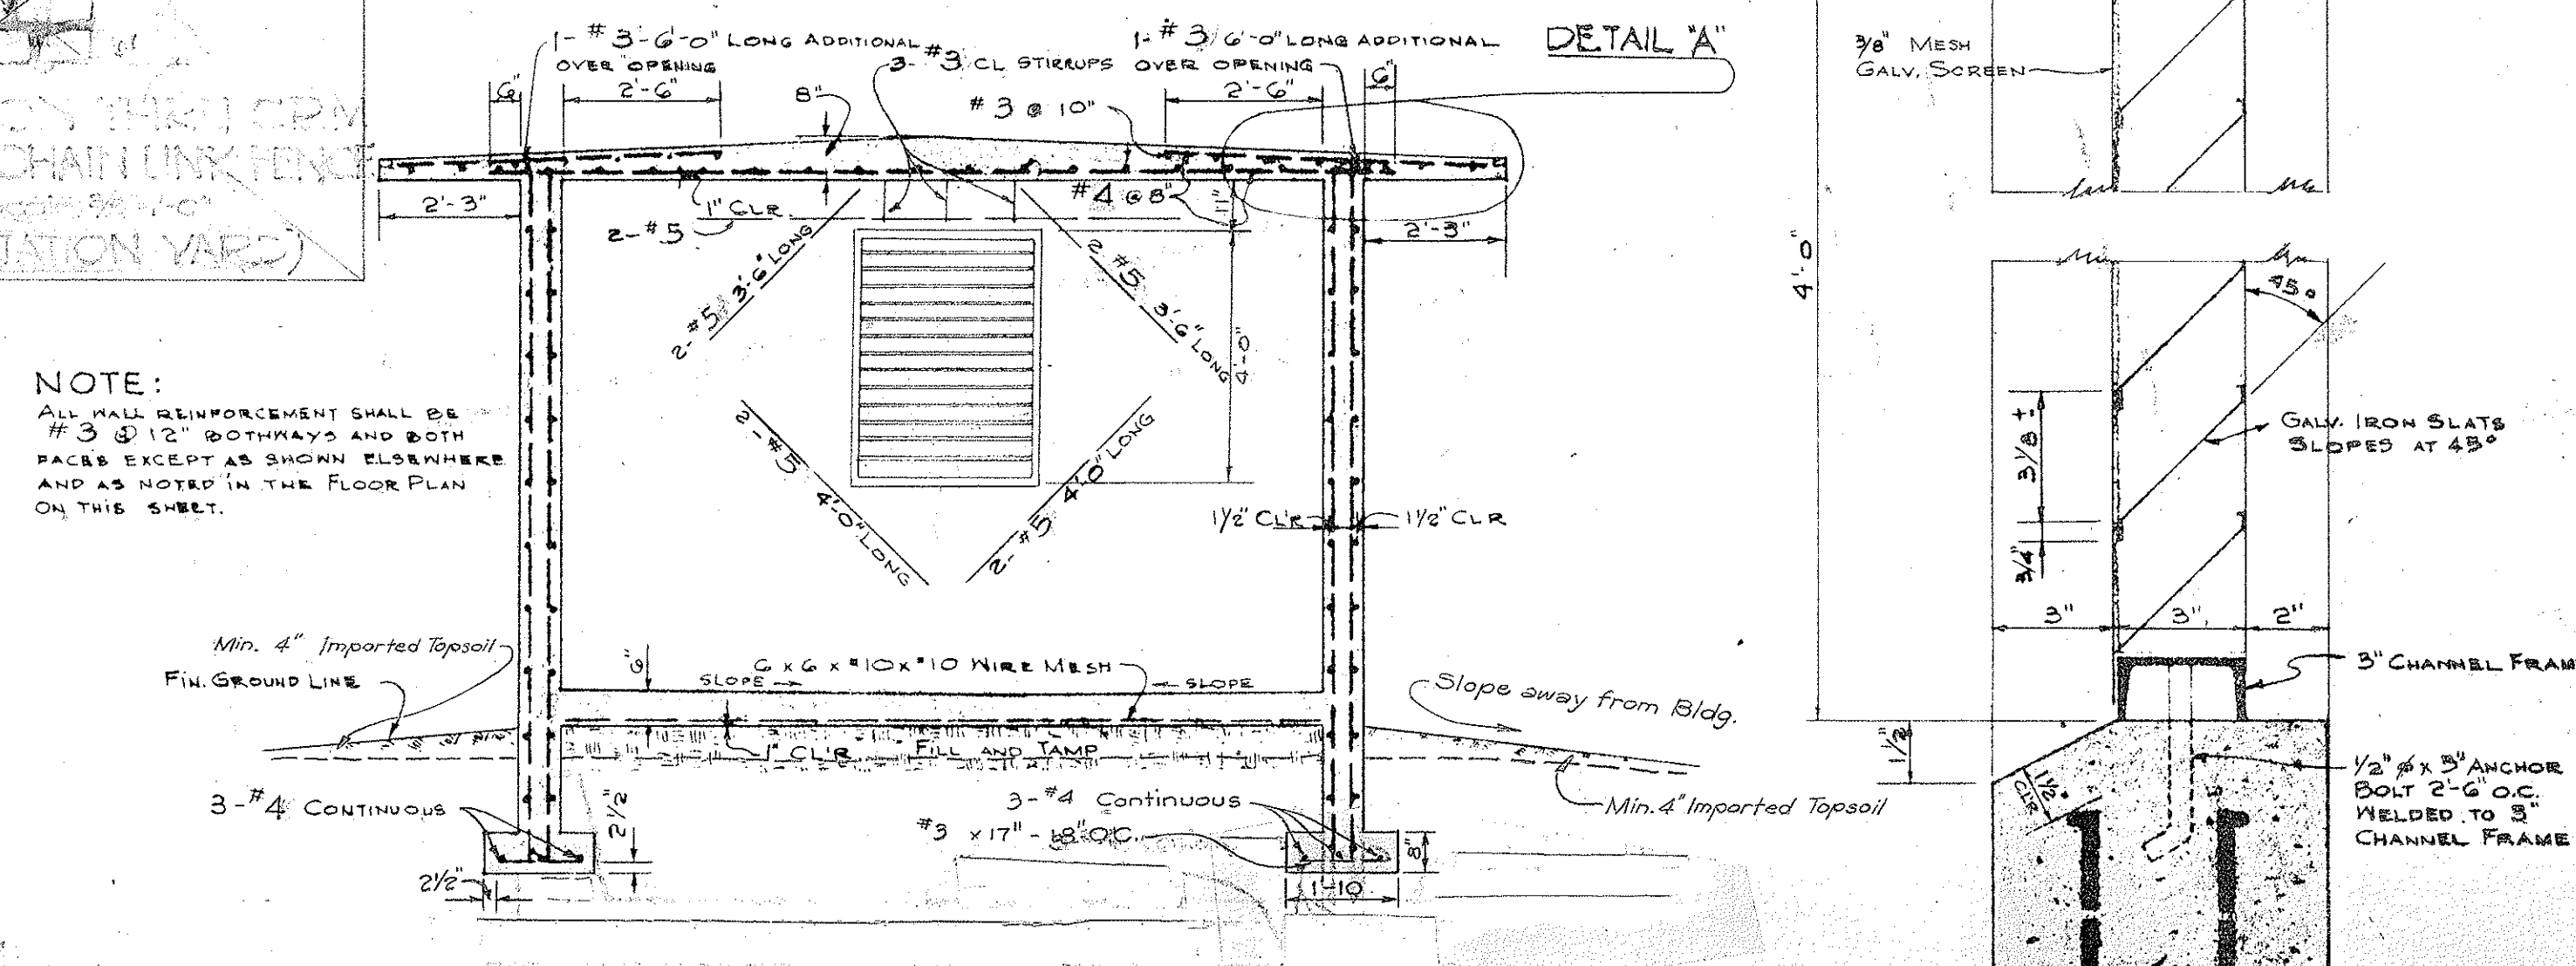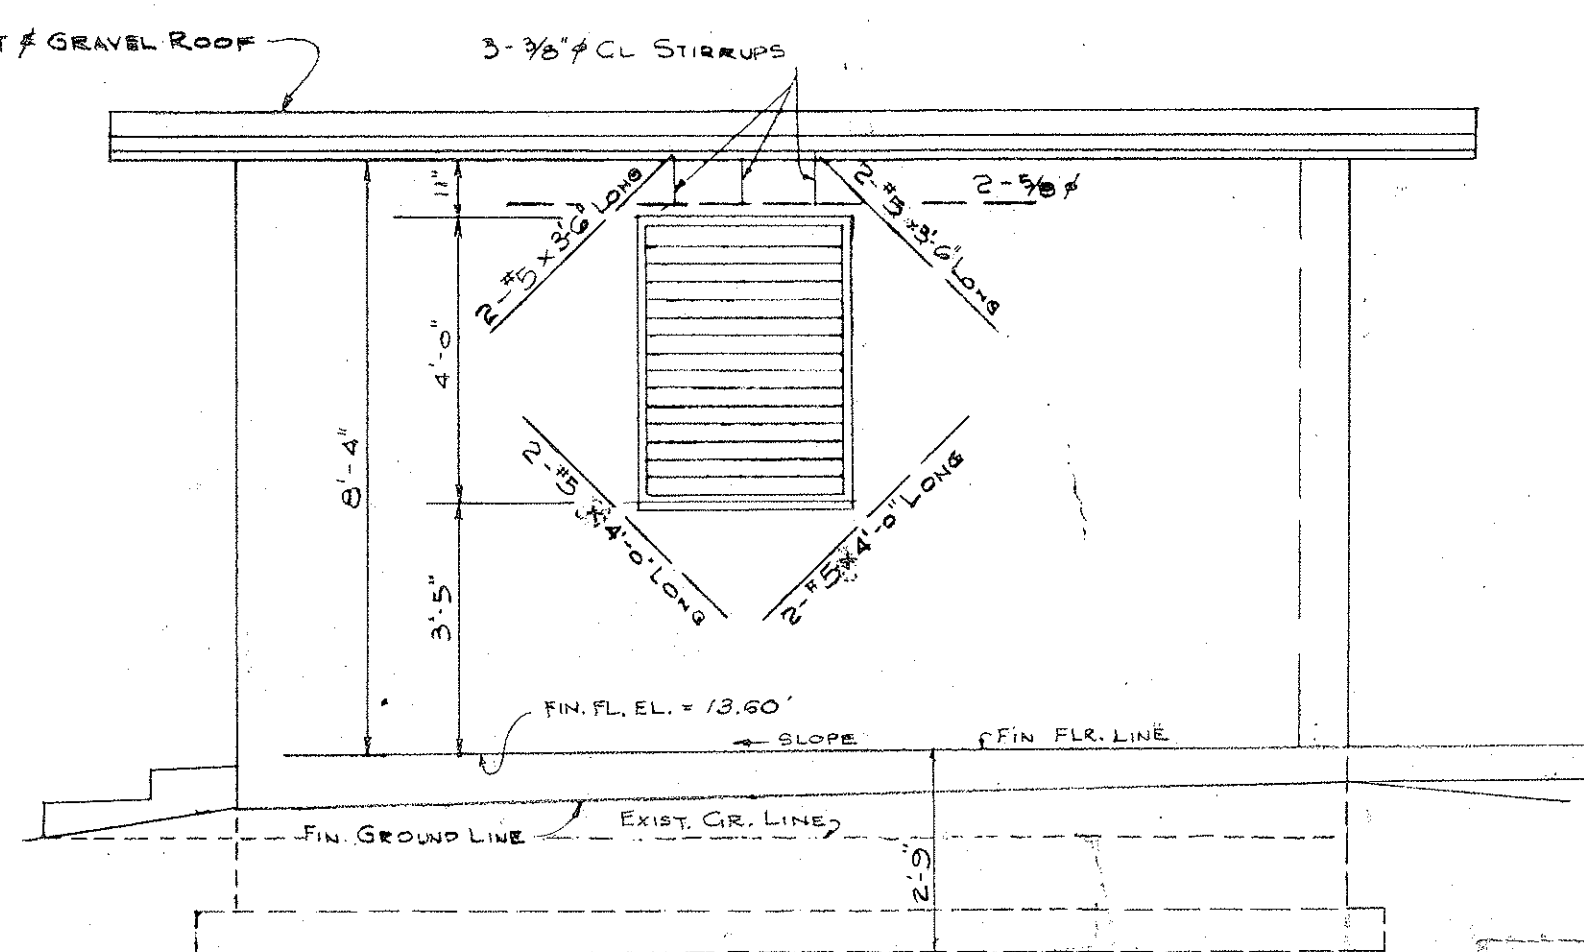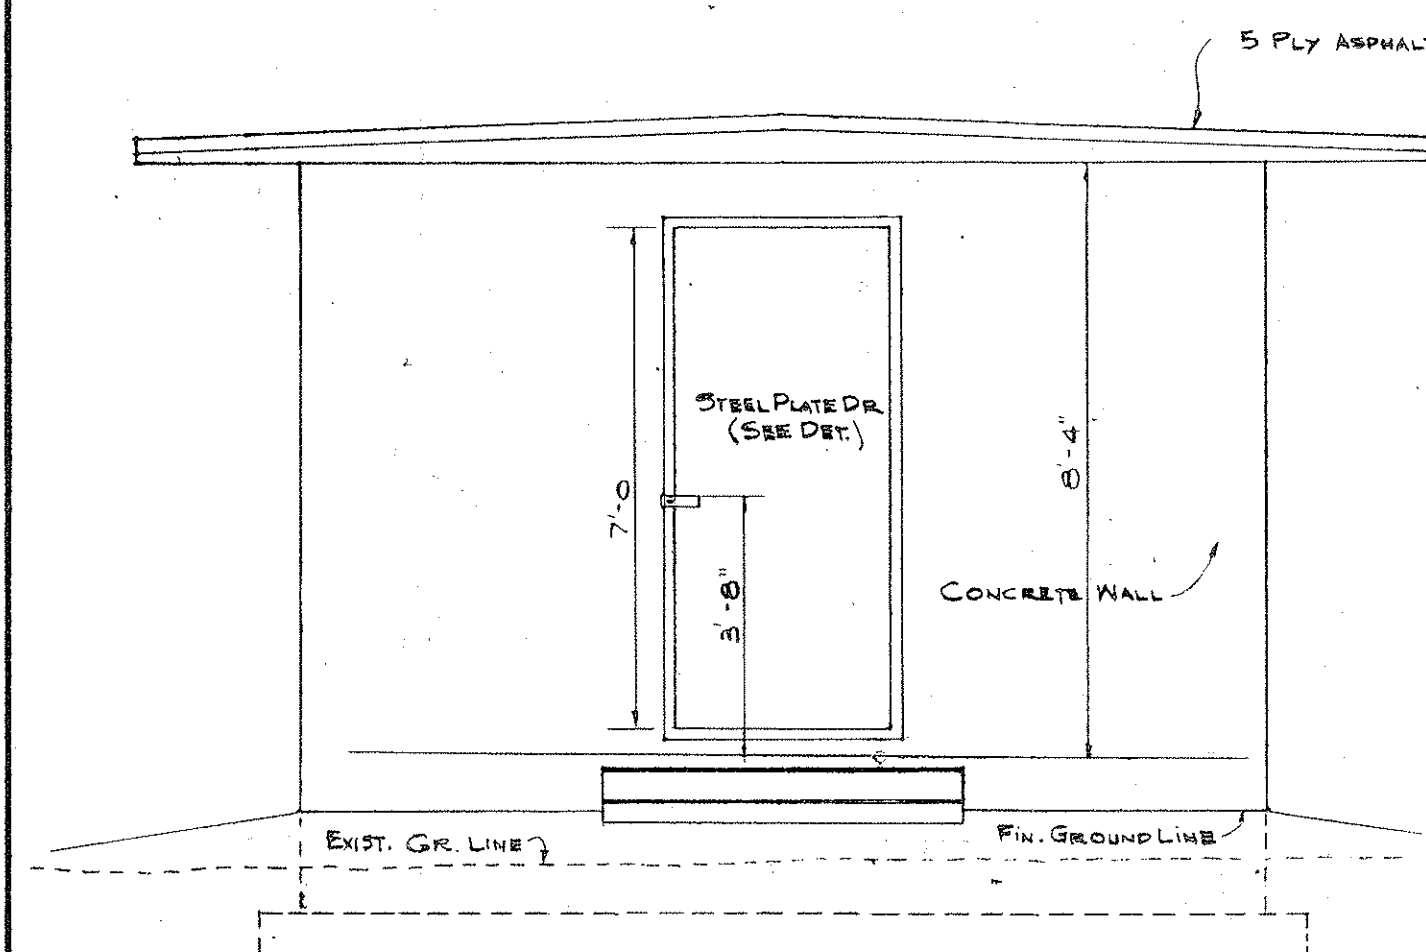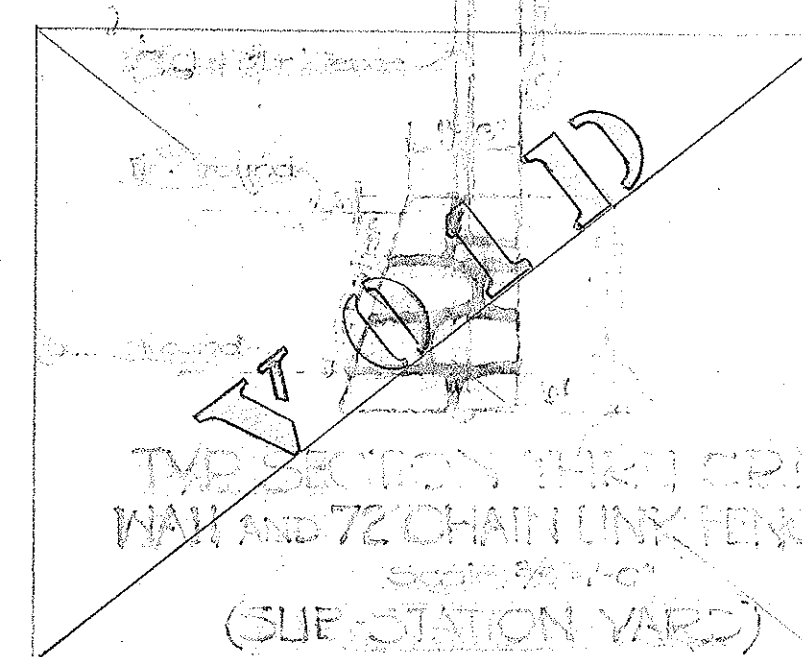

TERRITORIAL HIGHWAY DEPARTMENT
TERRITORY OF HAWAII

HIGHWAY LIGHTING SYSTEM

HONOLULU - PEARL-HARBOR ROAD
MIDDLE ST. TO WAIAKAMILO RD.
PROJECT NO F-092-1(4)

Scale: As Noted JAN. 1958

SHEET No. 6 OF 6 SHEETS

5974.6